





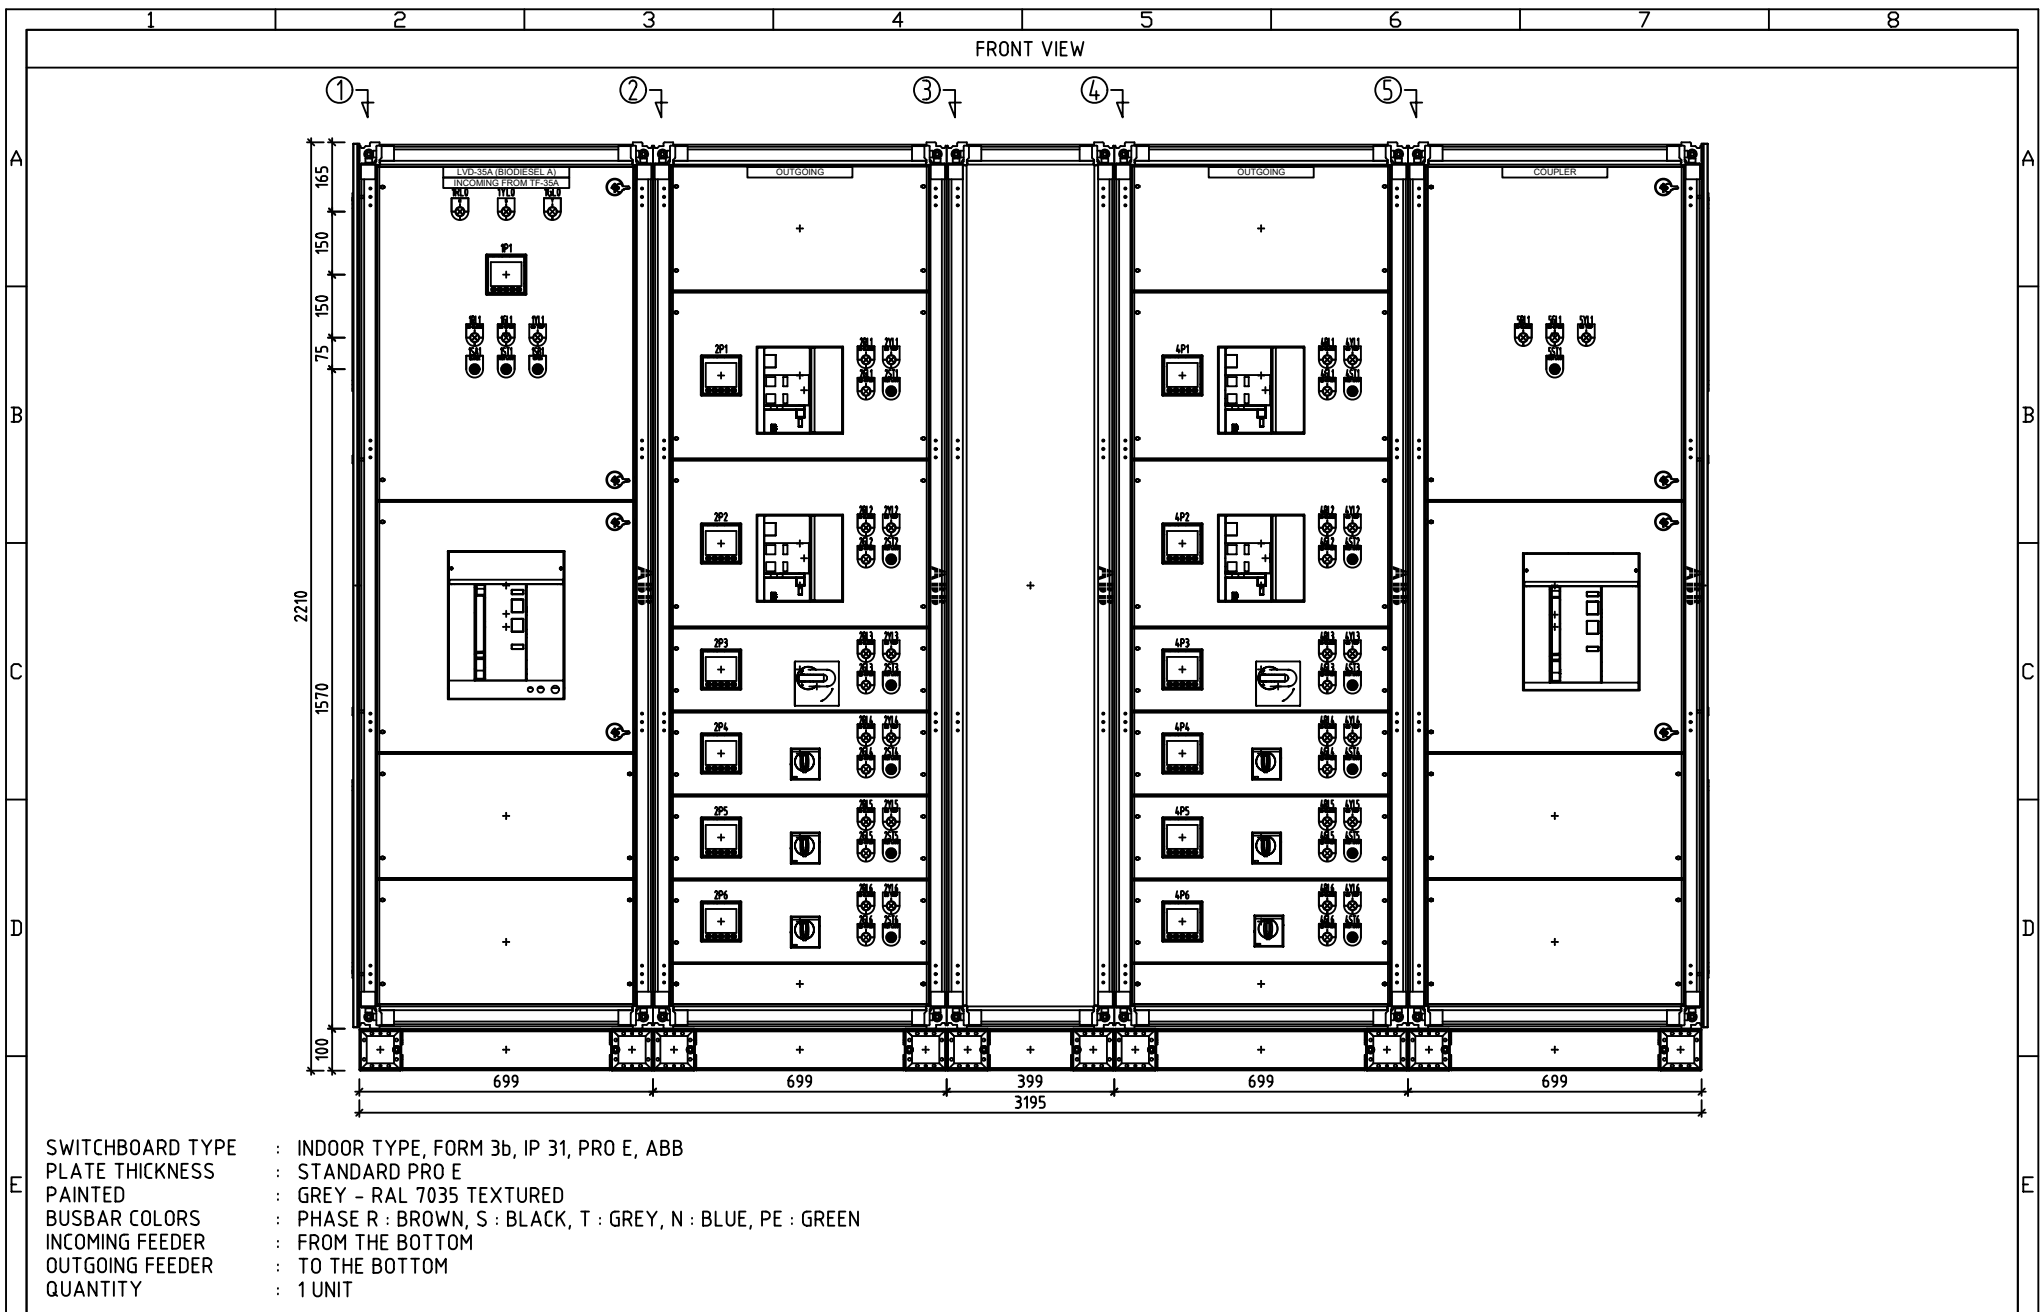


1		2		3		4		5		6		7		8		
 PMElectric Best Value Electrical Solution				PROJECT : MNA WILMAR		DRAWING TITLE : OUTLINE DRAWING LVD-35A (BIO DIESEL A)			DATE	DRAWN	SIGN	VERIFIED	SIGN	DESCRIPTION	REV	PAGE
									30-05-2020	YD		SBR		FOR PRODUCTION R1	1	29
									29-06-2020	YD		SBR		FOR PRODUCTION R2	2	
									01-07-2020	YD		SBR		FOR PRODUCTION R3	3	
									17-09-2020	YD		SBR		AS BUILT DRAWING	4	
CUSTOMER : PT. ABB SAKTI INDUSTRI				NO DR/JO : JO-004/IND.2020		SCALE : 1:18										
				NO DWG. : ABB-001		Dimension in mm										

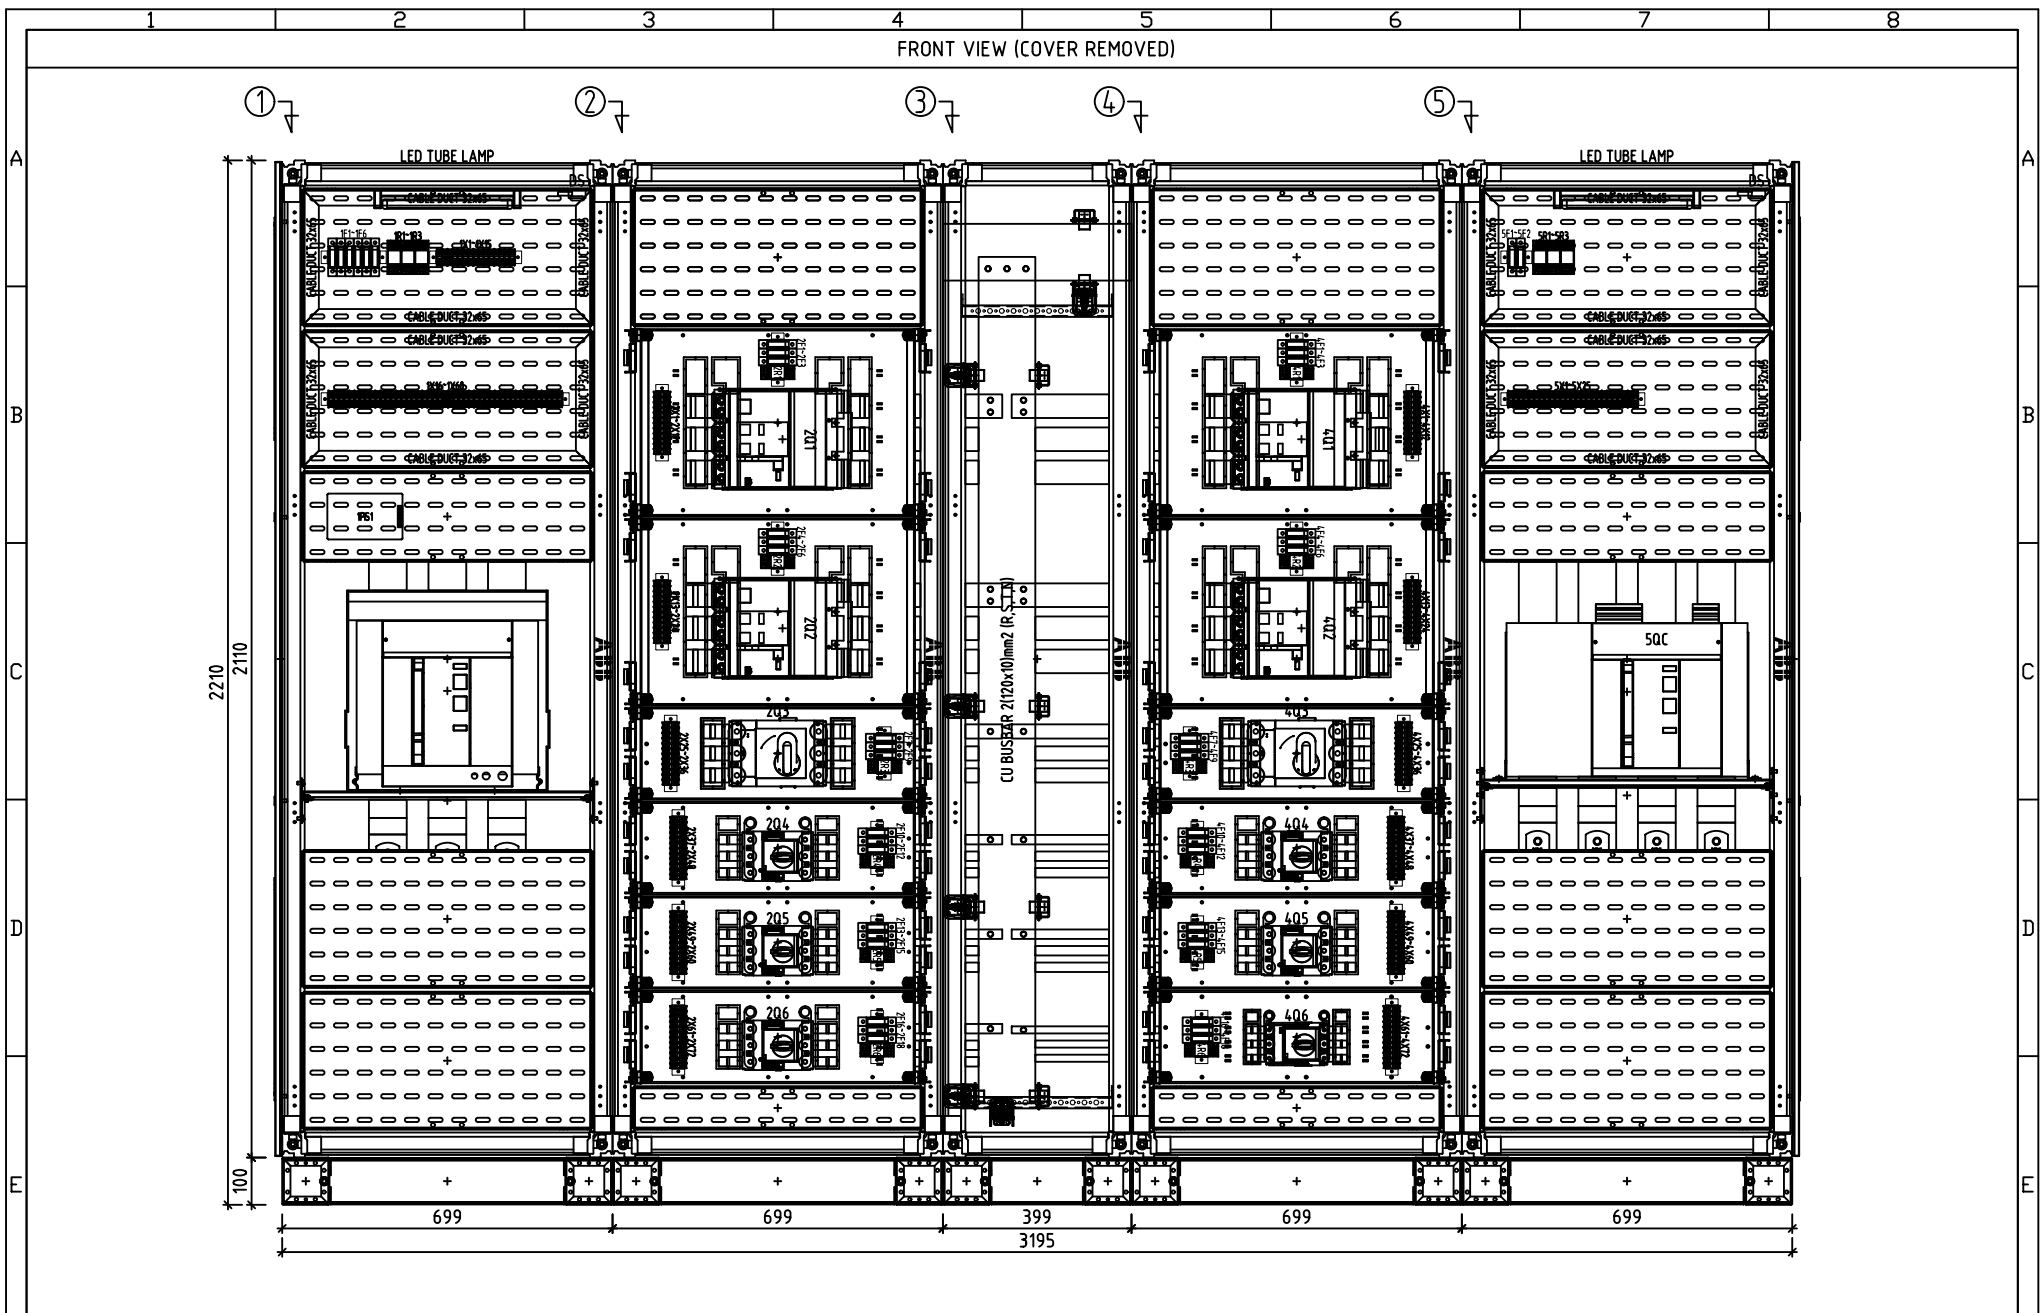

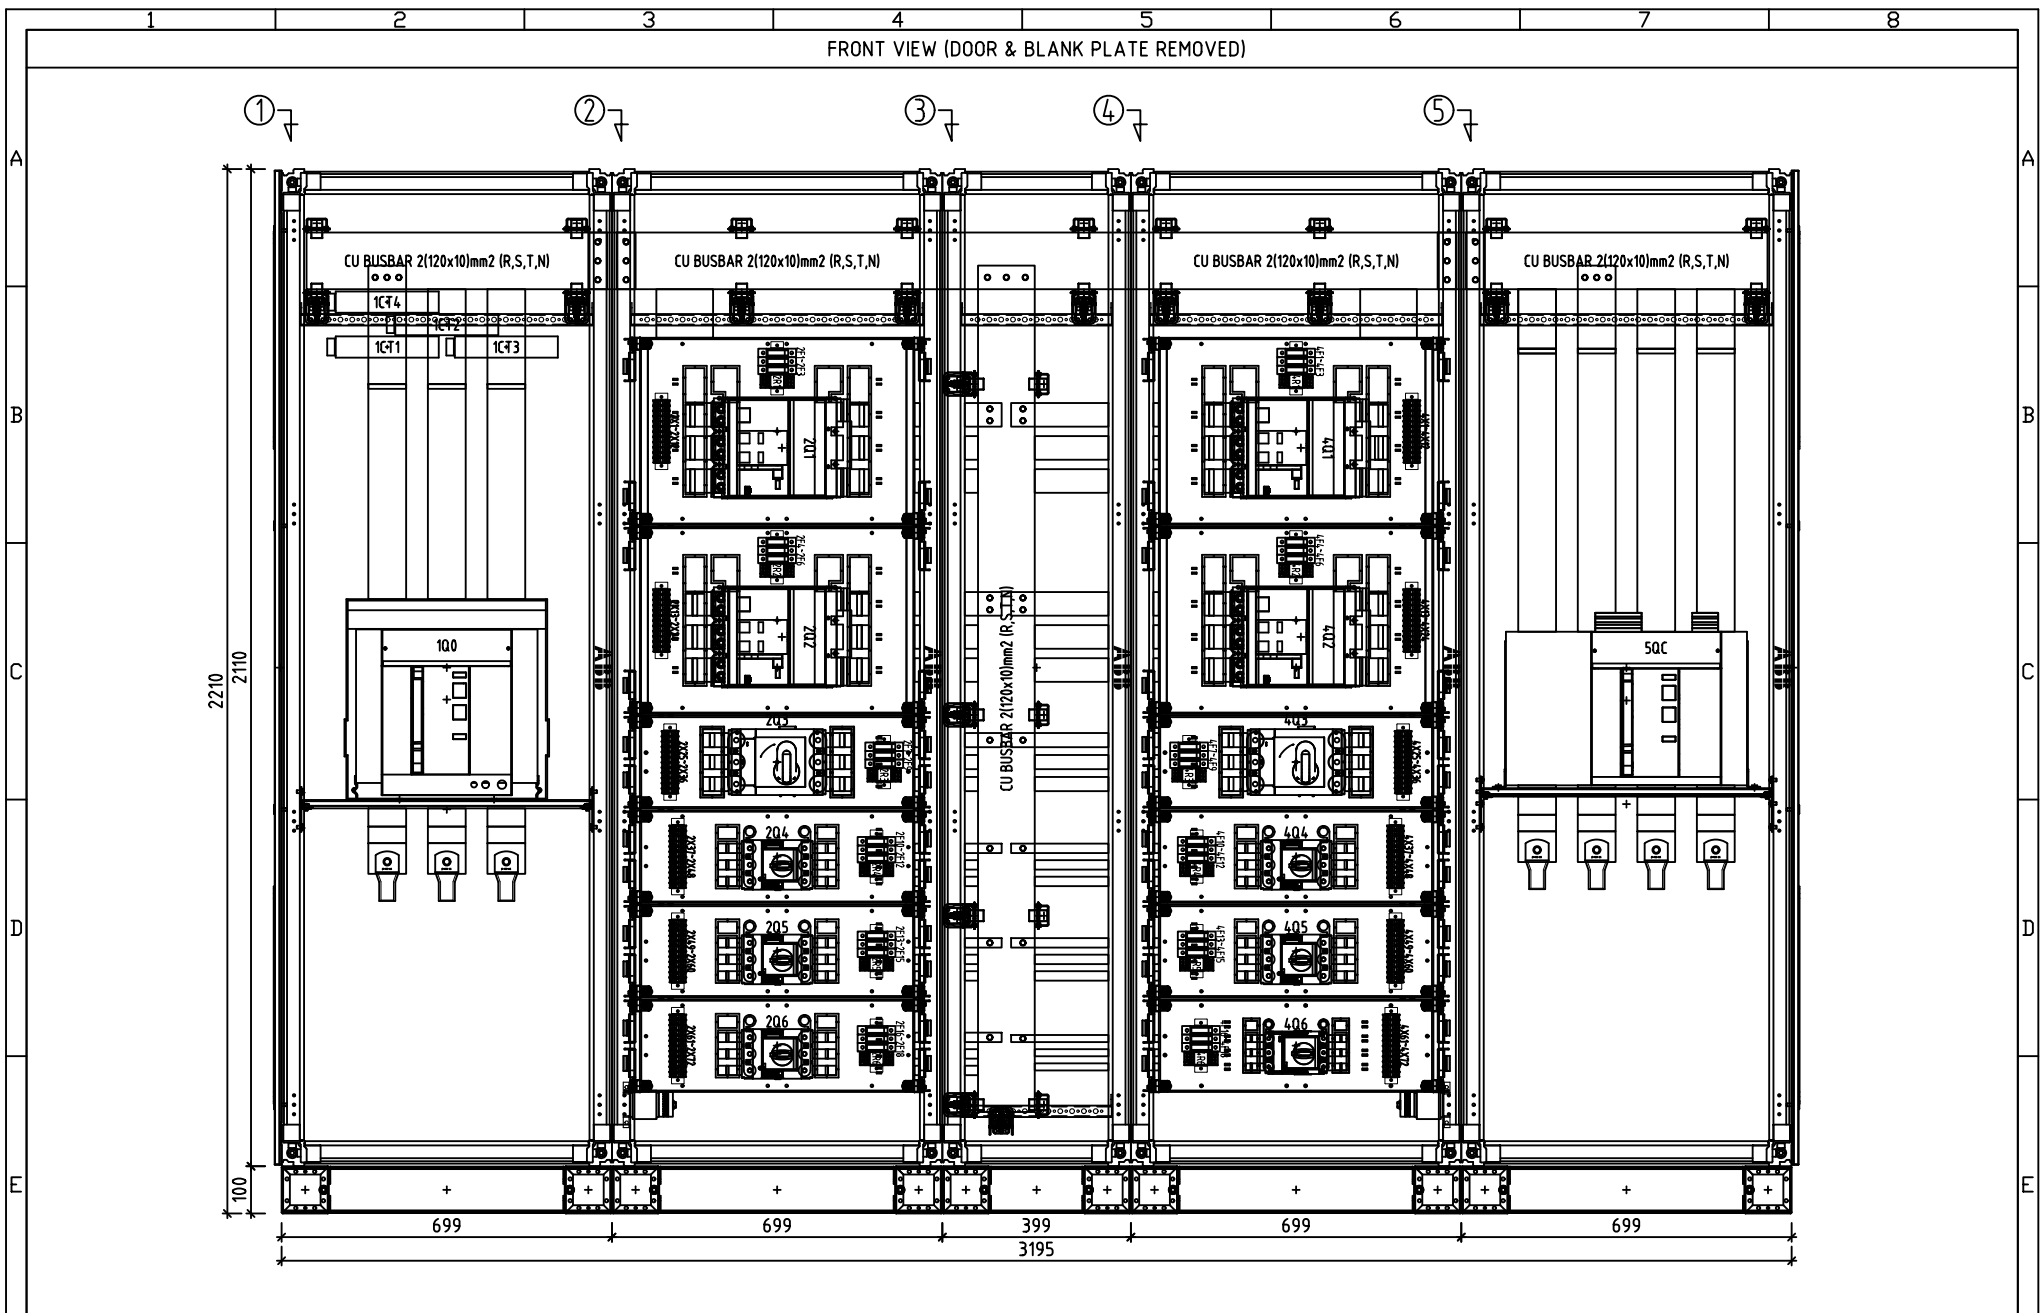


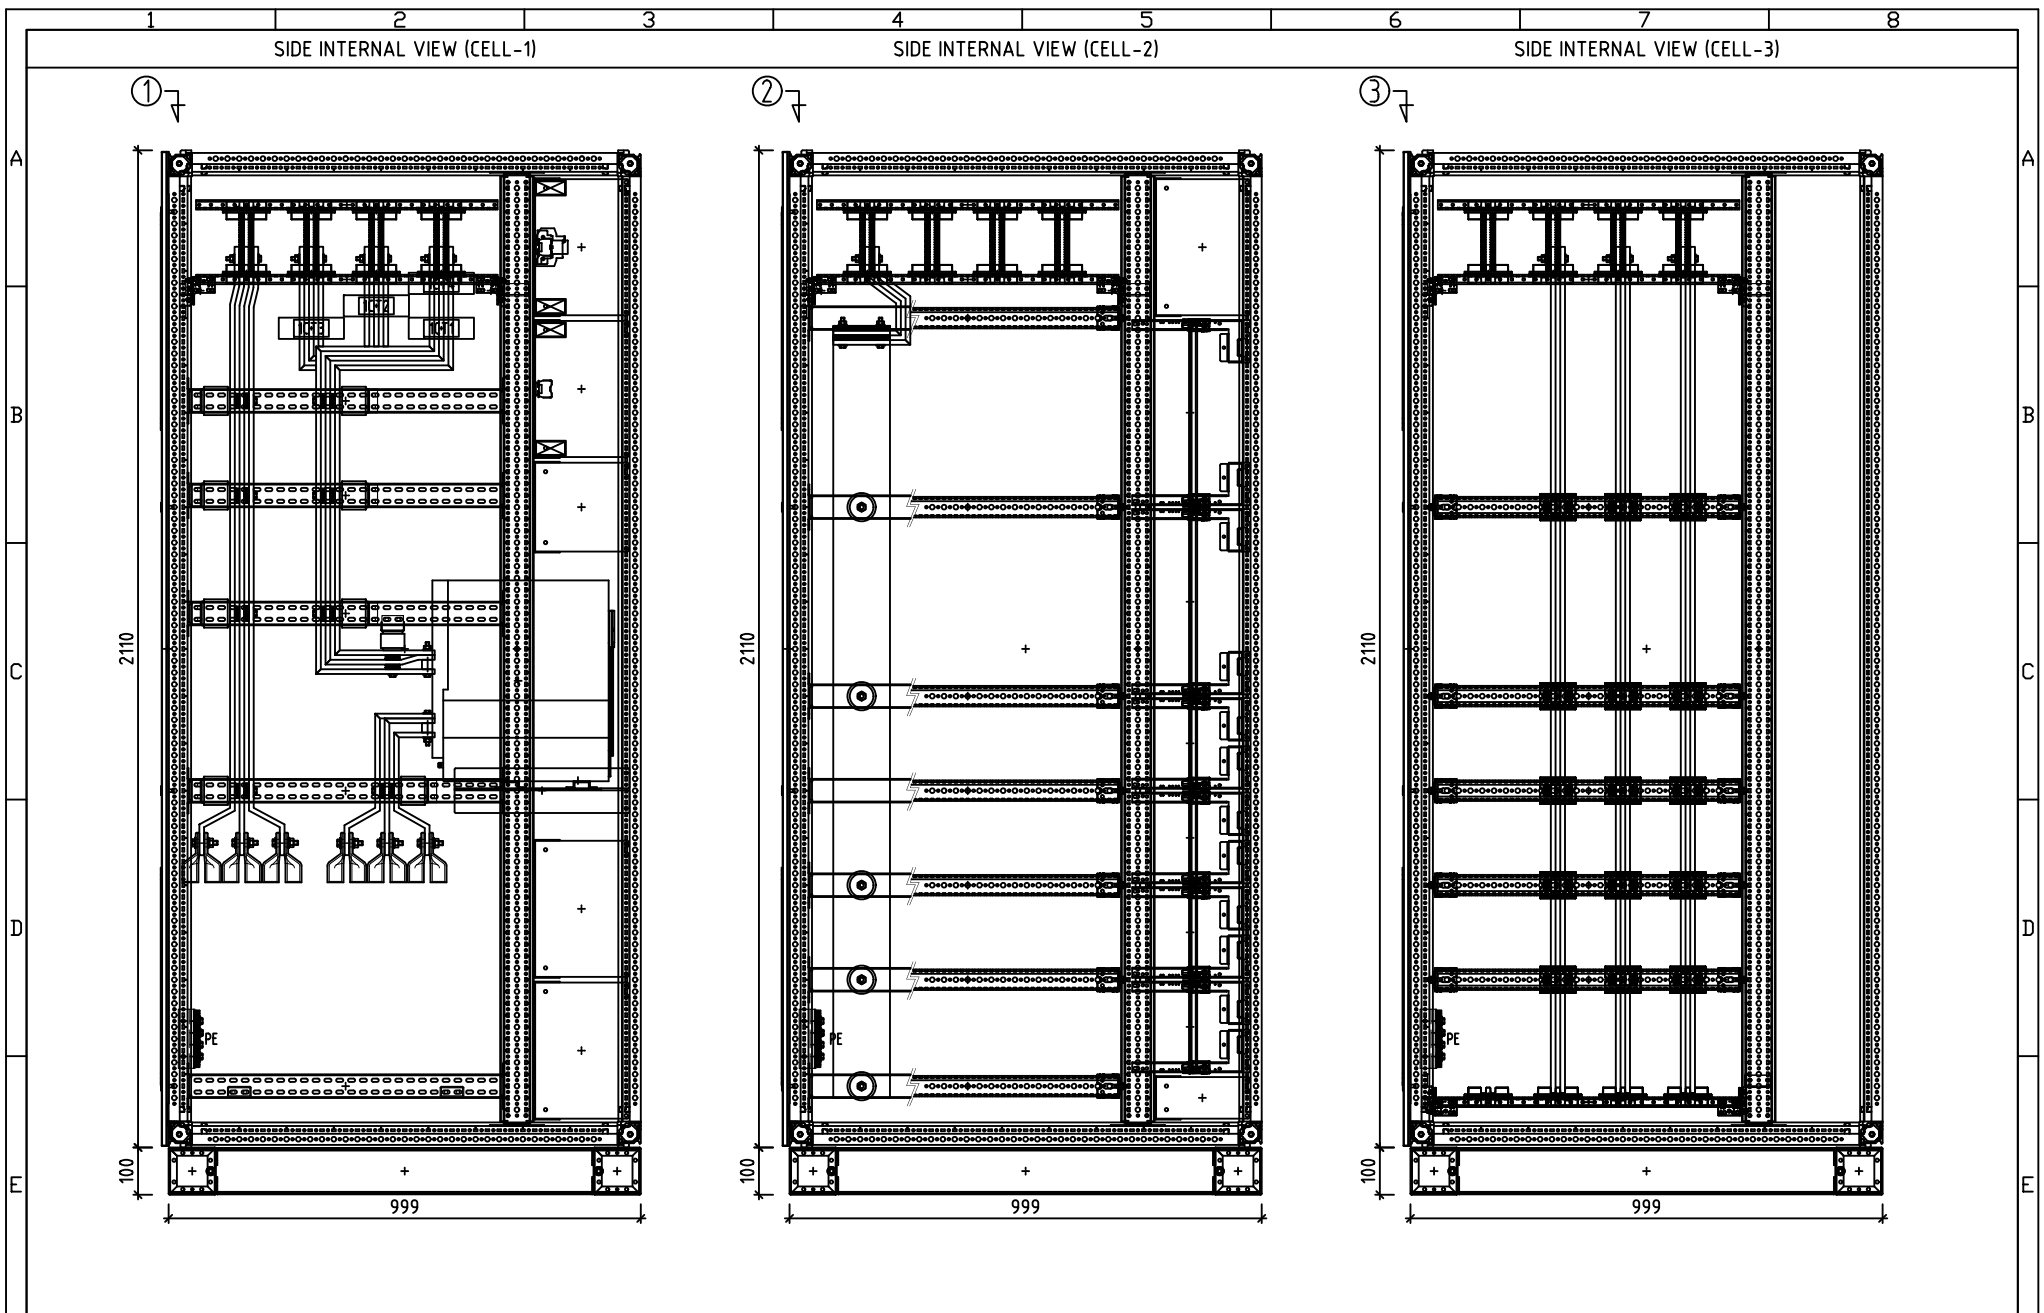


PMElectric Best Value Electrical Solution	PROJECT : MNA WILMAR		DRAWING TITLE : OUTLINE DRAWING LVD-35A (BIODIESEL A)		DATE	DRAWN	SIGN	VERIFIED	SIGN	DESCRIPTION	REV	PAGE
	CUSTOMER : PT. ABB SAKTI INDUSTRI		NO DR/JO : JO-004/IND.2020		30-05-2020	YD		SBR		FOR PRODUCTION R1	1	4
			SCALE : 1:16		29-06-2020	YD	YD	SBR		FOR PRODUCTION R2	2	
			NO DWG. : ABB-001		01-07-2020	YD	YD	SBR		FOR PRODUCTION R3	3	
			Dimension in mm		17-09-2020	YD		SBR		AS BUILT DRAWING	4	

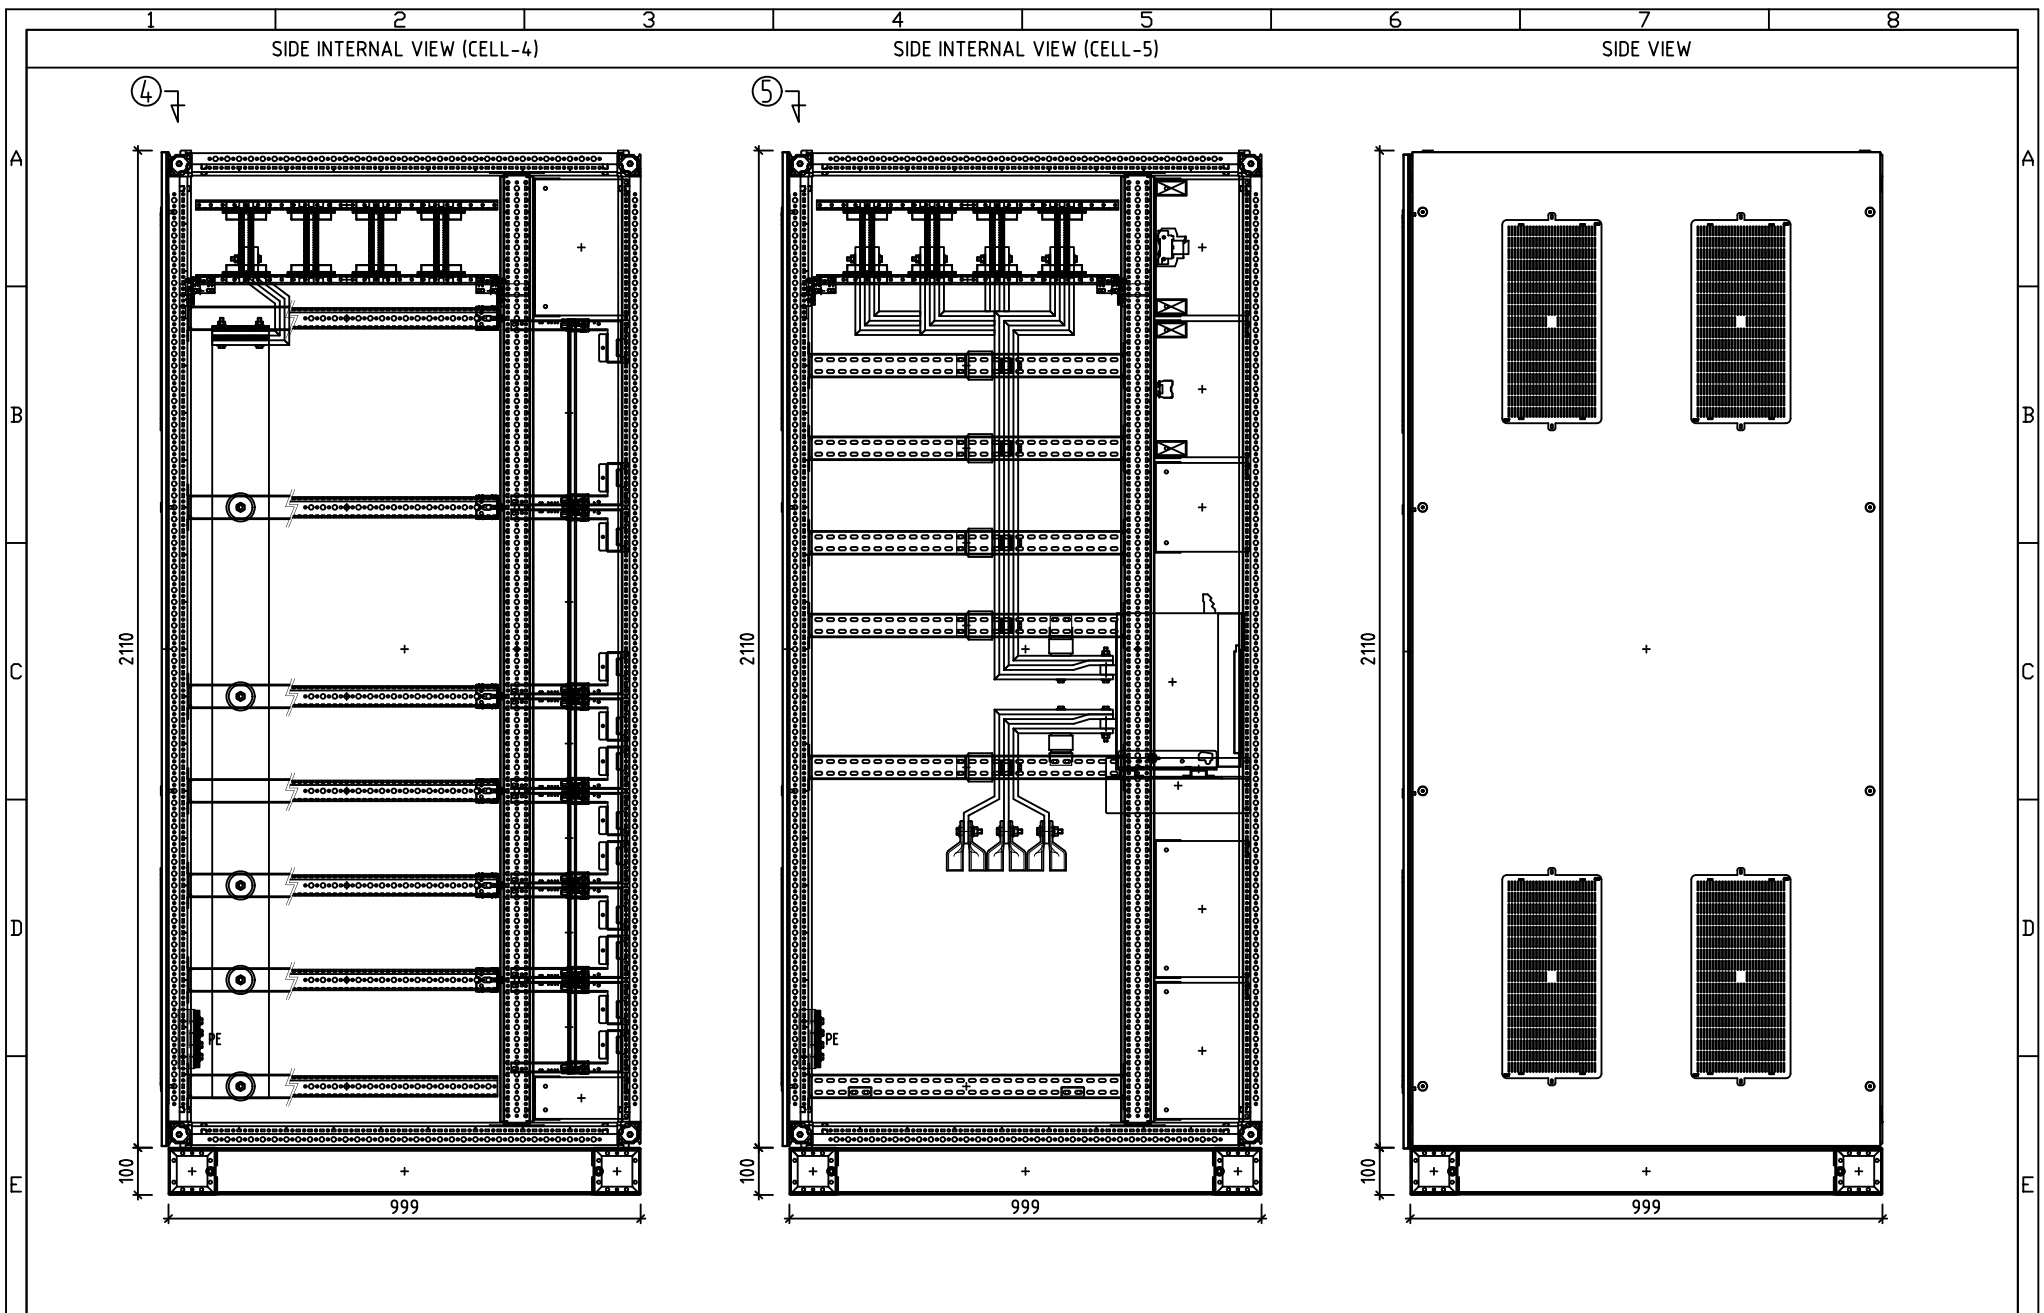


PMElectric Best Value Electrical Solution	PROJECT : MNA WILMAR		DRAWING TITLE : OUTLINE DRAWING LVD-35A (BIODIESEL A)		DATE	DRAWN	SIGN	VERIFIED	SIGN	DESCRIPTION	REV	PAGE
	CUSTOMER : PT. ABB SAKTI INDUSTRI		NO DR/JO : JO-004/IND.2020		30-05-2020	YD		SBR		FOR PRODUCTION R1	△	5
			SCALE : 1:16		29-06-2020	YD	YD	SBR		FOR PRODUCTION R2	△	
			NO DWG. : ABB-001		01-07-2020	YD	YD	SBR		FOR PRODUCTION R3	△	
			Dimension in mm		17-09-2020	YD		SBR		AS BUILT DRAWING	△	

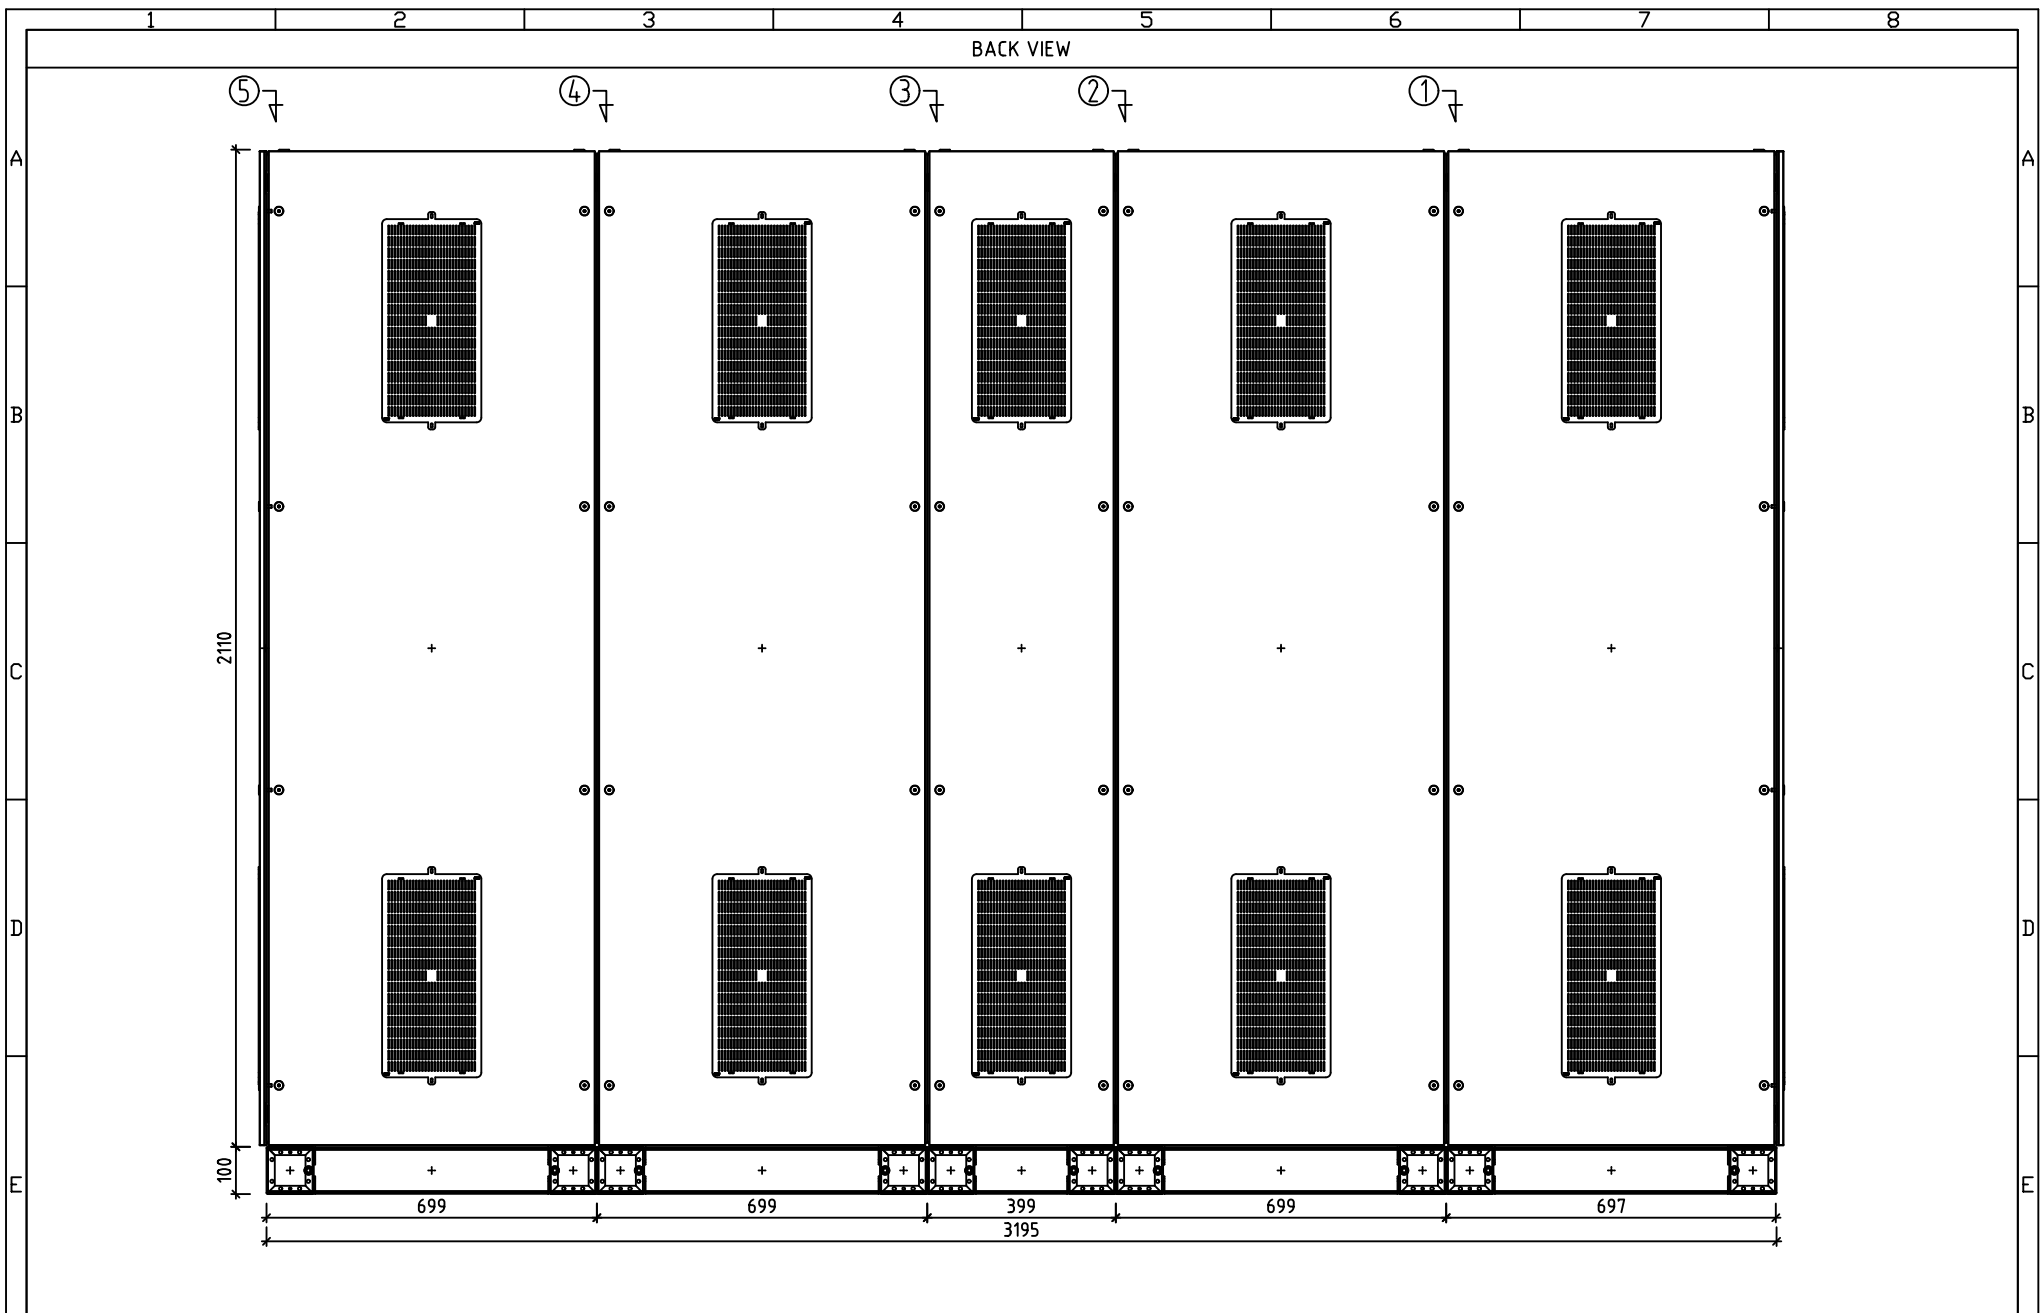


 PMElectric Best Value Electrical Solution	PROJECT : MNA WILMAR		DRAWING TITLE : OUTLINE DRAWING LVD-35A (BIO DIESEL A)		DATE	DRAWN	SIGN	VERIFIED	SIGN	DESCRIPTION	REV	PAGE
	CUSTOMER : PT. ABB SAKTI INDUSTRI		NO DR/JO : JO-004/IND.2020		SCALE : 1:16	30-05-2020	YD	[Signature]	[Signature]	SBR	FOR PRODUCTION R1	△
			NO DWG. : ABB-001		Dimension in mm	29-06-2020	YD			SBR	FOR PRODUCTION R2	△
								01-07-2020	YD	SBR	FOR PRODUCTION R3	△
								17-09-2020	YD	SBR	AS BUILT DRAWING	△
29												

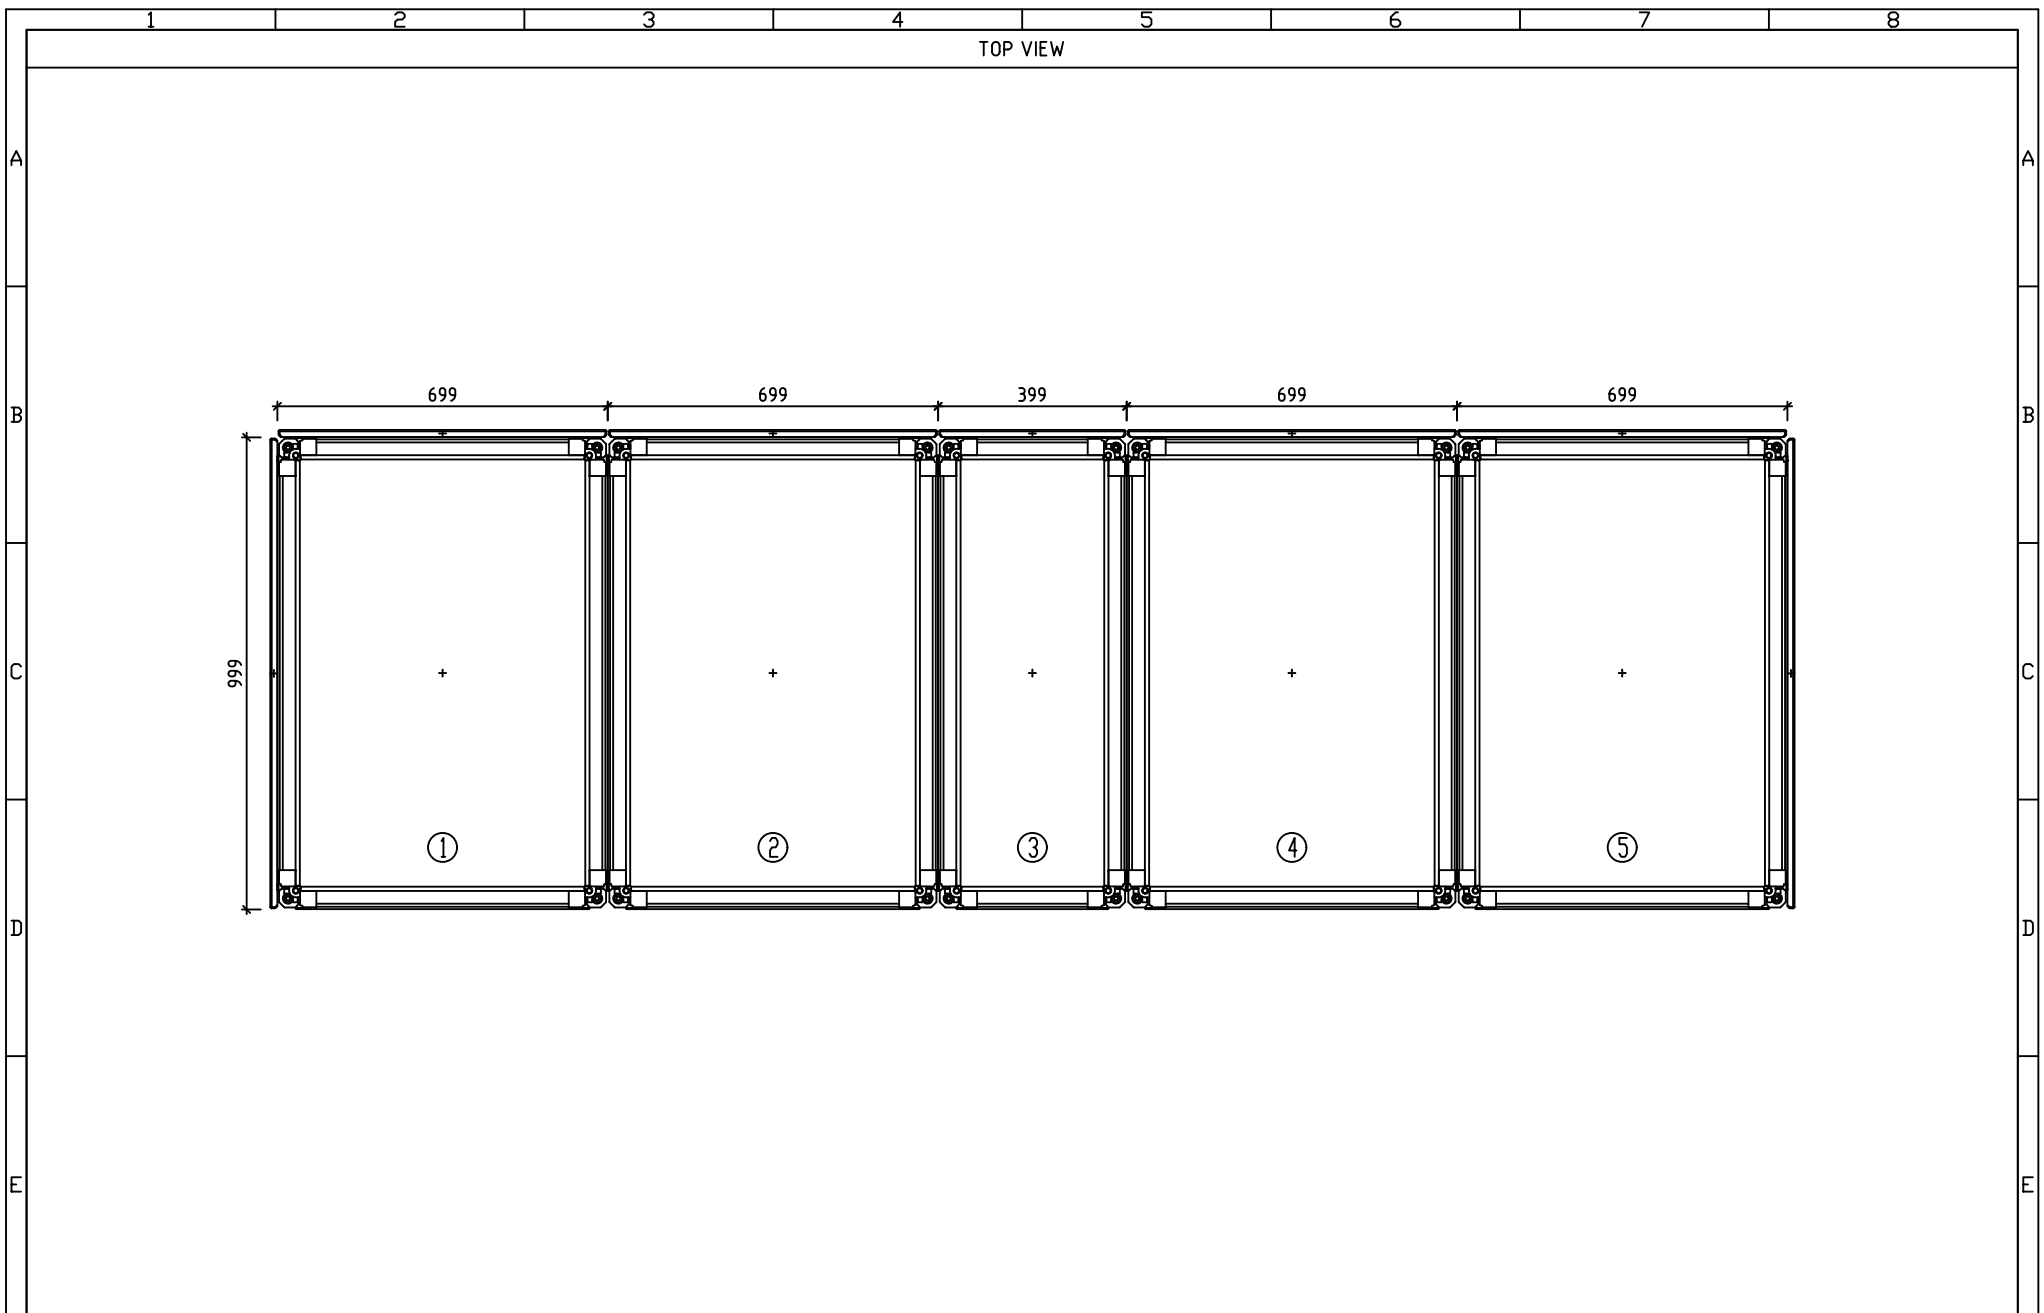


PMElectric Best Value Electrical Solution	PROJECT : MNA WILMAR CUSTOMER : PT. ABB SAKTI INDUSTRI	DRAWING TITLE : OUTLINE DRAWING LVD-35A (BODIESEL A) NO DR/JO : JO-004/IND.2020 NO DWG. : ABB-001		SCALE : 1:16 Dimension in mm	DATE	DRAWN	SIGN	VERIFIED	SIGN	DESCRIPTION	REV	PAGE 7 29
					30-05-2020	YD		SBR		FOR PRODUCTION R1	△	
					29-06-2020	YD	YD	SBR	AS	FOR PRODUCTION R2	△	
					01-07-2020	YD	YD	SBR	AS	FOR PRODUCTION R3	△	
					17-09-2020	YD		SBR		AS BUILT DRAWING	△	

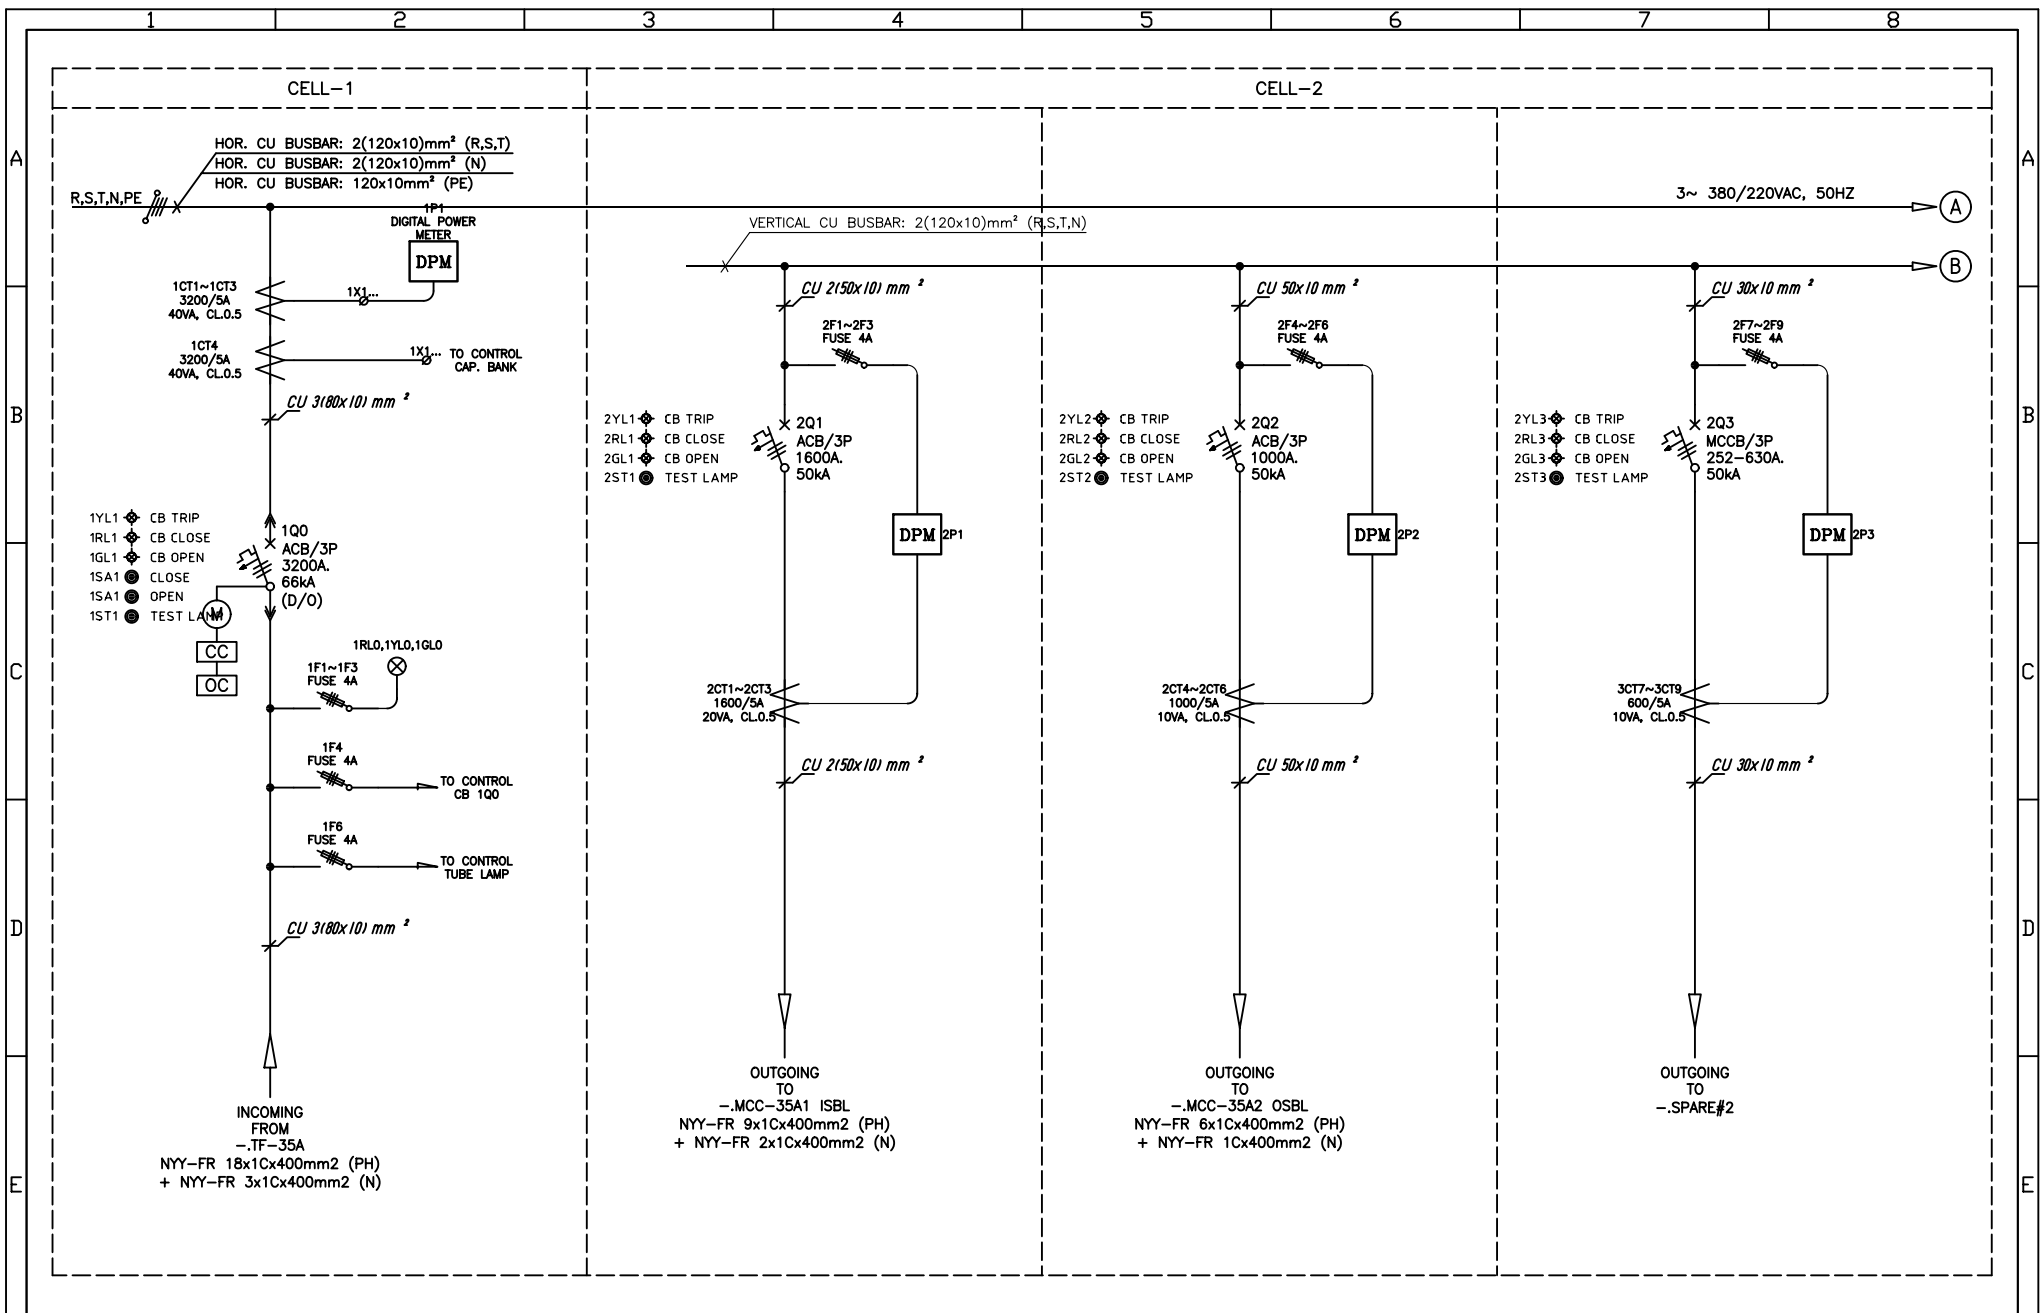


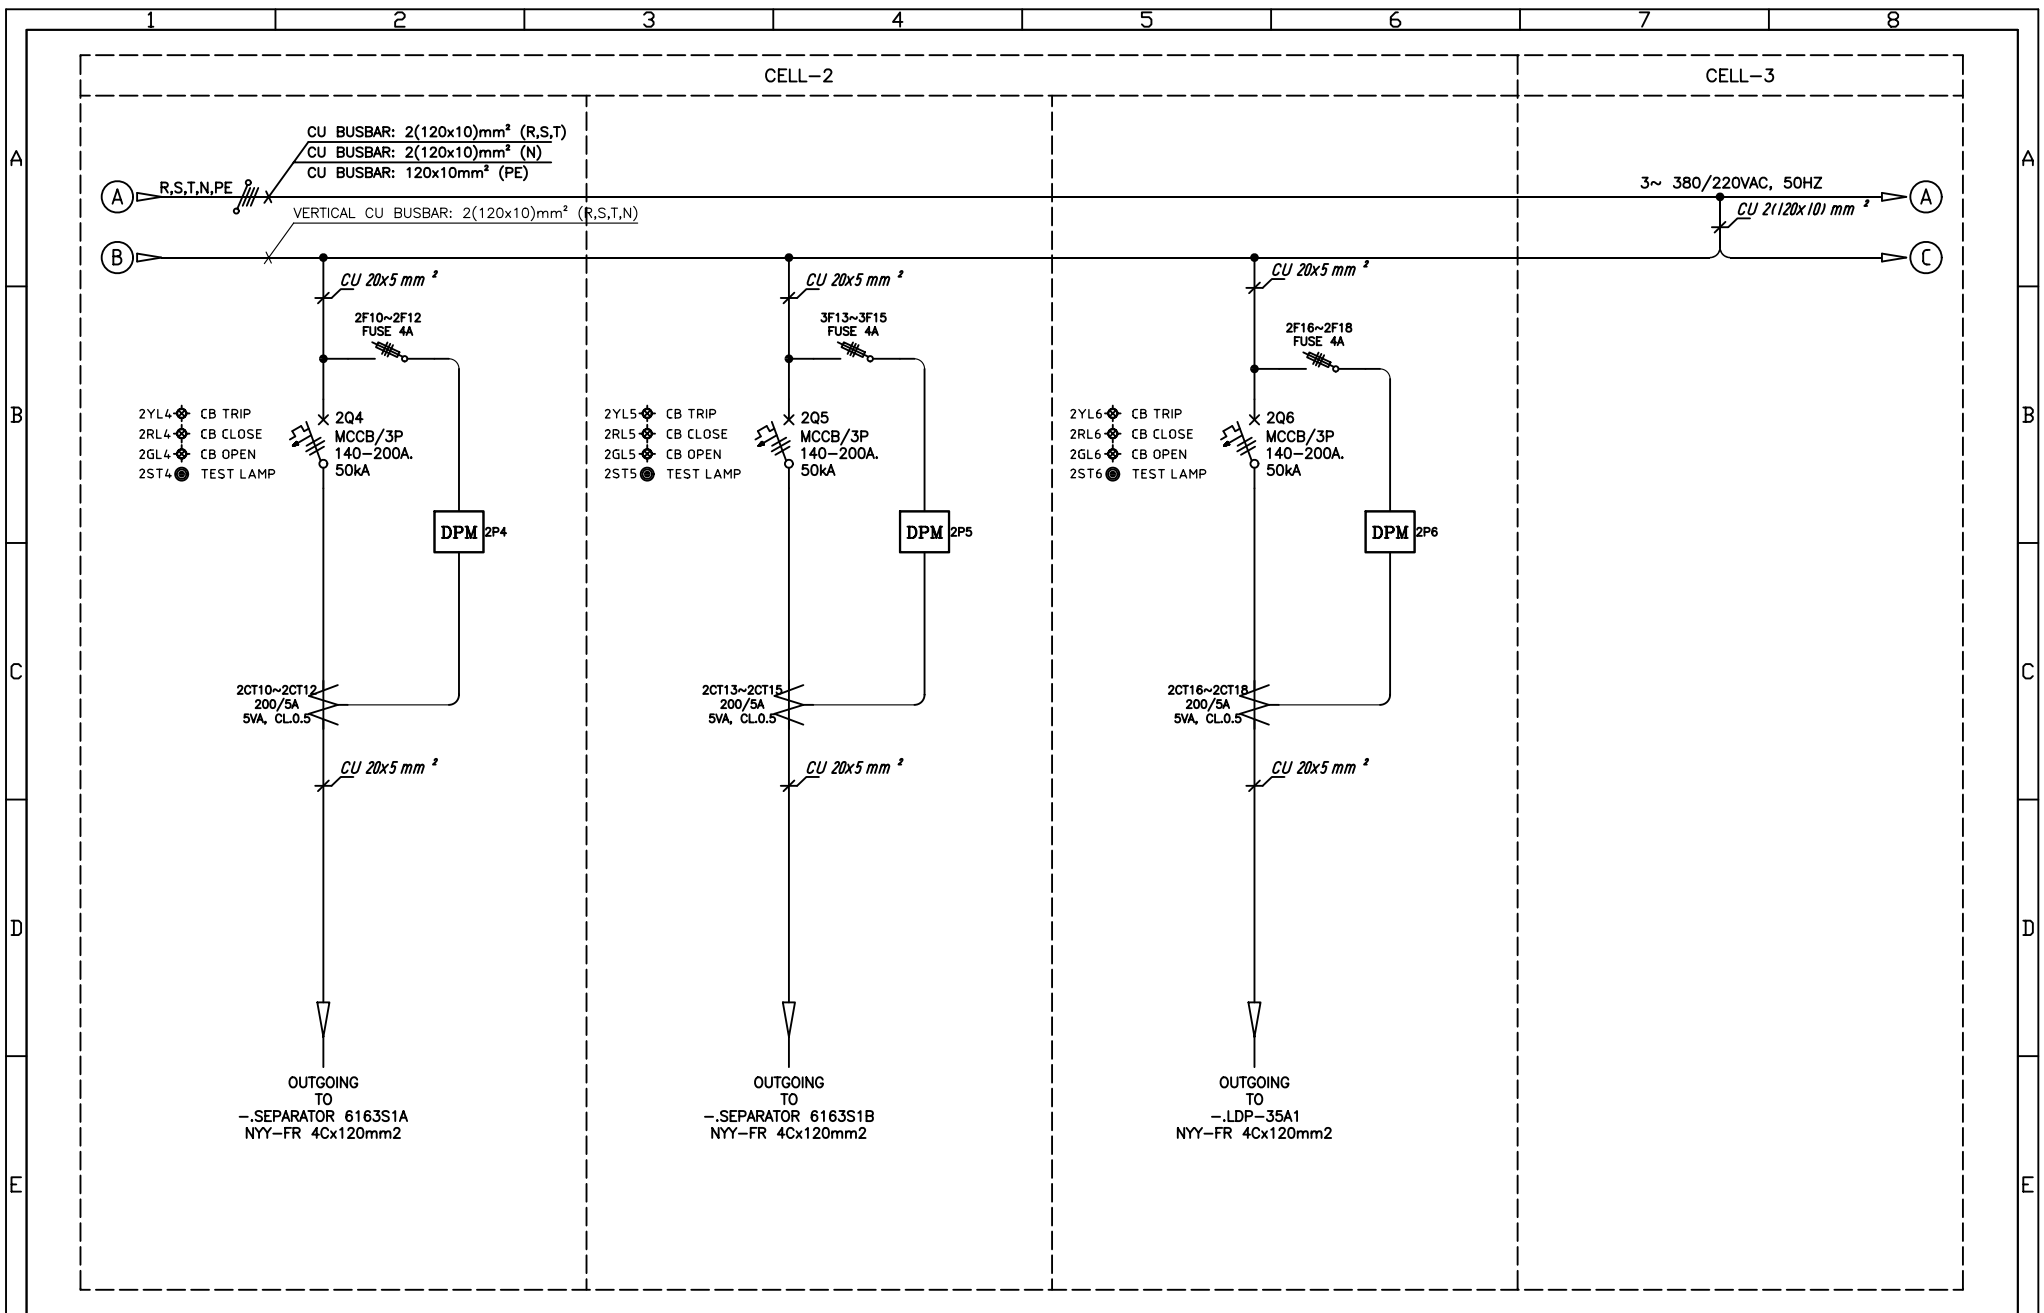


PROJECT :		DRAWING TITLE :		DATE	DRAWN	SIGN	VERIFIED	SIGN	DESCRIPTION	REV	PAGE
MNA WILMAR		SINGLE LINE DIAGRAM		30-05-2020	YD		SBR		FOR PRODUCTION R1	△	9
PT. ABB SAKTI INDUSTRI		LVD-35A (BIODIESEL A)		29-06-2020	YD		SBR		FOR PRODUCTION R2	△	
		NO DR/JO : JO-004/IND.2020		01-07-2020	YD		SBR		FOR PRODUCTION R3	△	
		NO DWG. : ABB-001		17-09-2020	YD		SBR		AS BUILT DRAWING	△	
		SCALE : NTS		Dimension in mm							29

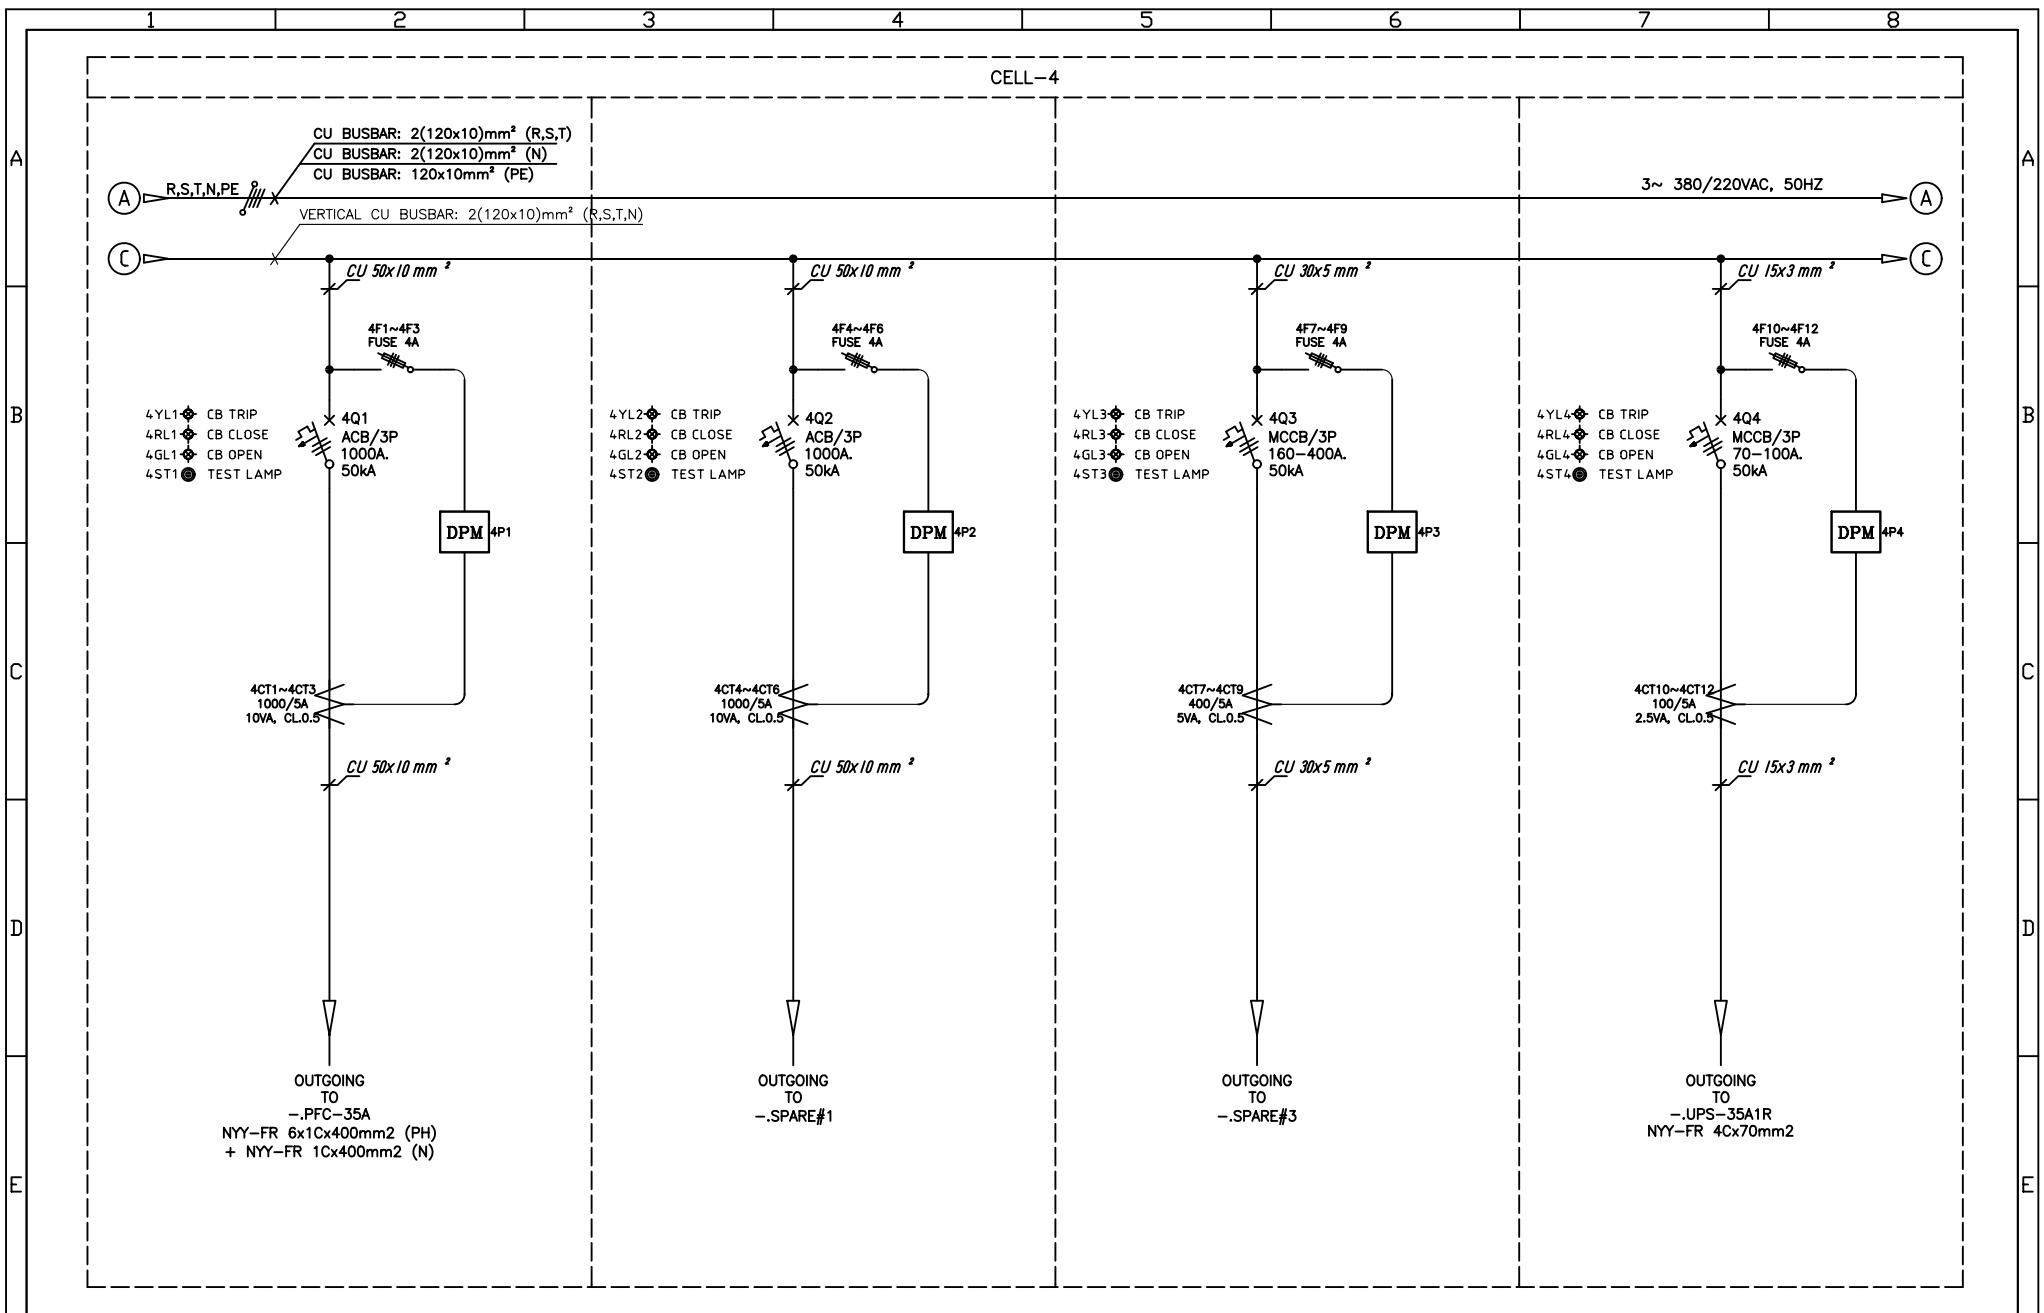


PMElectric Best Value Electrical Solution	PROJECT :	MNA WILMAR	DRAWING TITLE :	SINGLE LINE DIAGRAM LVD-35A (BIO DIESEL A)	DATE	DRAWN	SIGN	VERIFIED	SIGN	DESCRIPTION	REV	PAGE
	CUSTOMER :	PT. ABB SAKTI INDUSTRI	NO DR/JO :	JO-004/IND.2020	30-05-2020	YD		SBR		FOR PRODUCTION R1	△	10
			NO DWG. :	ABB-001	29-06-2020	YD	YD	SBR		FOR PRODUCTION R2	△	
					01-07-2020	YD	YD	SBR		FOR PRODUCTION R3	△	
					17-09-2020	YD		SBR		AS BUILT DRAWING	△	29

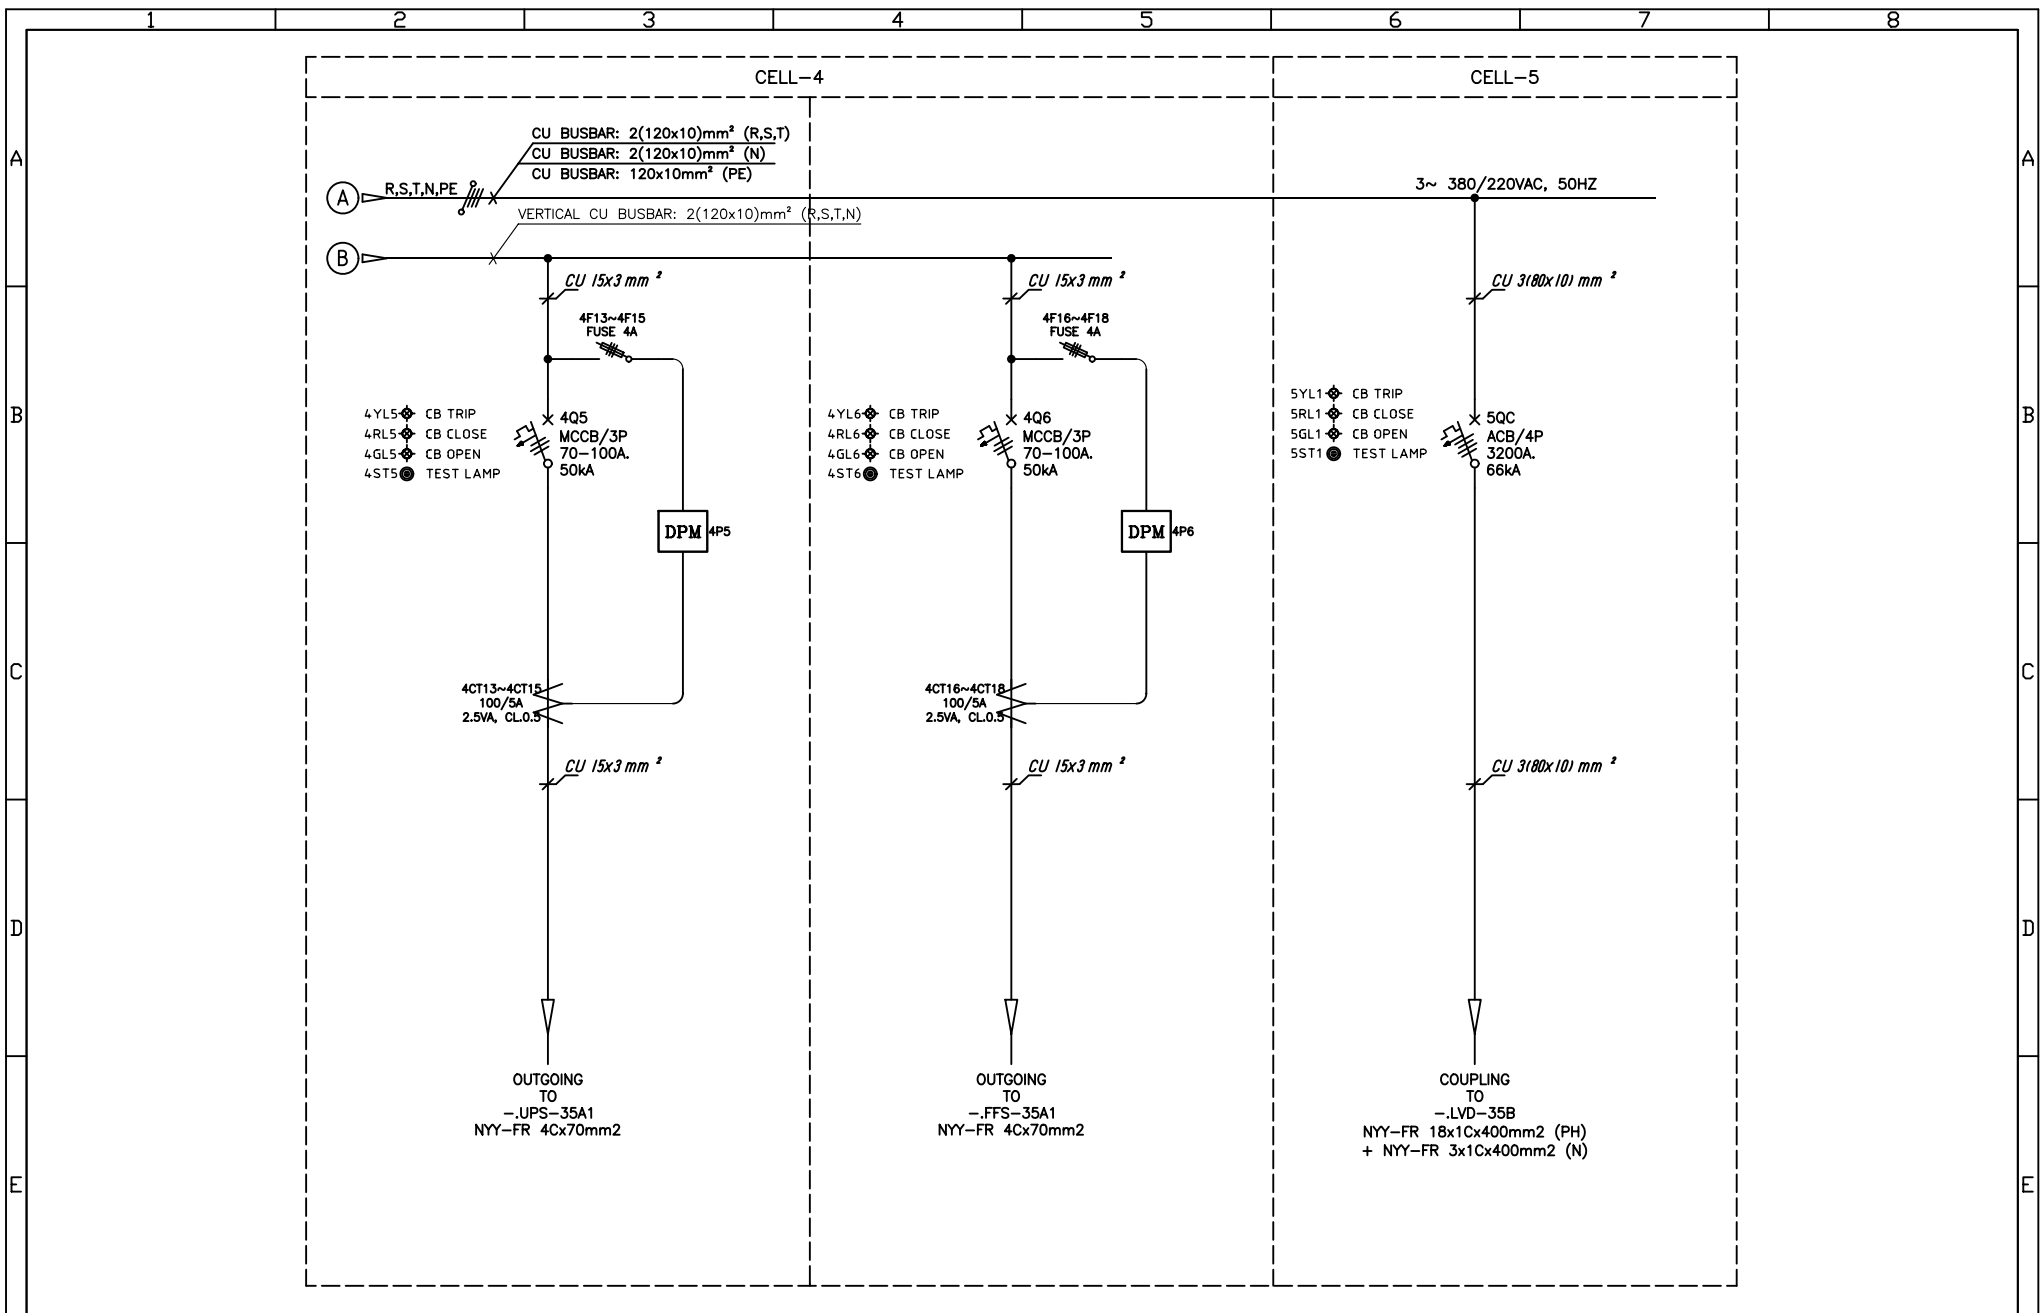


1		2		3		4		5		6		7		8			
 PMElectric Best Value Electrical Solution				PROJECT : MNA WILMAR		DRAWING TITLE : SINGLE LINE DIAGRAM LVD-35A (BIO DIESEL A)				DATE 30-05-2020	DRAWN YD	SIGN	VERIFIED SBR	SIGN	DESCRIPTION FOR PRODUCTION R1	REV A	PAGE 11 29
										29-06-2020	YD		SBR		FOR PRODUCTION R2	B	
										01-07-2020	YD		SBR		FOR PRODUCTION R3	C	
										17-09-2020	YD		SBR		AS BUILT DRAWING	D	
										SCALE : NTS		Dimension in mm					
				CUSTOMER : PT. ABB SAKTI INDUSTRI		NO DR/JO : JO-004/IND.2020		NO DWG. : ABB-001									

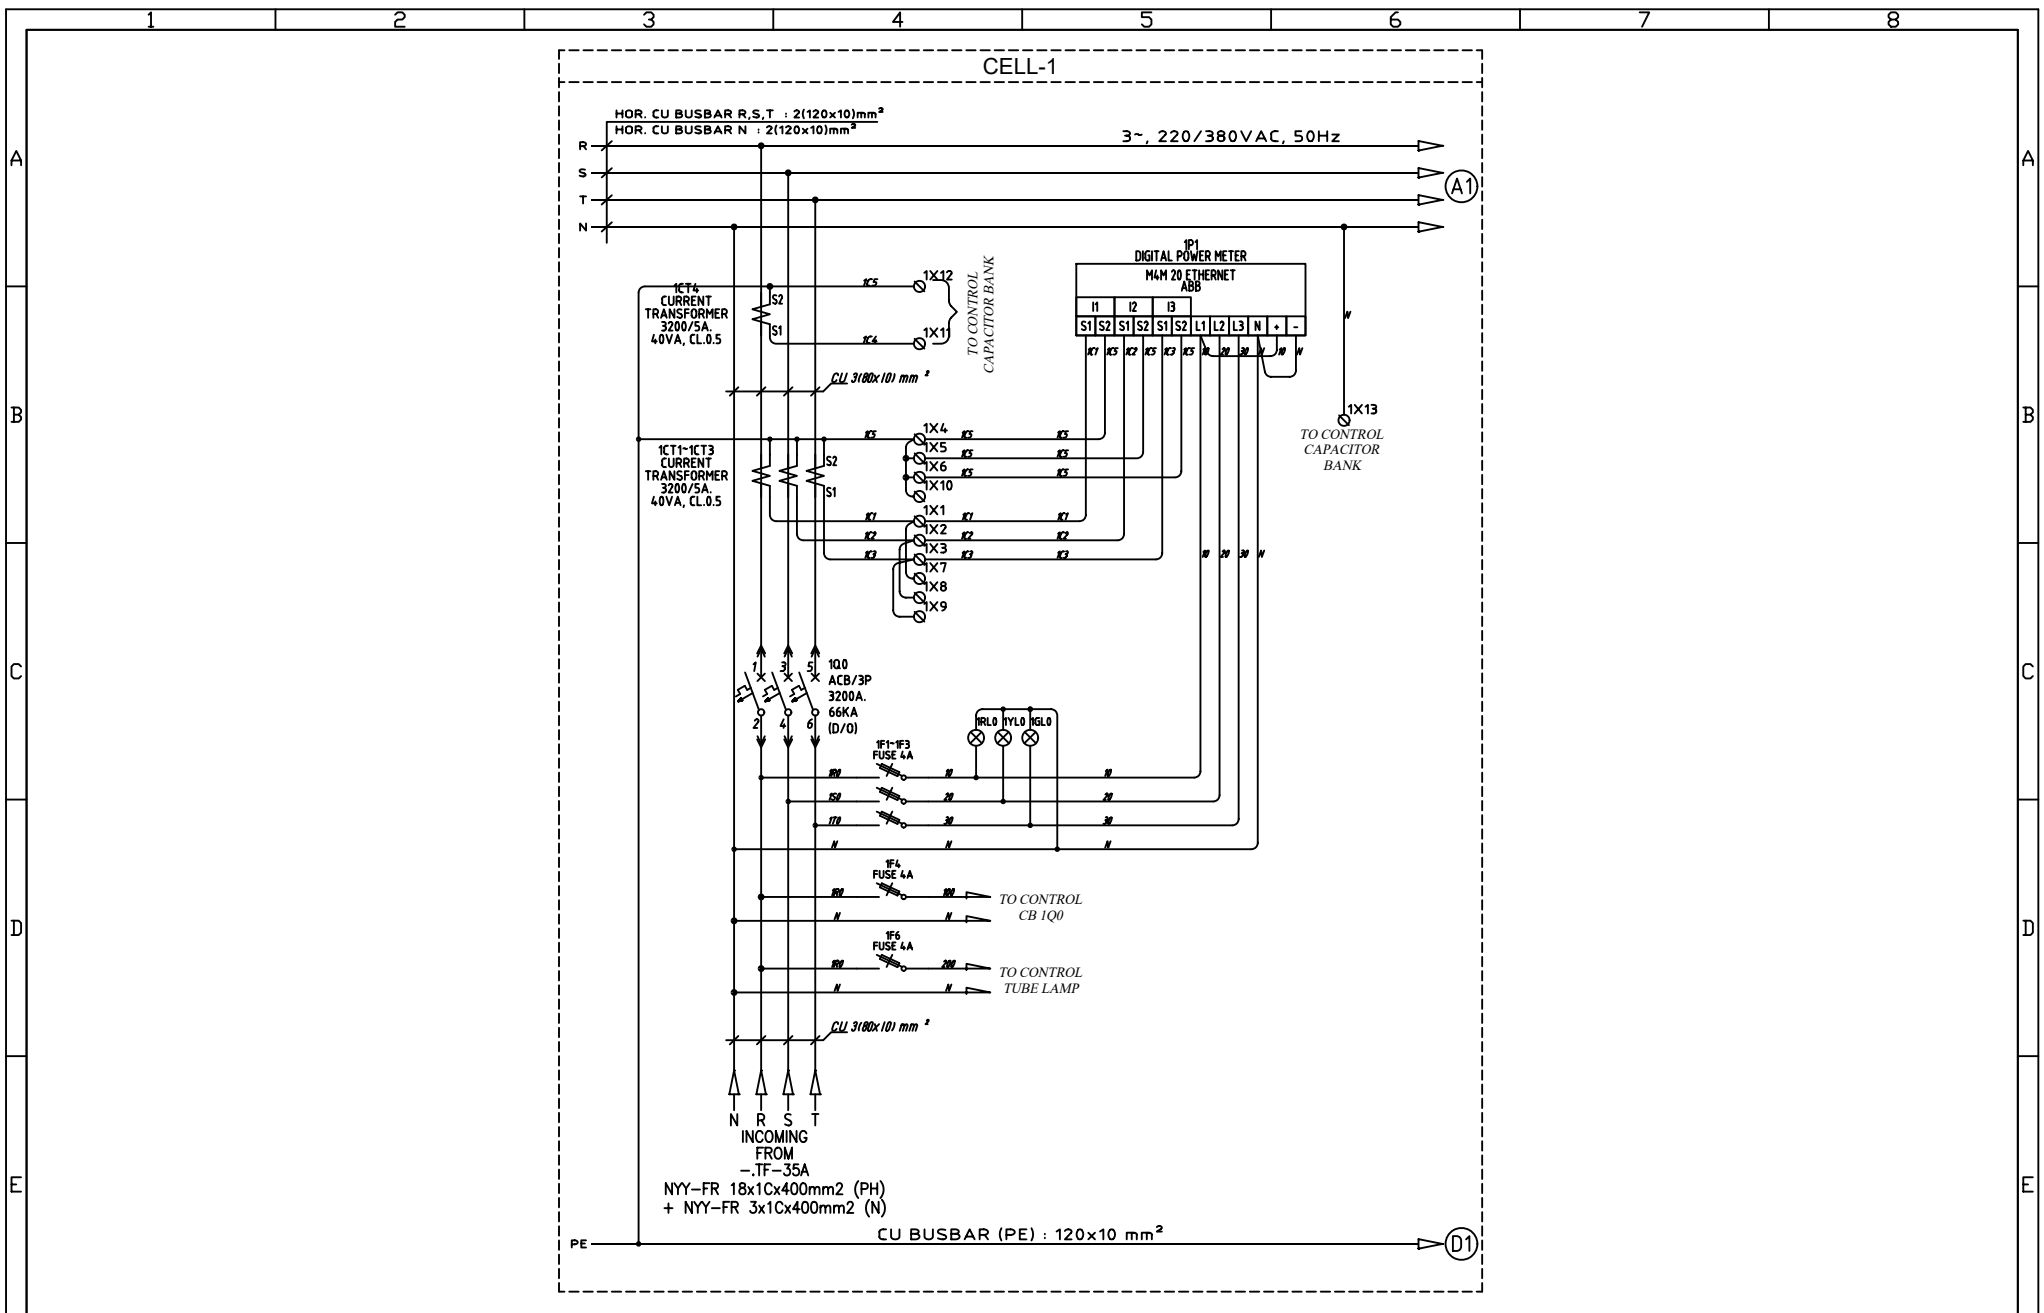


 PMElectric Best Value Electrical Solution	PROJECT :	MNA WILMAR	DRAWING TITLE :		DATE	DRAWN	SIGN	VERIFIED	SIGN	DESCRIPTION	REV	PAGE
	CUSTOMER :	PT. ABB SAKTI INDUSTRI	THREE LINE DIAGRAM		30-05-2020	YD		SBR		FOR PRODUCTION R1	△	12
			LVD-35A (BIODIESEL A)		29-06-2020	YD		SBR		FOR PRODUCTION R2	△	
			NO DR/JO : JO-004/IND.2020		01-07-2020	YD		SBR		FOR PRODUCTION R3	△	
			NO DWG. : ABB-001		17-09-2020	YD		SBR		AS BUILT DRAWING	△	
		SCALE : NTS		Dimension in mm		29						

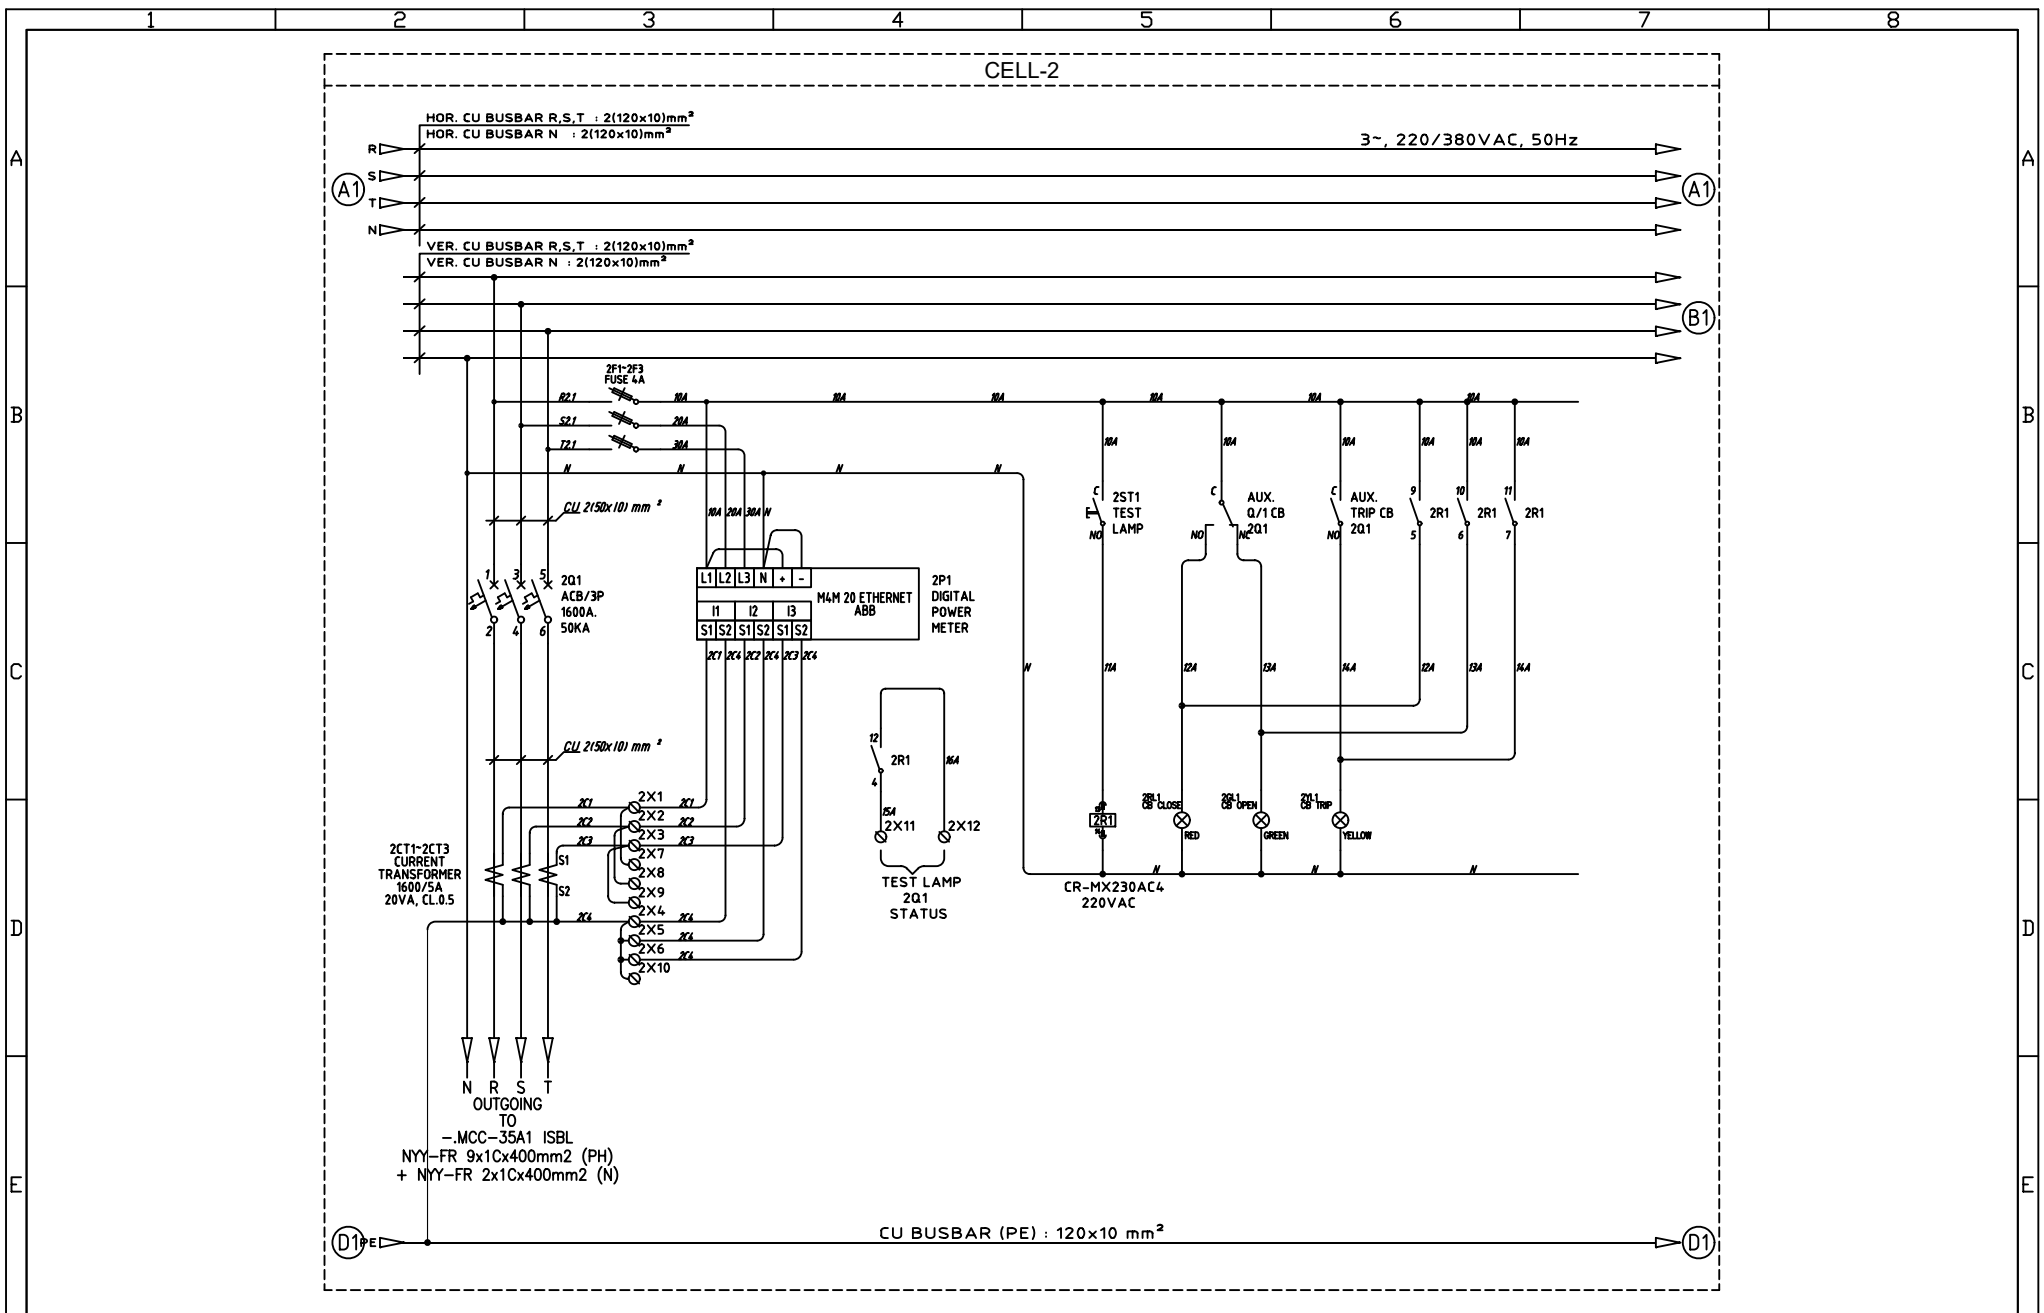



PMElectric Best Value Electrical Solution	PROJECT :	MNA WILMAR	DRAWING TITLE :	THREE LINE DIAGRAM LVD-35A (BIODIESEL A)	DATE	DRAWN	SIGN	VERIFIED	SIGN	DESCRIPTION	REV	PAGE
	CUSTOMER :	PT. ABB SAKTI INDUSTRI	NO DR/JO :	JO-004/IND.2020	30-05-2020	YD		SBR		FOR PRODUCTION R1	△	13
			NO DWG. :	ABB-001	29-06-2020	YD		SBR		FOR PRODUCTION R2	△	
					01-07-2020	YD		SBR		FOR PRODUCTION R3	△	
					17-09-2020	YD		SBR		AS BUILT DRAWING	△	

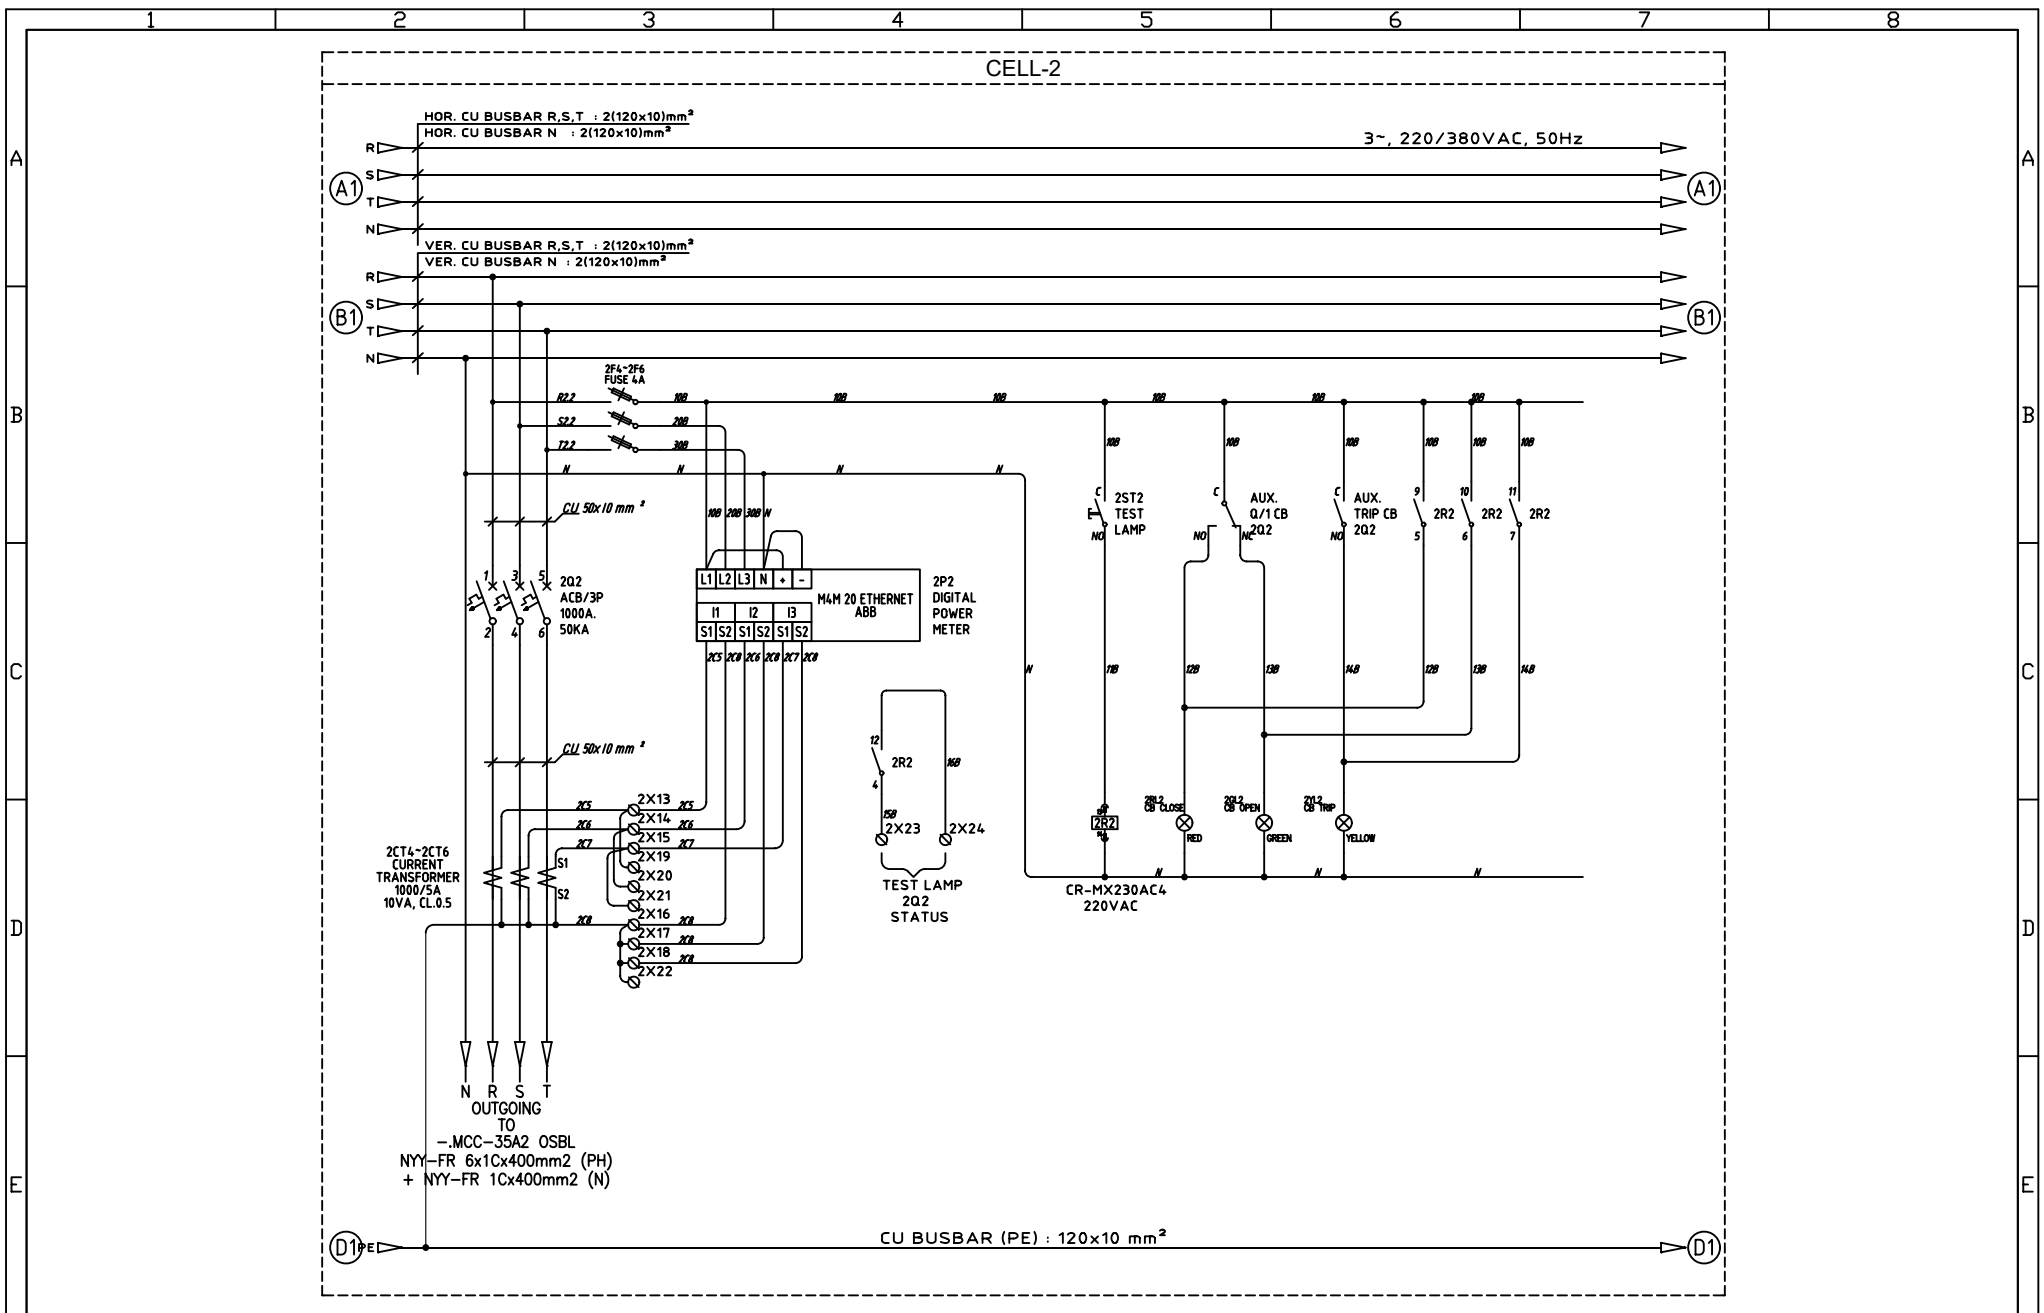



PMElectric Best Value Electrical Solution	PROJECT :	MNA WILMAR	DRAWING TITLE :	THREE LINE DIAGRAM LVD-35A (BIO DIESEL A)	DATE	DRAWN	SIGN	VERIFIED	SIGN	DESCRIPTION	REV	PAGE
	CUSTOMER :	PT. ABB SAKTI INDUSTRI	NO DR/JO : JO-004/IND.2020	SCALE : NTS	30-05-2020	YD		SBR		FOR PRODUCTION R1	1	14
			NO DWG. : ABB-001	Dimension in mm	29-06-2020	YD	YD	SBR		FOR PRODUCTION R2	2	
					01-07-2020	YD	YD	SBR		FOR PRODUCTION R3	3	
					17-09-2020	YD		SBR		AS BUILT DRAWING	4	

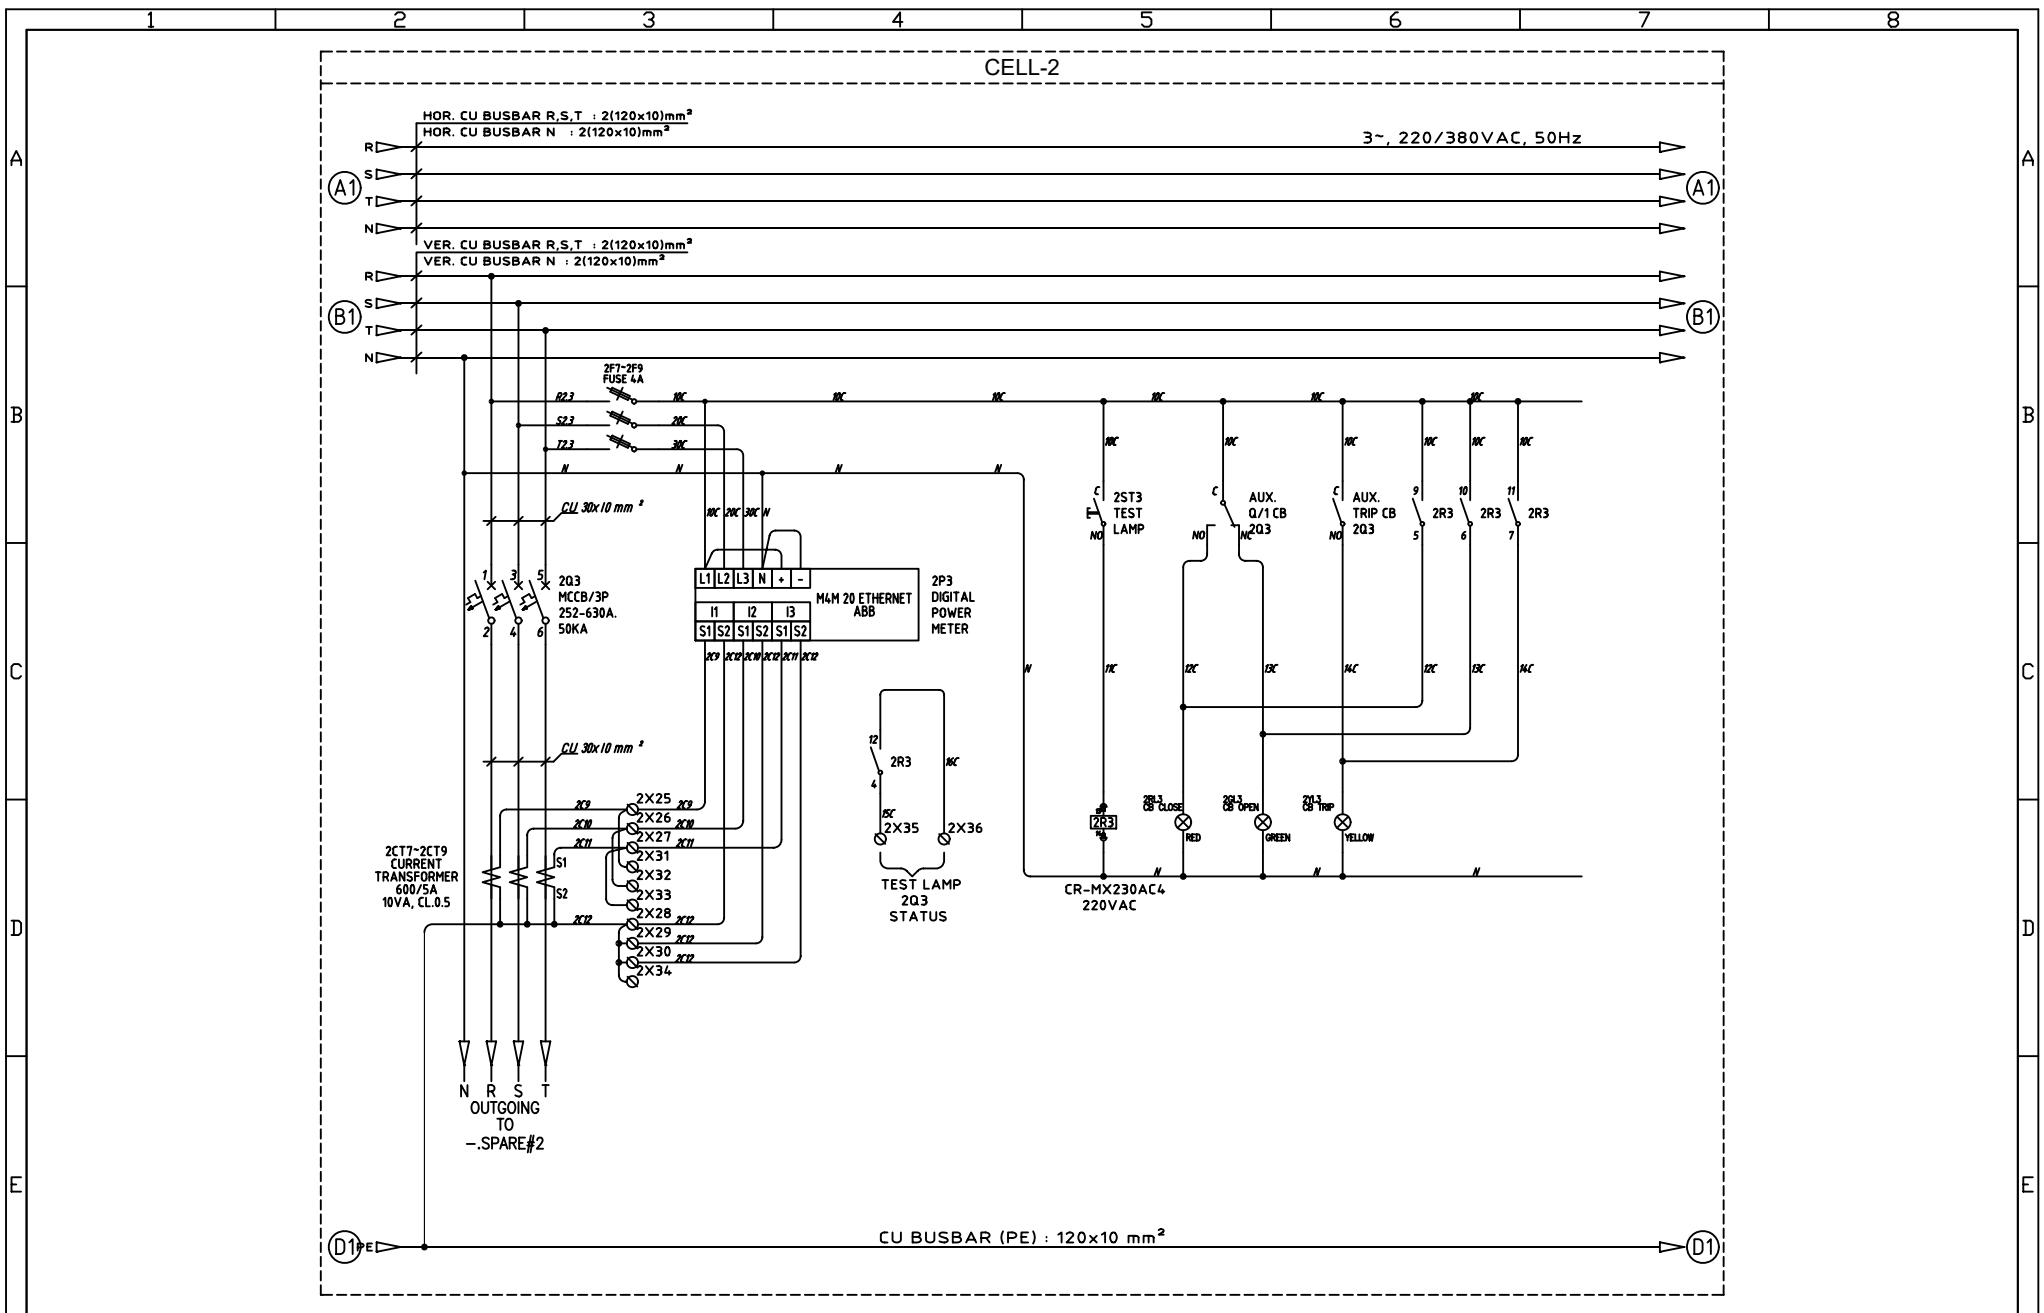


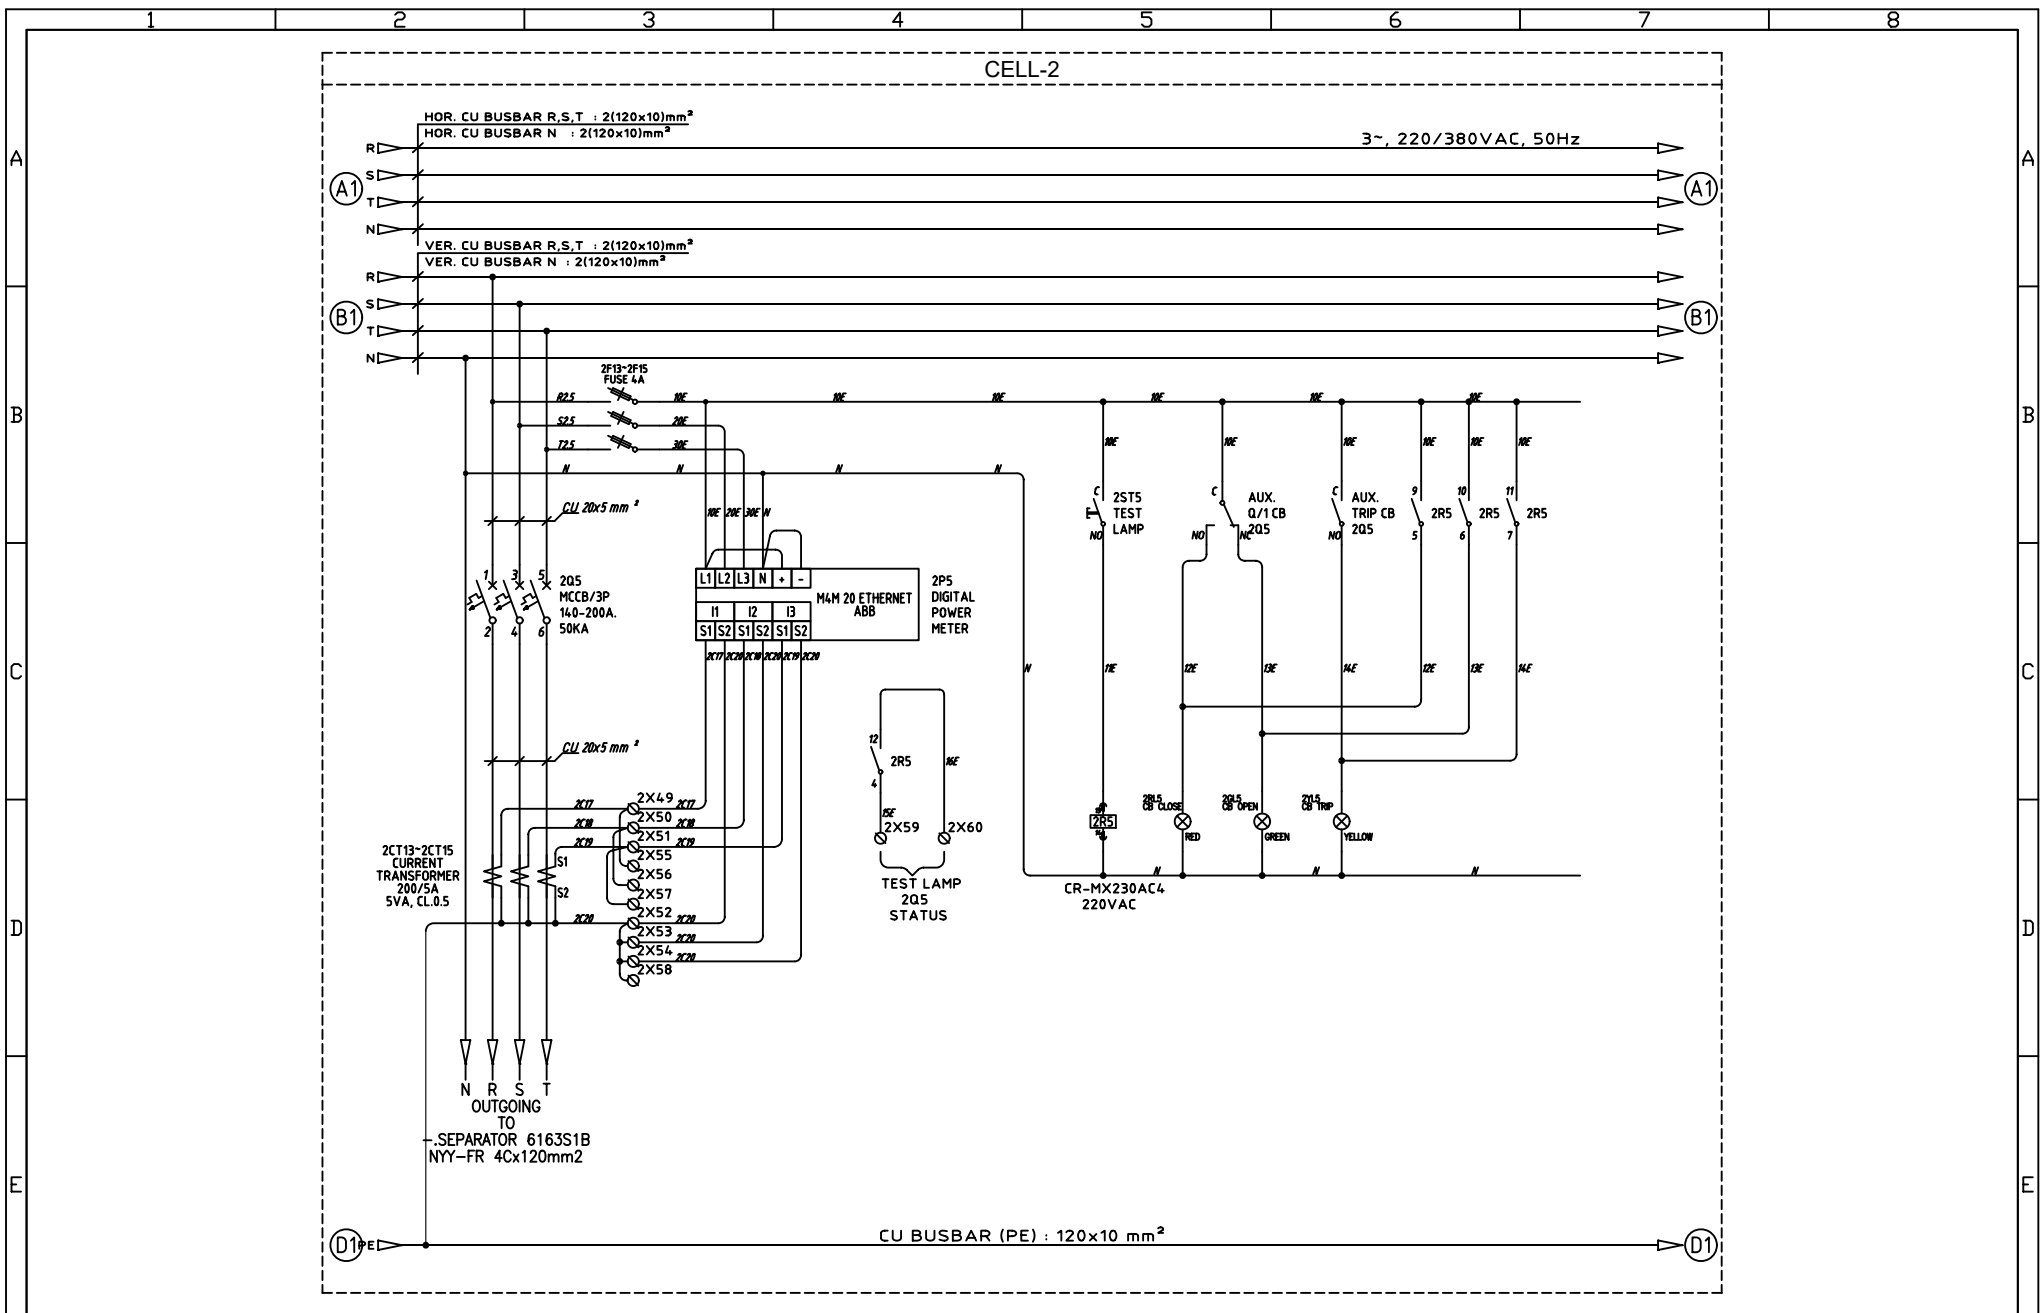

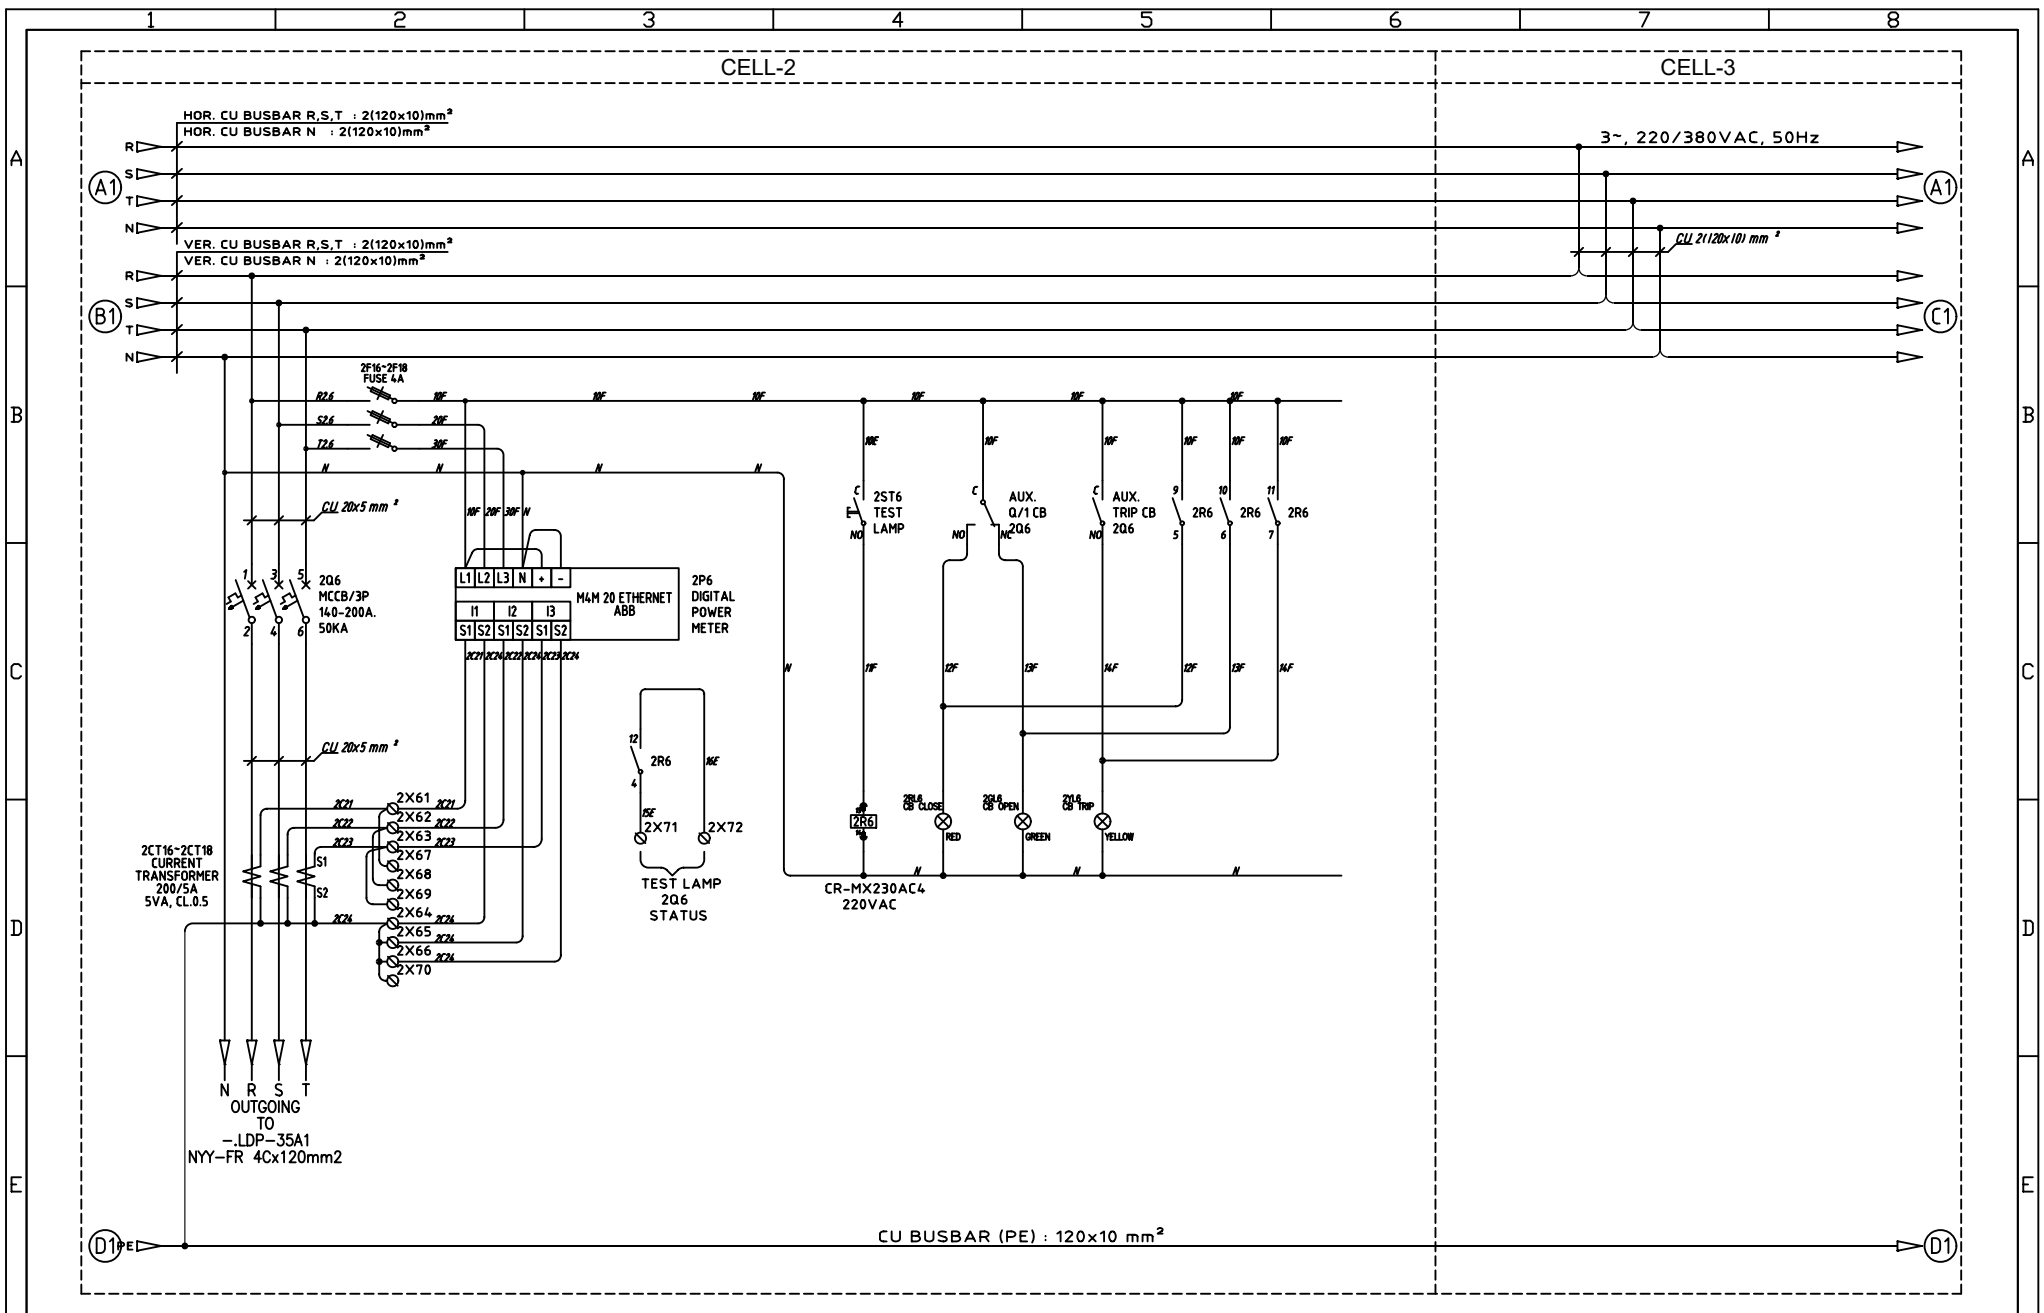


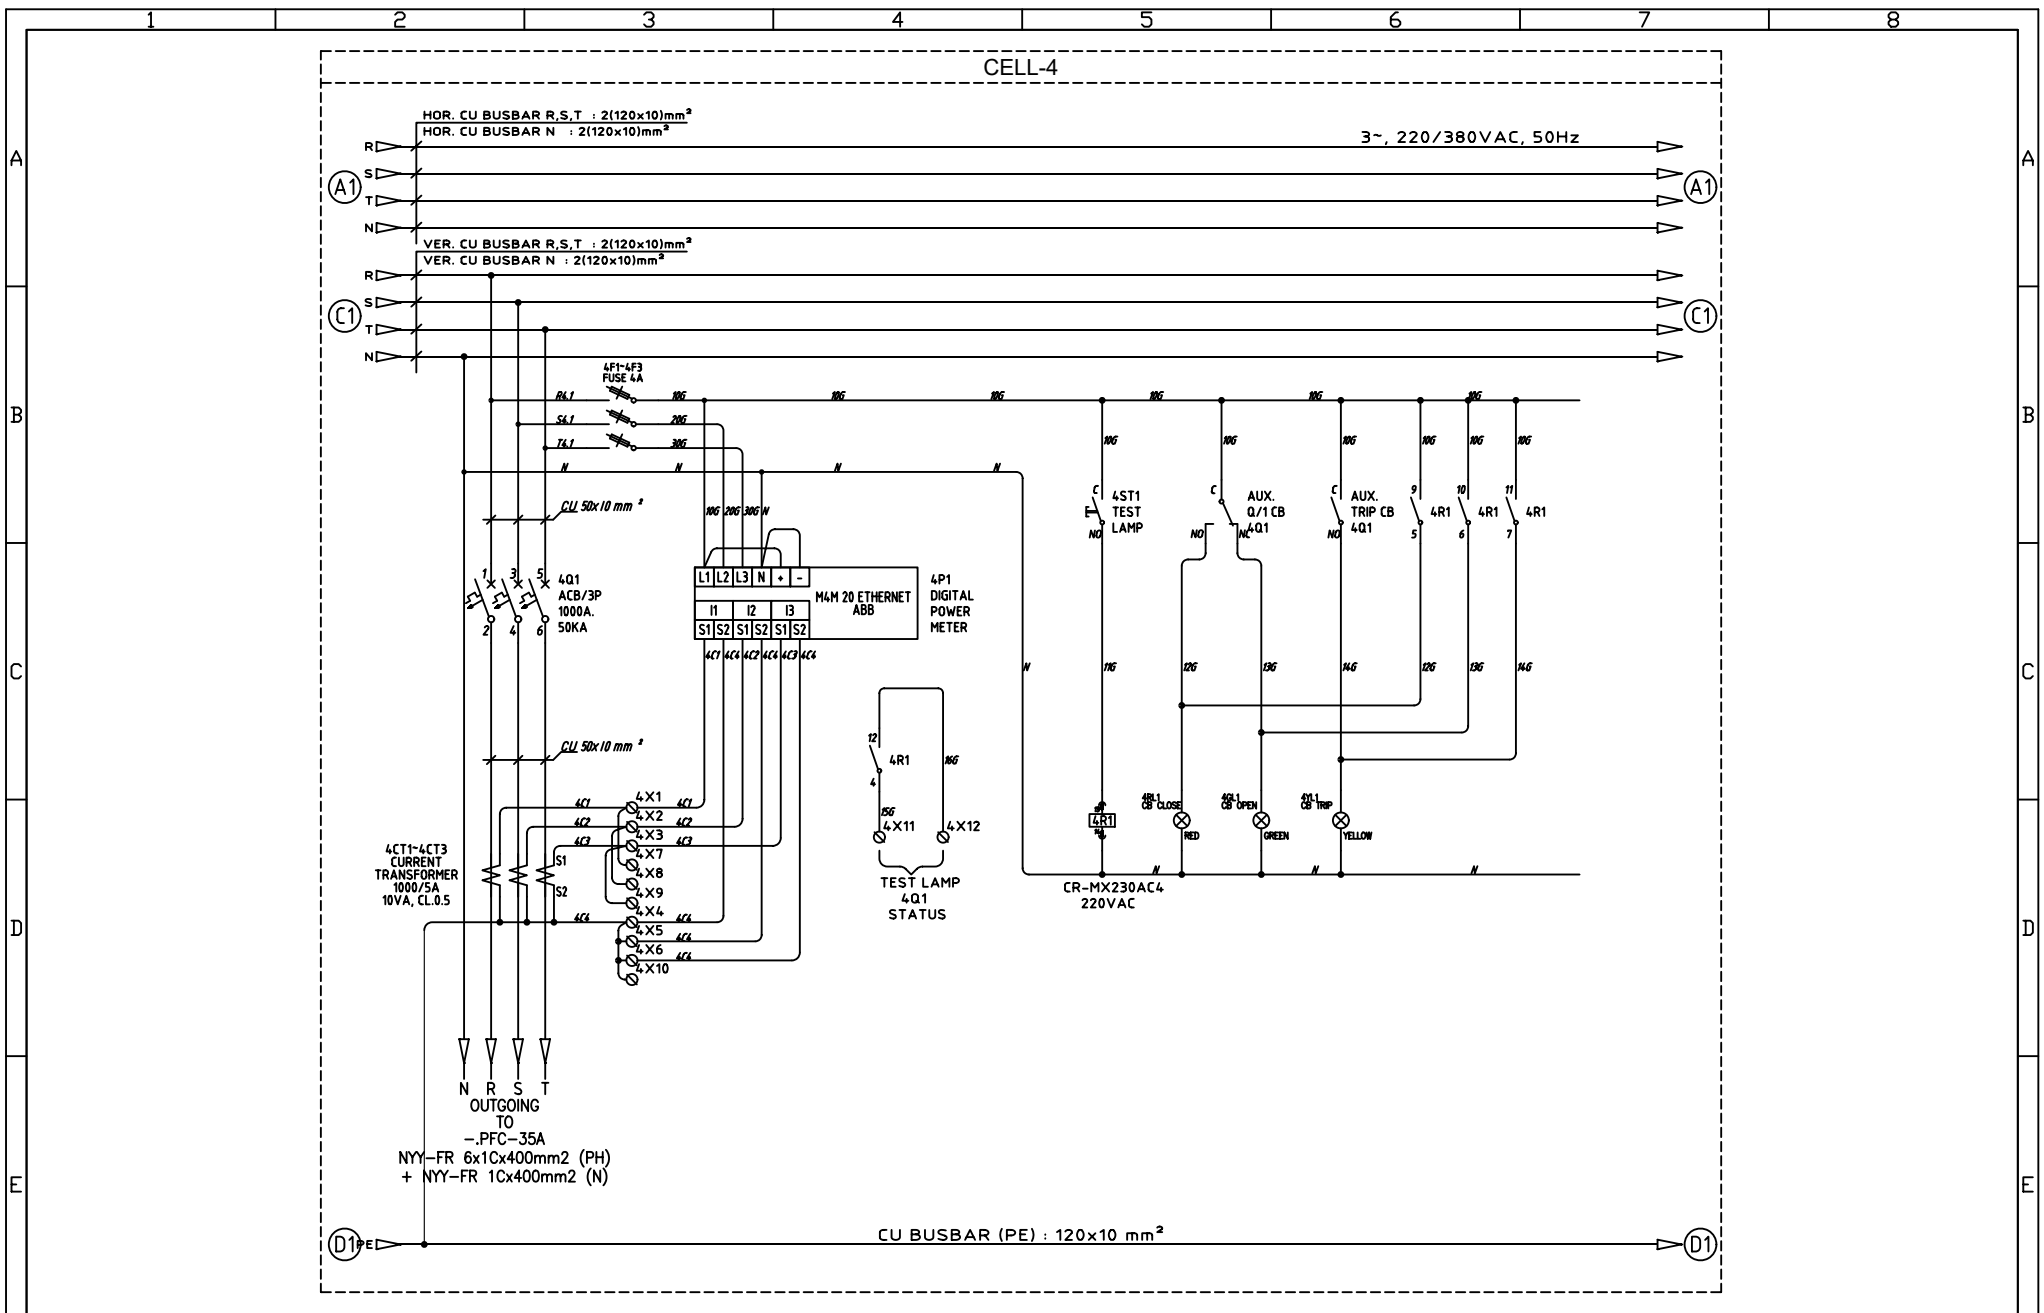

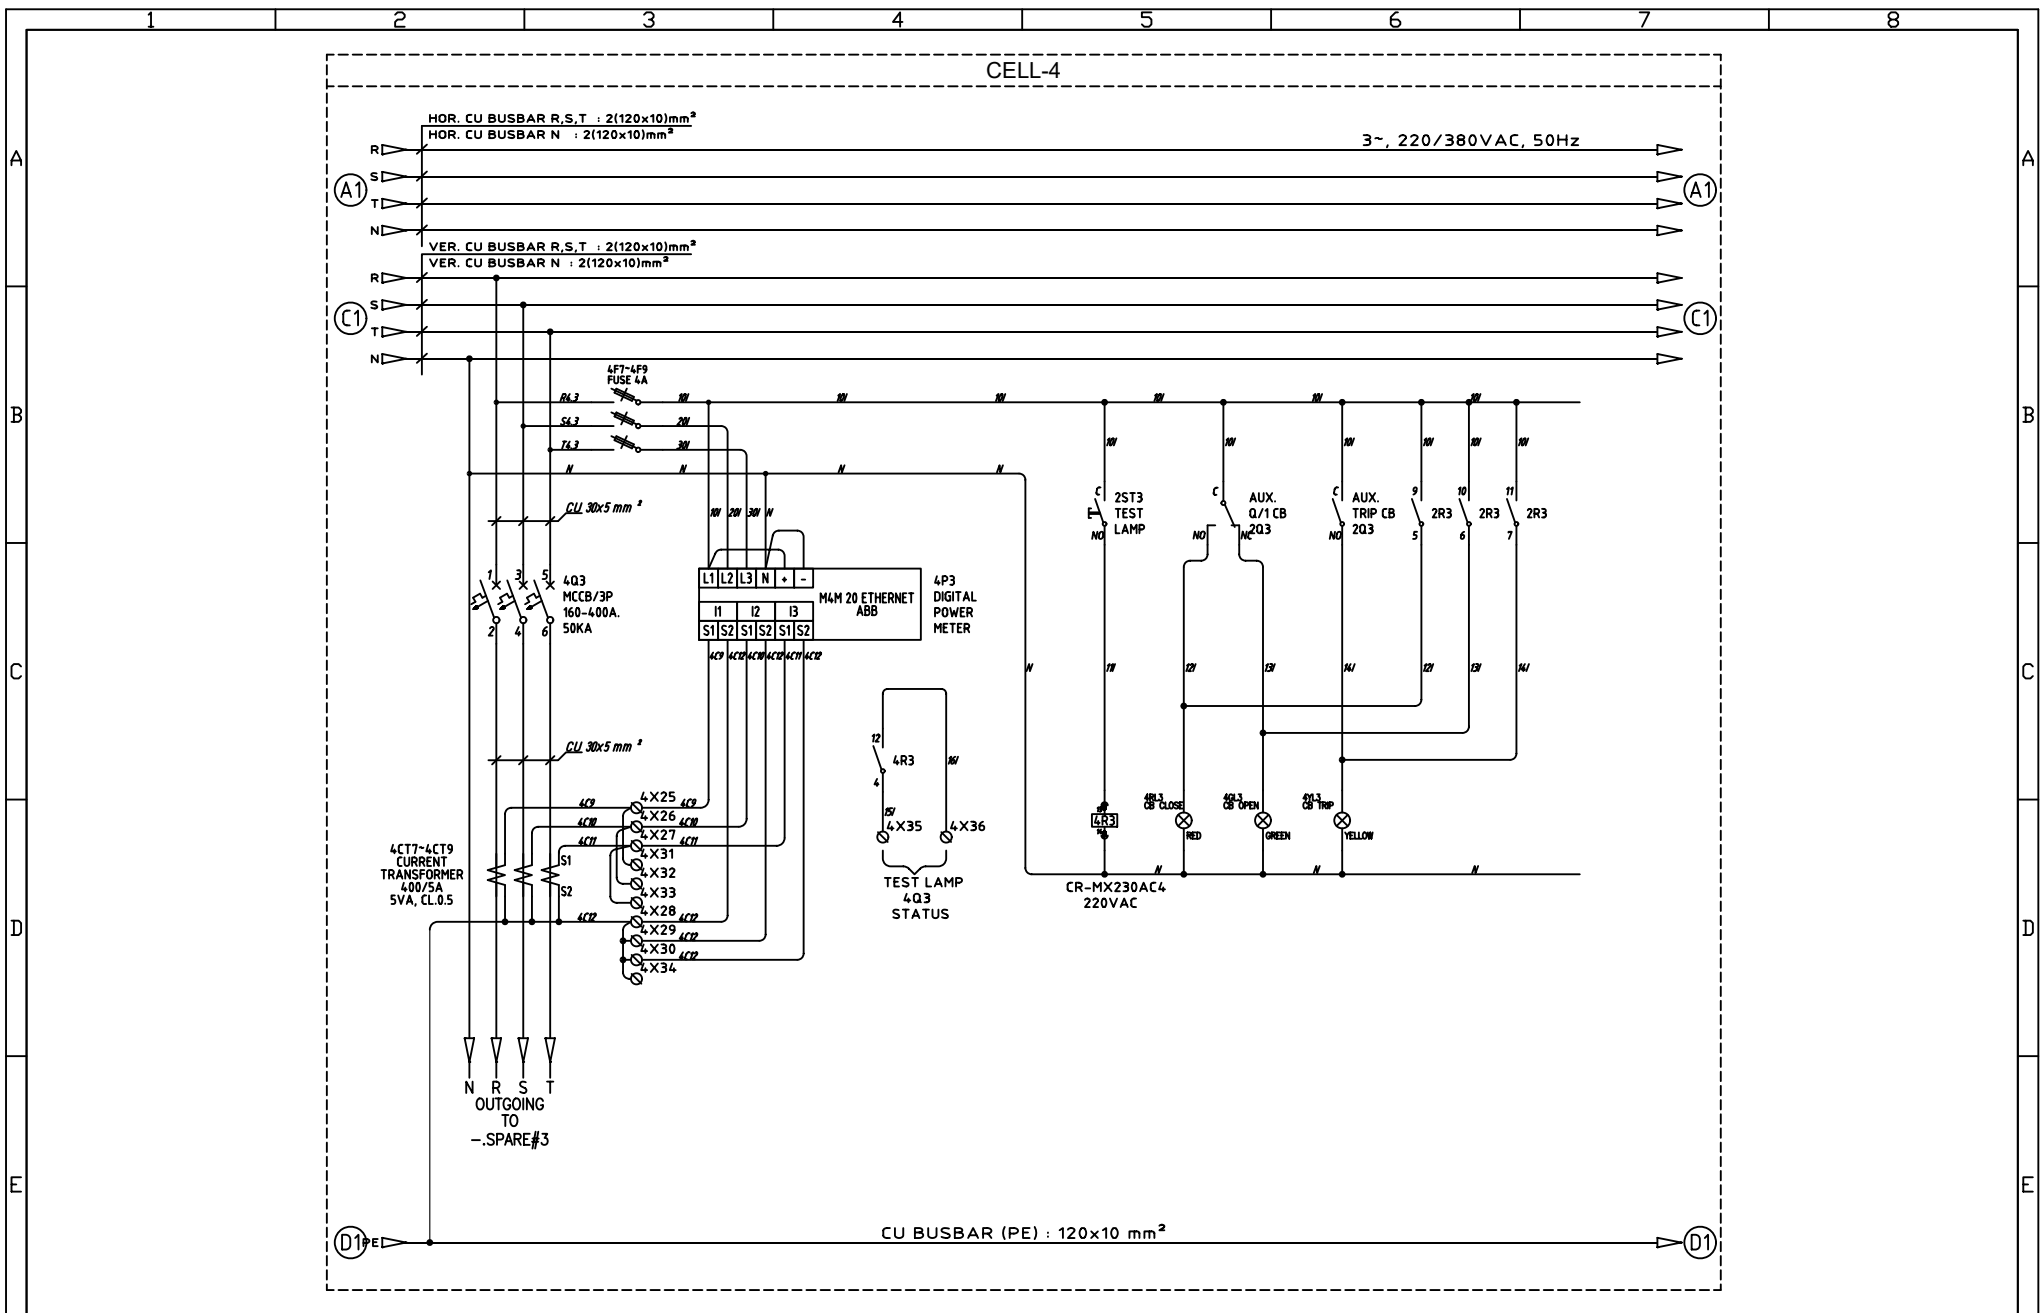


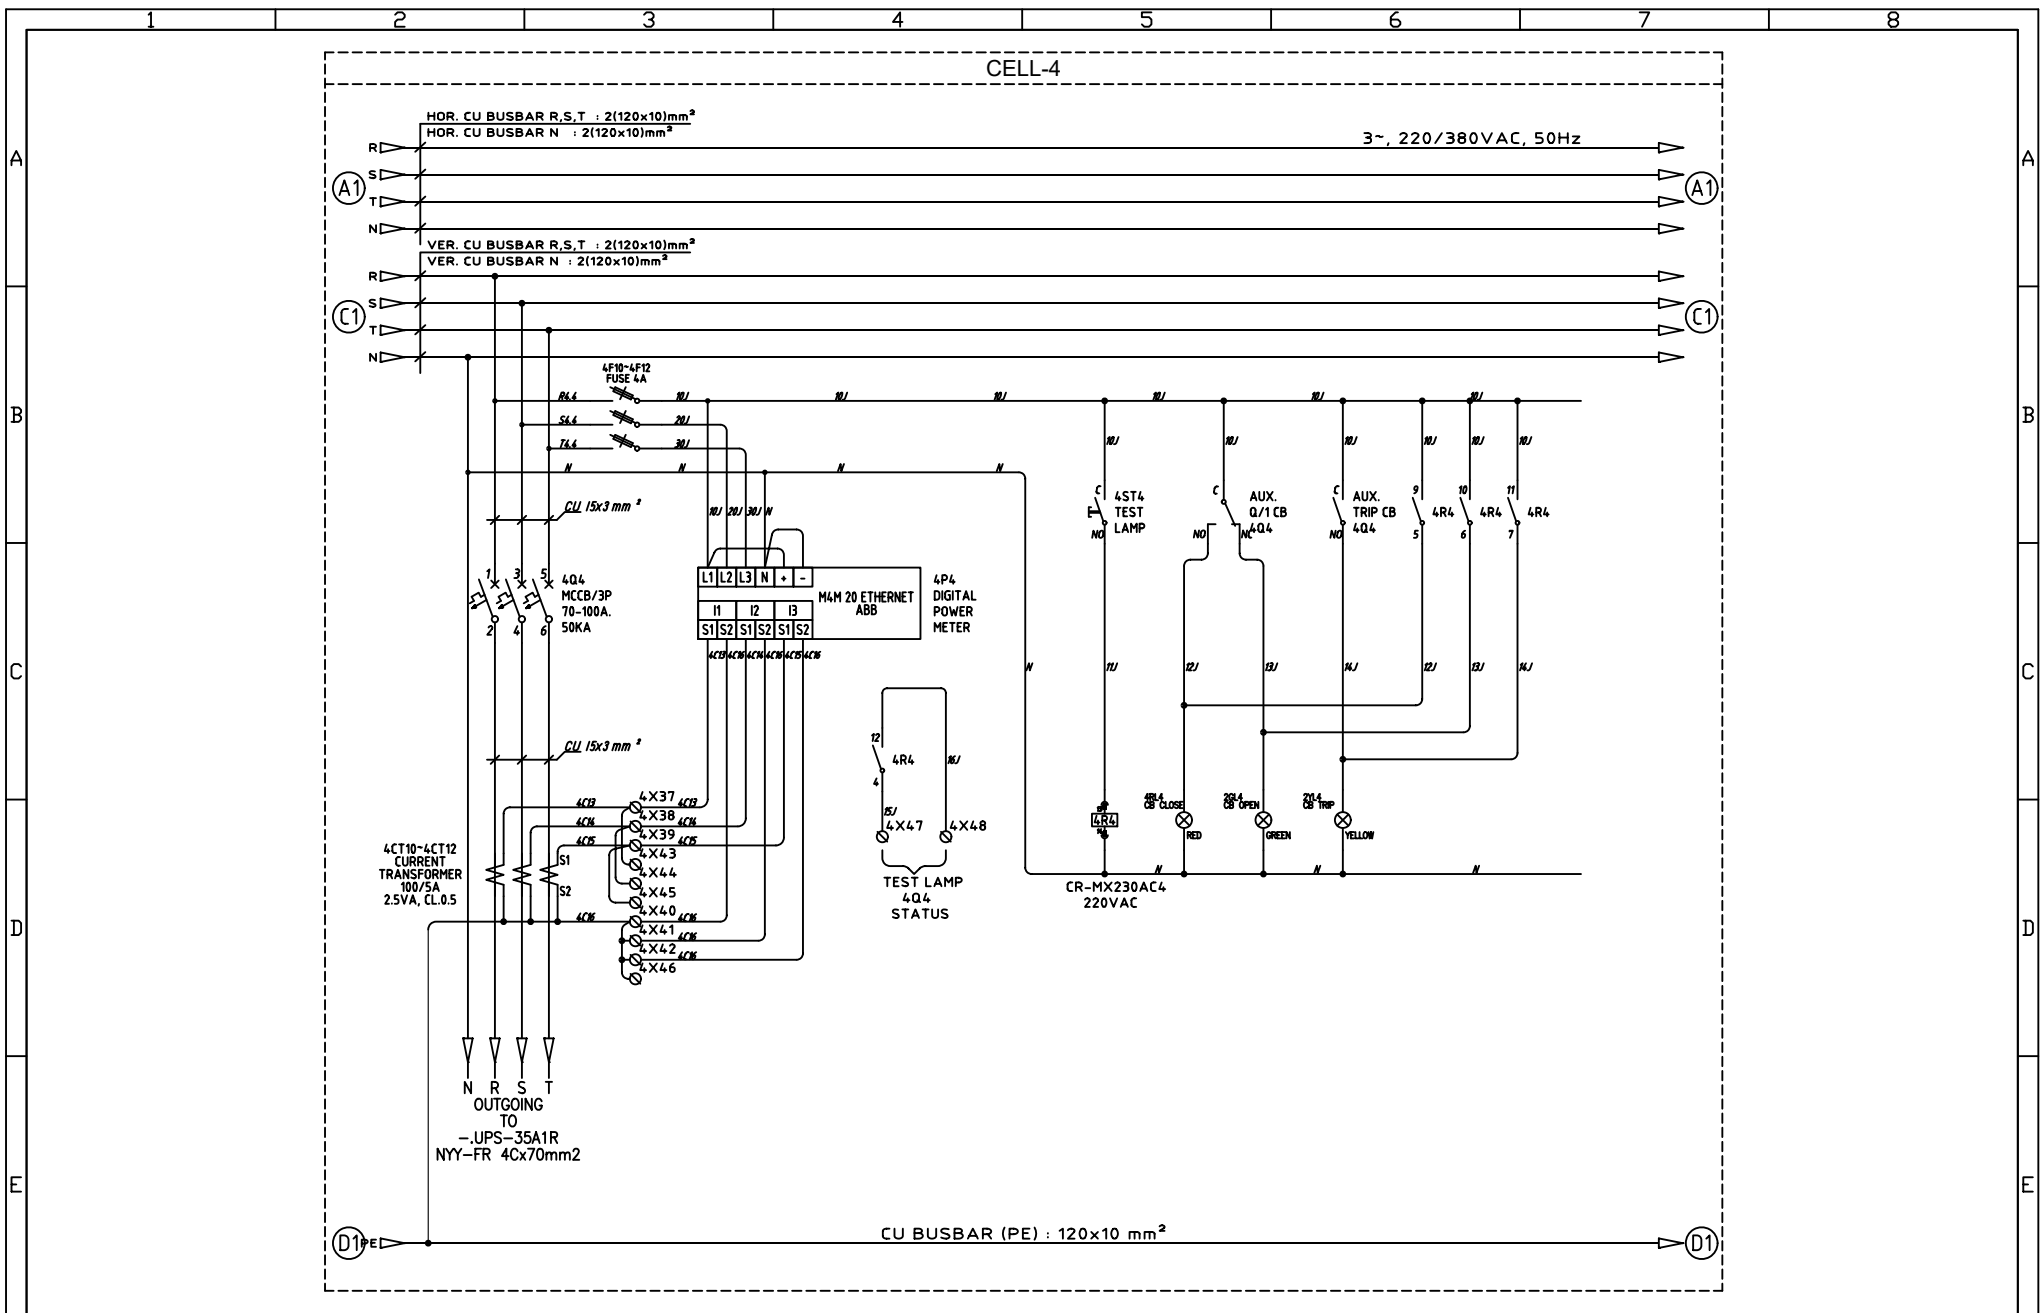

PMElectric Best Value Electrical Solution	PROJECT :	MNA WILMAR	DRAWING TITLE :	THREE LINE DIAGRAM LVD-35A (BIO DIESEL A)	DATE	DRAWN	SIGN	VERIFIED	SIGN	DESCRIPTION	REV	PAGE
	CUSTOMER :	PT. ABB SAKTI INDUSTRI	NO DR/JO :	JO-004/IND.2020	30-05-2020	YD		SBR		FOR PRODUCTION R1	△	22
			NO DWG. :	ABB-001	29-06-2020	YD		SBR		FOR PRODUCTION R2	△	
					01-07-2020	YD		SBR		FOR PRODUCTION R3	△	
					17-09-2020	YD		SBR		AS BUILT DRAWING	△	29

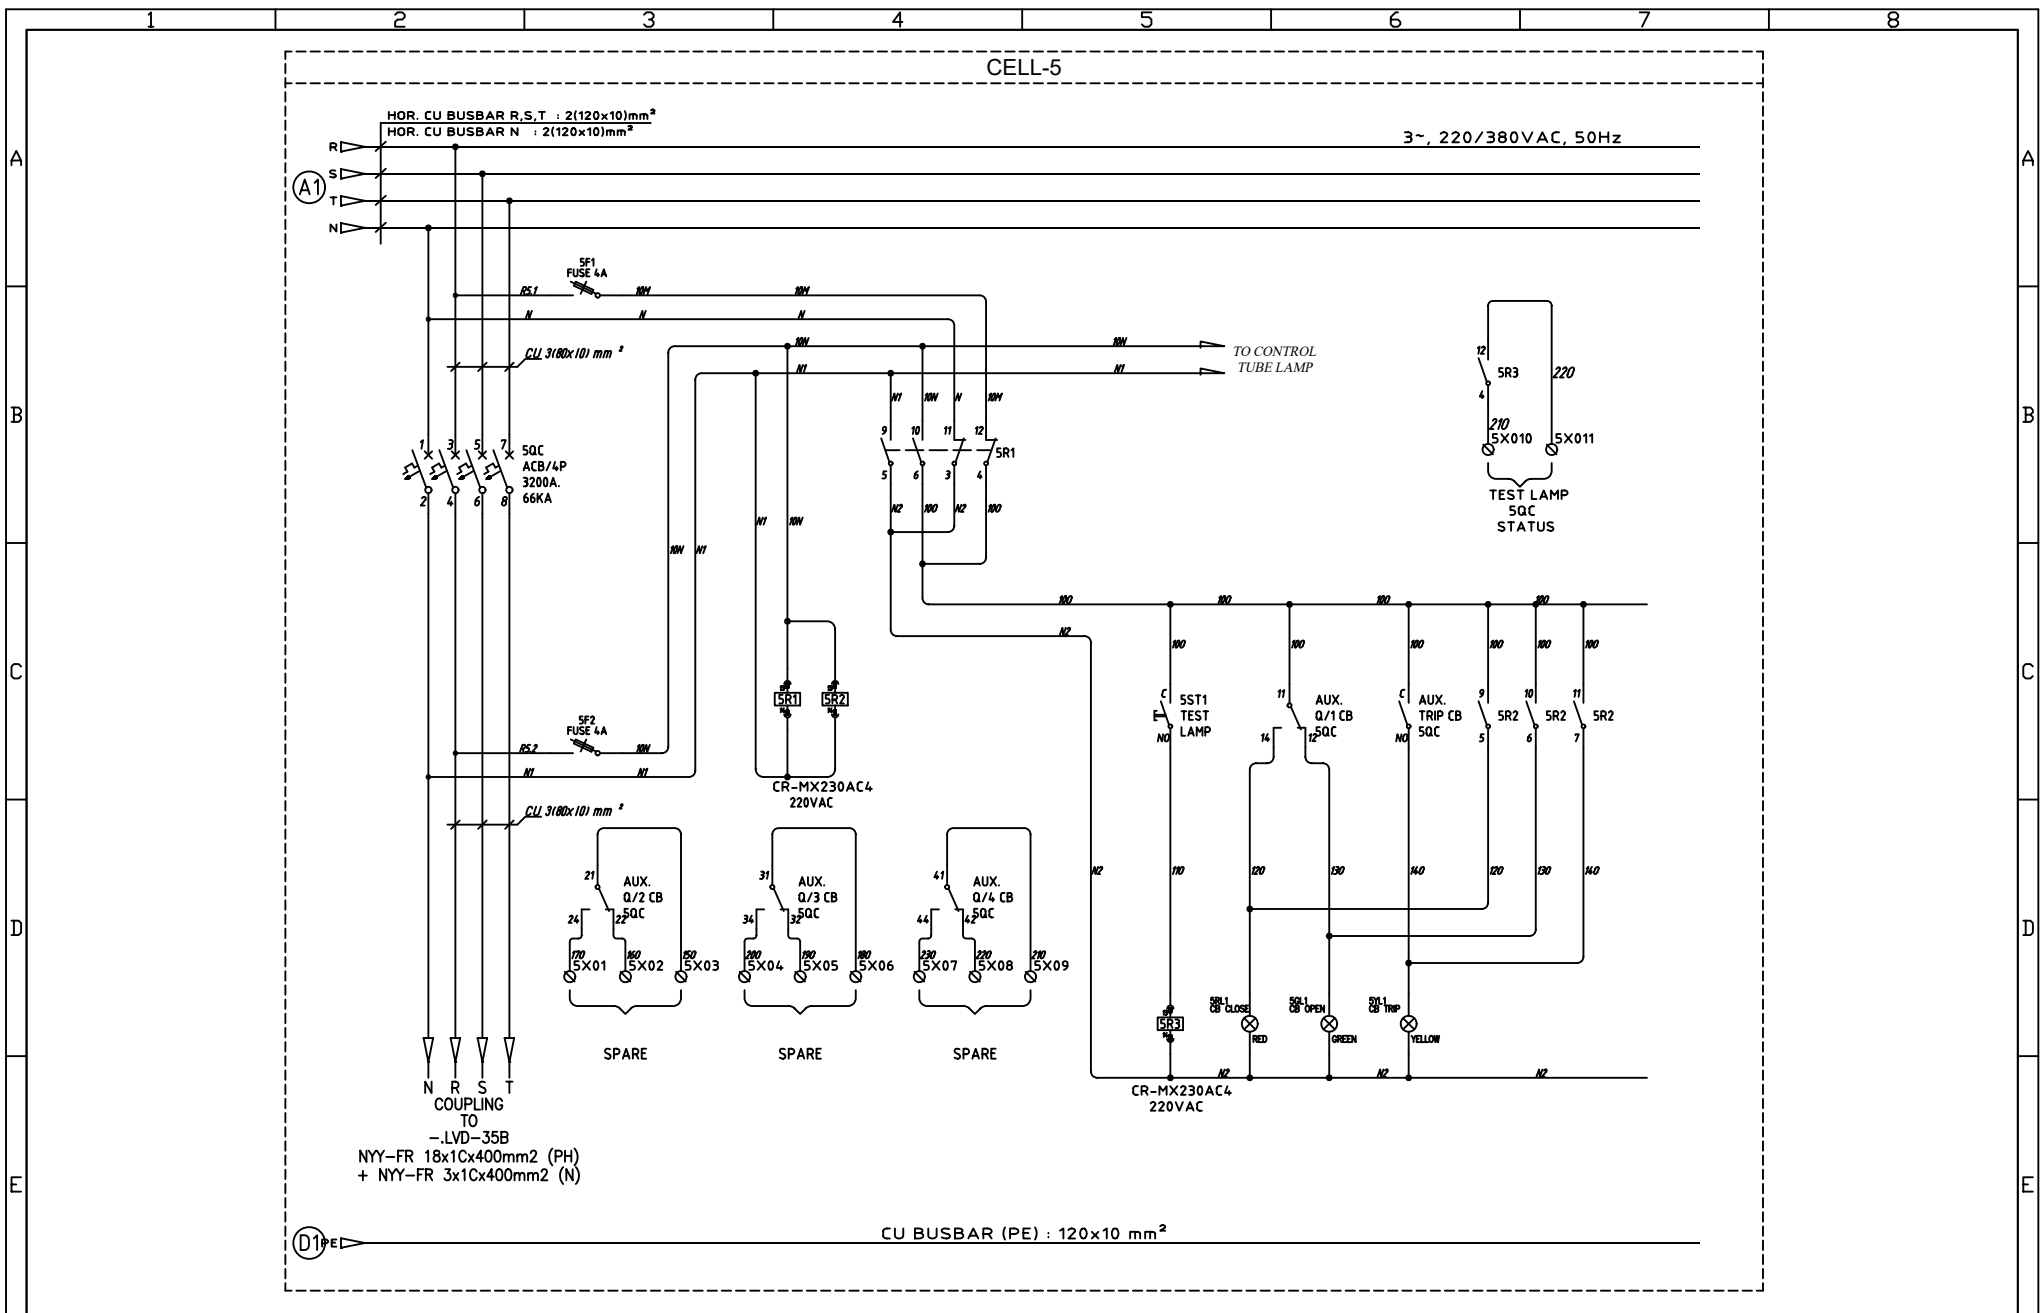

CONTROL DIAGRAM TUBE LAMP

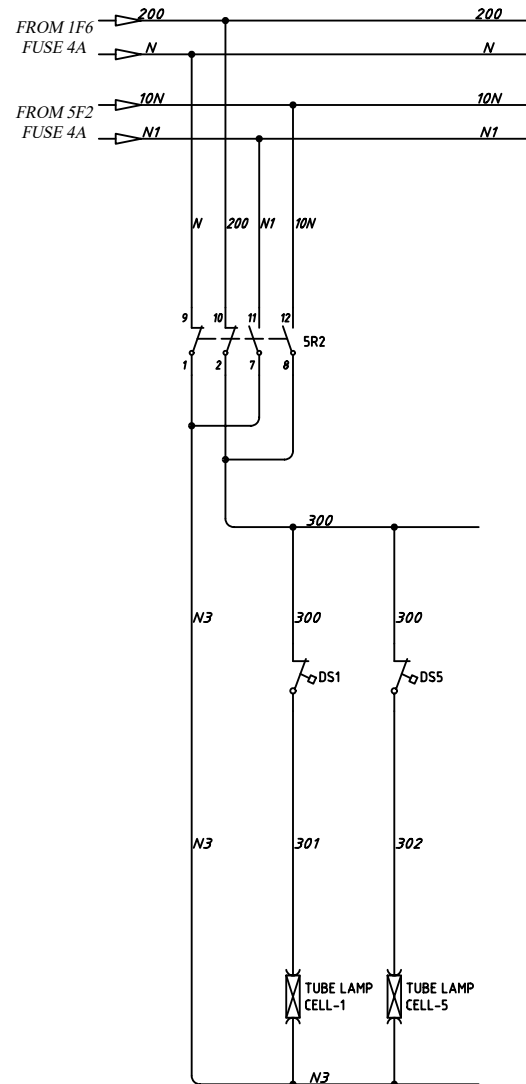

1	2	3	4	5	6	7	8
NO	CODE	SPECIFICATION	TYPE	BRAND	QTY	UNIT	REMARK
		~ INCOMING SECTION ~					
1	1Q0	ACB 3P 3200A 66KA, D/O, E4.2N32 3200 EKIP TOUCH/LSIG	1SDA072491R1	ABB	1	PC	
2	-	GEARED MOTOR 220-250V AC/DC, M-E2.2/E6.2	1SDA073725R1	ABB	1	PC	
3	-	SHUNT CLOSING RELEASE 220-240V AC/DC, YC E1.2-6.2	1SDA073687R1	ABB	1	PC	
4	-	SHUNT OPENING RELEASE 220-240V AC/DC, YO E1.2-6.2	1SDA073674R1	ABB	1	PC	
5	-	PADLOCK FOR ACB E2.2-E6.2 (TANPA GEMBOK)	1SDA073803R1	ABB	1	PC	
		~ COUPLING SECTION ~					
6	5QC	ACB 4P 3200A 66KA, F/T, E4.2N32 3200 EKIP DIP/LSI	1SDA071771R1	ABB	1	PC	
7	-	PADLOCK FOR ACB E2.2-E6.2 (TANPA GEMBOK)	1SDA073803R1	ABB	1	PC	
		~ OUTGOING SECTION ~					
8	2Q1	ACB 3P 1600A 50KA, F/T, E1.2C16 1600 EKIP DIP/LSI	1SDA070871R1	ABB	1	PC	
9	-	PADLOCK FOR ACB E1.2 (TANPA GEMBOK)	1SDA073800R1	ABB	1	PC	
10	2Q2,5Q1-5Q2	ACB 3P 1000A 50KA, F/T, E1.2C10 1000 EKIP DIP/LSI	1SDA070791R1	ABB	3	PCS	
11	-	PADLOCK FOR ACB E1.2 (TANPA GEMBOK)	1SDA073800R1	ABB	3	PCS	
12	2Q3	MCCB 3P 252-630A 50KA, T5S PR221DS-LS/I-630	1SDA054404R1	ABB	1	PC	
13	-	RHE NORMAL TRANSMITTED HANDLE, T5 FIXED/PLUGIN	1SDA054929R1	ABB	1	PC	
14	-	AUXILIARY CONTACT, AUX-C 3Q 1SY 250V AC/DC, T4-T5-T6	1SDA054911R1	ABB	1	PC	
15	4Q3	MCCB 3P 160-400A 50KA, T5S PR221DS-LS/I-400	1SDA054333R1	ABB	1	PC	
16	-	RHE NORMAL TRANSMITTED HANDLE, T5 FIXED/PLUGIN	1SDA054929R1	ABB	1	PC	
17	-	AUXILIARY CONTACT, AUX-C 3Q 1SY 250V AC/DC, T4-T5-T6	1SDA054911R1	ABB	1	PC	
18	4Q4~4Q6	MCCB 3P 140-200A 50KA, XT3S TMD-200	1SDA068220R1	ABB	3	PCS	
19	-	RHE NORMAL TRANSMITTED HANDLE, XT1/XT3, FIXED/PLUGIN	1SDA066479R1	ABB	3	PCS	
20	-	AUXILIARY CONTACT, AUX-C 2Q 1SY 250V AC, XT1,XT2,XT3,XT4	1SDA066433R1	ABB	3	PCS	
21	4Q4~4Q6	MCCB 3P 70-100A 50KA, XT2S TMA-100	1SDA067558R1	ABB	3	PCS	
22	-	RHE NORMAL TRANSMITTED HANDLE, XT2/XT4, FIXED/PLUGIN	1SDA069055R1	ABB	3	PCS	
23	-	AUXILIARY CONTACT, AUX-C 2Q 1SY 250V AC, XT1,XT2,XT3,XT4	1SDA066433R1	ABB	3	PCS	
		~ CONTROL, METERING & PROTECTION SECTION ~					
24	1F1~1F...	FUSE CARTRIDGE 4A + FUSE CARRIER	RT18-32	PM	44	PCS	
25	1RL0~1RL...	PILOT LAMP 220VAC, LED, Ø22.5mm, RED	AD22-221DS	AXLE/EQ	15	PCS	
26	1YL0~1YL...	PILOT LAMP 220VAC, LED, Ø22.5mm, YELLOW	AD22-221DS	AXLE/EQ	15	PCS	
27	1GL0~1GL...	PILOT LAMP 220VAC, LED, Ø22.5mm, GREEN	AD22-221DS	AXLE/EQ	15	PCS	
28	1SA1~1SA...	PUSH BUTTON, 1 C/O, Ø22.5mm, GREEN	AXP-B235	AXLE/EQ	1	PCS	
29	1SB1~1SB...	PUSH BUTTON, 1 C/O, Ø22.5mm, RED	AXP-B245	AXLE/EQ	1	PCS	
30	1ST1~1ST...	PUSH BUTTON FLUSH, 1 N/O, Ø22mm, BLACK	YW1B-M1E10B	IDEC/EQ	14	PCS	
31	1P1~1P...	DIGITAL POWER METER, MODBUS ETHERNET TCP/IP, M4M20ETHERNET	2CSG204471R4051	ABB	13	PCS	
32	1CT1~1CT...	CURRENT TRANSFORMER 100/5A, 2.5VA, CLASS 0.5, 31.5x11mm	HG30-100	HOWIG/EQ	9	PCS	
33	1CT1~1CT...	CURRENT TRANSFORMER 200/5A, 5VA, CLASS 0.5, 31.5x11mm	HG30-200	HOWIG/EQ	9	PCS	
34	1CT1~1CT...	CURRENT TRANSFORMER 400/5A, 5VA, CLASS 0.5, 42x11mm	HG40-400	HOWIG/EQ	3	PCS	
35	1CT1~1CT...	CURRENT TRANSFORMER 600/5A, 10VA, CLASS 0.5, 51x16mm	HG50-600	HOWIG/EQ	3	PCS	

1		2		3		4		5		6		7		8			
 PMElectric Best Value Electrical Solution		PROJECT :		MNA WILMAR		DRAWING TITLE :		PART LIST COMPONENT LVD-35A (BIODIESEL A)		DATE	DRAWN	SIGN	VERIFIED	SIGN	DESCRIPTION	REV	PAGE
		CUSTOMER :		PT. ABB SAKTI INDUSTRI		NO DR/JO : JO-004/IND.2020 NO DWG. : ABB-001		SCALE : NTS Dimension in mm		30-05-2020	YD		SBR		FOR PRODUCTION R1	△	28
										29-06-2020	YD		SBR		FOR PRODUCTION R2	△	
										01-07-2020	YD		SBR		FOR PRODUCTION R3	△	
										17-09-2020	YD		SBR		AS BUILT DRAWING	△	
																29	

	1	2	3	4	5	6	7	8
	NO	CODE	SPECIFICATION	TYPE	BRAND	QTY	UNIT	REMARK
A	36	1CT1~1CT...	CURRENT TRANSFORMER 1000/5A, 10VA, CLASS 0.5, 82x32.5mm	HG82-1000	HOWIG/EQ	9	PCS	
	37	1CT1~1CT...	CURRENT TRANSFORMER 1600/5A, 20VA, CLASS 0.5, 82x32.5mm	HG82-1600	HOWIG/EQ	3	PCS	
	38	1CT1~1CT...	CURRENT TRANSFORMER 3200/5A, 40VA, CLASS 0.5, 126x36mm	HG120-3200	HOWIG/EQ	4	PCS	
	39	1PS1	POWER SUPPLY 115/230VAC-24VDC, 150W	LRS-150-24	MEAN WELL	1	PC	
	40	1R1~1R...	MINIATURE RELAY 5A, 4 C/O, 230VAC, CR-MX230AC4 + SOCKET	1SVR405633R3000+1SVR405651R3400	ABB	18	PCS	
	41	1X1~1X...	TERMINAL BLOCK 20A	SLR-20	PM	230	PCS	
B	42	DS	LIMIT SWITCH SINGLE POLE 1-CO	-	IMPORT	2	PCS	
	43	TUBE LAMP	TUBULAR LAMP LED 4W, 220VAC	31099	PHILIPS	2	PCS	
	44	-	WIRING & ACCESORIES	PM	LOCAL	1	LOT	
	45	-	CU BUSBAR	PREMIUM	EX-IMPORT	1	LOT	
	46	-	BOX PANEL UK: 2200(H) X 400(W) X 1000(D)mm ²	PRO E	ABB	1	UNIT	
	47	-	BOX PANEL UK: 2200(H) X 700(W) X 1000(D)mm ²	PRO E	ABB	4	UNIT	
C	48							
	49							
	50							
	51							
	52							
	53							
D	54							
	55							
	56							
	57							
	58							
	59							
E	60							
	61							
	62							
	63							
1		2		3		4		5		6		7		8	
 PMElectric Best Value Electrical Solution	PROJECT : MNA WILMAR			DRAWING TITLE : PART LIST COMPONENT LVD-35A (BIODIESEL A)			DATE	DRAWN	SIGN	VERIFIED	SIGN	DESCRIPTION		REV	PAGE
	CUSTOMER : PT. ABB SAKTI INDUSTRI			NO DR/JO : JO-004/IND.2020 NO DWG. : ABB-001			30-05-2020	YD		SBR		FOR PRODUCTION R1		△	29
							29-06-2020	YD		SBR		FOR PRODUCTION R2		△	
							01-07-2020	YD		SBR		FOR PRODUCTION R3		△	
			SCALE : NTS			17-09-2020	YD		SBR		AS BUILT DRAWING		△	29	
			Dimension in mm												