



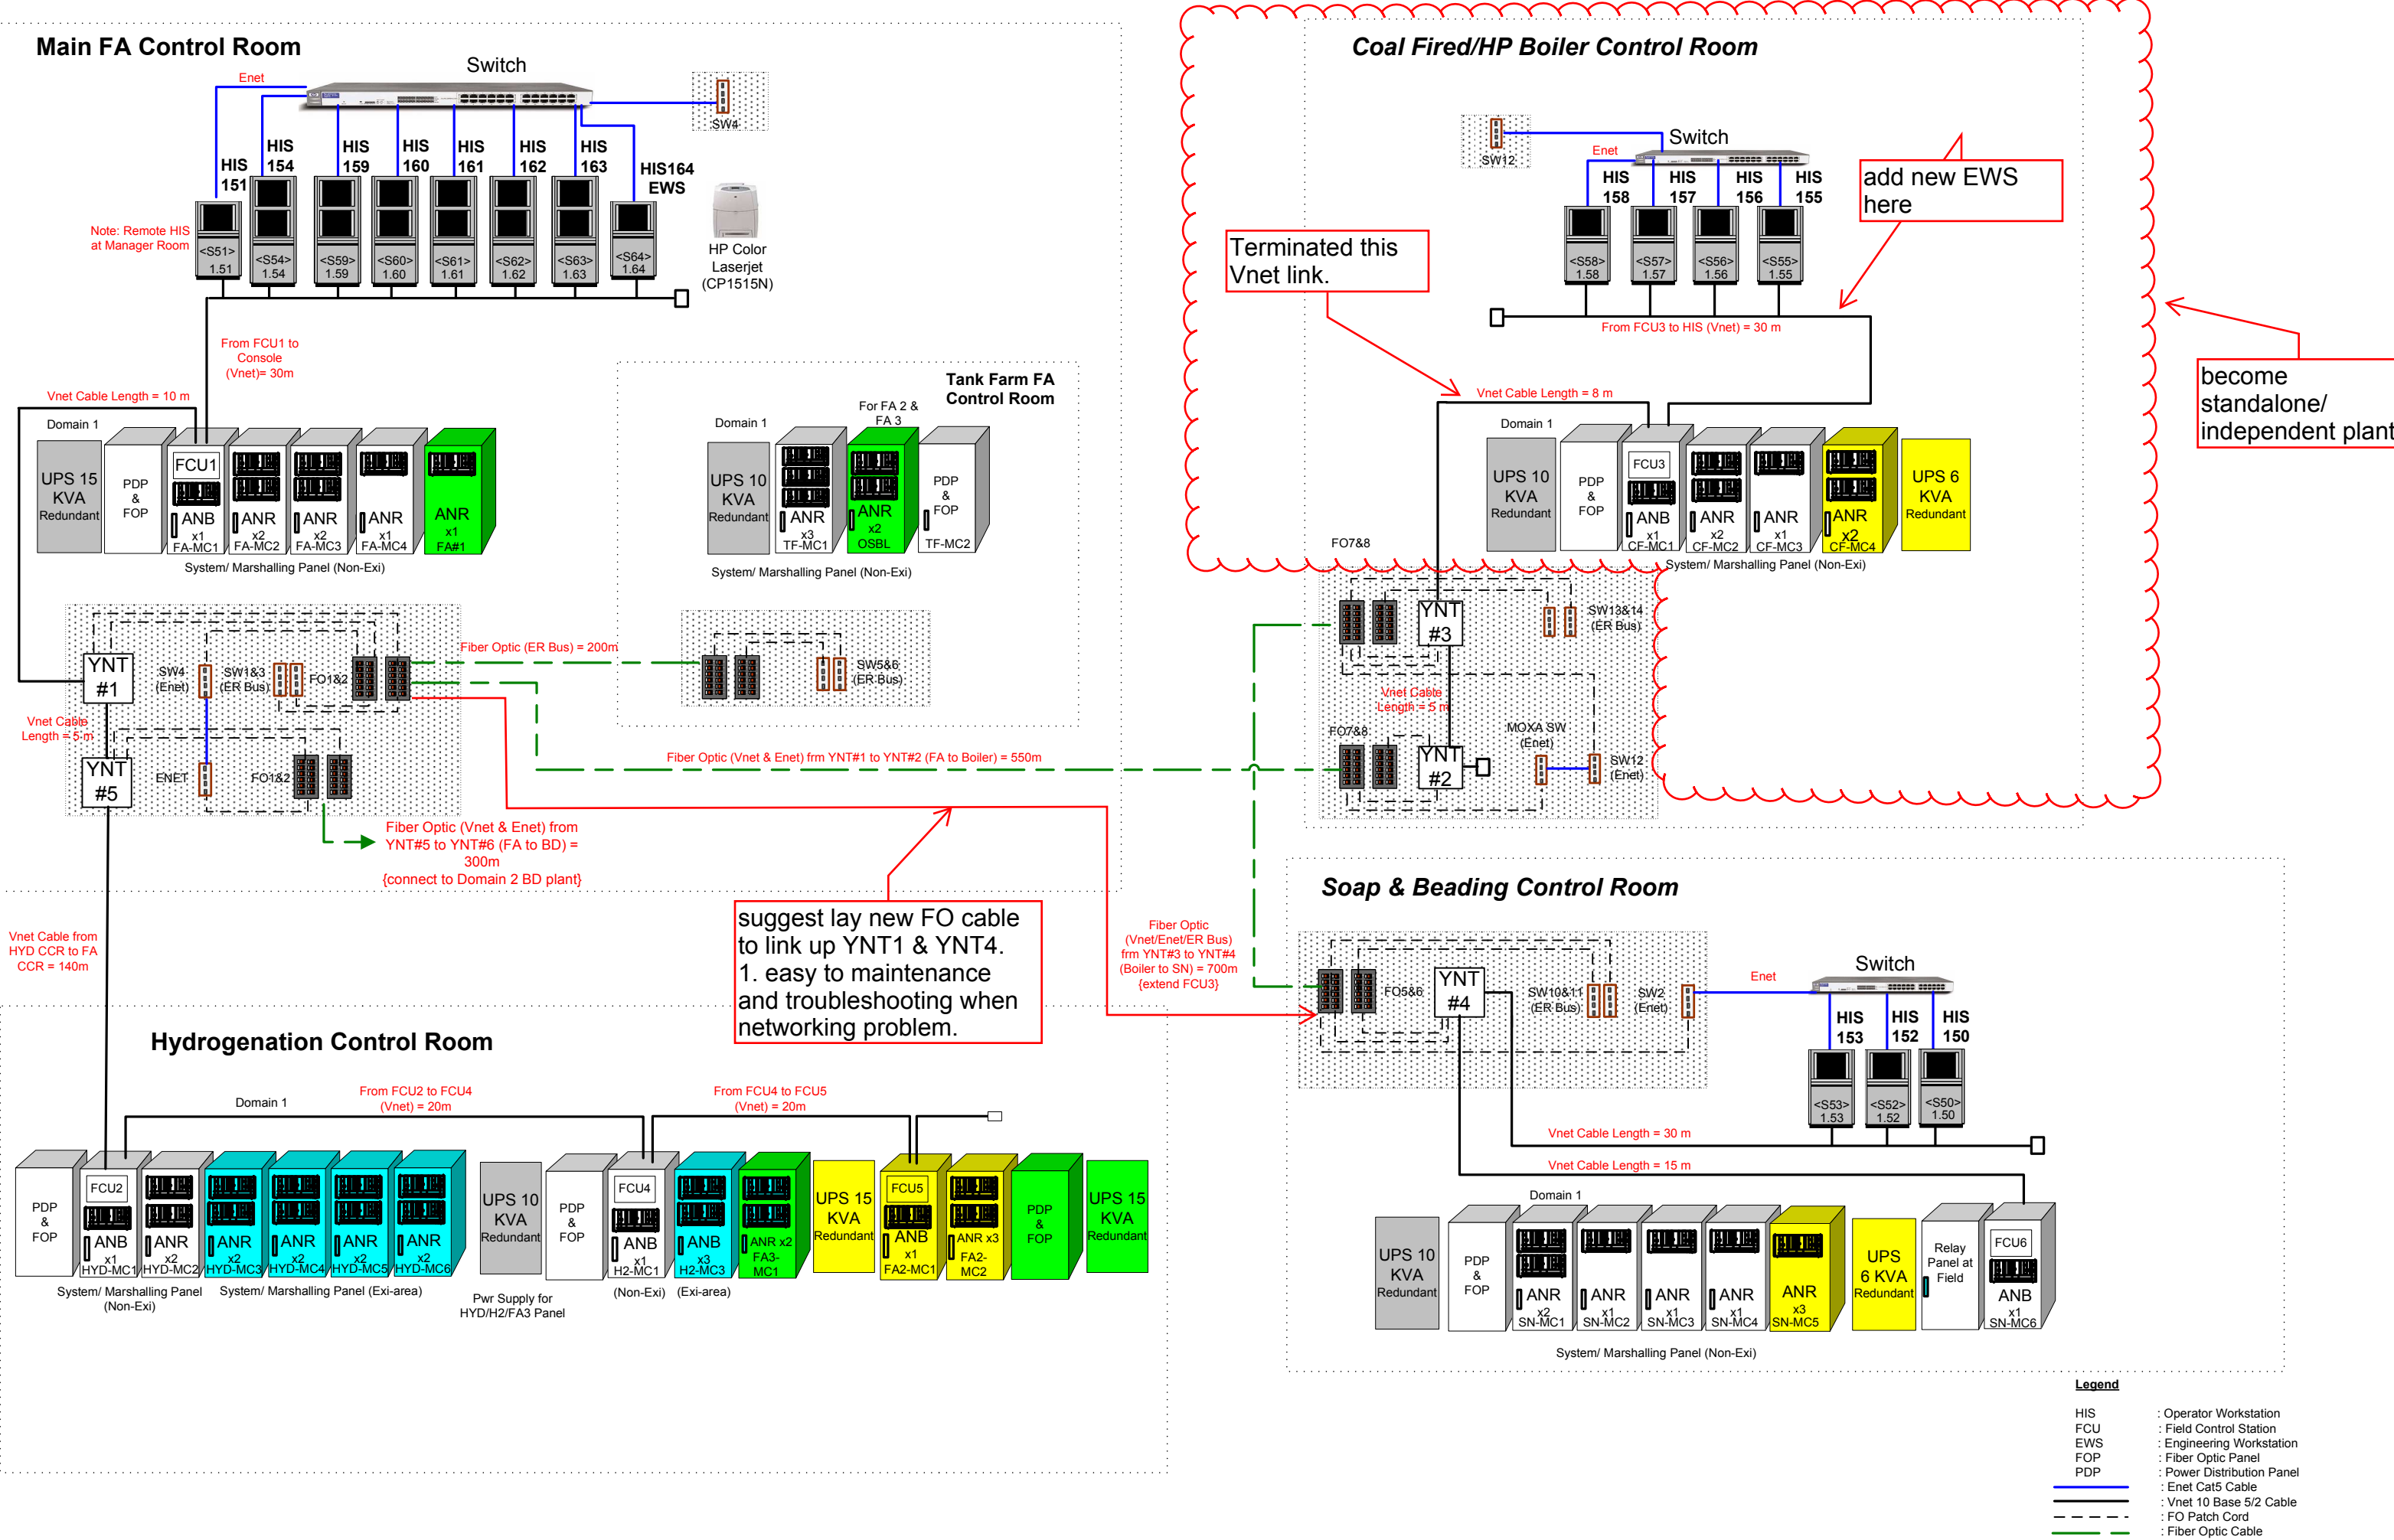



Domain 2

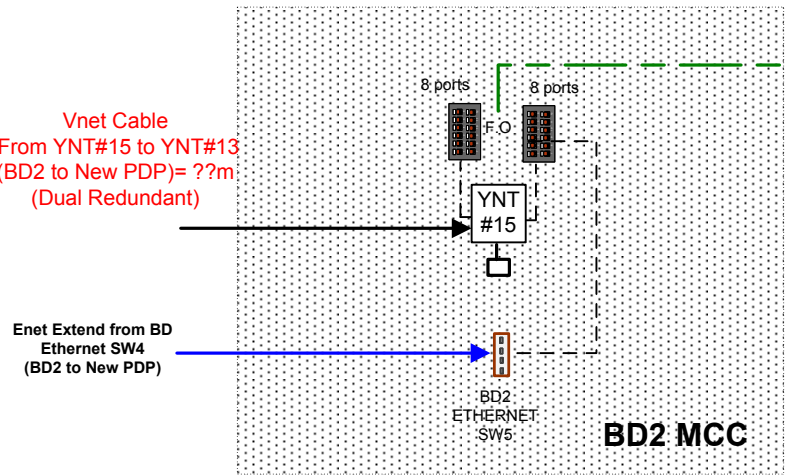

* new panel
Under BD3
Supply BQ


BD#3 Central Control Room

Domain 5

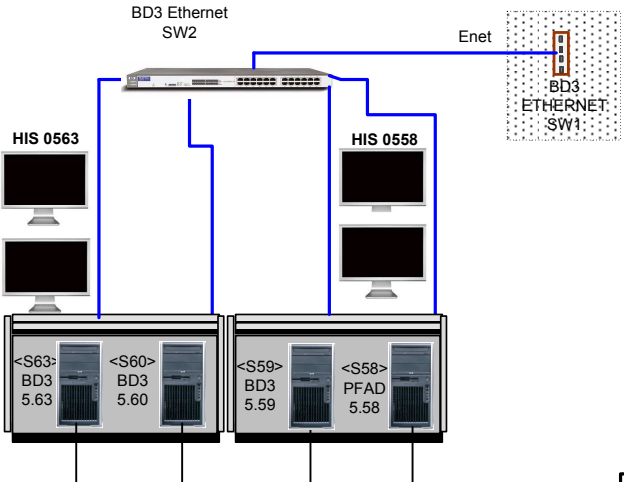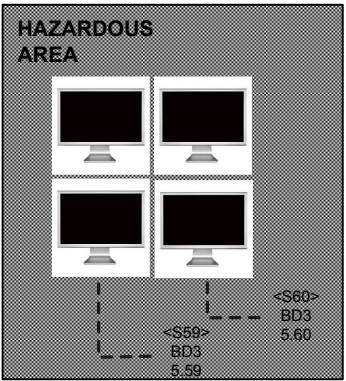


Vnet Cable Length = 3 m
(Redundant)

Vnet Cable Length = 20 m
(Redundant)

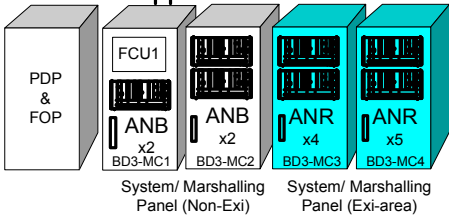




Fiber Optic (Vnet/Enet)
=?m (Dual)

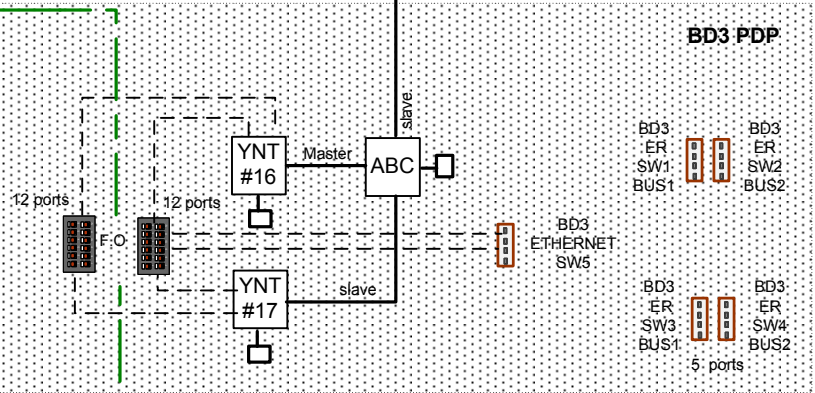


Fiber Optic (Vnet/Enet)
=?m (Dual)
Extend to PFAD

Vnet Cable Length = 3 m
(Dual Redundant)

Vnet Cable Length = 40 M
(Dual Redundant)

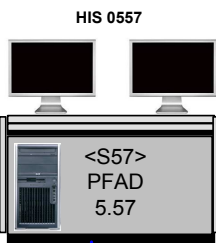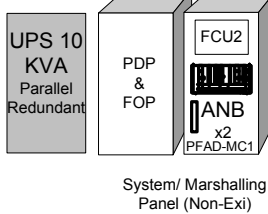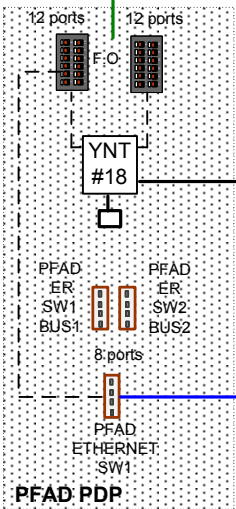

PFAD MCC

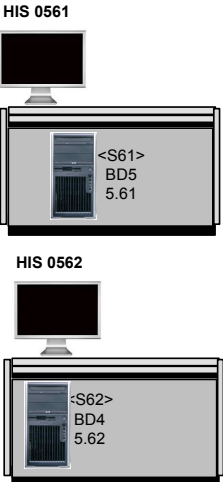

Legend

- HIS : Operator Workstation
- FCU : Field Control Station
- EWS : Engineering Workstation
- FOP : Fiber Optic Panel
- PDP : Power Distribution Panel
- Blue line : Enet Cat5 Cable
- Red line : Vnet 10 Base 5/2 Cable
- Green line : FO Patch Cord
- Black line : Fiber Optic Cable