


DOCUMENT STATUS	
FOR INFORMATION	☐
COMMENTED	☐
APPROVED WITH COMMENTS	☐
APPROVED FOR DESIGN/CONSTRUCTION	☐
REJECTED	☐

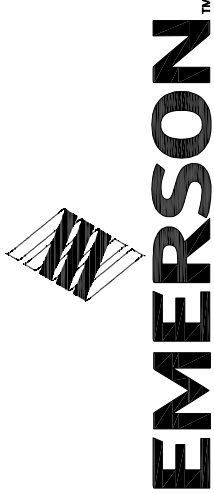


GENERAL AND INTERNAL ARRANGEMENT DRAWING - COAL BOILER, AIR COMPRESSOR & N2 GENERATOR DCS SERANG PROJECT


							CUSTOMER : WILMAR INDUSTRIAL COMPLEX PT MNA SERANG, INDONESIA
							CONTRACT NO. : -
							PROJECT TITLE : DCS SERANG PROJECT
0	AS BUILT	29/08/19	AS/NAM	LKL	MNI		CUSTOMER PROJECT NO. : -
A	ISSUE FOR COMMENT	09/08/18	AS	LKL	MNI		
REV.	DESCRIPTION	DATE	DRAWN BY	CHECKED BY	APPROVED BY		

	PERMIT STAMP AND PROFESSIONAL STAMP AFFIXED ABOVE SHALL APPLY ONLY TO REV(s)		SCALE: NTS UNITS: mm (inch)	SIZE: A3 © 2018	EMERSON PROJECT NO.: 3258585 PROJECT TITLE: DCS SERANG PROJECT	TITLE: COVER SHEET	EMERSON DRAWING NO.: 3258585-PSS-PASH-DWG-00023	SHEET NO: 001
							CUSTOMER DRAWING NO.: -	REV: 0


DRAWING INDEX & REVISION

 [illegible]


	PERMIT STAMP AND PROFESSIONAL STAMP AFFIXED ABOVE SHALL APPLY ONLY TO REV(S)			SCALE:	NTS	SIZE:	EMERSON PROJECT NO.: 3258585		TITLE: DRAWING INDEX & REVISION	EMERSON DRAWING NO.: 3258585-PSS-PASH-DWG-00023	SHEET NO.: 002
	UNITS:	mm (inch)		©	2018	PROJECT TITLE: DCS SERANG PROJECT	CUSTOMER DRAWING NO.: —	REV.: 0			

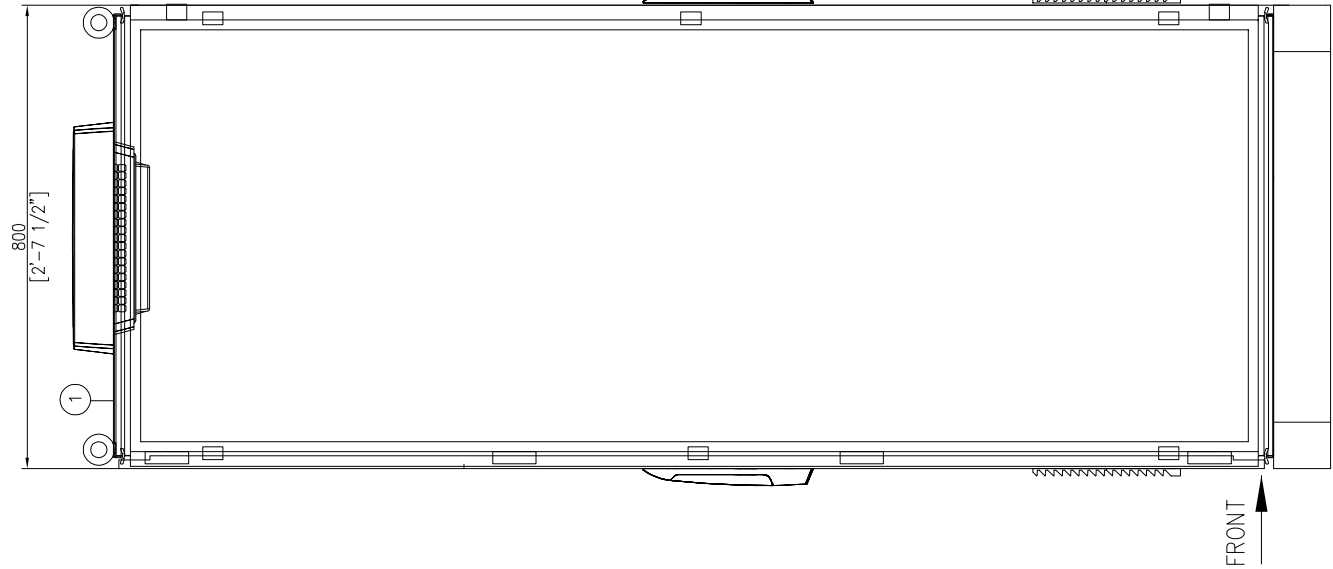


SIDE VIEW
(SECTION A-A)

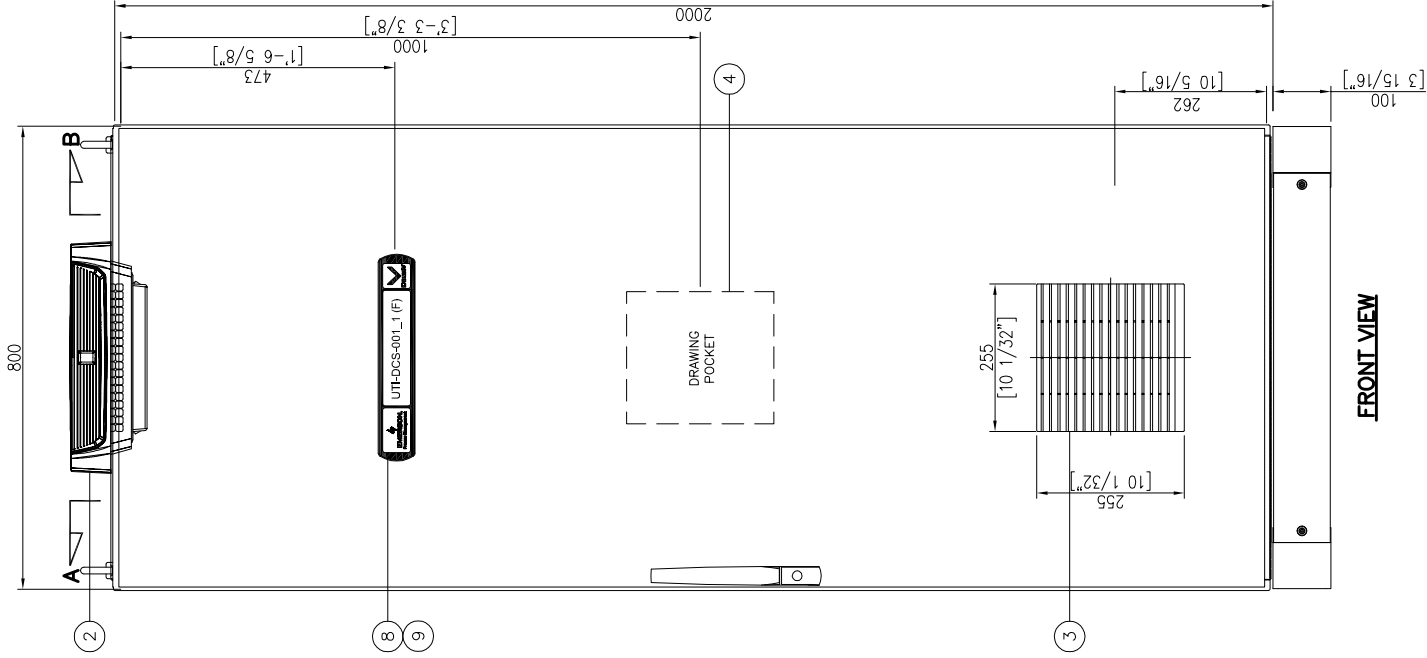

FRONT VIEW

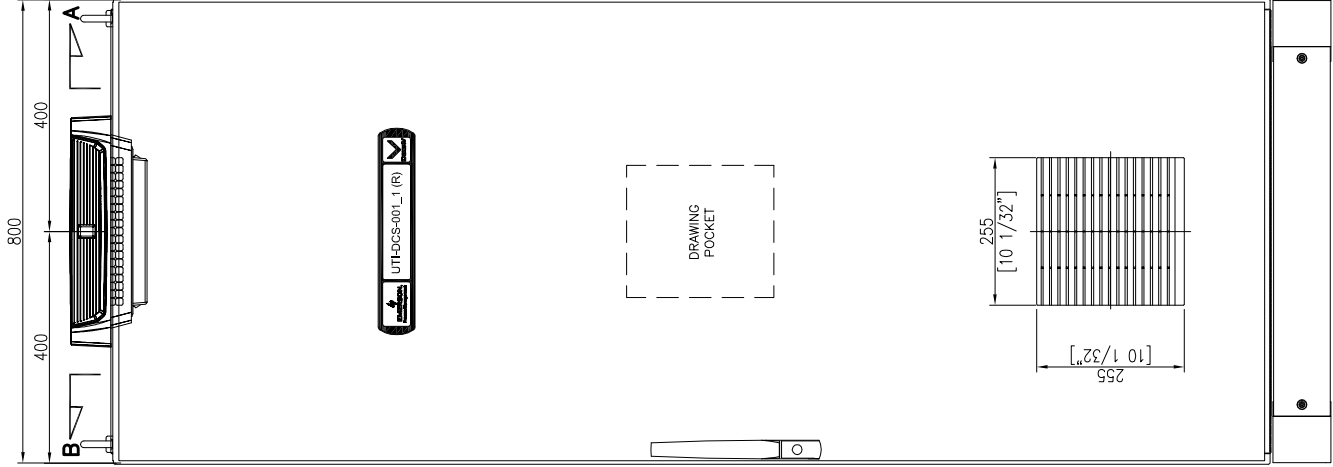

REAR VIEW

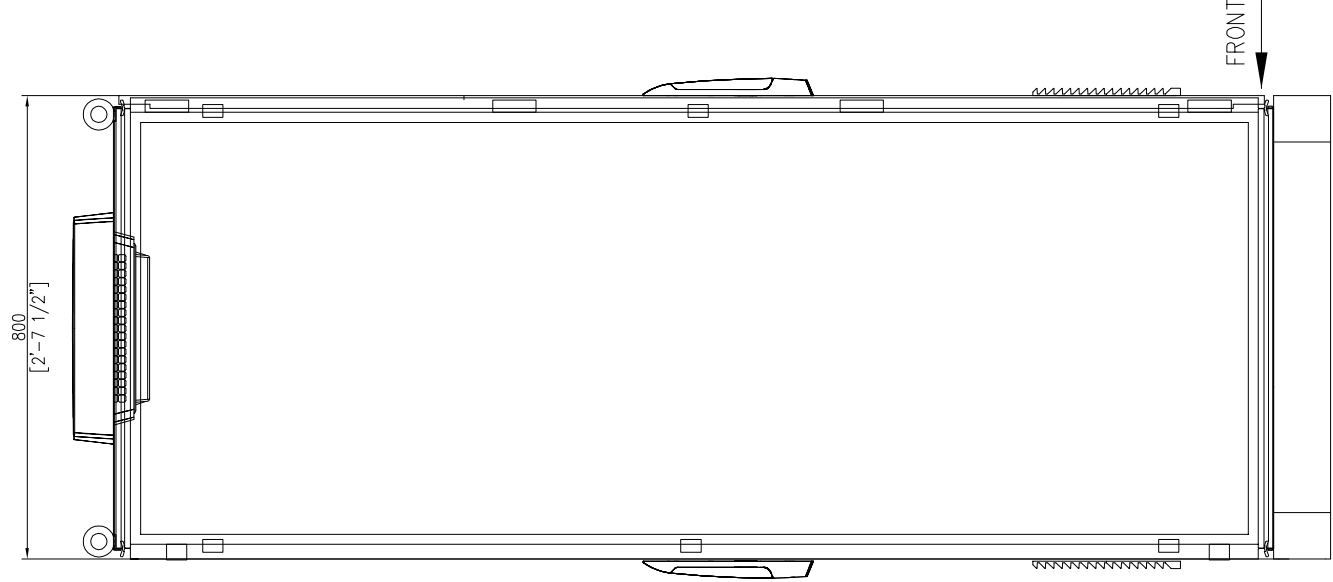

SIDE VIEW
(SECTION B-B)



PERMIT STAMP AND PROFESSIONAL STAMP
AFFIXED ABOVE SHALL APPLY ONLY TO REV(S)



SCALE: NTS
UNITS: mm (inch)


SIZE: A3
© 2018


EMERSON PROJECT NO.: 3258585
PROJECT TITLE: DCS SERANG PROJECT

TITLE: SYSTEM CABINET UTL-DCS-001_L1
(FRONT & REAR DOOR VIEW,
RIGHT SIDE & LEFT SIDE VIEW)

EMERSON DRAWING NO.: 3258585-PSS-PASH-DWG-00023
CUSTOMER DRAWING NO.: -


SHEET NO: 003
REV: 0

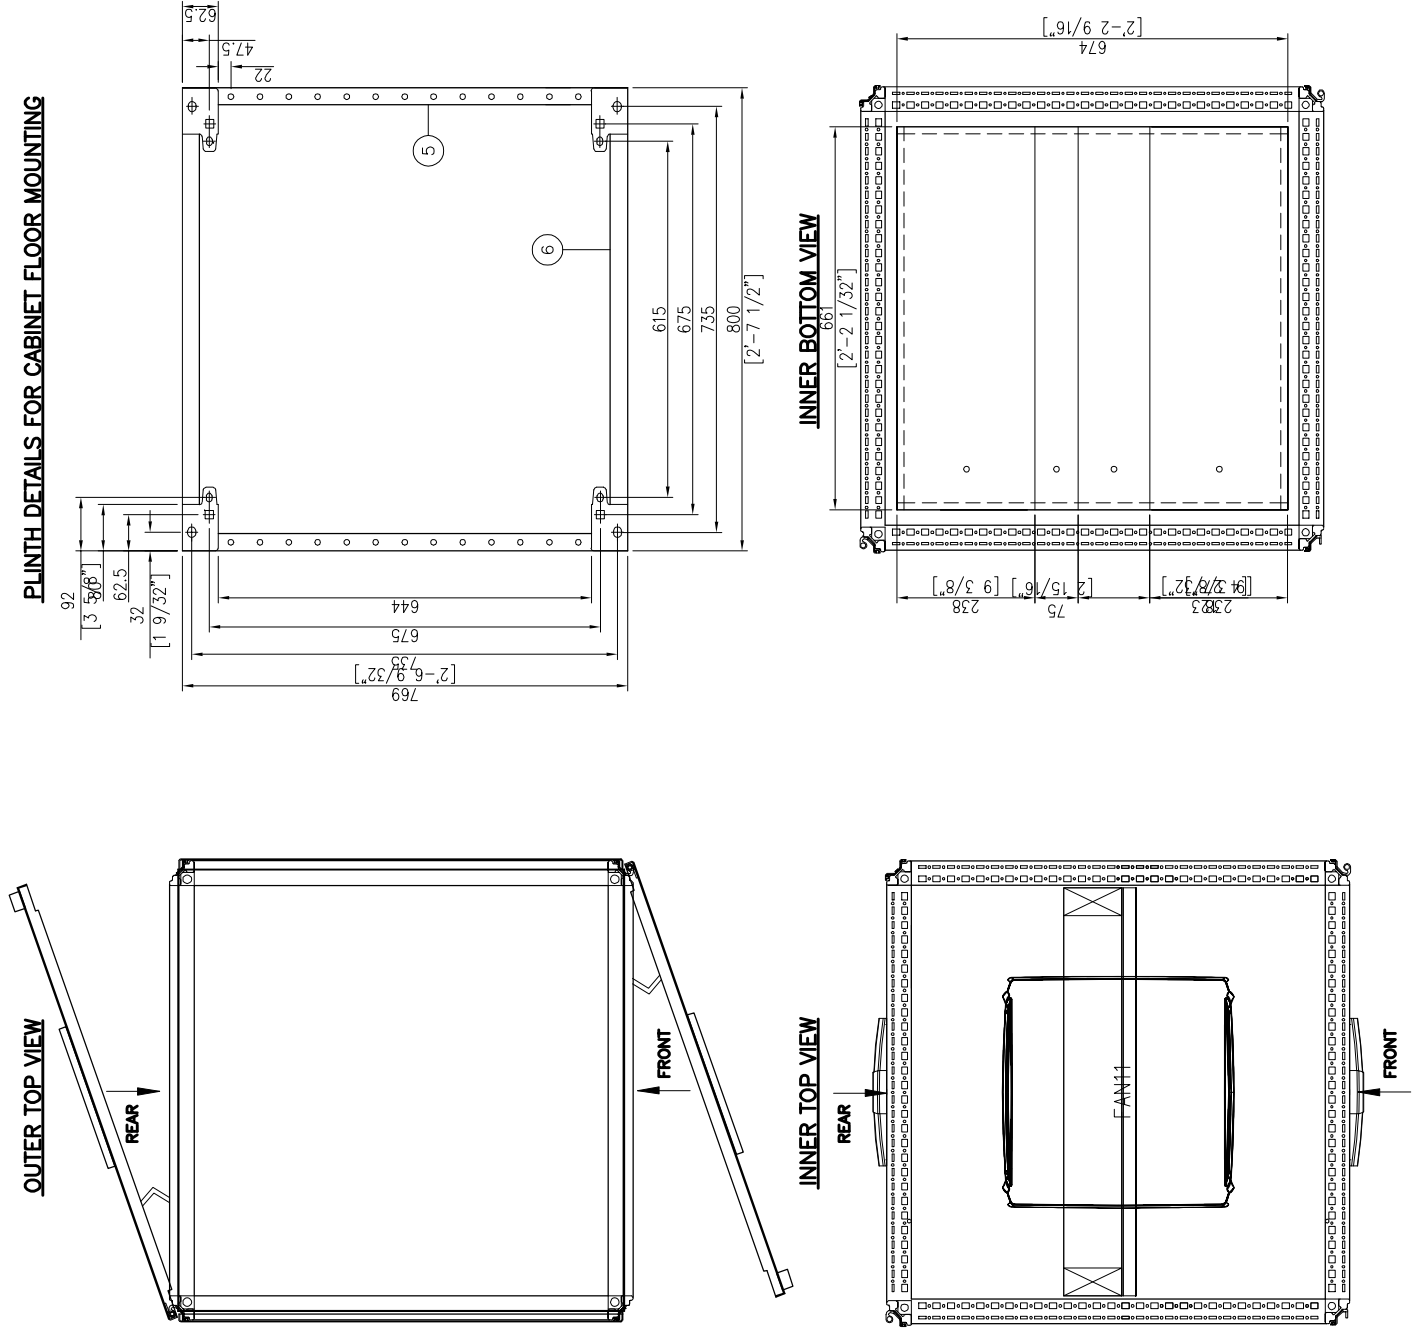

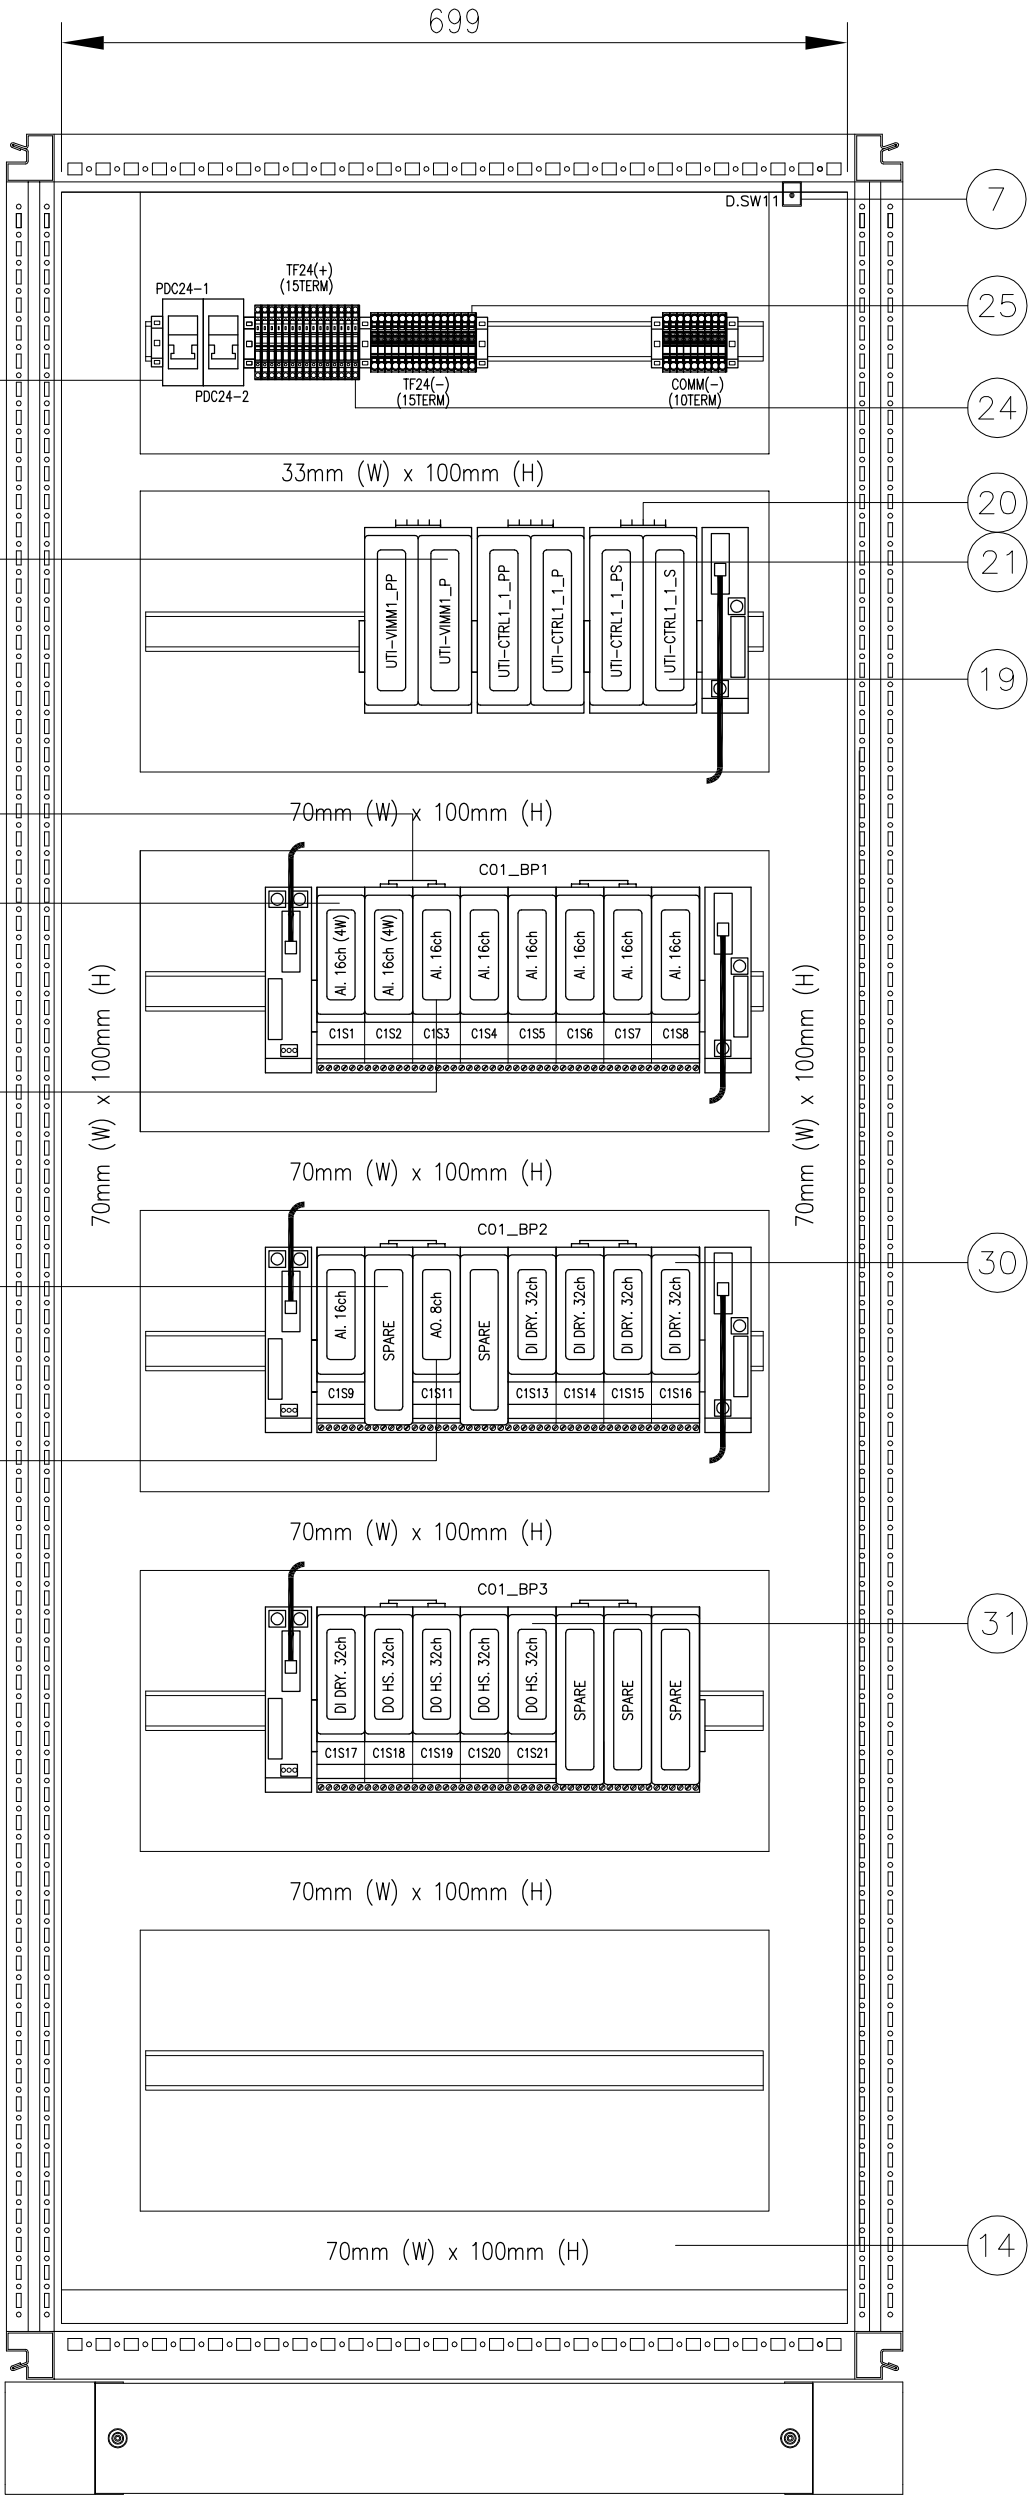


FRONT VIEW

			 EMERSON.	SCALE: NTS	SIZE: A3	EMERSON PROJECT NO.: 3258585 PROJECT TITLE: DCS SERANG PROJECT	TITLE: SYSTEM CABINET UTI-DCS-001_1 FRONT VIEW	EMERSON DRAWING NO.: 3258585-PSS-PASH-DWG-00023	SHEET NO.: 005
								CUSTOMER DRAWING NO.: —	REV.: 0
	PERMIT STAMP AND PROFESSIONAL STAMP AFFIXED ABOVE SHALL APPLY ONLY TO REV(s)								

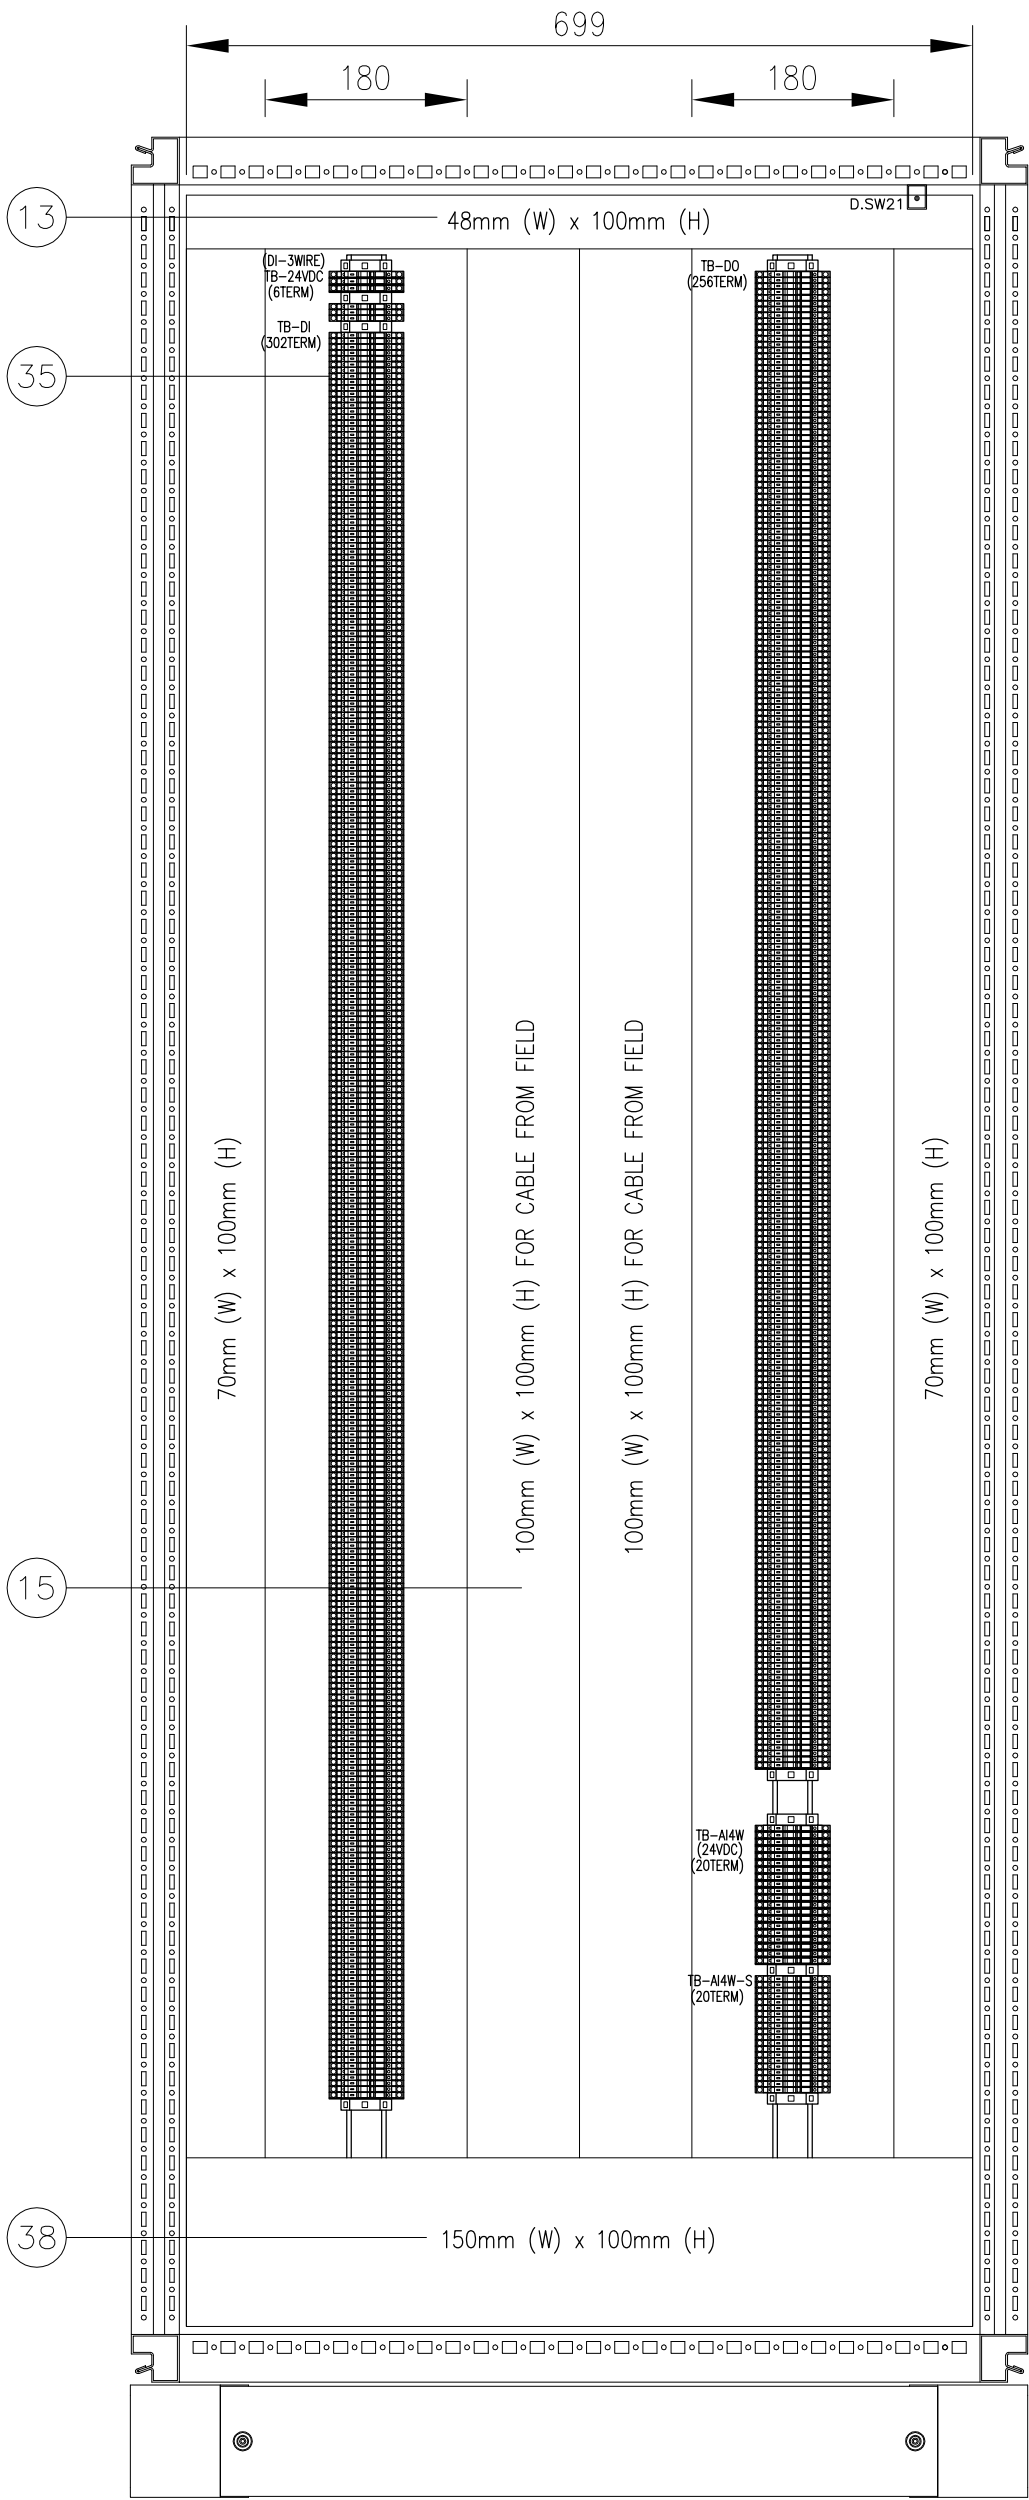

REAR VIEW


	PERMIT STAMP AND PROFESSIONAL STAMP AFFIXED ABOVE SHALL APPLY ONLY TO REV(s)				SCALE: NTS	SIZE: A3	EMERSON PROJECT NO.: 3258585		TITLE: SYSTEM CABINET UTI-DCS-001_1		EMERSON DRAWING NO.: 3258585-PSS-PASH-DWG-00023		SHEET NO: 006
					UNITS: mm (inch)	© 2018	PROJECT TITLE: DCS SERANG PROJECT		REAR VIEW		CUSTOMER DRAWING NO.: -		REV: 0

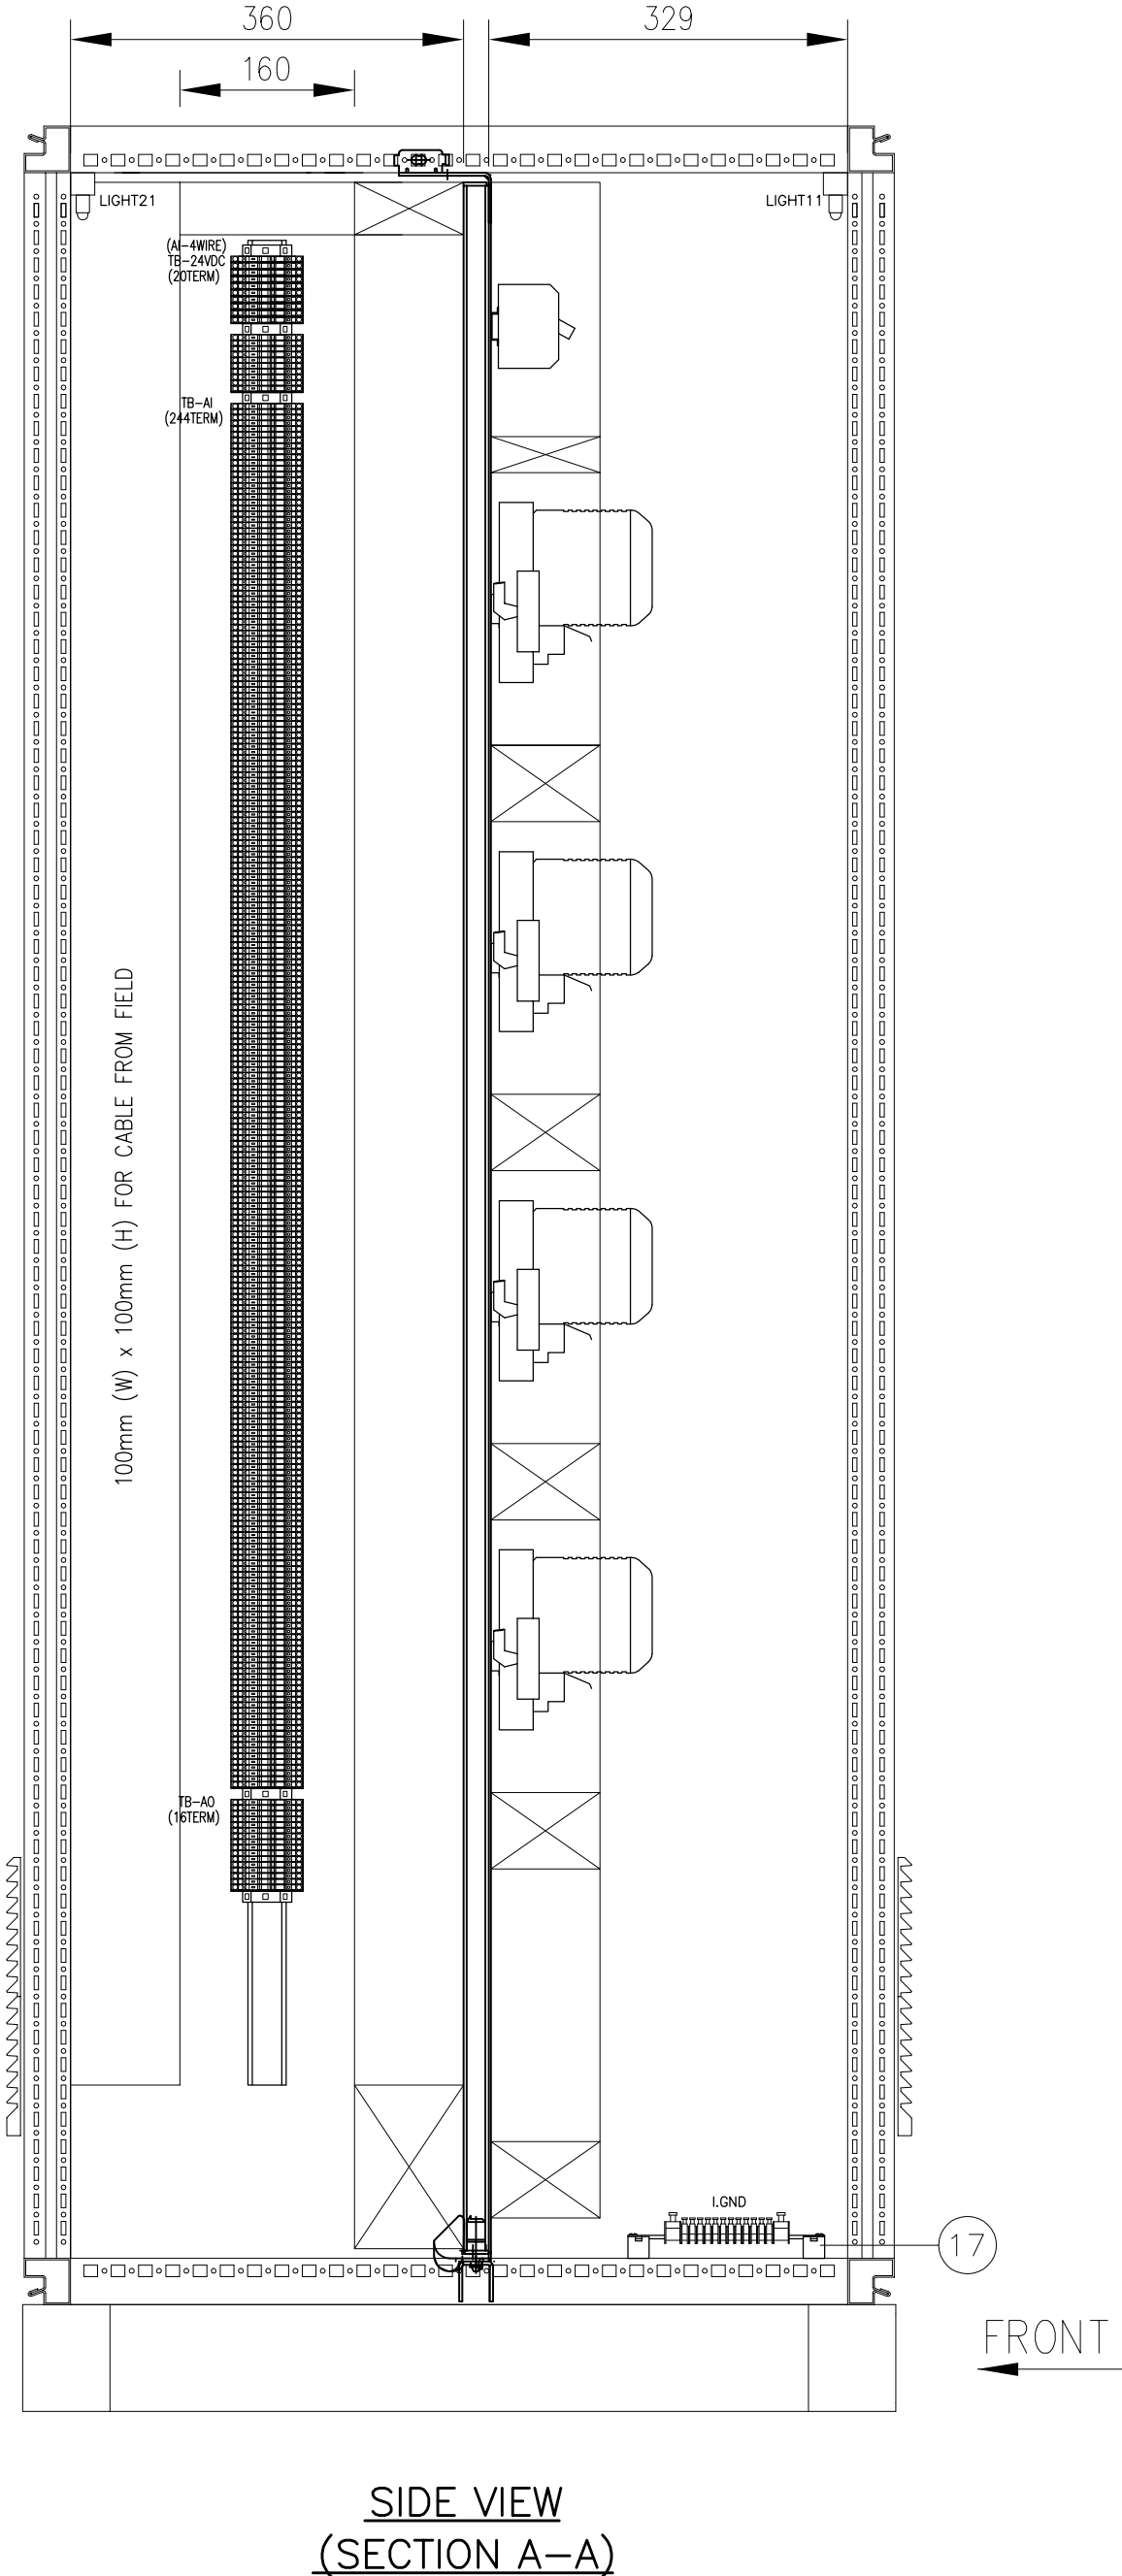

SIDE VIEW
(SECTION A-A)

	PERMIT STAMP AND PROFESSIONAL STAMP AFFIXED ABOVE SHALL APPLY ONLY TO REV(s)		 EMERSON.	SCALE: NTS	SIZE: A3	EMERSON PROJECT NO.: 3258585		TITLE: SYSTEM CABINET UTI-DCS-001_1		EMERSON DRAWING NO.: 3258585-PSS-PASH-DWG-00023		SHEET NO: 007
				UNITS: mm (inch)	2018	PROJECT TITLE: DCS SERANG PROJECT		SIDE VIEW (SECTION A-A)		CUSTOMER DRAWING NO.: -		REV: 0

THIS DRAWING IS THE PROPERTY OF EMERSON PROCESS MANAGEMENT. INFORMATION AND KNOW HOW HEREIN ARE CONFIDENTIAL AND MAY NOT BE USED, REPRODUCED OR REVEALED TO OTHERS EXCEPT IN ACCORDANCE WITH CONTRACT OR OTHER WRITTEN CONSENT OF EMERSON PROCESS MANAGEMENT. ANY PERMITTED REPRODUCTION IN WHOLE OR IN PART, INCLUDING SHOP DRAWINGS MUST BEAR OR REFER TO THIS LEGEND.

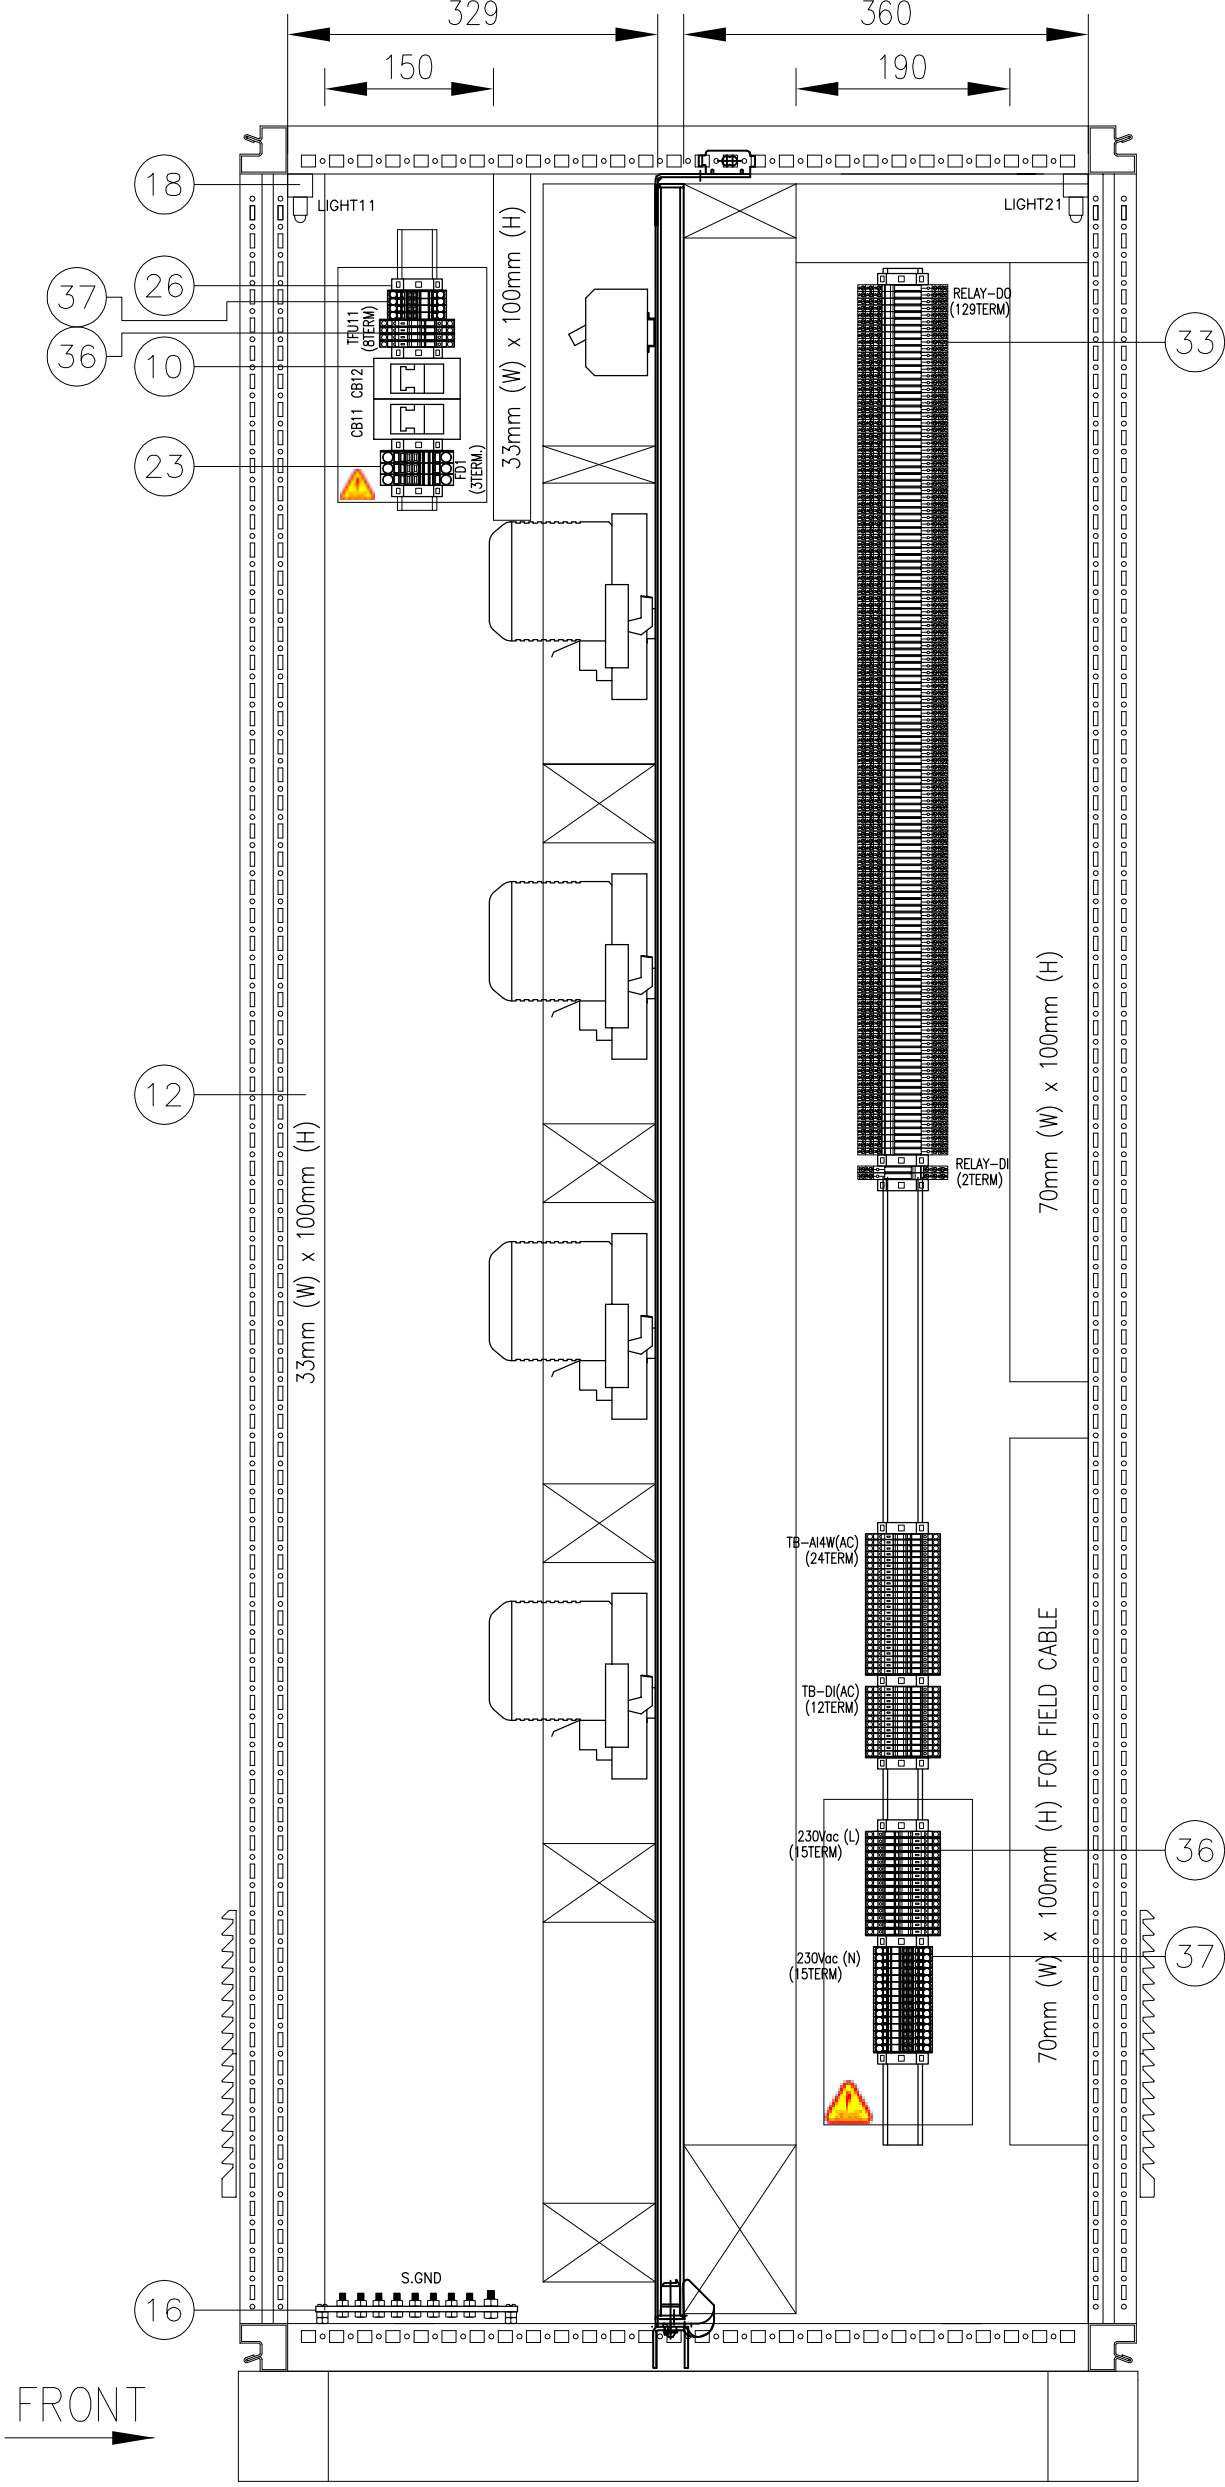

SIDE VIEW
(SECTION B-B)



PERMIT STAMP AND PROFESSIONAL STAMP
AFFIXED ABOVE SHALL APPLY ONLY TO REV(s)



SCALE: NTS
UNITS: mm (inch)

SIZE: A3
© 2018

EMERSON PROJECT NO.: 3258585
PROJECT TITLE: DCS SERANG PROJECT

TITLE: SYSTEM CABINET UTI-DCS-001_1
SIDE VIEW
(SECTION B-B)

EMERSON DRAWING NO.: 3258585-PSS-PASH-DWG-00023
CUSTOMER DRAWING NO.: -

SHEET NO: 008
REV: 0

BILL OF MATERIALS

ITEM NO.	DESCRIPTION	PART NUMBER	QTY.	MANUFACTURER
01	RITTAL CABINET (W800mmxD800mmxH2000mm) FRONT AND REAR ACCESS	TS8808.521	1 SET	RITTAL
02	TOPTHERM ROOF-MOUNTED FAN, 500 M ² /H, 230 V, 1~, 50/60 HZ	SK3241.100	1 PC	RITTAL
03	OUTLET FILTER INCLUDING FILTER MAT	SK3240.200	2 PCS	RITTAL
04	PLASTIC WIRING PLAN POCKET, A4 POTRAIT, RAL7035	SZ2514.000	2 PCS	RITTAL
05	BASE PLINTH	TS8601.800	1 SET	RITTAL
06	TRIM PLINTH	TS8601.080	1 SET	RITTAL
07	DOOR-OPERATED SWITCH,WITHOUT CONNECTION CABLE	SZ4315.520	2 PCS	RITTAL
08	CABINET NAMEPLATE HOLDER	KJ4010X1-BX3	2 PCS	EMERSON PROCESS
09	CABINET NAMEPLATE BLANK INSERT	KJ4010X1-BX2	2 PCS	EMERSON PROCESS
10	AC MCB 2POLE (6A)	IK60N C6A	2 PCS	SCHNEIDER
11	DC MCB 2POLE (20A)	C60H-DC C20A	2 PCS	SCHNEIDER
12	33 X 100 mm PVC WIREWAY (GREY)	-	1 LOT	CONTRACTOR
13	48 X 100 mm PVC WIREWAY (GREY)	-	1 LOT	CONTRACTOR
14	70 X 100 mm PVC WIREWAY (GREY)	-	1 LOT	CONTRACTOR
15	100 X 100 mm PVC WIREWAY (GREY)	-	1 LOT	CONTRACTOR
16	SAFETY GROUND BAR	-	1 LOT	CONTRACTOR
17	INSTRUMENT GROUND BAR	-	1 LOT	CONTRACTOR
18	STANDARD LIGHT	-	2 PCS	CONTRACTOR
19	MQ CONTROLLER	VE3008	2 PCS	EMERSON PROCESS
20	2-WIDE POWER/CONTROLLER CARRIER	VE3051C0	3 PCS	EMERSON PROCESS
21	ENHANCED SYSTEM POWER SUPPLY; (DUAL DC/DC) INPUT	VE5009	3 PCS	EMERSON PROCESS
22	VIRTUAL I/O MODULE 2	VE4026	1 PC	EMERSON PROCESS
23	2-COND THROUGH TERMINAL BLOCK, 10MM SQ	2010-1201	3 PCS	WAGO
24	FUSE DISCONNECT TB WITH FUSE BLOW INDICATOR, 24VDC, 2MM SQ	2002-1611/1000-0541	38 PCS	WAGO
25	2-COND THROUGH TERMINAL BLOCK, 2MM SQ	2002-1201	43 PCS	WAGO
26	END STOPPER	249-117	1 LOT	WAGO
27	ANALOG INPUT CARD; 16 CHANNELS; 4-20 MA; HART; I/O TERMINATION BLOCK	VE4003S2B6	7 PCS	EMERSON PROCESS
28	ANALOG INPUT CARD; 16 CHANNELS; 4-20 MA; HART; 4-WIRE; I/O TERMINATION BLOCK	VE4003S2B7	2 PCS	EMERSON PROCESS
29	ANALOG OUTPUT, 8 CHANNELS 4-20 MA, HART, STANDARD I/O TERMINATION BLOCK	VE4005S2B1	1 PC	EMERSON PROCESS
30	DISCRETE INPUT CARD: 32 CHANNELS 24 VDC; DRY CONTACT; TERMINATION BLOCK	VE4001S2T2B4	5 PCS	EMERSON PROCESS
31	DISCRETE OUTPUT CARD 32 CHANNELS 24 VDC; HIGH SIDE; I/O TERMINATION BLOCK	VE4002S1T2B5	4 PCS	EMERSON PROCESS
32	CARRIER BLANK CAP	VE6101	5 PCS	EMERSON PROCESS
33	RELAY MODULE PLC-RSC-24DC/21	2966171	131 PCS	PHOENIX CONTACT
34	8-WIDE I/O INTERFACE CARRIER WITH CARRIER SHIELD BAR	VE3051C0	3 PCS	EMERSON PROCESS



PERMIT STAMP AND PROFESSIONAL STAMP
AFFIXED ABOVE SHALL APPLY ONLY TO REV(s)



SCALE: NTS
UNITS: mm (inch)

SIZE: A3
© 2018

EMERSON PROJECT NO.: 3258585
PROJECT TITLE: DCS SERANG PROJECT

TITLE: SYSTEM CABINET UTI-DCS-001_1
BILL OF MATERIALS

EMERSON DRAWING NO.: 3258585-PSS-PASH-DWG-00023
CUSTOMER DRAWING NO.: -



SHEET NO: 009
REV: 0


BILL OF MATERIALS

[illegible]


	PERMIT STAMP AND PROFESSIONAL STAMP AFFIXED ABOVE SHALL APPLY ONLY TO REV(s)		SCALE:	NTS	SIZE:	A3	EMERSON PROJECT NO.: 3258585 PROJECT TITLE: DCS SERANG PROJECT	TITLE: SYSTEM CABINET UTI-DCS-001_1 BILL OF MATERIALS	EMERSON DRAWING NO.: 3258585-PSS-PASH-DWG-00023	SHEET NO.: 010
			UNITS:	mm (inch)	⌀	2018				

 PLINTH DETAILS FOR CABINET FLOOR MOUNTING

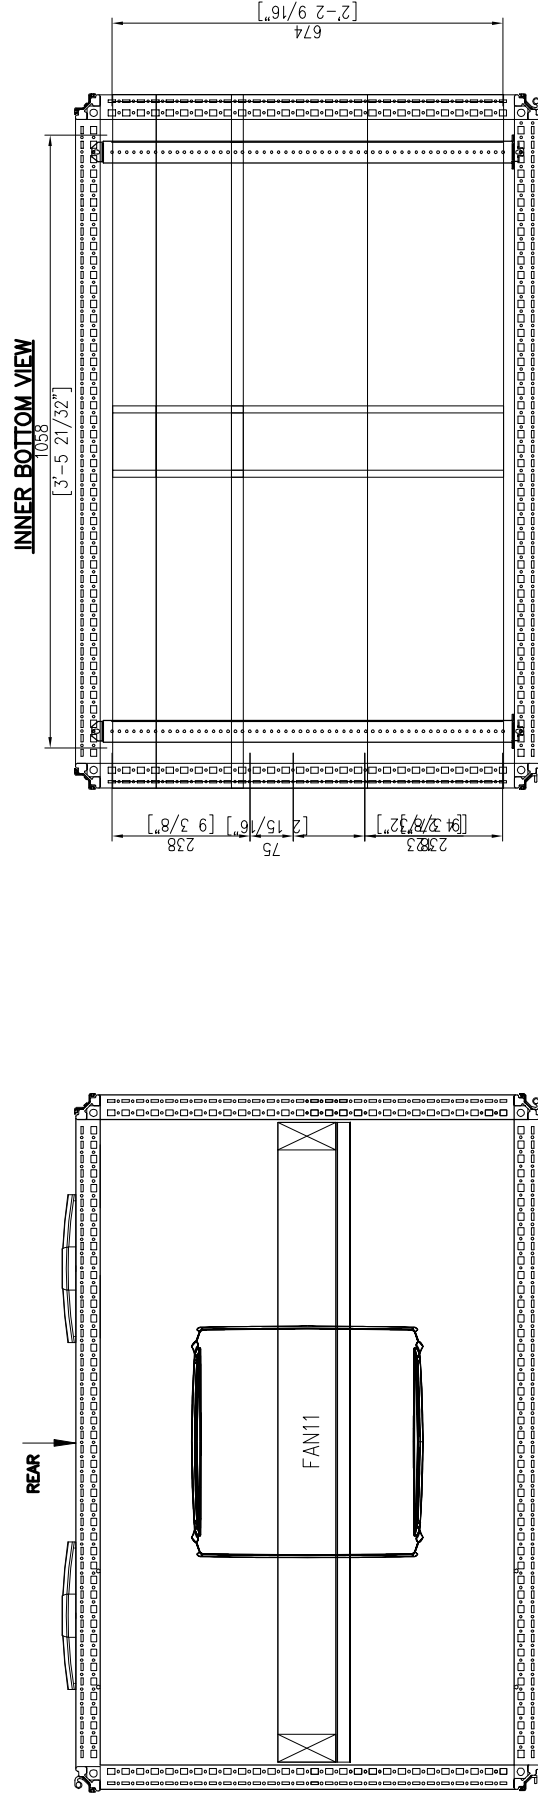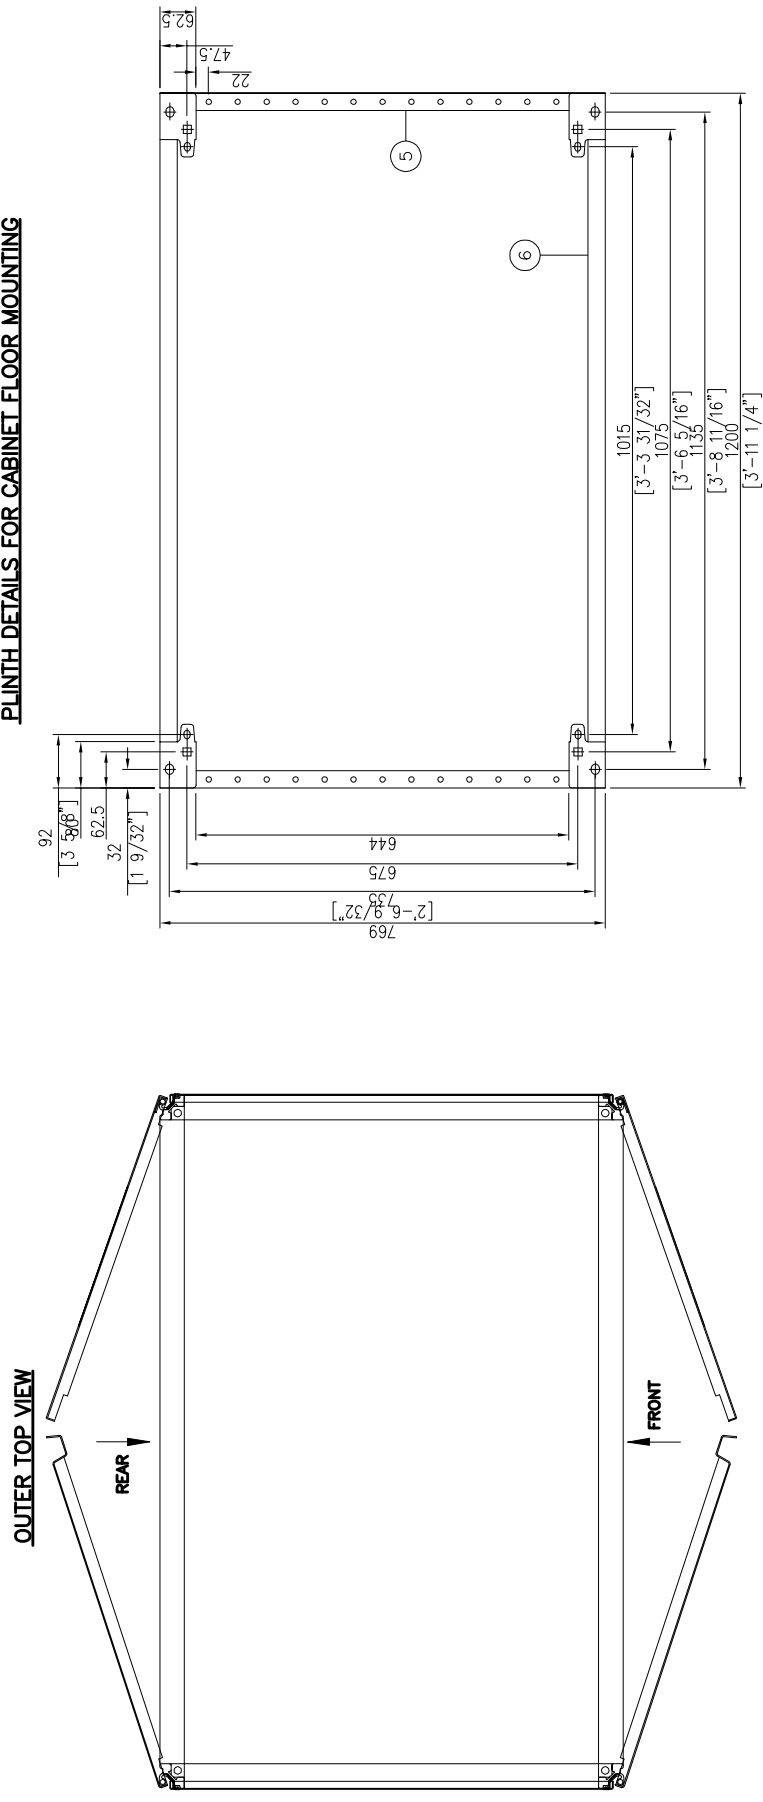


	PERMIT STAMP AND PROFESSIONAL STAMP AFFIXED ABOVE SHALL APPLY ONLY TO REV(S)		SCALE:	NTS	SIZE:	A3	EMERSON PROJECT NO.: 3258585 PROJECT TITLE: DCS SERANG PROJECT	TITLE: SYSTEM CABINET UTI-DCS-001_2 PLINTH, OUTER & INNER VIEW	EMERSON DRAWING NO.:	3258585-PSS-PASH-DWG-00023	SHEET NO.:	014
			UNITS:	mm (inch)	2018	CUSTOMER DRAWING NO.:			—	REV.:	0	



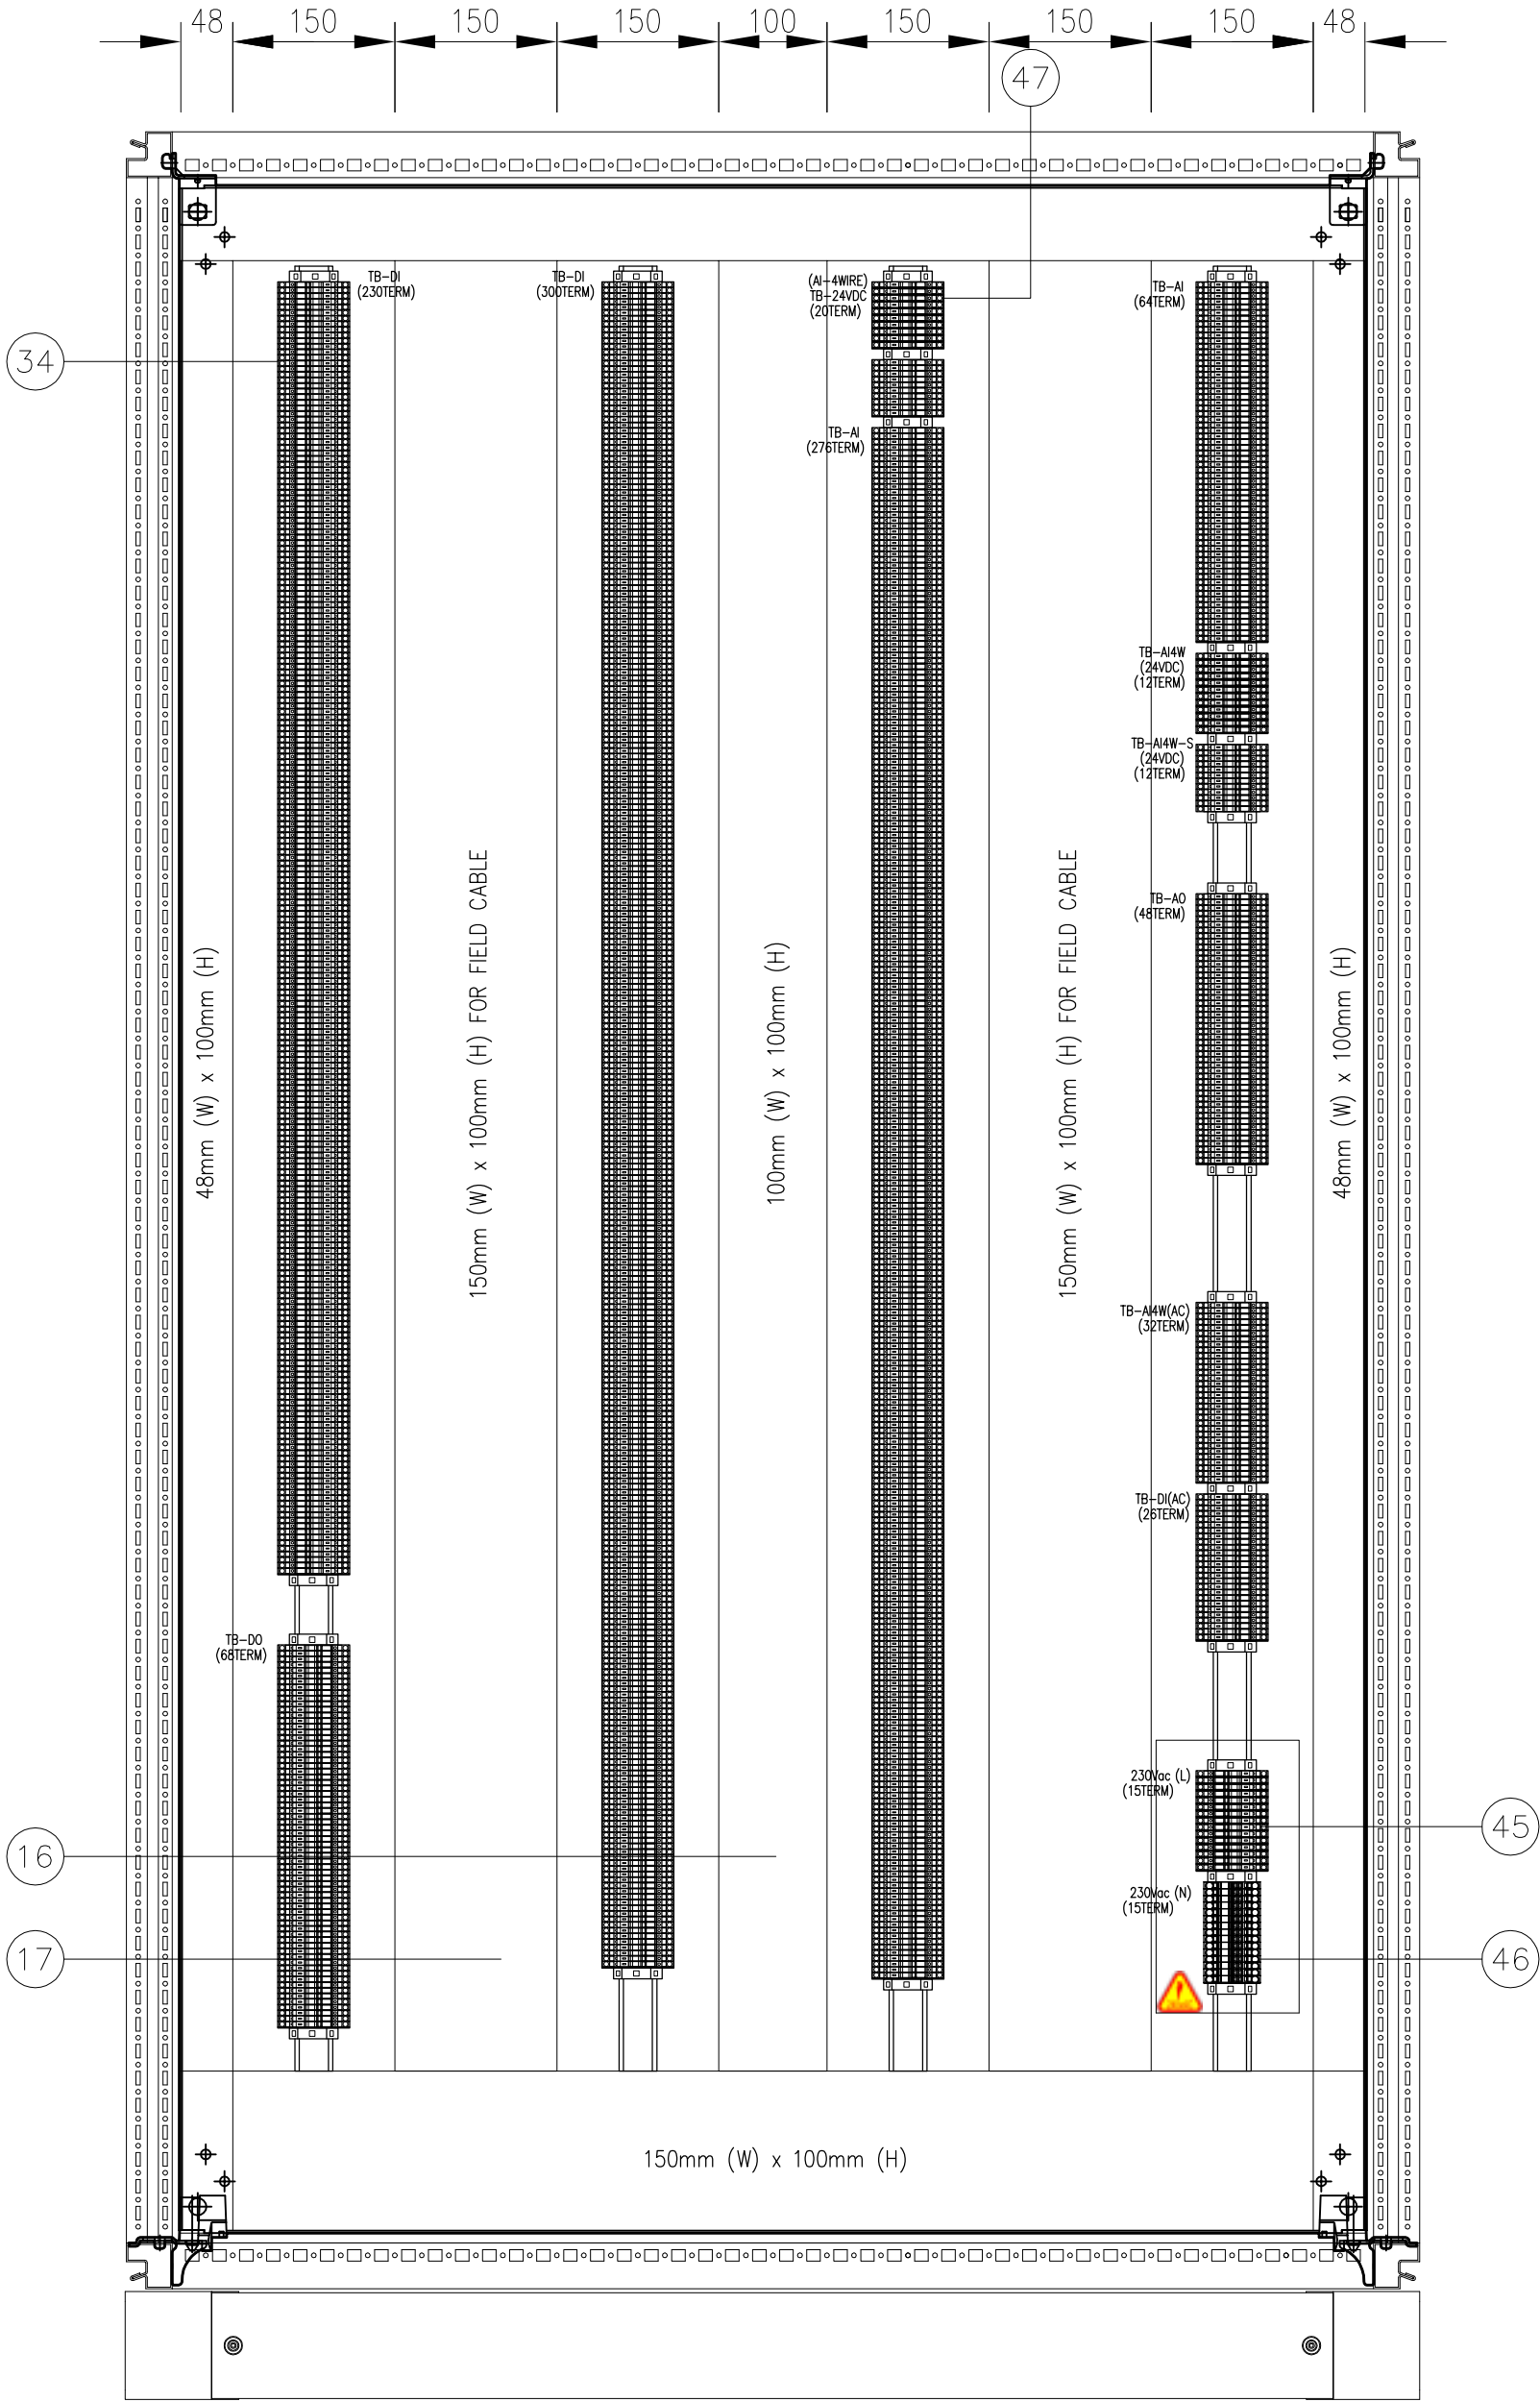

REAR VIEW

	PERMIT STAMP AND PROFESSIONAL STAMP AFFIXED ABOVE SHALL APPLY ONLY TO REV(s)		 EMERSON.	SCALE: NTS	SIZE: A3	EMERSON PROJECT NO.: 3258585 PROJECT TITLE: DCS SERANG PROJECT	TITLE: SYSTEM CABINET UTI-DCS-001_2 REAR VIEW	EMERSON DRAWING NO.: 3258585-PSS-PASH-DWG-00023	SHEET NO: 016
				UNITS: mm (inch)	© 2018			CUSTOMER DRAWING NO.: —	REV.: 0

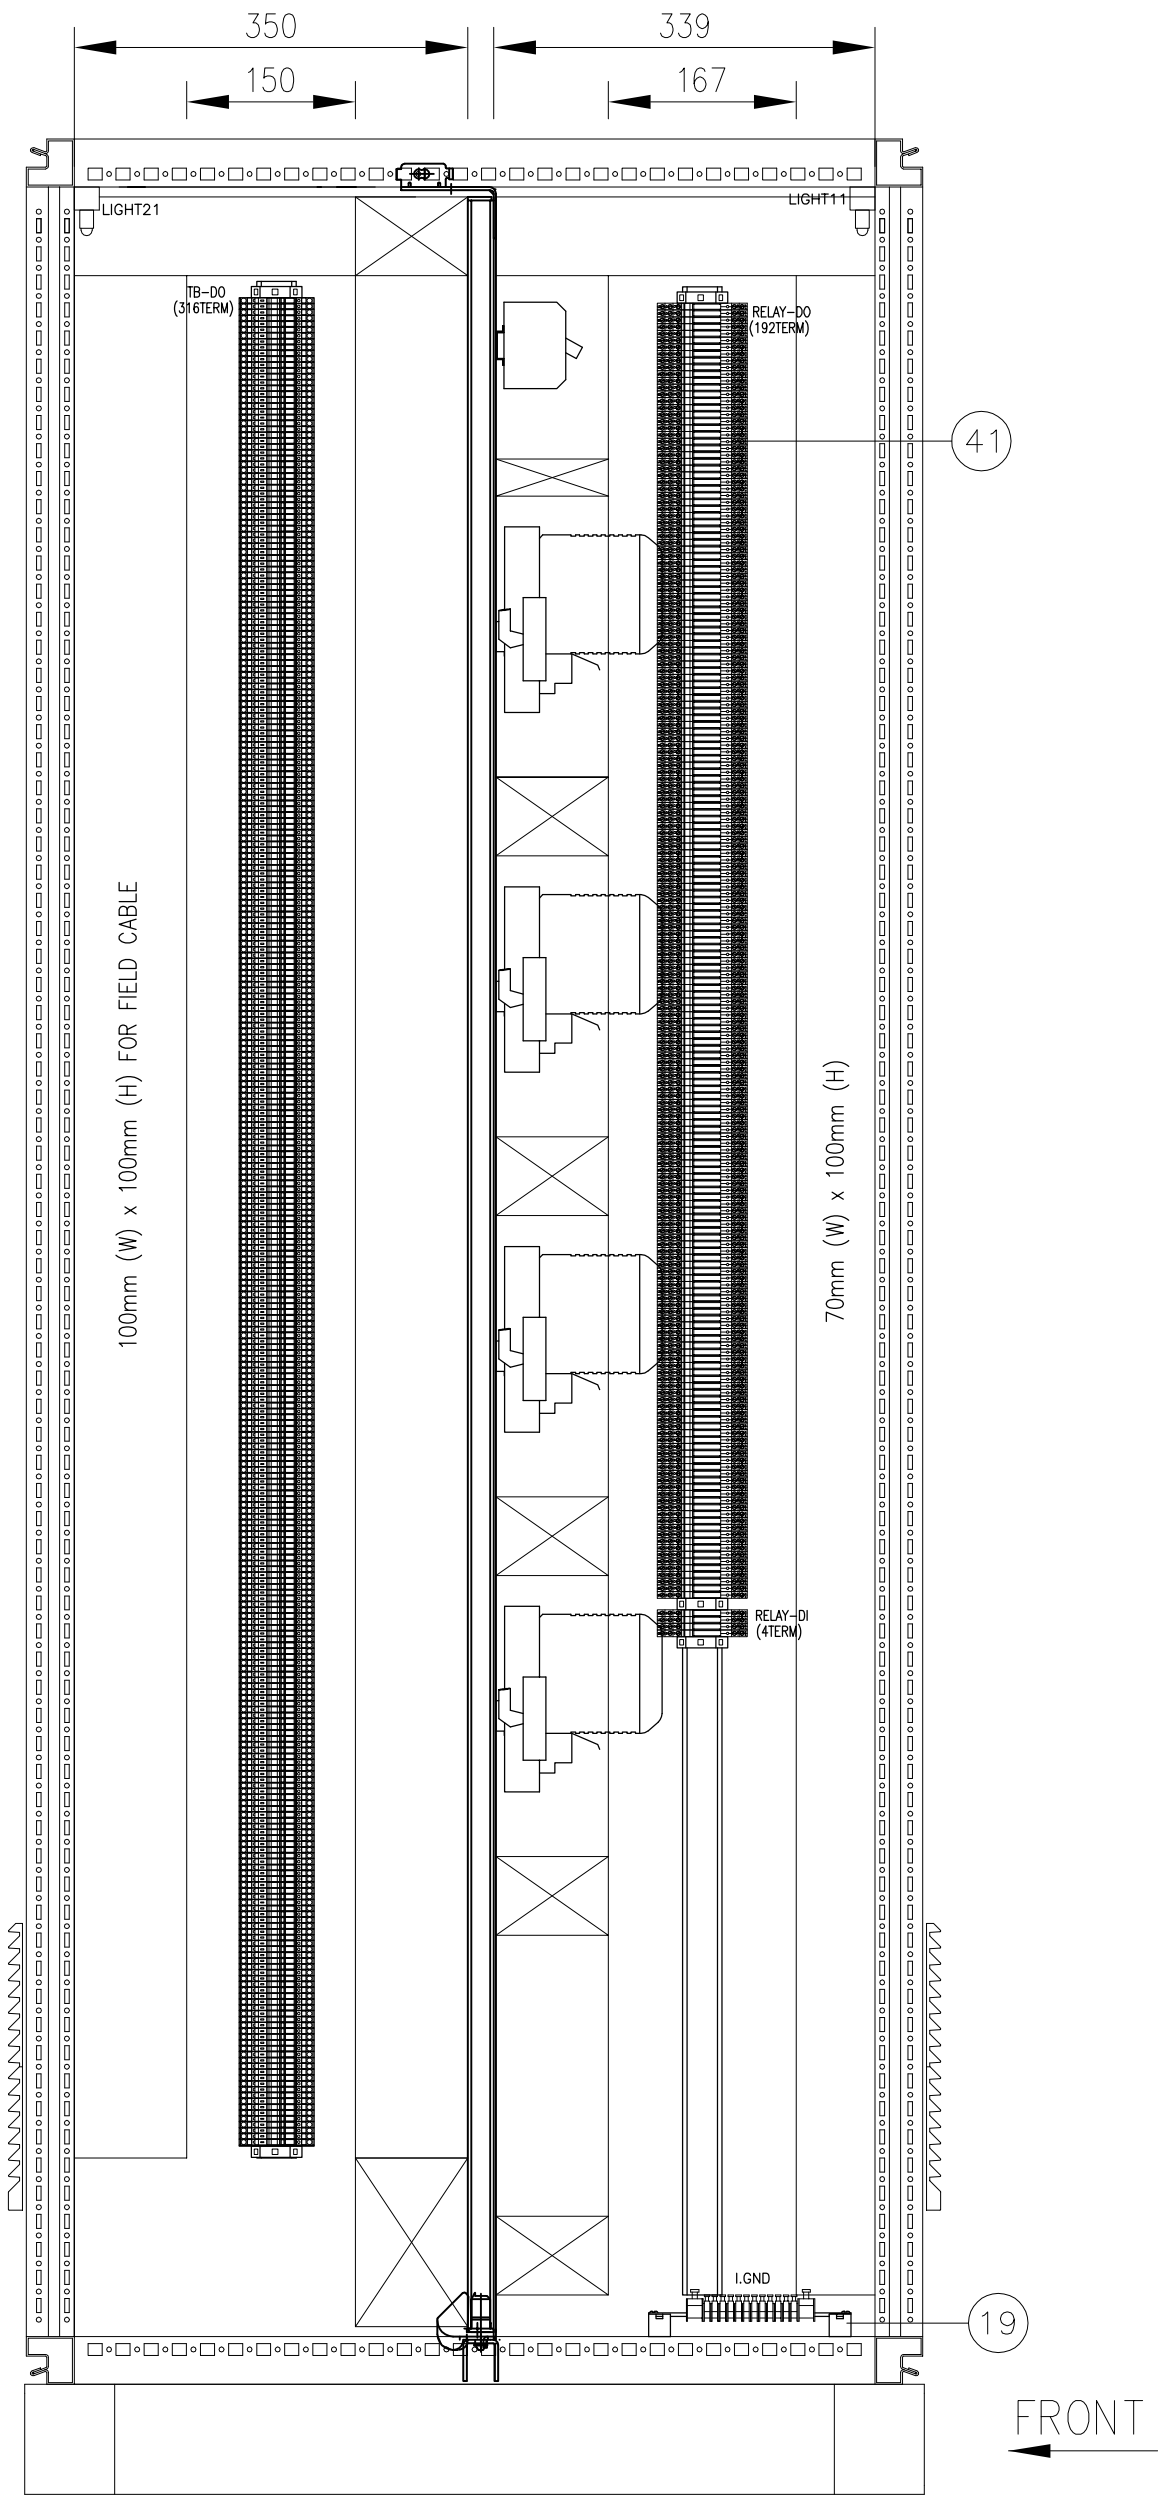

SIDE VIEW
(SECTION A-A)



PERMIT STAMP AND PROFESSIONAL STAMP
AFFIXED ABOVE SHALL APPLY ONLY TO REV(s)



SCALE: NTS
UNITS: mm (inch)

SIZE: A3
© 2018


EMERSON PROJECT NO.: 3258585
PROJECT TITLE: DCS SERANG PROJECT

TITLE: SYSTEM CABINET UTI-DCS-001_2
SIDE VIEW
(SECTION A-A)

EMERSON DRAWING NO.: 3258585-PSS-PASH-DWG-00023
CUSTOMER DRAWING NO.: -

SHEET NO: 017
REV: 0

FRONT
→

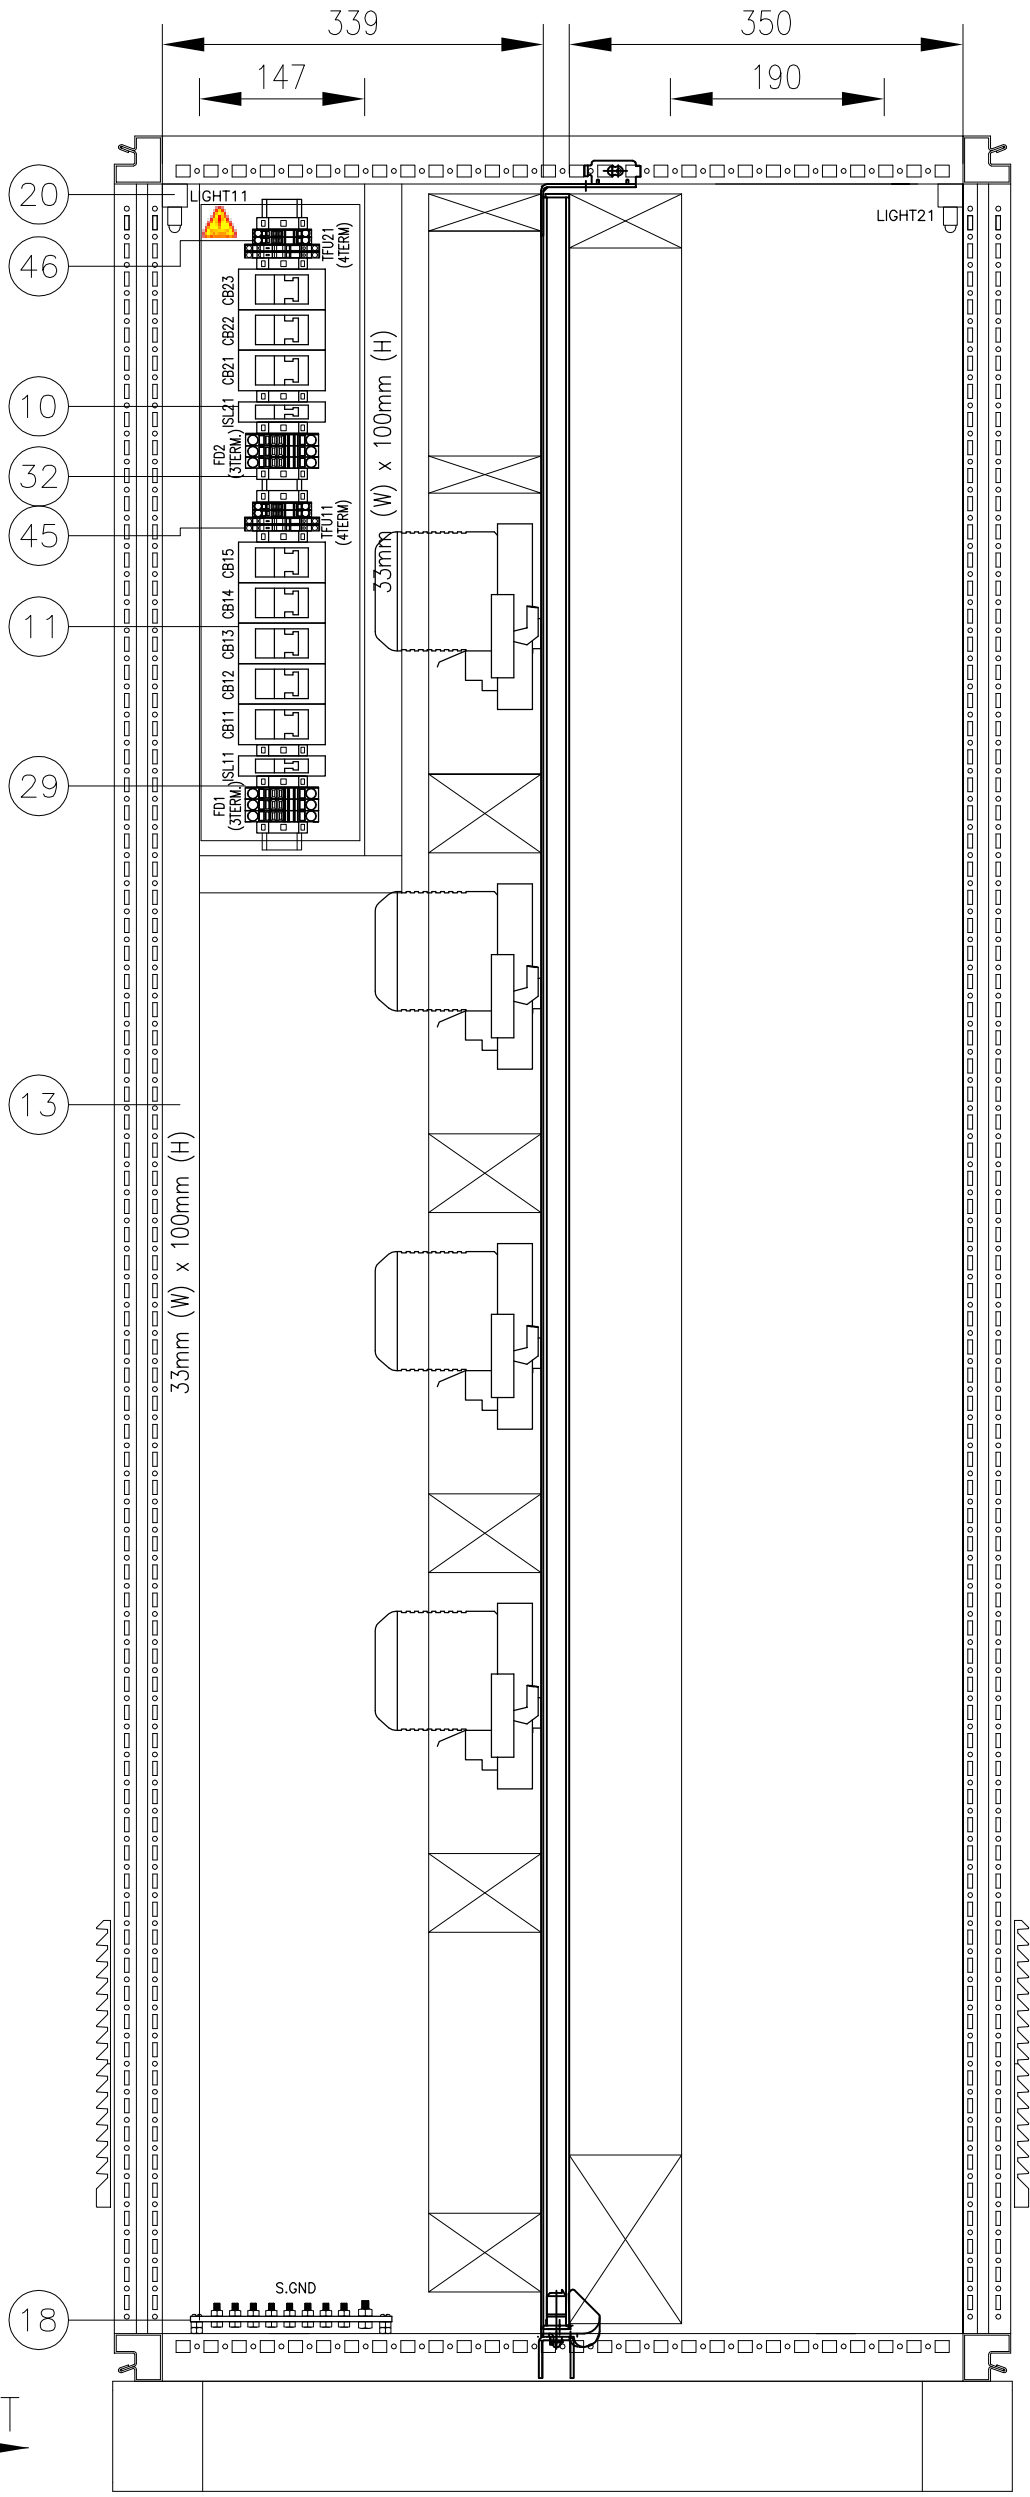

SIDE VIEW
(SECTION B-B)



PERMIT STAMP AND PROFESSIONAL STAMP
AFFIXED ABOVE SHALL APPLY ONLY TO REV(s)



SCALE: NTS
UNITS: mm (inch)

SIZE: A3
© 2018

EMERSON PROJECT NO.: 3258585
PROJECT TITLE: DCS SERANG PROJECT

TITLE: SYSTEM CABINET UTI-DCS-001_2
SIDE VIEW
(SECTION B-B)

EMERSON DRAWING NO.: 3258585-PSS-PASH-DWG-00023

SHEET NO: 018

CUSTOMER DRAWING NO.: -

REV: 0

BILL OF MATERIALS

ITEM NO.	DESCRIPTION	PART NUMBER	QTY.	MANUFACTURER
01	RITTAL CABINET (W1200mmxD800mmxH2000mm) FRONT AND REAR ACCESS	TS8808.521	1 SET	RITTAL
02	TOPTHERM ROOF-MOUNTED FAN, 500 M ² /H, 230 V, 1~, 50/60 HZ	SK3241.100	1 PC	RITTAL
03	OUTLET FILTER INCLUDING FILTER MAT	SK3240.200	2 PCS	RITTAL
04	PLASTIC WIRING PLAN POCKET, A4 POTRAIT, RAL7035	SZ2514.000	2 PCS	RITTAL
05	BASE PLINTH	TS8601.800	1 SET	RITTAL
06	TRIM PLINTH	TS8601.080	1 SET	RITTAL
07	DOOR-OPERATED SWITCH,WITHOUT CONNECTION CABLE	SZ4315.520	2 PCS	RITTAL
08	CABINET NAMEPLATE HOLDER	KJ4010X1-BX3	2 PCS	EMERSON PROCESS
09	CABINET NAMEPLATE BLANK INSERT	KJ4010X1-BX2	2 PCS	EMERSON PROCESS
10	ISOLATOR 32A	ISW	2 PCS	SCHNEIDER
11	AC MCB 2POLE (10A)	IK60N C10A	8 PCS	SCHNEIDER
12	DC MCB 2POLE (20A)	C60H-DC C20A	4 PCS	SCHNEIDER
13	33 X 100 mm PVC WIREWAY (GREY)	-	1 LOT	CONTRACTOR
14	48 X 100 mm PVC WIREWAY (GREY)	-	1 LOT	CONTRACTOR
15	70 X 100 mm PVC WIREWAY (GREY)	-	1 LOT	CONTRACTOR
16	100 X 100 mm PVC WIREWAY (GREY)	-	1 LOT	CONTRACTOR
17	150 X 100 mm PVC WIREWAY (GREY)	-	1 LOT	CONTRACTOR
18	SAFETY GROUND BAR	-	1 LOT	CONTRACTOR
19	INSTRUMENT GROUND BAR	-	1 LOT	CONTRACTOR
20	STANDARD LIGHT	-	2 PCS	CONTRACTOR
21	MX CONTROLLER	VE3007	2 PCS	EMERSON PROCESS
22	2-WIDE POWER/CONTROLLER CARRIER	VE3051C0	3 PCS	EMERSON PROCESS
23	ENHANCED SYSTEM POWER SUPPLY; (DUAL DC/DC) INPUT	VE5009	3 PCS	EMERSON PROCESS
24	SWITCH FOR PROFINET	EDS-208A-SS-SC	1 PC	MOXA
25	SWITCH FOR DELTAV	RS20-0800S2SDHEPH	2 PCS	HIRSCHMANN
26	VIRTUAL I/O MODULE 2	VE4026	1 PC	EMERSON PROCESS
27	DELTAV BULK POWER SUPPLY 100-240 V AC TO 24 V DC, 20A	VE5126	6 PCS	EMERSON PROCESS
28	DELTAV BULK POWER SUPPLY REDUNDANCY MODULE, 12 V DC TO 28 V DC, 40 A	VE5135	4 PCS	EMERSON PROCESS
29	2-COND THROUGH TERMINAL BLOCK, 10MM SQ	2010-1201	6 PCS	WAGO
30	FUSE DISCONNECT TB WITH FUSE BLOW INDICATOR, 24VDC, 6MM SQ	2006-1611/1000-0541	20 PCS	WAGO
31	2-COND THROUGH TERMINAL BLOCK, 4MM SQ	2004-1201	56 PCS	WAGO
32	END STOPPER	249-117	1 LOT	WAGO
33	8-WIDE I/O INTERFACE CARRIER WITH CARRIER SHIELD BAR	VE3051C0	4 PCS	EMERSON PROCESS
34	TERMINAL BLOCK DISCONNECT TERMINAL BLOCK, 2.5MM SQ	2002-1671	1368 PCS	WAGO





PERMIT STAMP AND PROFESSIONAL STAMP
AFFIXED ABOVE SHALL APPLY ONLY TO REV(s)


EMERSON PROJECT NO.: **3258585**
PROJECT TITLE:
DCS SERANG PROJECT

TITLE:
SYSTEM CABINET UTI-DCS-001_2
BILL OF MATERIALS

EMERSON DRAWING NO.:
3258585-PSS-PASH-DWG-00023
CUSTOMER DRAWING NO.:
_

SHEET NO:
019

REV.:
0

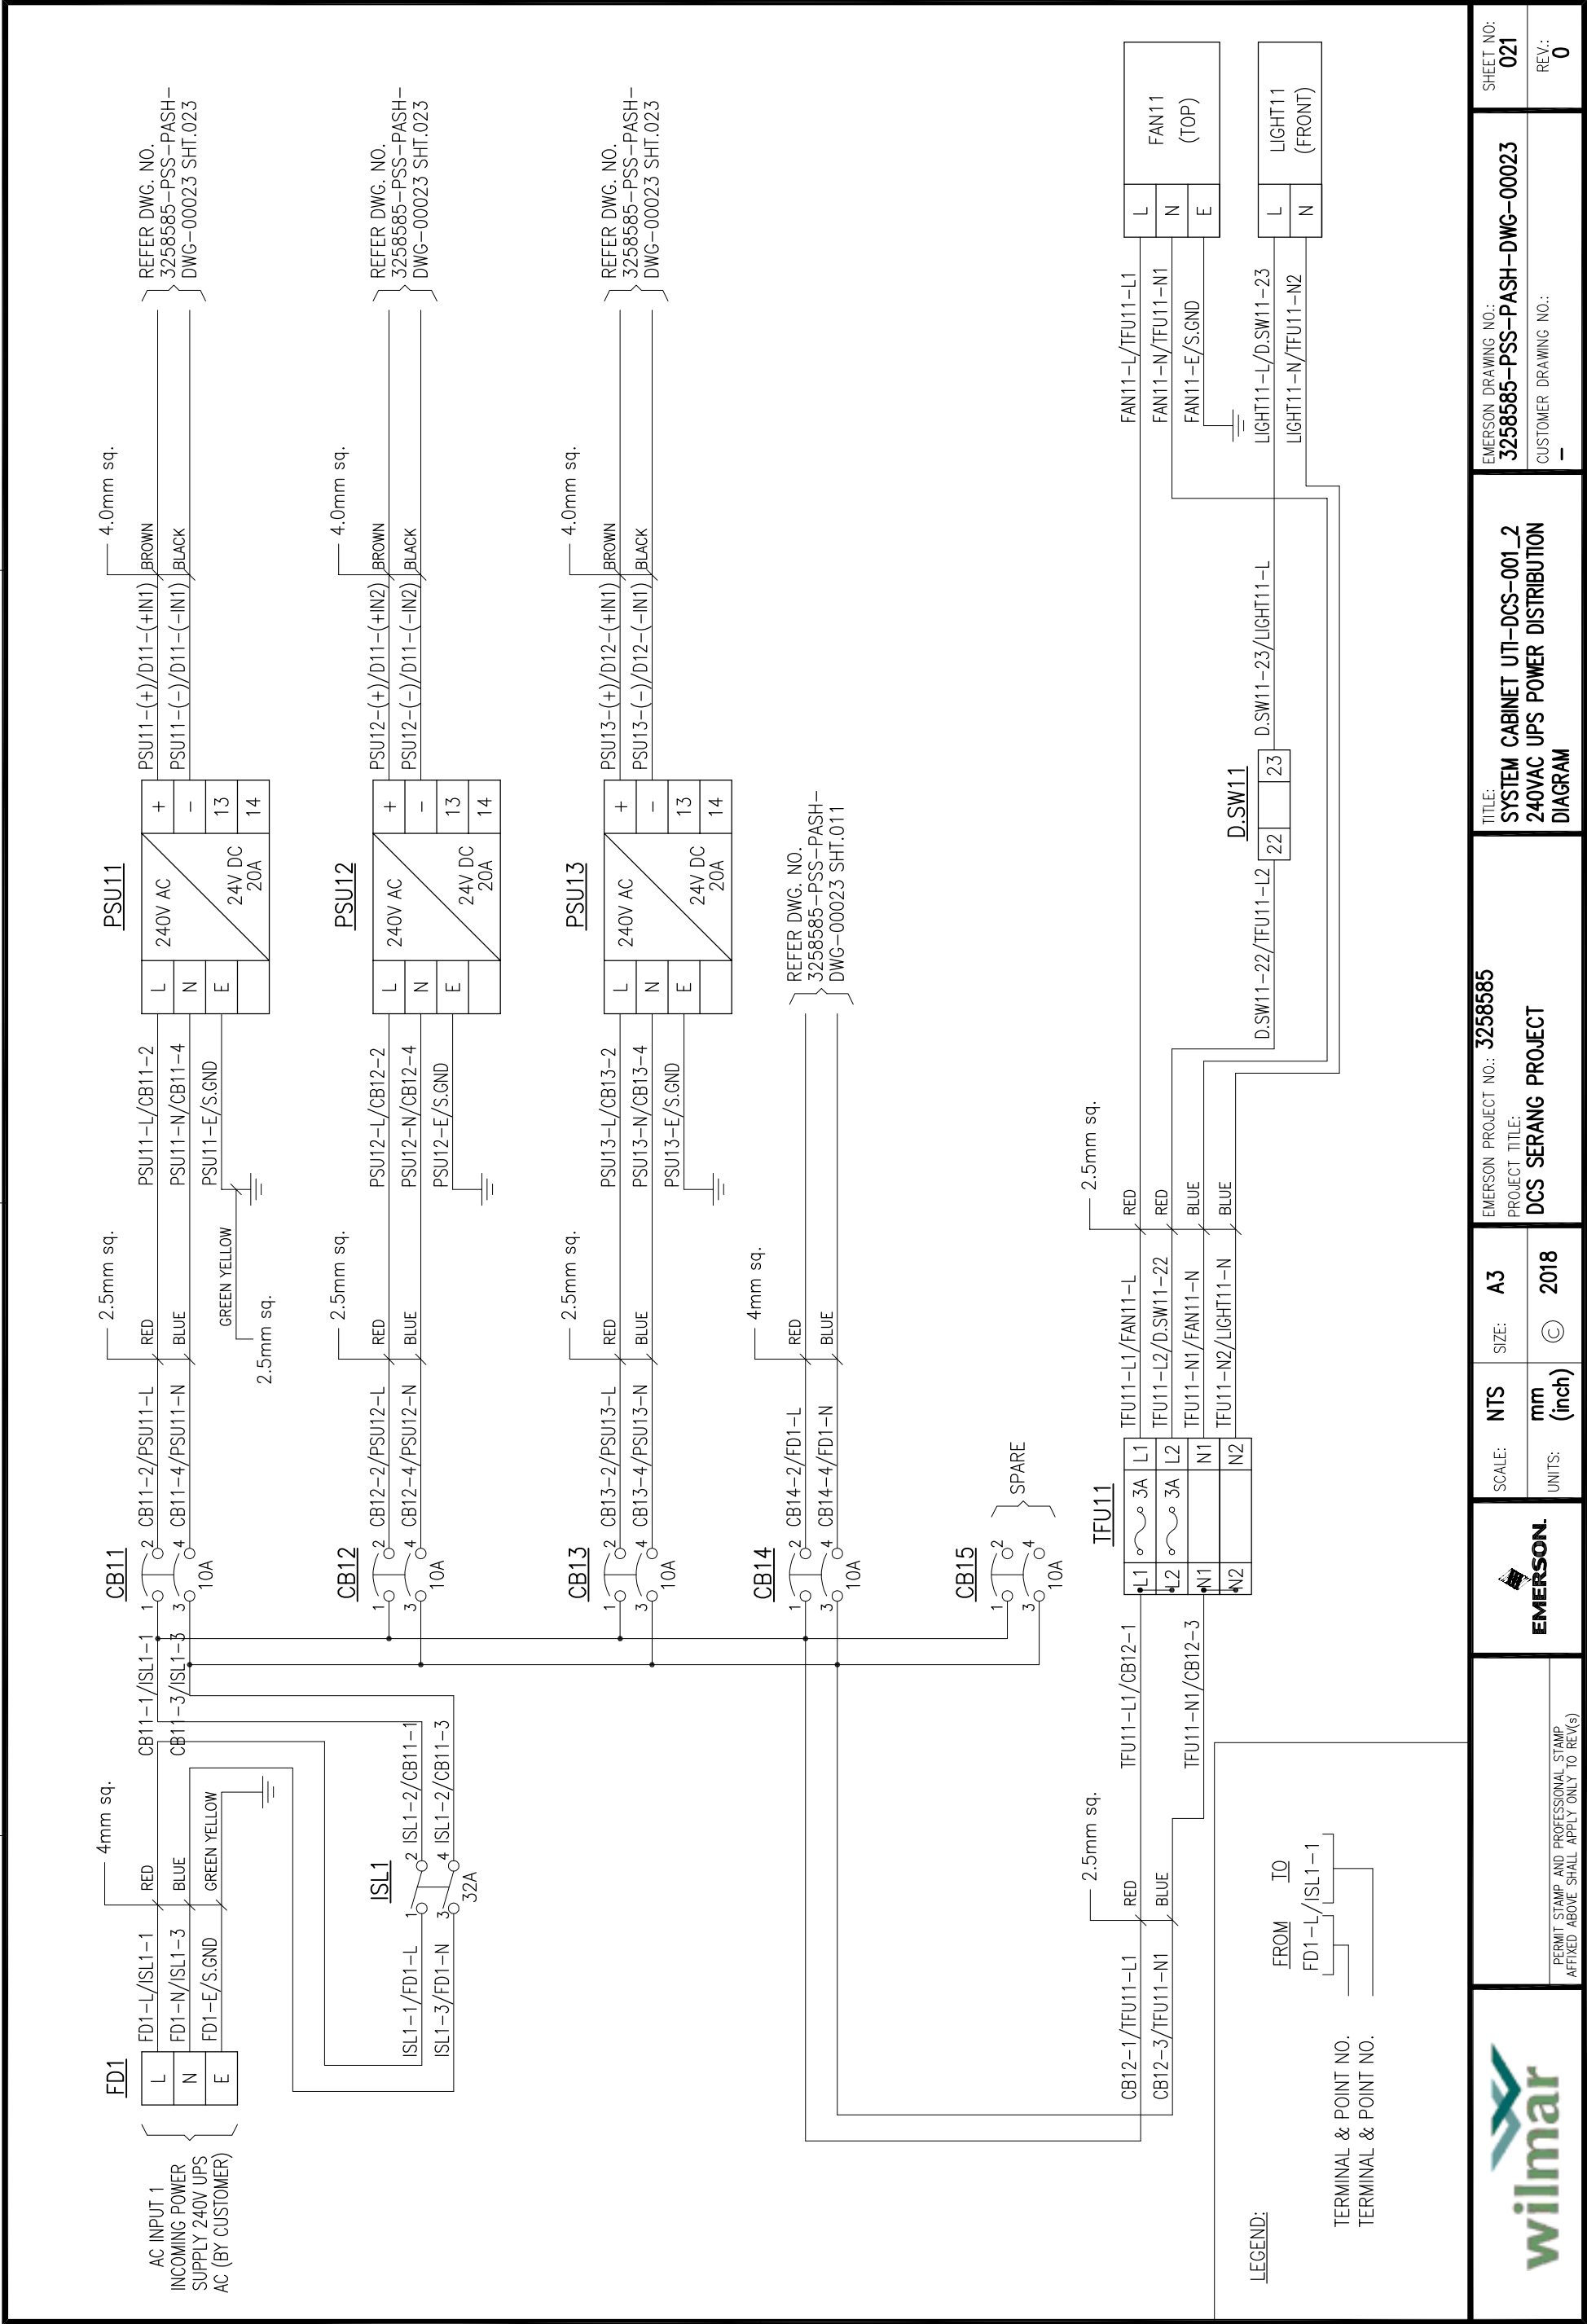



LEGEND:

FROM

TO

FD1-L/ISL1-1

TERMINAL & POINT NO.

TERMINAL & POINT NO.

	PERMIT STAMP AND PROFESSIONAL STAMP AFFIXED ABOVE SHALL APPLY ONLY TO REV(s)	EMERSON PROJECT NO.: 3258585		TITLE: SYSTEM CABINET UTI-DCS-001_2 24VDC POWER DISTRIBUTION DIAGRAM		EMERSON DRAWING NO.: 3258585-PSS-PASH-DWG-00023	SHEET NO: 023
		PROJECT TITLE: DCS SERANG PROJECT		PROJECT TITLE: DCS SERANG PROJECT		CUSTOMER DRAWING NO.: -	REV.: 0

THIS DRAWING IS THE PROPERTY OF EMERSON PROCESS MANAGEMENT. INFORMATION AND KNOW HOW HEREIN ARE CONFIDENTIAL AND MAY NOT BE USED, REPRODUCED OR REVEALED TO OTHERS EXCEPT IN ACCORDANCE WITH CONTRACT OR OTHER WRITTEN CONSENT OF EMERSON PROCESS MANAGEMENT. ANY PERMITTED REPRODUCTION IN WHOLE OR IN PART, INCLUDING SHOP DRAWINGS MUST BEAR OR REFER TO THIS LEGEND.



TERMINAL & POINT NO.

TERMINAL & POINT NO.

LEGEND:

FROM

TO

FD1-L/ISL1-1

2.5mm sq.

