


DOCUMENT STATUS	
FOR INFORMATION	☐
COMMENTED	☐
APPROVED WITH COMMENTS	☐
APPROVED FOR DESIGN/CONSTRUCTION	☐
REJECTED	☐

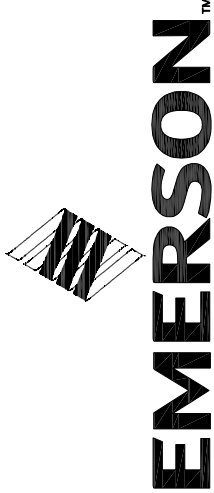

GENERAL AND INTERNAL ARRANGEMENT DRAWING

NETWORK CABINET

DCS SERANG PROJECT

									CUSTOMER : CONTRACT NO. : PROJECT TITLE : CUSTOMER PROJECT NO. : WILMAR INDUSTRIAL COMPLEX PT MNA SERANG, INDONESIA - DCS SERANG PROJECT -
0	AS BUILT	29/08/19	AS/NAM	LKL	MNI				
C	ISSUE FOR COMMENT	14/11/18	AS	LKL	MNI				
B	ISSUE FOR COMMENT	12/09/18	AS	LKL	MNI				
A	ISSUE FOR COMMENT	31/07/18	AS	LKL	MNI				
REV.	DESCRIPTION	DATE	DRAWN BY	CHECKED BY	APPROVED BY				

	PERMIT STAMP AND PROFESSIONAL STAMP AFFIXED ABOVE SHALL APPLY ONLY TO REV(s)		SCALE: NTS UNITS: mm (inch)	SIZE: A3 © 2018	EMERSON PROJECT NO.: 3258585 PROJECT TITLE: DCS SERANG PROJECT	TITLE: COVER SHEET	EMERSON DRAWING NO.: 3258585-PSS-PASH-DWG-00010	SHEET NO.: 001
							CUSTOMER DRAWING NO.: -	REV.: 0

DRAWING INDEX & REVISION

DRAWING NO.		DRAWING TITLE										DATE	REV.	DATE	REV.	DATE	REV.	DATE	REV.
3258585-PSS-PASH-DWG-00010	SHT.001	COVER SHEET										31/07/18	A	12/09/18	B	14/11/18	C	29/08/19	0
3258585-PSS-PASH-DWG-00010	SHT.002	DRAWING INDEX & REVISION										31/07/18	A	12/09/18	B	14/11/18	C	29/08/19	0
3258585-PSS-PASH-DWG-00010	SHT.003	NETWORK CABINET CR1-NET-001 – (FRONT DOOR VIEW, RIGHT SIDE & LEFT SIDE VIEW)										31/07/18	A	12/09/18	B	14/11/18	C	29/08/19	0
3258585-PSS-PASH-DWG-00010	SHT.004	NETWORK CABINET CR1-NET-001 – (BOTTOM VIEW)										31/07/18	A	12/09/18	B	14/11/18	C	29/08/19	0
3258585-PSS-PASH-DWG-00010	SHT.005	NETWORK CABINET CR1-NET-001 – (FRONT VIEW, SECTION A-A & SECTION B-B)										31/07/18	A	12/09/18	B	14/11/18	C	29/08/19	0
3258585-PSS-PASH-DWG-00010	SHT.006	NETWORK CABINET CR1-NET-001 – BILL OF MATERIAL										31/07/18	A	12/09/18	B	14/11/18	C	29/08/19	0
3258585-PSS-PASH-DWG-00010	SHT.007	NETWORK CABINET CR1-NET-001 – 240VAC UPS POWER DISTRIBUTION DIAGRAM										31/07/18	A	12/09/18	B	14/11/18	C	29/08/19	0
3258585-PSS-PASH-DWG-00010	SHT.008	NETWORK CABINET CR1-NET-001 – 24VDC POWER DISTRIBUTION DIAGRAM										31/07/18	A	12/09/18	B	14/11/18	C	29/08/19	0
3258585-PSS-PASH-DWG-00010	SHT.009	NETWORK CABINET CR2-NET-001 – (FRONT DOOR VIEW, RIGHT SIDE & LEFT SIDE VIEW)										31/07/18	A	12/09/18	B	14/11/18	C	29/08/19	0
3258585-PSS-PASH-DWG-00010	SHT.010	NETWORK CABINET CR2-NET-001 – (BOTTOM VIEW)										31/07/18	A	12/09/18	B	14/11/18	C	29/08/19	0
3258585-PSS-PASH-DWG-00010	SHT.011	NETWORK CABINET CR2-NET-001 – (FRONT VIEW, SECTION A-A & SECTION B-B)										31/07/18	A	12/09/18	B	14/11/18	C	29/08/19	0
3258585-PSS-PASH-DWG-00010	SHT.012	NETWORK CABINET CR2-NET-001 – BILL OF MATERIAL										31/07/18	A	12/09/18	B	14/11/18	C	29/08/19	0
3258585-PSS-PASH-DWG-00010	SHT.013	NETWORK CABINET CR2-NET-001 – 240VAC UPS POWER DISTRIBUTION DIAGRAM										31/07/18	A	12/09/18	B	14/11/18	C	29/08/19	0
3258585-PSS-PASH-DWG-00010	SHT.014	NETWORK CABINET CR2-NET-001 – 24VDC POWER DISTRIBUTION DIAGRAM										31/07/18	A	12/09/18	B	14/11/18	C	29/08/19	0
3258585-PSS-PASH-DWG-00010	SHT.015	NETWORK CABINET CR3-NET-001 – (FRONT DOOR VIEW, RIGHT SIDE & LEFT SIDE VIEW)										31/07/18	A	12/09/18	B	14/11/18	C	29/08/19	0
3258585-PSS-PASH-DWG-00010	SHT.016	NETWORK CABINET CR3-NET-001 – (BOTTOM VIEW)										31/07/18	A	12/09/18	B	14/11/18	C	29/08/19	0
3258585-PSS-PASH-DWG-00010	SHT.017	NETWORK CABINET CR3-NET-001 – (FRONT VIEW, SECTION A-A & SECTION B-B)										31/07/18	A	12/09/18	B	14/11/18	C	29/08/19	0
3258585-PSS-PASH-DWG-00010	SHT.018	NETWORK CABINET CR3-NET-001 – BILL OF MATERIAL										31/07/18	A	12/09/18	B	14/11/18	C	29/08/19	0
3258585-PSS-PASH-DWG-00010	SHT.019	NETWORK CABINET CR3-NET-001 – 240VAC UPS POWER DISTRIBUTION DIAGRAM										31/07/18	A	12/09/18	B	14/11/18	C	29/08/19	0
3258585-PSS-PASH-DWG-00010	SHT.020	NETWORK CABINET CR3-NET-001 – 24VDC POWER DISTRIBUTION DIAGRAM										31/07/18	A	12/09/18	B	14/11/18	C	29/08/19	0
3258585-PSS-PASH-DWG-00010	SHT.021	NETWORK CABINET CR4-NET-001 – (FRONT DOOR VIEW, RIGHT SIDE & LEFT SIDE VIEW)										31/07/18	A	12/09/18	B	14/11/18	C	29/08/19	0
3258585-PSS-PASH-DWG-00010	SHT.022	NETWORK CABINET CR4-NET-001 – (BOTTOM VIEW)										31/07/18	A	12/09/18	B	14/11/18	C	29/08/19	0
3258585-PSS-PASH-DWG-00010	SHT.023	NETWORK CABINET CR4-NET-001 – (FRONT VIEW, SECTION A-A & SECTION B-B)										31/07/18	A	12/09/18	B	14/11/18	C	29/08/19	0
3258585-PSS-PASH-DWG-00010	SHT.024	NETWORK CABINET CR4-NET-001 – BILL OF MATERIAL										31/07/18	A	12/09/18	B	14/11/18	C	29/08/19	0
3258585-PSS-PASH-DWG-00010	SHT.025	NETWORK CABINET CR4-NET-001 – 240VAC UPS POWER DISTRIBUTION DIAGRAM										31/07/18	A	12/09/18	B	14/11/18	C	29/08/19	0
3258585-PSS-PASH-DWG-00010	SHT.026	NETWORK CABINET CR4-NET-001 – 24VDC POWER DISTRIBUTION DIAGRAM										31/07/18	A	12/09/18	B	14/11/18	C	29/08/19	0
3258585-PSS-PASH-DWG-00010	SHT.027	NETWORK CABINET CR5-NET-001 – (FRONT DOOR VIEW, RIGHT SIDE & LEFT SIDE VIEW)										31/07/18	A	12/09/18	B	14/11/18	C	29/08/19	0
3258585-PSS-PASH-DWG-00010	SHT.028	NETWORK CABINET CR5-NET-001 – (BOTTOM VIEW)										31/07/18	A	12/09/18	B	14/11/18	C	29/08/19	0
3258585-PSS-PASH-DWG-00010	SHT.029	NETWORK CABINET CR5-NET-001 – (FRONT VIEW, SECTION A-A & SECTION B-B)										31/07/18	A	12/09/18	B	14/11/18	C	29/08/19	0
3258585-PSS-PASH-DWG-00010	SHT.030	NETWORK CABINET CR5-NET-001 – BILL OF MATERIAL										31/07/18	A	12/09/18	B	14/11/18	C	29/08/19	0
3258585-PSS-PASH-DWG-00010	SHT.031	NETWORK CABINET CR5-NET-001 – 240VAC UPS POWER DISTRIBUTION DIAGRAM										31/07/18	A	12/09/18	B	14/11/18	C	29/08/19	0
3258585-PSS-PASH-DWG-00010	SHT.032	NETWORK CABINET CR5-NET-001 – 24VDC POWER DISTRIBUTION DIAGRAM										31/07/18	A	12/09/18	B	14/11/18	C	29/08/19	0
3258585-PSS-PASH-DWG-00010	SHT.033	NETWORK CABINET CR6-NET-001 – (FRONT DOOR VIEW, RIGHT SIDE & LEFT SIDE VIEW)										31/07/18	A	12/09/18	B	14/11/18	C	29/08/19	0
3258585-PSS-PASH-DWG-00010	SHT.034	NETWORK CABINET CR6-NET-001 – (BOTTOM VIEW)										31/07/18	A	12/09/18	B	14/11/18	C	29/08/19	0
3258585-PSS-PASH-DWG-00010	SHT.035	NETWORK CABINET CR6-NET-001 – (FRONT VIEW, SECTION A-A & SECTION B-B)										31/07/18	A	12/09/18	B	14/11/18	C	29/08/19	0
3258585-PSS-PASH-DWG-00010	SHT.036	NETWORK CABINET CR6-NET-001 – BILL OF MATERIAL										31/07/18	A	12/09/18	B	14/11/18	C	29/08/19	0
3258585-PSS-PASH-DWG-00010	SHT.037	NETWORK CABINET CR6-NET-001 – 240VAC UPS POWER DISTRIBUTION DIAGRAM										31/07/18	A	12/09/18	B	14/11/18	C	29/08/19	0
3258585-PSS-PASH-DWG-00010	SHT.038	NETWORK CABINET CR6-NET-001 – 24VDC POWER DISTRIBUTION DIAGRAM										31/07/18	A	12/09/18	B	14/11/18	C	29/08/19	0



PERMIT STAMP AND PROFESSIONAL STAMP
AFFIXED ABOVE SHALL APPLY ONLY TO REV(s)



EMERSON PROJECT NO.: 3258585

PROJECT TITLE: DCS SERANG PROJECT

SCALE: NTS

SIZE: A3

UNITS: mm (inch)

© 2018


TITLE: DRAWING INDEX & REVISION

EMERSON DRAWING NO.: 3258585-PSS-PASH-DWG-00010

SHEET NO: 002

REV.: 0

THIS DRAWING IS THE PROPERTY OF EMERSON PROCESS MANAGEMENT. INFORMATION AND KNOW HOW HEREIN ARE CONFIDENTIAL AND MAY NOT BE USED, REPRODUCED OR REVEALED TO OTHERS EXCEPT IN ACCORDANCE WITH CONTRACT OR OTHER WRITTEN CONSENT OF EMERSON PROCESS MANAGEMENT. ANY PERMITTED REPRODUCTION IN WHOLE OR IN PART, INCLUDING SHOP DRAWINGS MUST BEAR OR REFER TO THIS LEGEND.

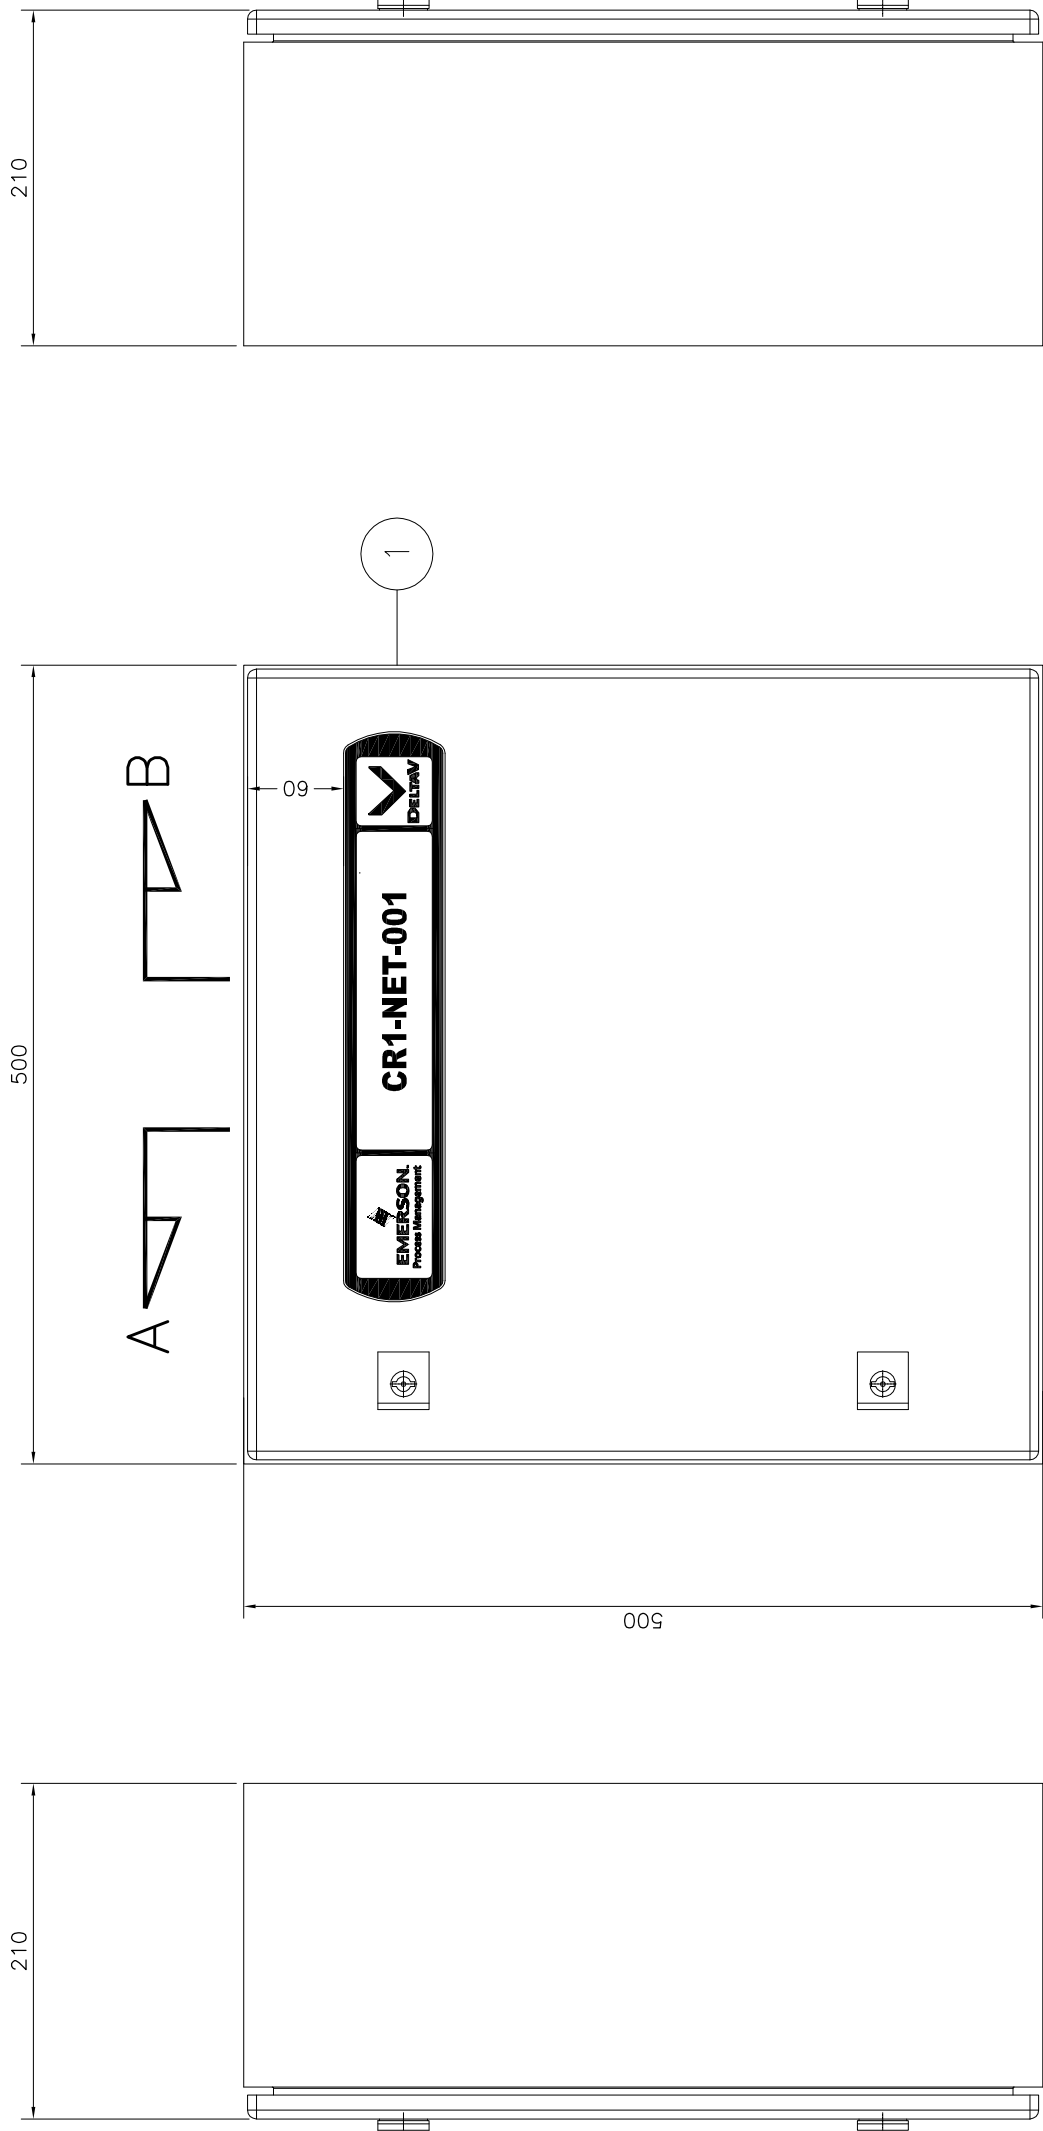

LEFT SIDE VIEW


NETWORK CABINET – CR1 –NET–001

RIGHT SIDE VIEW

NETWORK CABINET – CR1 –NET–001

NOTE: NETWORK CABINET FOR THIN CLIENT
IN CONTROL ROOMS

		EMERSON PROJECT NO.: 3258585 PROJECT TITLE: DCS SERANG PROJECT		TITLE: NETWORK CABINET CR1–NET–001 (FRONT DOOR VIEW, RIGHT SIDE & LEFT SIDE VIEW)		EMERSON DRAWING NO.: 3258585–PSS–PASH–DWG–00010	SHEET NO: 003
		SCALE: NTS UNITS: mm (inch)	SIZE: A3 © 2018			CUSTOMER DRAWING NO.: –	REV.: 0

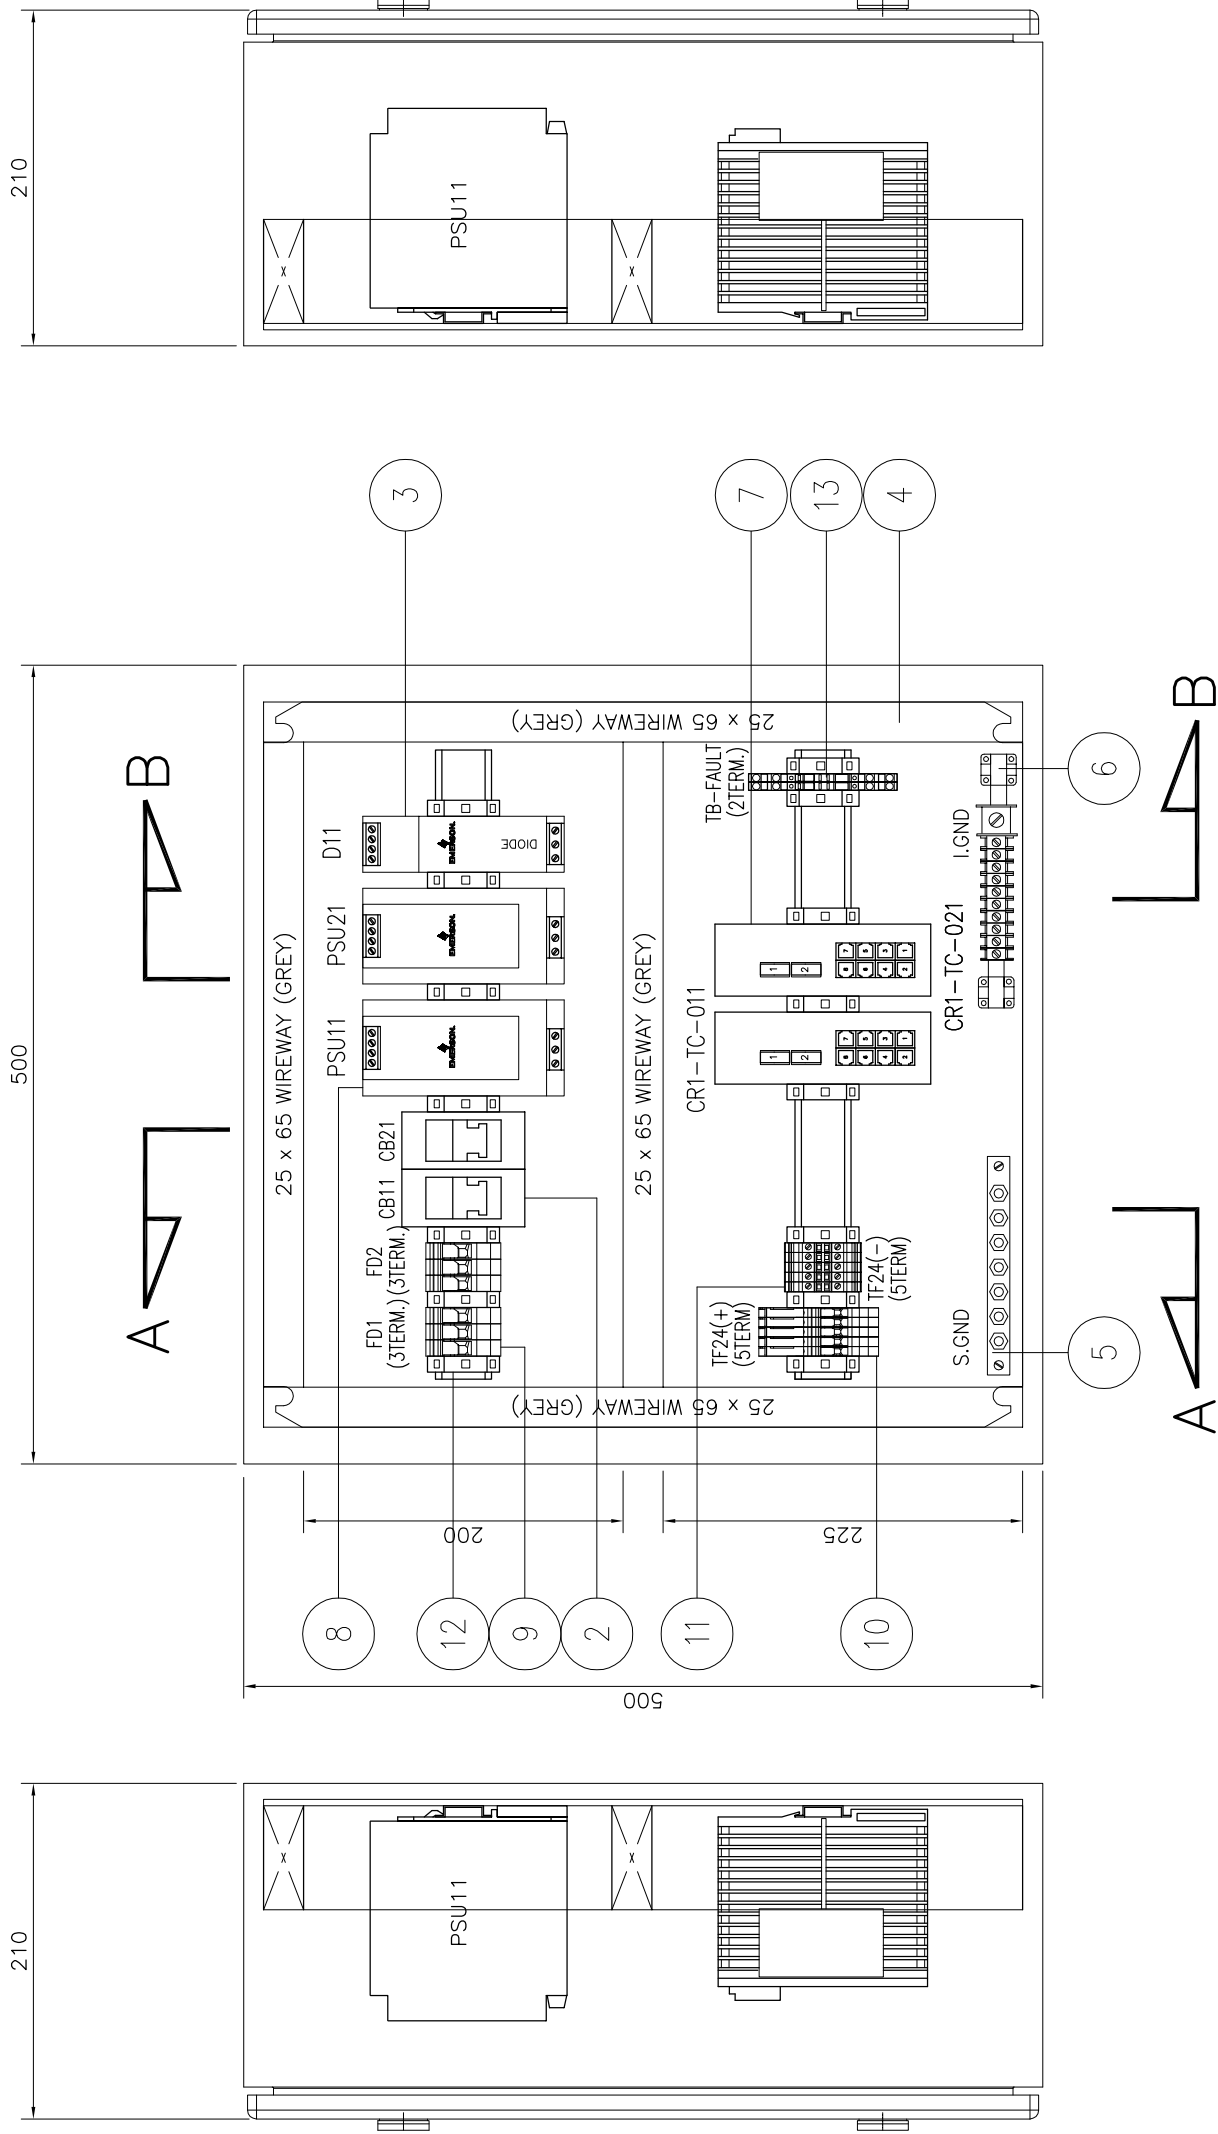

SECTION A-A

NETWORK CABINET – CR1–NET–001

FRONT VIEW

NETWORK CABINET – CR1–NET–001

SECTION B-B

NETWORK CABINET – CR1–NET–001

	PERMIT STAMP AND PROFESSIONAL STAMP AFFIXED ABOVE SHALL APPLY ONLY TO REV(s)		SCALE: NTS UNITS: mm (inch)	SIZE: A3 © 2018	EMERSON PROJECT NO.: 3258585 PROJECT TITLE: DCS SERANG PROJECT	TITLE: NETWORK CABINET CR1–NET–001 (FRONT VIEW, SECTION A-A & SECTION B-B)	EMERSON DRAWING NO.: 3258585–PSS–PASH–DWG–00010	SHEET NO: 005
							CUSTOMER DRAWING NO.: –	REV: 0

BILL OF MATERIALS

ITEM NO.	DESCRIPTION		PART NUMBER	QTY.	MANUFACTURER
01	RITTAL CABINET (W500 X H500 X D210) FRONT ACCESS		AE1050.500	1 SET	RITTAL
02	AC MCB 2POLE (6A)		IK60N C6A	2 PCS	SCHNEIDER
03	DELTA V BULK POWER SUPPLY REDUNDANCY MODULE, 12 V DC TO 28 V DC, 20 A		VE5134	1 PC	EMERSON PROCESS
04	25 X 65 mm PVC WIREWAY (GREY)		-	1 LOT	CONTRACTOR
05	SAFETY GROUND BAR		-	1 LOT	CONTRACTOR
06	INSTRUMENT GROUND BAR		-	1 LOT	CONTRACTOR
07	ETHERNET SWITCH 8-PORT		ISF3010D	2 PCS	INHAND
08	DELTA V BULK POWER SUPPLY 100-240 V AC TO 24 V DC, 10A		VE5123	2 PCS	EMERSON PROCESS
09	2-COND THROUGH TERMINAL BLOCK, 10MM SQ		2010-1201	6 PCS	WAGO
10	FUSE DISCONNECT TB WITH FUSE BLOW INDICATOR, 24VDC, 4MM SQ		2004-1611/1000-0541	5 PCS	WAGO
11	2-COND THROUGH TERMINAL BLOCK, 4MM SQ		2004-1201	5 PCS	WAGO
12	END STOPPER		249-117	1 LOT	WAGO
13	DOUBLE DECK DISCONNECT TERMINAL BLOCK, 2.5MM SQ		2002-2671	2 PCS	WAGO
14					
15					
PERMIT STAMP AND PROFESSIONAL STAMP
AFFIXED ABOVE SHALL APPLY ONLY TO REV(s)



EMERSON PROJECT NO.: 3258585
PROJECT TITLE: DCS SERANG PROJECT


SCALE: NTS
UNITS: mm (inch)

SIZE: A3
2018

TITLE: NETWORK CABINET CR1-NET-001
BILL OF MATERIAL

EMERSON DRAWING NO.: 3258585-PSS-PASH-DWG-00010
CUSTOMER DRAWING NO.: -

SHEET NO: 006
REV: 0

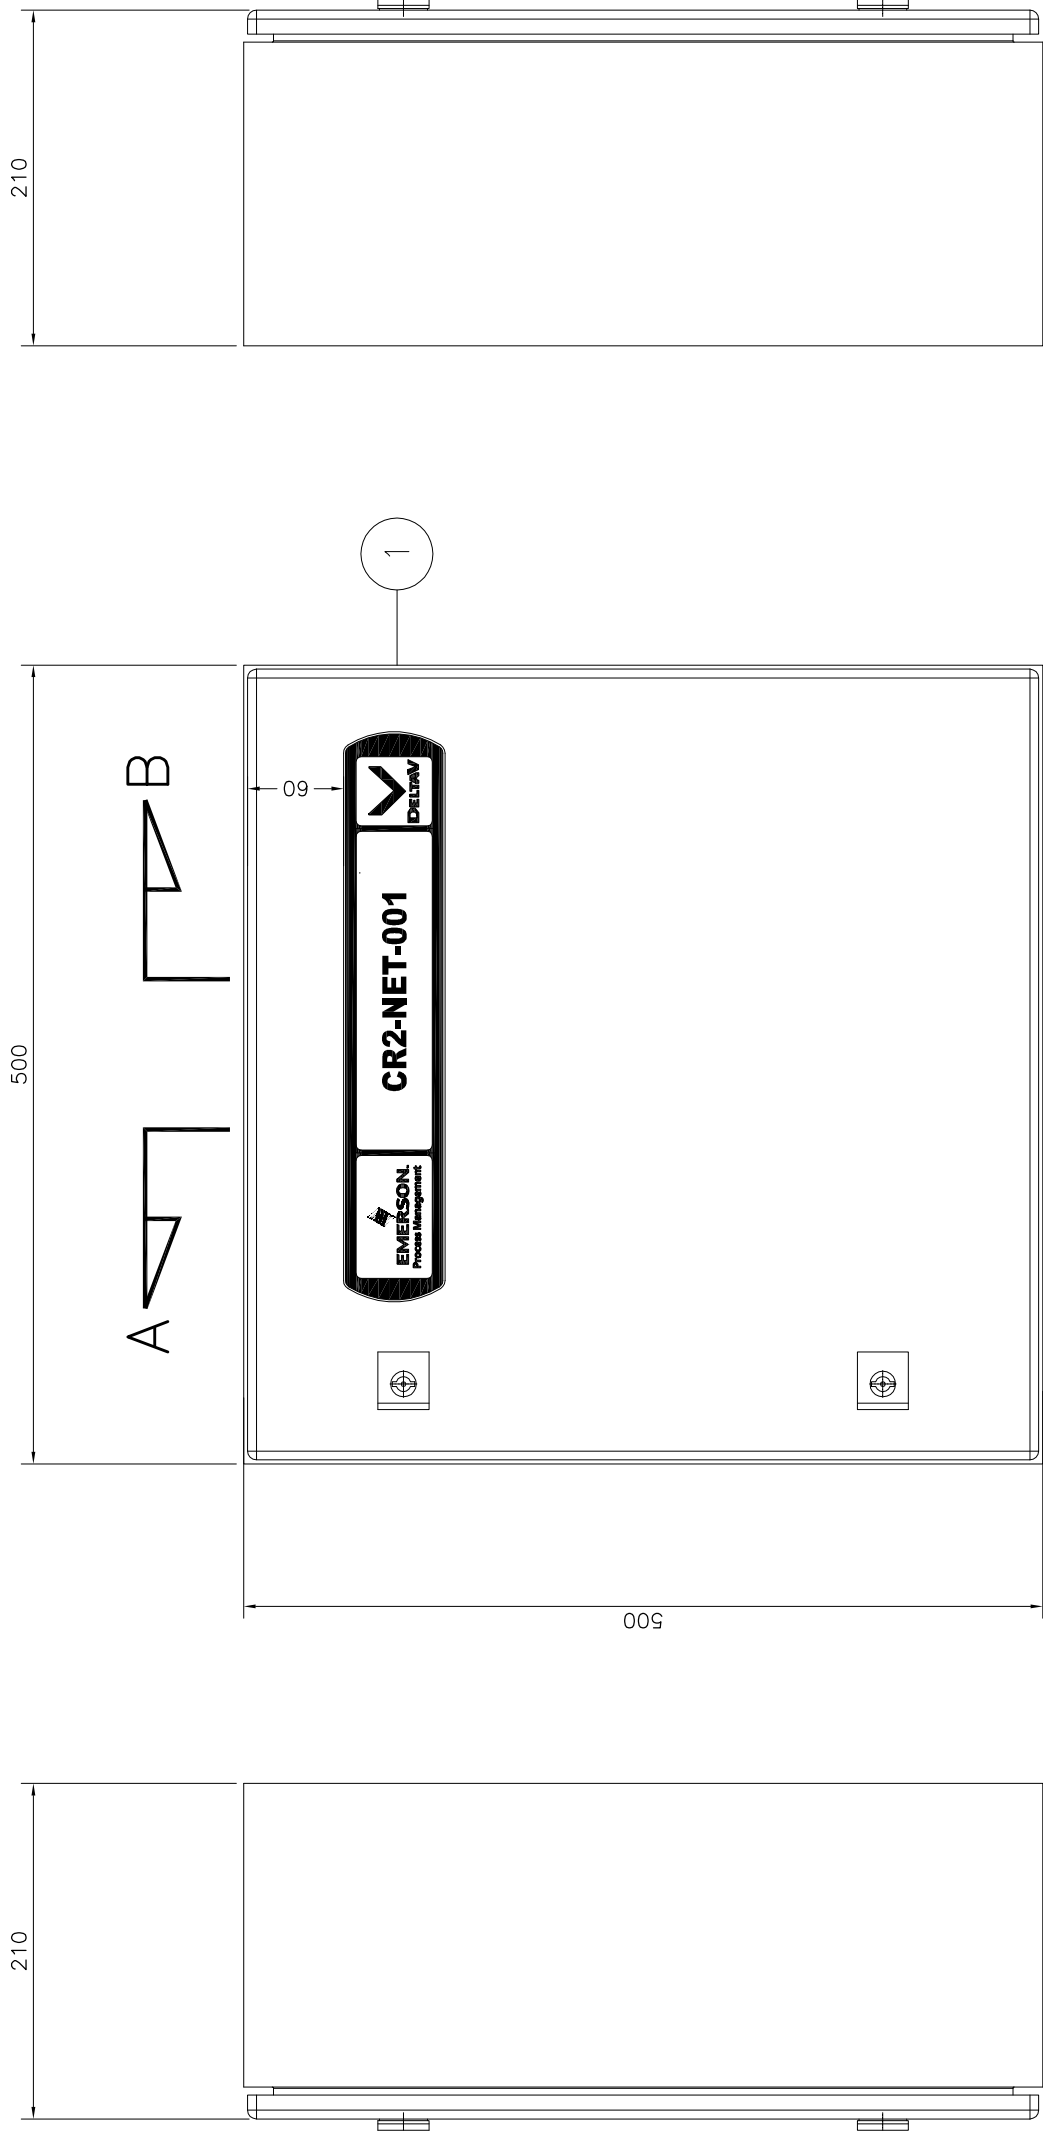

LEFT SIDE VIEW


NETWORK CABINET – CR2–NET–001

RIGHT SIDE VIEW

NETWORK CABINET – CR2–NET–001

NOTE: NETWORK CABINET FOR THIN CLIENT
IN CONTROL ROOMS

		EMERSON PROJECT NO.: 3258585 PROJECT TITLE: DCS SERANG PROJECT		TITLE: NETWORK CABINET CR2–NET–001 (FRONT DOOR VIEW, RIGHT SIDE & LEFT SIDE VIEW)		EMERSON DRAWING NO.: 3258585–PSS–PASH–DWG–00010	SHEET NO: 009
		SCALE: NTS UNITS: mm (inch)	SIZE: A3 © 2018			CUSTOMER DRAWING NO.: –	REV.: 0

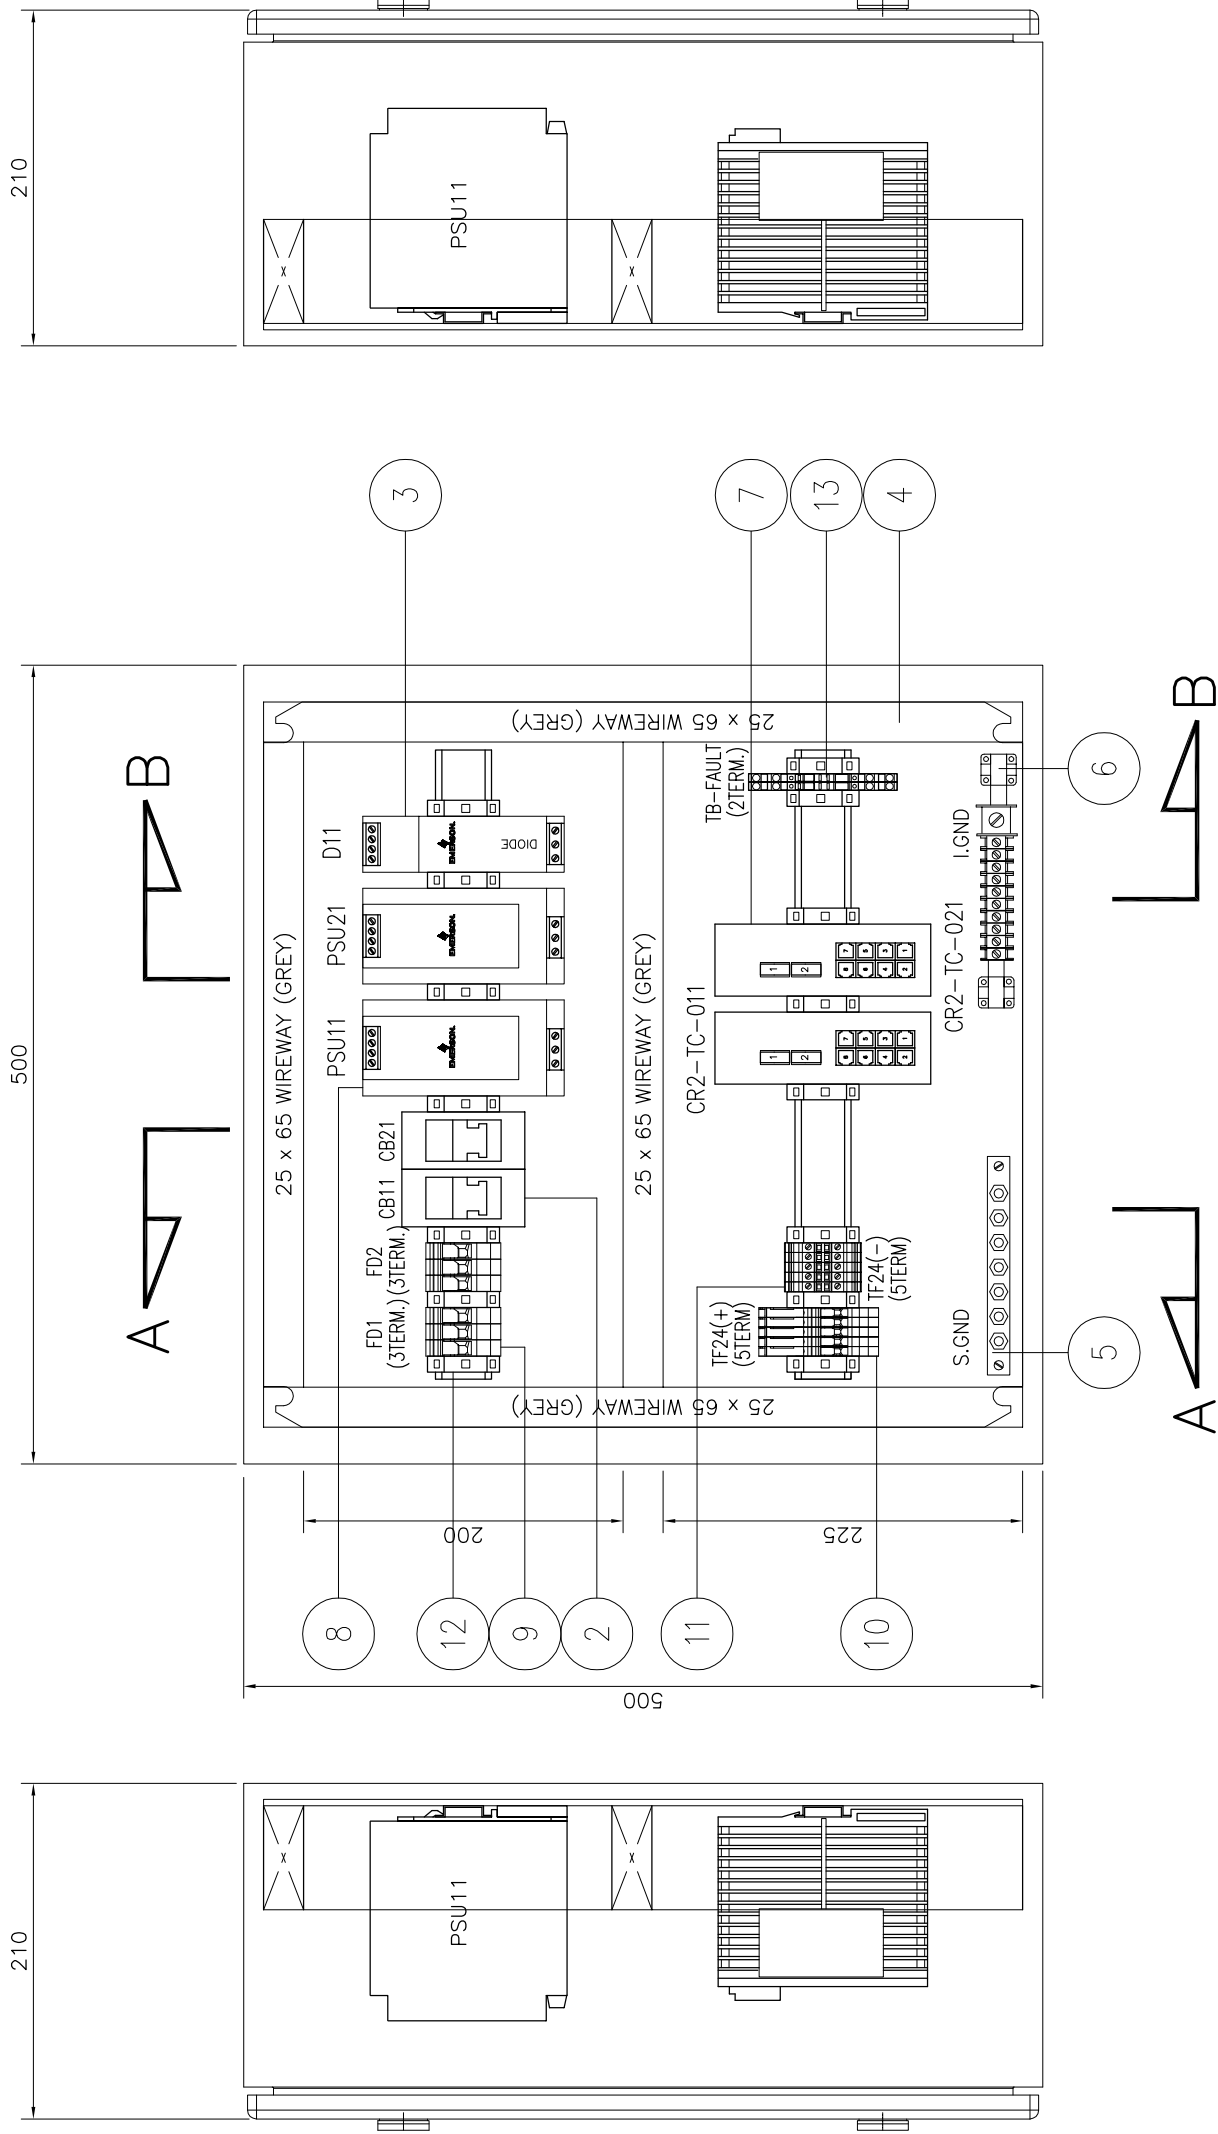

SECTION A-A

NETWORK CABINET – CR2–NET–001

FRONT VIEW

NETWORK CABINET – CR2–NET–001

SECTION B-B

NETWORK CABINET – CR2–NET–001

	PERMIT STAMP AND PROFESSIONAL STAMP AFFIXED ABOVE SHALL APPLY ONLY TO REV(s)		SCALE: NTS UNITS: mm (inch)	SIZE: A3 © 2018	EMERSON PROJECT NO.: 3258585 PROJECT TITLE: DCS SERANG PROJECT	TITLE: NETWORK CABINET CR2–NET–001 (FRONT VIEW, SECTION A-A & SECTION B-B)	EMERSON DRAWING NO.: 3258585–PSS–PASH–DWG–00010	SHEET NO: 011
							CUSTOMER DRAWING NO.: –	REV: 0

BILL OF MATERIALS

ITEM NO.	DESCRIPTION		PART NUMBER	QTY.	MANUFACTURER
01	RITTAL CABINET (W500 X H500 X D210) FRONT ACCESS		AE1050.500	1 SET	RITTAL
02	AC MCB 2POLE (6A)		IK60N C6A	2 PCS	SCHNEIDER
03	DELTAV BULK POWER SUPPLY REDUNDANCY MODULE, 12 V DC TO 28 V DC, 20 A		VE5134	1 PC	EMERSON PROCESS
04	25 X 65 mm PVC WIREWAY (GREY)		-	1 LOT	CONTRACTOR
05	SAFETY GROUND BAR		-	1 LOT	CONTRACTOR
06	INSTRUMENT GROUND BAR		-	1 LOT	CONTRACTOR
07	ETHERNET SWITCH 8-PORT		ISF3010D	2 PCS	INHAND
08	DELTAV BULK POWER SUPPLY 100-240 V AC TO 24 V DC, 10A		VE5123	2 PCS	EMERSON PROCESS
09	2-COND THROUGH TERMINAL BLOCK, 10MM SQ		2010-1201	6 PCS	WAGO
10	FUSE DISCONNECT TB WITH FUSE BLOW INDICATOR, 24VDC, 4MM SQ		2004-1611/1000-0541	5 PCS	WAGO
11	2-COND THROUGH TERMINAL BLOCK, 4MM SQ		2004-1201	5 PCS	WAGO
12	END STOPPER		249-117	1 LOT	WAGO
13	DOUBLE DECK DISCONNECT TERMINAL BLOCK, 2.5MM SQ		2002-2671	2 PCS	WAGO
14					
15					
PERMIT STAMP AND PROFESSIONAL STAMP
AFFIXED ABOVE SHALL APPLY ONLY TO REV(s)



EMERSON PROJECT NO.: 3258585
PROJECT TITLE: DCS SERANG PROJECT


SCALE: NTS
UNITS: mm (inch)

SIZE: A3
© 2018

TITLE: NETWORK CABINET CR2-NET-001
BILL OF MATERIAL

EMERSON DRAWING NO.: 3258585-PSS-PASH-DWG-00010
CUSTOMER DRAWING NO.: -

SHEET NO: 012
REV: 0

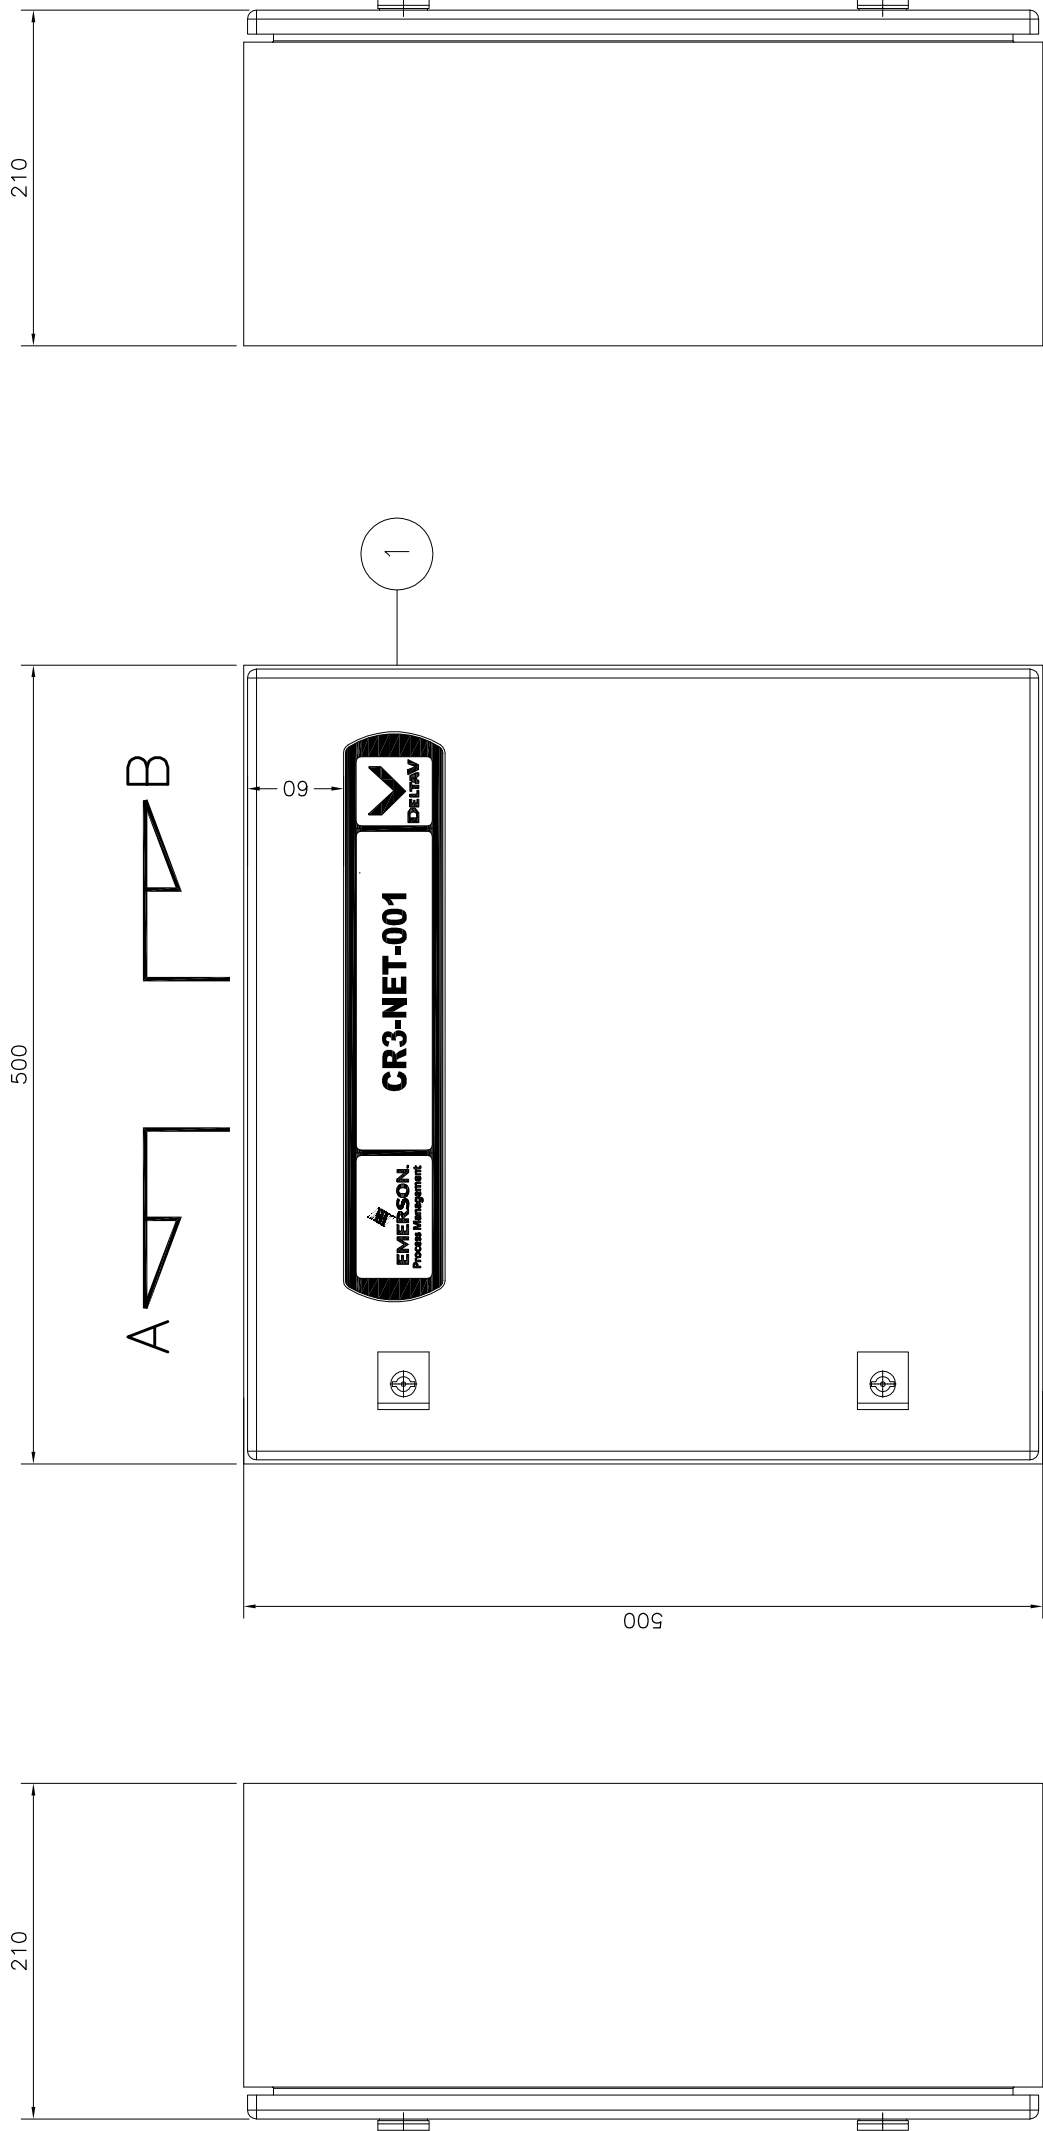


LEFT SIDE VIEW
NETWORK CABINET – CR3–NET–001

FRONT DOOR VIEW
NETWORK CABINET – CR3–NET–001

RIGHT SIDE VIEW
NETWORK CABINET – CR3–NET–001

NOTE: NETWORK CABINET FOR THIN CLIENT
IN CONTROL ROOMS

		SCALE: NTS UNITS: mm (inch)	SIZE: A3 © 2018	EMERSON PROJECT NO.: 3258585 PROJECT TITLE: DCS SERANG PROJECT	TITLE: NETWORK CABINET CR3–NET–001 (FRONT DOOR VIEW, RIGHT SIDE & LEFT SIDE VIEW)	EMERSON DRAWING NO.: 3258585–PSS–PASH–DWG–00010	SHEET NO: 015
						CUSTOMER DRAWING NO.: –	REV.: 0

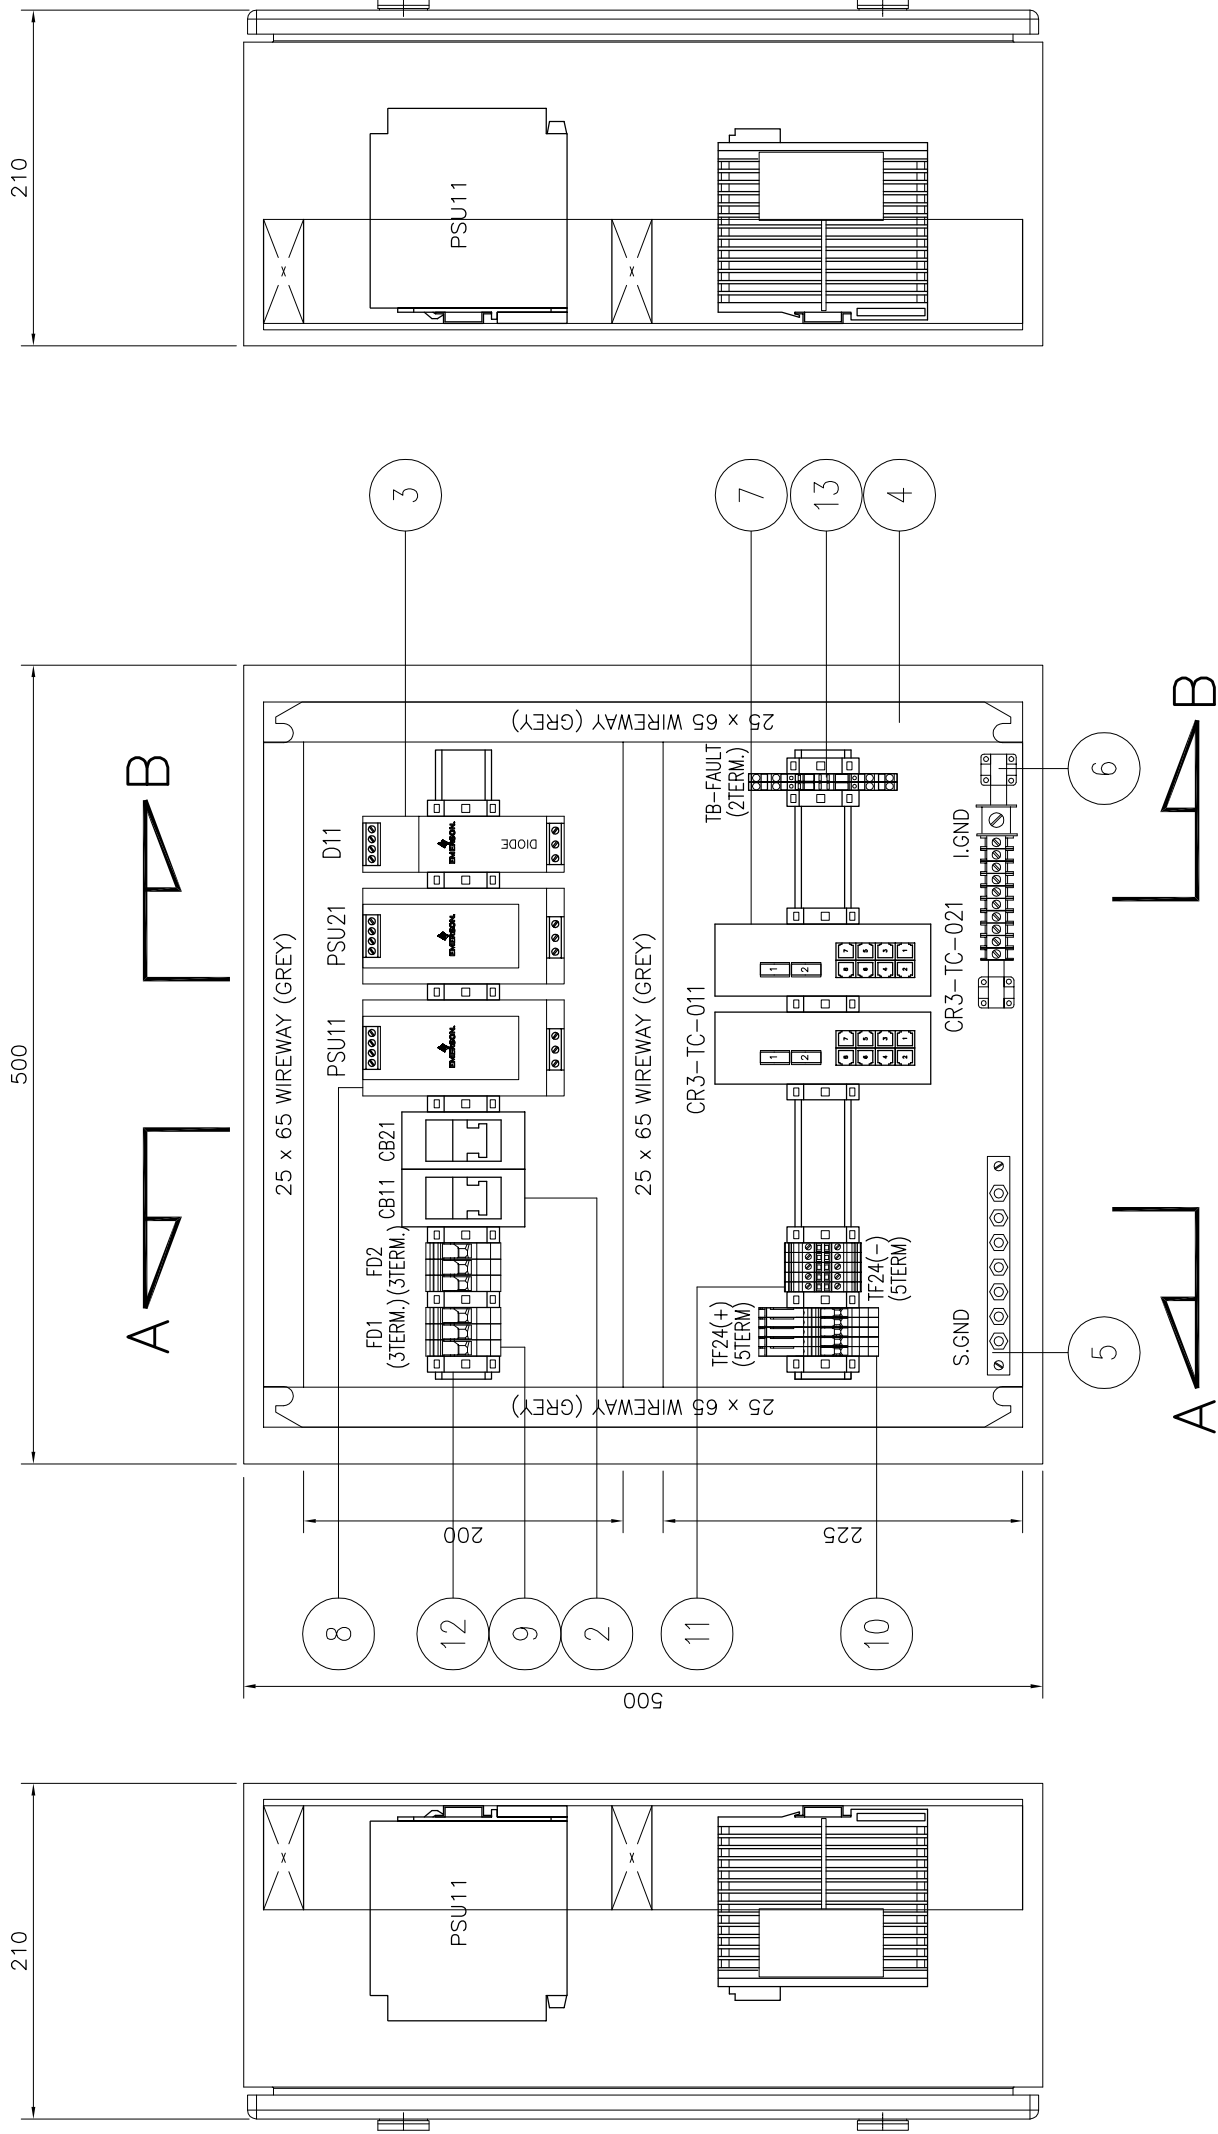

SECTION A-A

NETWORK CABINET – CR3-NET-001

FRONT VIEW

NETWORK CABINET – CR3-NET-001

SECTION B-B

NETWORK CABINET – CR3-NET-001



PERMIT STAMP AND PROFESSIONAL STAMP
AFFIXED ABOVE SHALL APPLY ONLY TO REV(s)



SCALE: NTS
UNITS: mm (inch)
SIZE: A3
© 2018

EMERSON PROJECT NO.: 3258585

PROJECT TITLE:
DCS SERANG PROJECT

TITLE:
NETWORK CABINET CR3-NET-001
(FRONT VIEW,
SECTION A-A & SECTION B-B)

EMERSON DRAWING NO.:
3258585-PSS-PASH-DWG-00010

CUSTOMER DRAWING NO.:
-

SHEET NO:

017

REV:

0

BILL OF MATERIALS

ITEM NO.	DESCRIPTION		PART NUMBER	QTY.	MANUFACTURER
01	RITTAL CABINET (W500 X H500 X D210) FRONT ACCESS		AE1050.500	1 SET	RITTAL
02	AC MCB 2POLE (6A)		IK60N C6A	2 PCS	SCHNEIDER
03	DELTA V BULK POWER SUPPLY REDUNDANCY MODULE, 12 V DC TO 28 V DC, 20 A		VE5134	1 PC	EMERSON PROCESS
04	25 X 65 mm PVC WIREWAY (GREY)		-	1 LOT	CONTRACTOR
05	SAFETY GROUND BAR		-	1 LOT	CONTRACTOR
06	INSTRUMENT GROUND BAR		-	1 LOT	CONTRACTOR
07	ETHERNET SWITCH 8-PORT		ISF3010D	2 PCS	INHAND
08	DELTA V BULK POWER SUPPLY 100-240 V AC TO 24 V DC, 10A		VE5123	2 PCS	EMERSON PROCESS
09	2-COND THROUGH TERMINAL BLOCK, 10MM SQ		2010-1201	6 PCS	WAGO
10	FUSE DISCONNECT TB WITH FUSE BLOW INDICATOR, 24VDC, 4MM SQ		2004-1611/1000-0541	5 PCS	WAGO
11	2-COND THROUGH TERMINAL BLOCK, 4MM SQ		2004-1201	5 PCS	WAGO
12	END STOPPER		249-117	1 LOT	WAGO
13	DOUBLE DECK DISCONNECT TERMINAL BLOCK, 2.5MM SQ		2002-2671	2 PCS	WAGO
14					
15					
PERMIT STAMP AND PROFESSIONAL STAMP
AFFIXED ABOVE SHALL APPLY ONLY TO REV(s)



EMERSON PROJECT NO.: 3258585
PROJECT TITLE: DCS SERANG PROJECT


SCALE: NTS
UNITS: mm (inch)

SIZE: A3
© 2018

TITLE: NETWORK CABINET CR3-NET-001
BILL OF MATERIAL

EMERSON DRAWING NO.: 3258585-PSS-PASH-DWG-00010
CUSTOMER DRAWING NO.: -

SHEET NO: 018
REV: 0

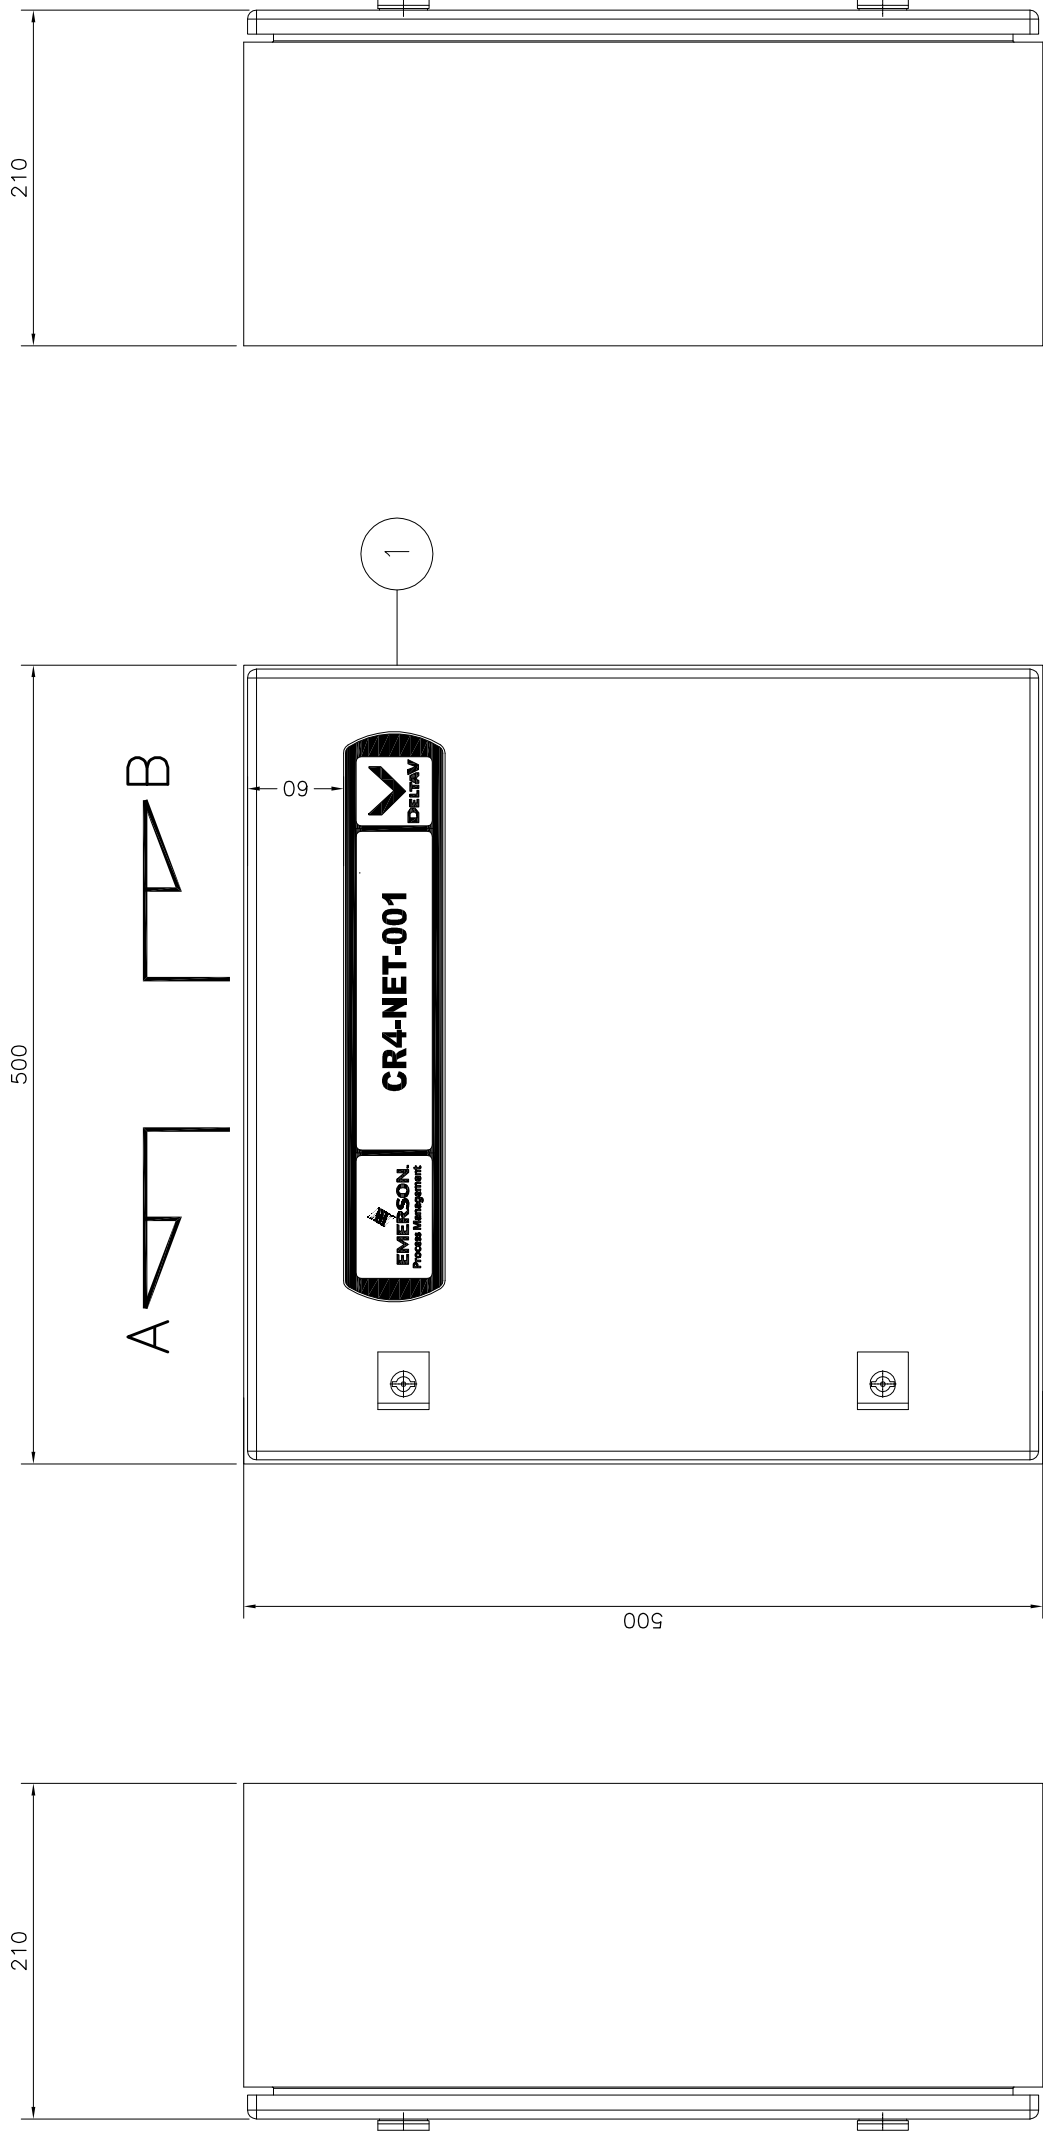


LEFT SIDE VIEW
NETWORK CABINET – CR4–NET–001

FRONT DOOR VIEW
NETWORK CABINET – CR4–NET–001

RIGHT SIDE VIEW
NETWORK CABINET – CR4–NET–001

NOTE: NETWORK CABINET FOR THIN CLIENT
IN CONTROL ROOMS

	PERMIT STAMP AND PROFESSIONAL STAMP AFFIXED ABOVE SHALL APPLY ONLY TO REV(s)		SCALE: NTS UNITS: mm (inch)	SIZE: A3 © 2018	EMERSON PROJECT NO.: 3258585 PROJECT TITLE: DCS SERANG PROJECT	TITLE: NETWORK CABINET CR4–NET–001 (FRONT DOOR VIEW, RIGHT SIDE & LEFT SIDE VIEW)	EMERSON DRAWING NO.: 3258585–PSS–PASH–DWG–00010	SHEET NO: 021
							CUSTOMER DRAWING NO.: –	REV: 0

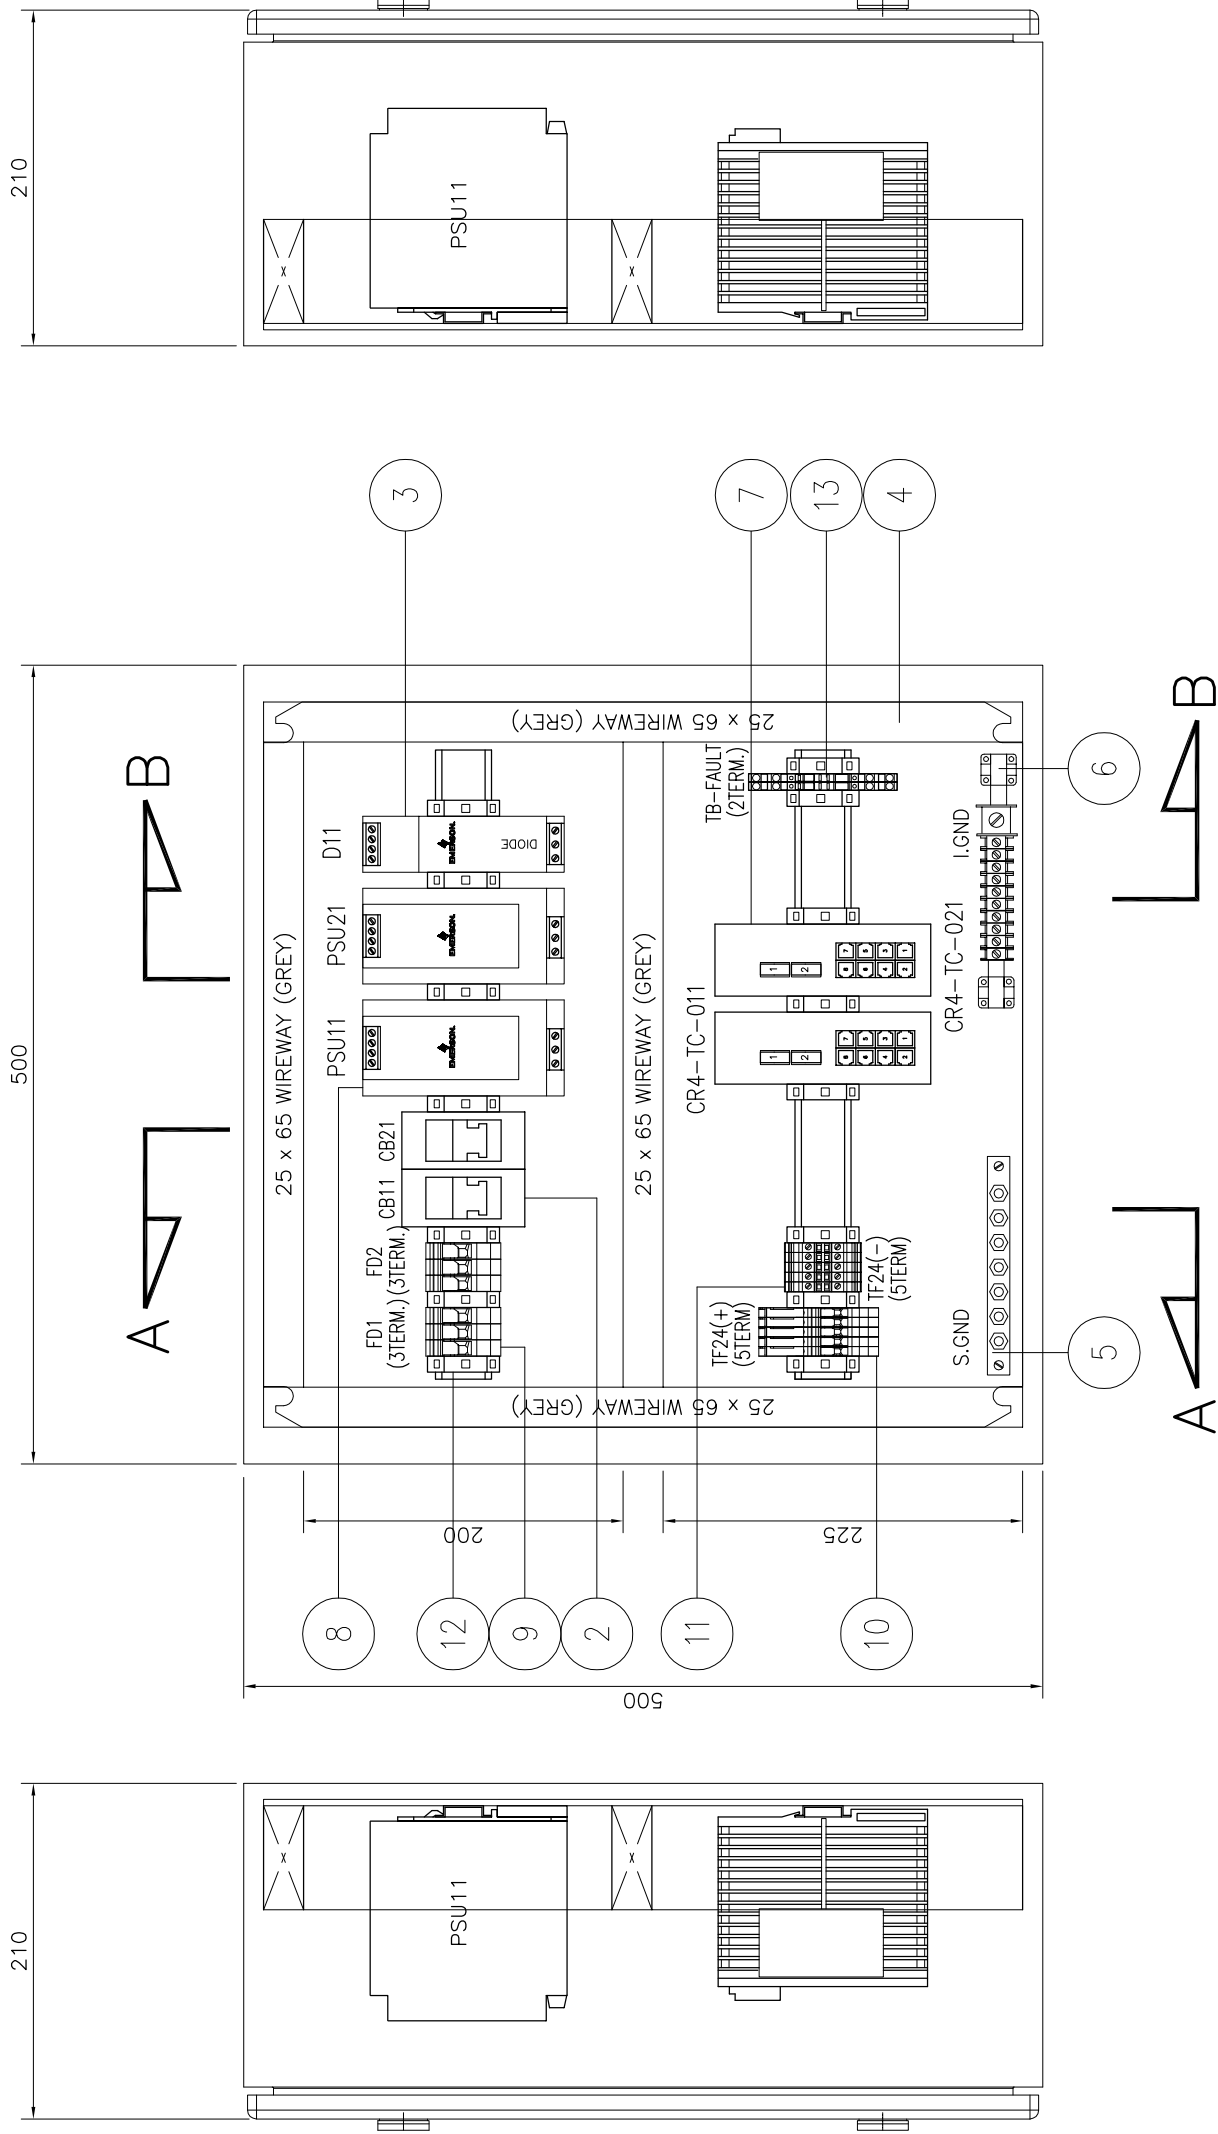

SECTION A-A

NETWORK CABINET – CR4–NET–001

FRONT VIEW

NETWORK CABINET – CR4–NET–001

SECTION B-B

NETWORK CABINET – CR4–NET–001

		SCALE: NTS UNITS: mm (inch)	SIZE: A3 © 2018	EMERSON PROJECT NO.: 3258585 PROJECT TITLE: DCS SERANG PROJECT	TITLE: NETWORK CABINET CR4–NET–001 (FRONT VIEW, SECTION A-A & SECTION B-B)	EMERSON DRAWING NO.: 3258585–PSS–PASH–DWG–00010	SHEET NO: 023
						CUSTOMER DRAWING NO.: –	REV: 0

BILL OF MATERIALS

ITEM NO.	DESCRIPTION		PART NUMBER	QTY.	MANUFACTURER
01	RITTAL CABINET (W500 X H500 X D210) FRONT ACCESS		AE1050.500	1 SET	RITTAL
02	AC MCB 2POLE (6A)		IK60N C6A	2 PCS	SCHNEIDER
03	DELTA V BULK POWER SUPPLY REDUNDANCY MODULE, 12 V DC TO 28 V DC, 20 A		VE5134	1 PC	EMERSON PROCESS
04	25 X 65 mm PVC WIREWAY (GREY)		-	1 LOT	CONTRACTOR
05	SAFETY GROUND BAR		-	1 LOT	CONTRACTOR
06	INSTRUMENT GROUND BAR		-	1 LOT	CONTRACTOR
07	ETHERNET SWITCH 8-PORT		ISF3010D	2 PCS	INHAND
08	DELTA V BULK POWER SUPPLY 100-240 V AC TO 24 V DC, 10A		VE5123	2 PCS	EMERSON PROCESS
09	2-COND THROUGH TERMINAL BLOCK, 10MM SQ		2010-1201	6 PCS	WAGO
10	FUSE DISCONNECT TB WITH FUSE BLOW INDICATOR, 24VDC, 4MM SQ		2004-1611/1000-0541	5 PCS	WAGO
11	2-COND THROUGH TERMINAL BLOCK, 4MM SQ		2004-1201	5 PCS	WAGO
12	END STOPPER		249-117	1 LOT	WAGO
13	DOUBLE DECK DISCONNECT TERMINAL BLOCK, 2.5MM SQ		2002-2671	2 PCS	WAGO
14					
15					
PERMIT STAMP AND PROFESSIONAL STAMP
AFFIXED ABOVE SHALL APPLY ONLY TO REV(s)



EMERSON PROJECT NO.: 3258585
PROJECT TITLE: DCS SERANG PROJECT

SCALE: NTS
UNITS: mm (inch)




SIZE: A3
2018

TITLE: NETWORK CABINET CR4-NET-001
BILL OF MATERIAL

EMERSON DRAWING NO.: 3258585-PSS-PASH-DWG-00010
CUSTOMER DRAWING NO.: -

SHEET NO: 024

REV: 0

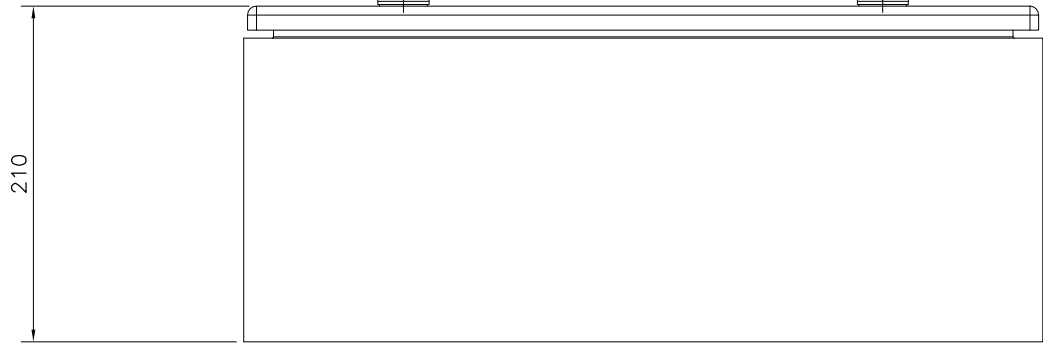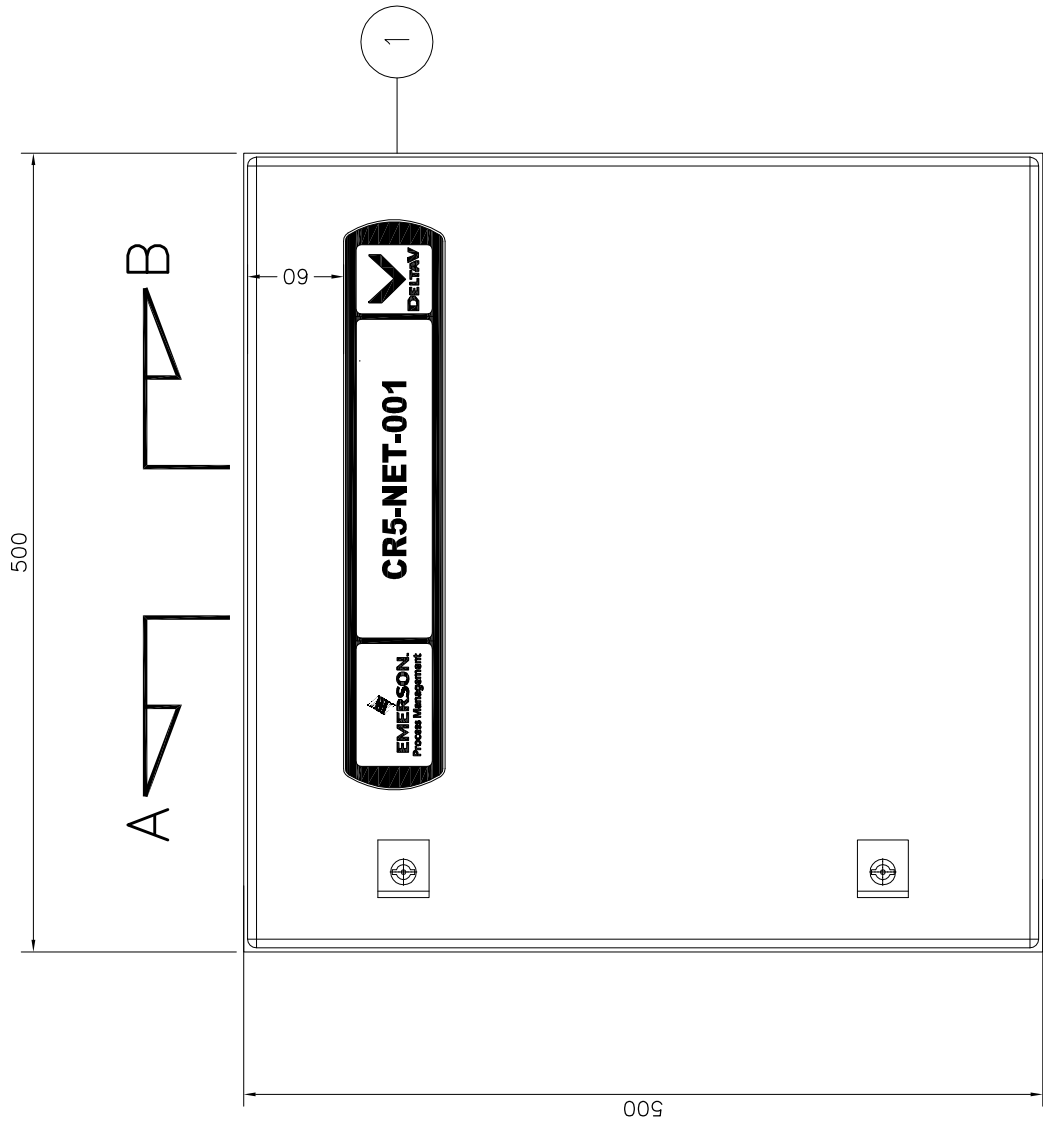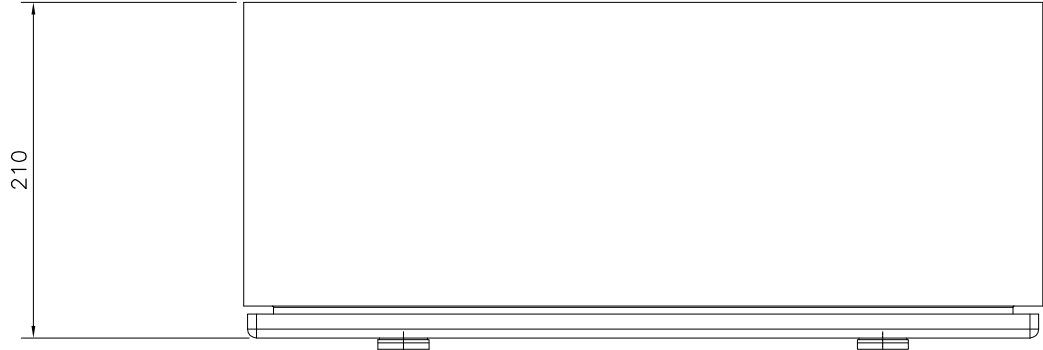

LEFT SIDE VIEW

NETWORK CABINET – CR5–NET–001

FRONT DOOR VIEW


NETWORK CABINET – CR5–NET–001

RIGHT SIDE VIEW

NETWORK CABINET – CR5–NET–001

NOTE: NETWORK CABINET FOR THIN CLIENT
IN CONTROL ROOMS

		EMERSON PROJECT NO.: 3258585 PROJECT TITLE: DCS SERANG PROJECT		TITLE: NETWORK CABINET CR5–NET–001 (FRONT DOOR VIEW, RIGHT SIDE & LEFT SIDE VIEW)		EMERSON DRAWING NO.: 3258585–PSS–PASH–DWG–00010	SHEET NO: 027
		SCALE: NTS UNITS: mm (inch)	SIZE: A3 © 2018			CUSTOMER DRAWING NO.: –	REV.: 0

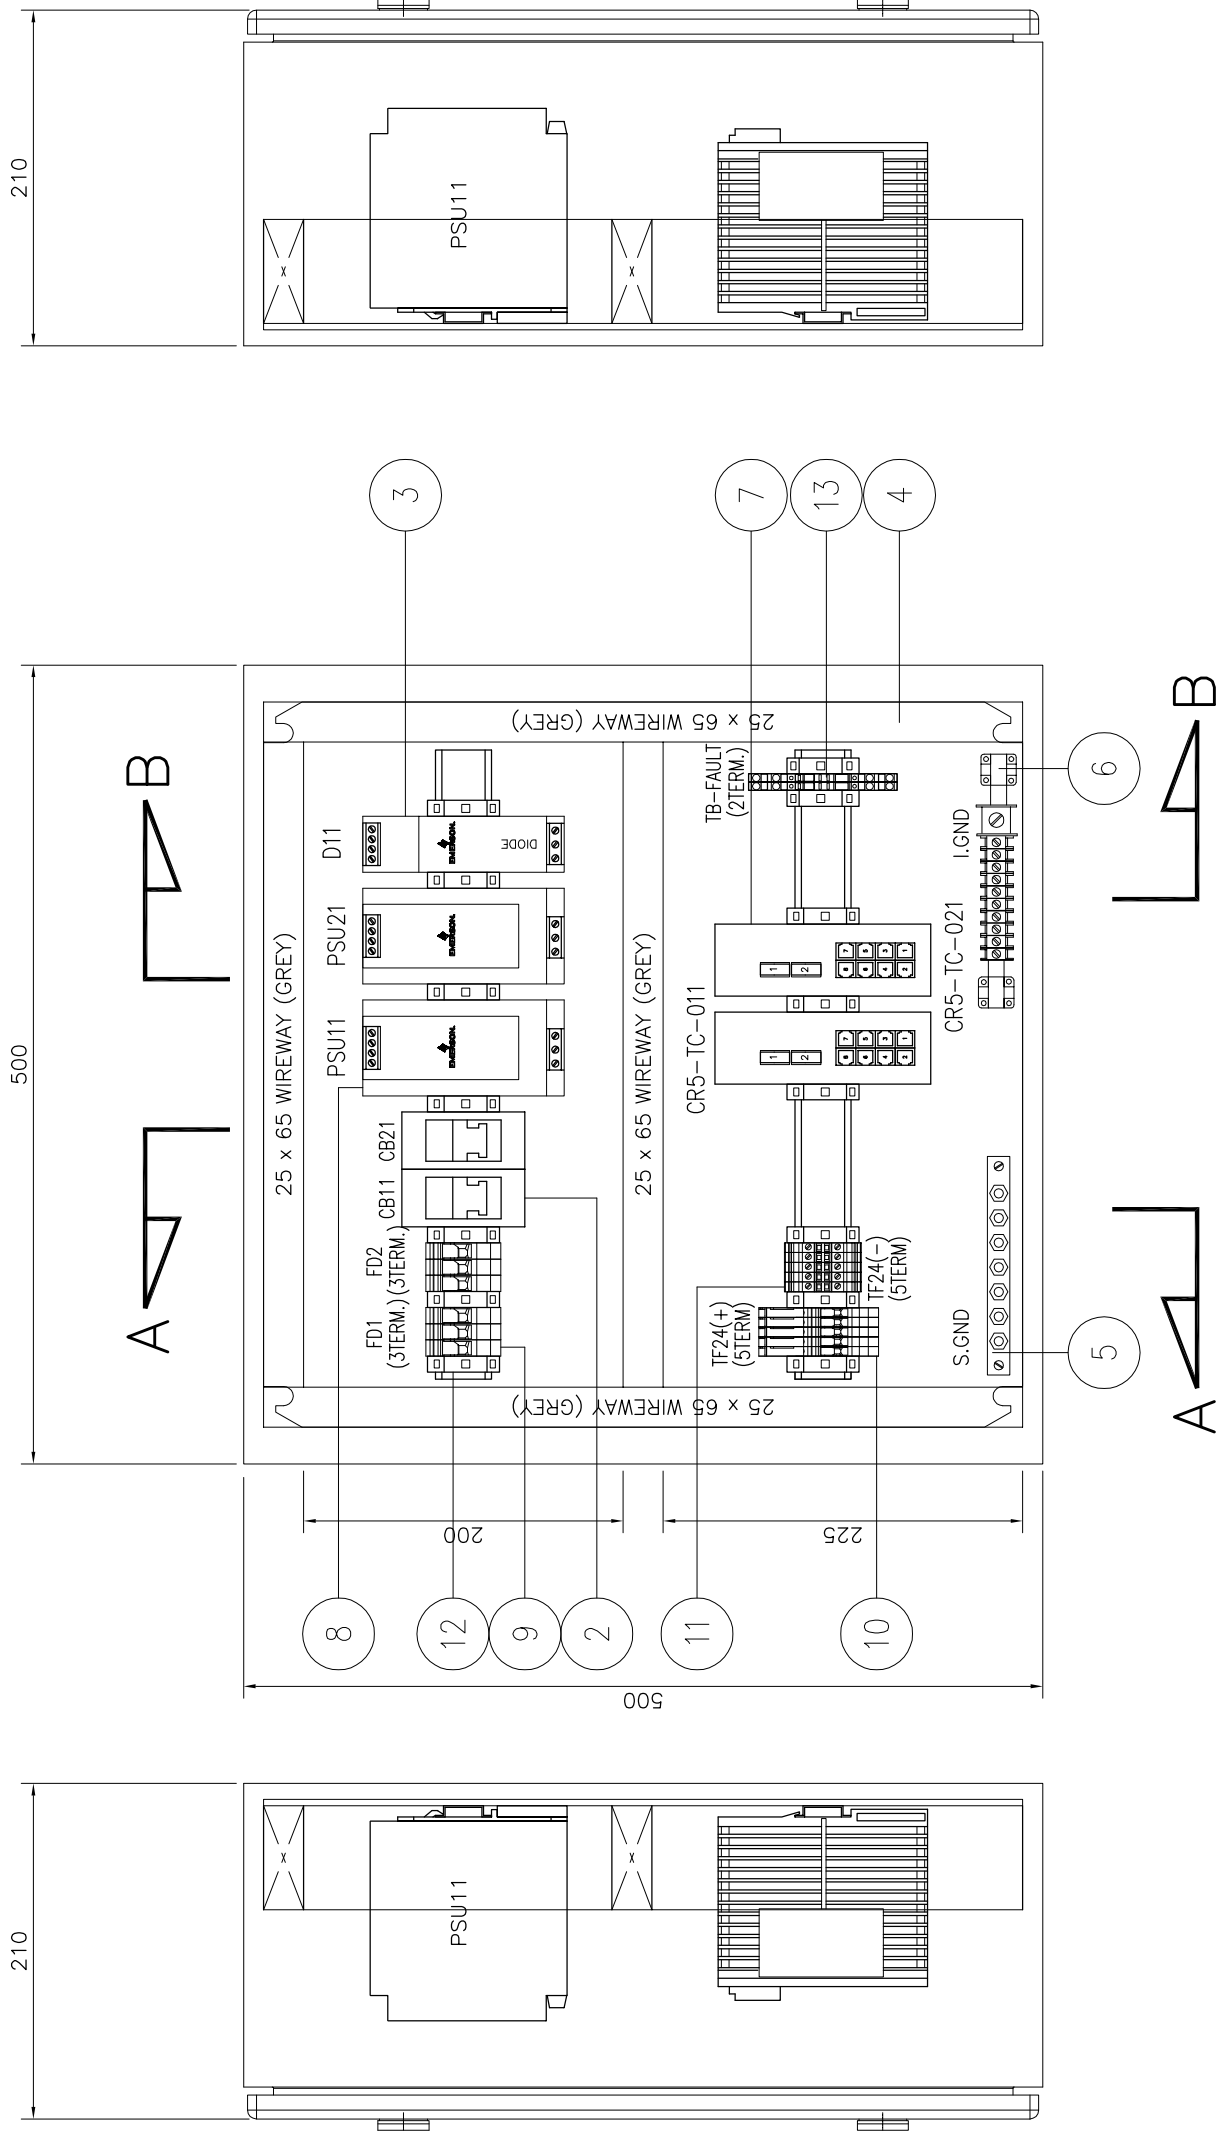

SECTION A-A

NETWORK CABINET – CR5–NET–001

FRONT VIEW

NETWORK CABINET – CR5–NET–001

SECTION B-B

NETWORK CABINET – CR5–NET–001



PERMIT STAMP AND PROFESSIONAL STAMP
AFFIXED ABOVE SHALL APPLY ONLY TO REV(s)



SCALE: NTS SIZE: A3
UNITS: mm (inch) 2018

EMERSON PROJECT NO.: 3258585
PROJECT TITLE: DCS SERANG PROJECT

TITLE: NETWORK CABINET CR5–NET–001
(FRONT VIEW,
SECTION A-A & SECTION B-B)

EMERSON DRAWING NO.: 3258585–PSS–PASH–DWG–00010

CUSTOMER DRAWING NO.: –

SHEET NO:

029

REV:

0

BILL OF MATERIALS

ITEM NO.	DESCRIPTION		PART NUMBER	QTY.	MANUFACTURER
01	RITTAL CABINET (W500 X H500 X D210) FRONT ACCESS		AE1050.500	1 SET	RITTAL
02	AC MCB 2POLE (6A)		IK60N C6A	2 PCS	SCHNEIDER
03	DELTA V BULK POWER SUPPLY REDUNDANCY MODULE, 12 V DC TO 28 V DC, 20 A		VE5134	1 PC	EMERSON PROCESS
04	25 X 65 mm PVC WIREWAY (GREY)		-	1 LOT	CONTRACTOR
05	SAFETY GROUND BAR		-	1 LOT	CONTRACTOR
06	INSTRUMENT GROUND BAR		-	1 LOT	CONTRACTOR
07	ETHERNET SWITCH 8-PORT		ISF3010D	2 PCS	INHAND
08	DELTA V BULK POWER SUPPLY 100-240 V AC TO 24 V DC, 10A		VE5123	2 PCS	EMERSON PROCESS
09	2-COND THROUGH TERMINAL BLOCK, 10MM SQ		2010-1201	6 PCS	WAGO
10	FUSE DISCONNECT TB WITH FUSE BLOW INDICATOR, 24VDC, 4MM SQ		2004-1611/1000-0541	5 PCS	WAGO
11	2-COND THROUGH TERMINAL BLOCK, 4MM SQ		2004-1201	5 PCS	WAGO
12	END STOPPER		249-117	1 LOT	WAGO
13	DOUBLE DECK DISCONNECT TERMINAL BLOCK, 2.5MM SQ		2002-2671	2 PCS	WAGO
14					
15					
PERMIT STAMP AND PROFESSIONAL STAMP
AFFIXED ABOVE SHALL APPLY ONLY TO REV(s)




EMERSON PROJECT NO.: 3258585
PROJECT TITLE:
DCS SERANG PROJECT

TITLE:
NETWORK CABINET CR5-NET-001
BILL OF MATERIAL

EMERSON DRAWING NO.: 3258585-PSS-PASH-DWG-00010
CUSTOMER DRAWING NO.: -

SHEET NO: 030
REV: 0

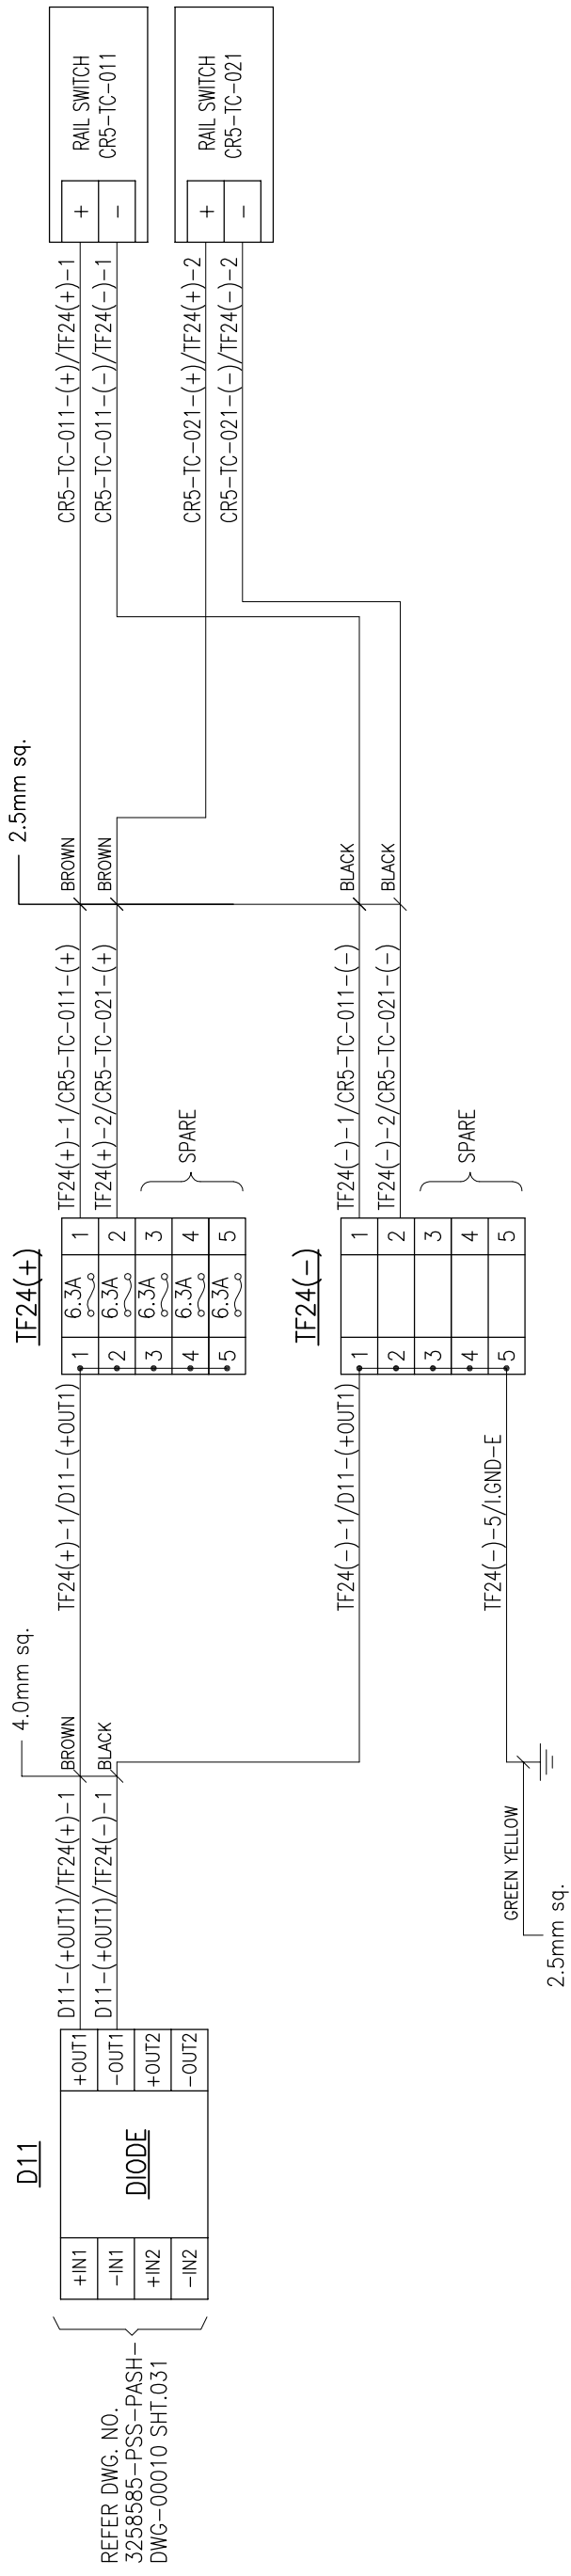


LEGEND:

TERMINAL & POINT NO.	FROM	TO
TERMINAL & POINT NO.	FD1-L/ISL1-1	

TERMINAL & POINT NO.

	PERMIT STAMP AND PROFESSIONAL STAMP AFFIXED ABOVE SHALL APPLY ONLY TO REV(S)				SCALE:	NTS	SIZE:	A3	EMERSON PROJECT NO.: 3258585 PROJECT TITLE: DCS SERANG PROJECT	TITLE: NETWORK CABINET CR5-NET-001 24VDC POWER DISTRIBUTION DIAGRAM	EMERSON DRAWING NO.: 3258585-PSS-PASH-DWG-00010	SHEET NO.: 032
					UNITS:	mm (inch)	©	2018				

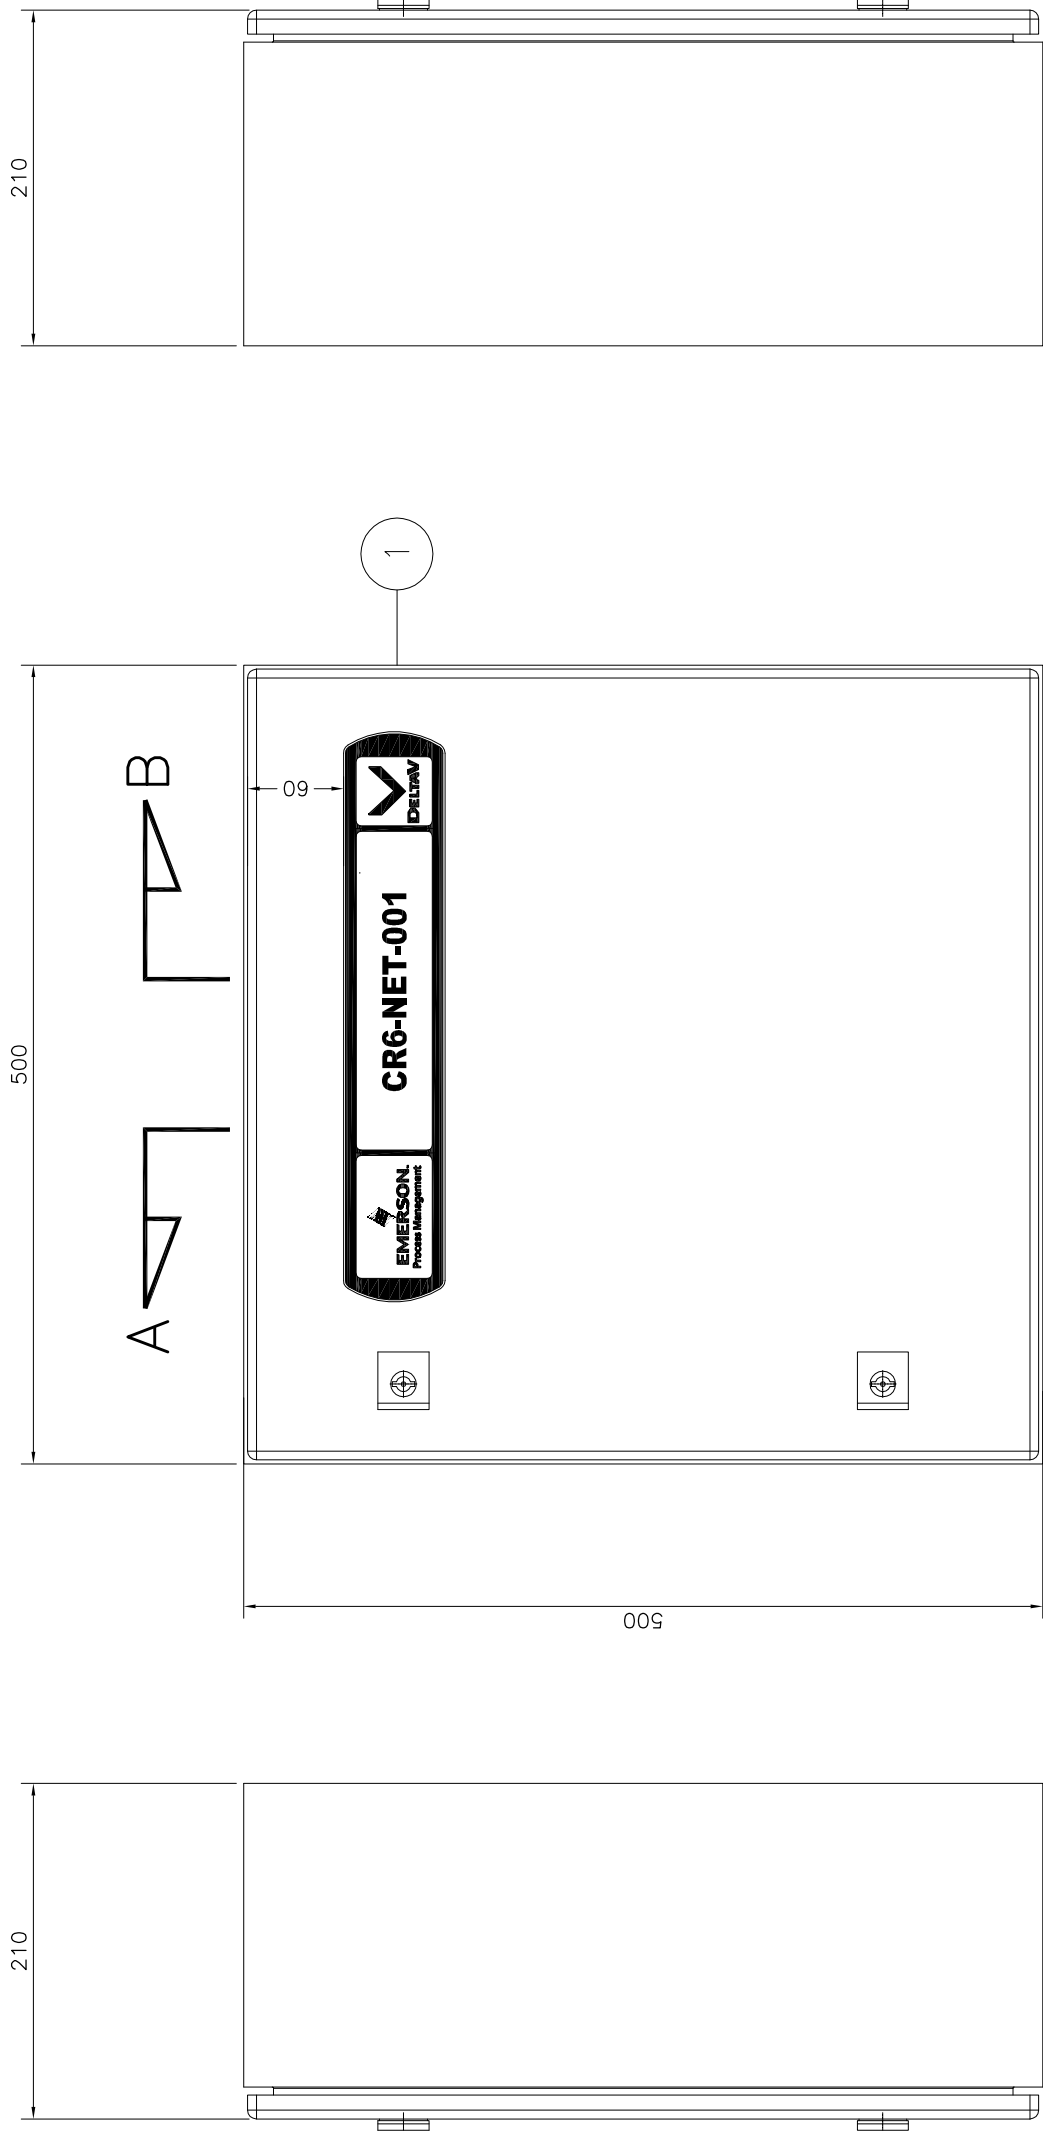

LEFT SIDE VIEW


NETWORK CABINET – CR6–NET–001

RIGHT SIDE VIEW

NETWORK CABINET – CR6–NET–001

NOTE: NETWORK CABINET FOR THIN CLIENT
IN CONTROL ROOMS

	PERMIT STAMP AND PROFESSIONAL STAMP AFFIXED ABOVE SHALL APPLY ONLY TO REV(s)		SCALE: NTS UNITS: mm (inch)	SIZE: A3 © 2018	EMERSON PROJECT NO.: 3258585 PROJECT TITLE: DCS SERANG PROJECT	TITLE: NETWORK CABINET CR6–NET–001 (FRONT DOOR VIEW, RIGHT SIDE & LEFT SIDE VIEW)	EMERSON DRAWING NO.: 3258585–PSS–PASH–DWG–00010	SHEET NO: 033
							CUSTOMER DRAWING NO.: –	REV.: 0

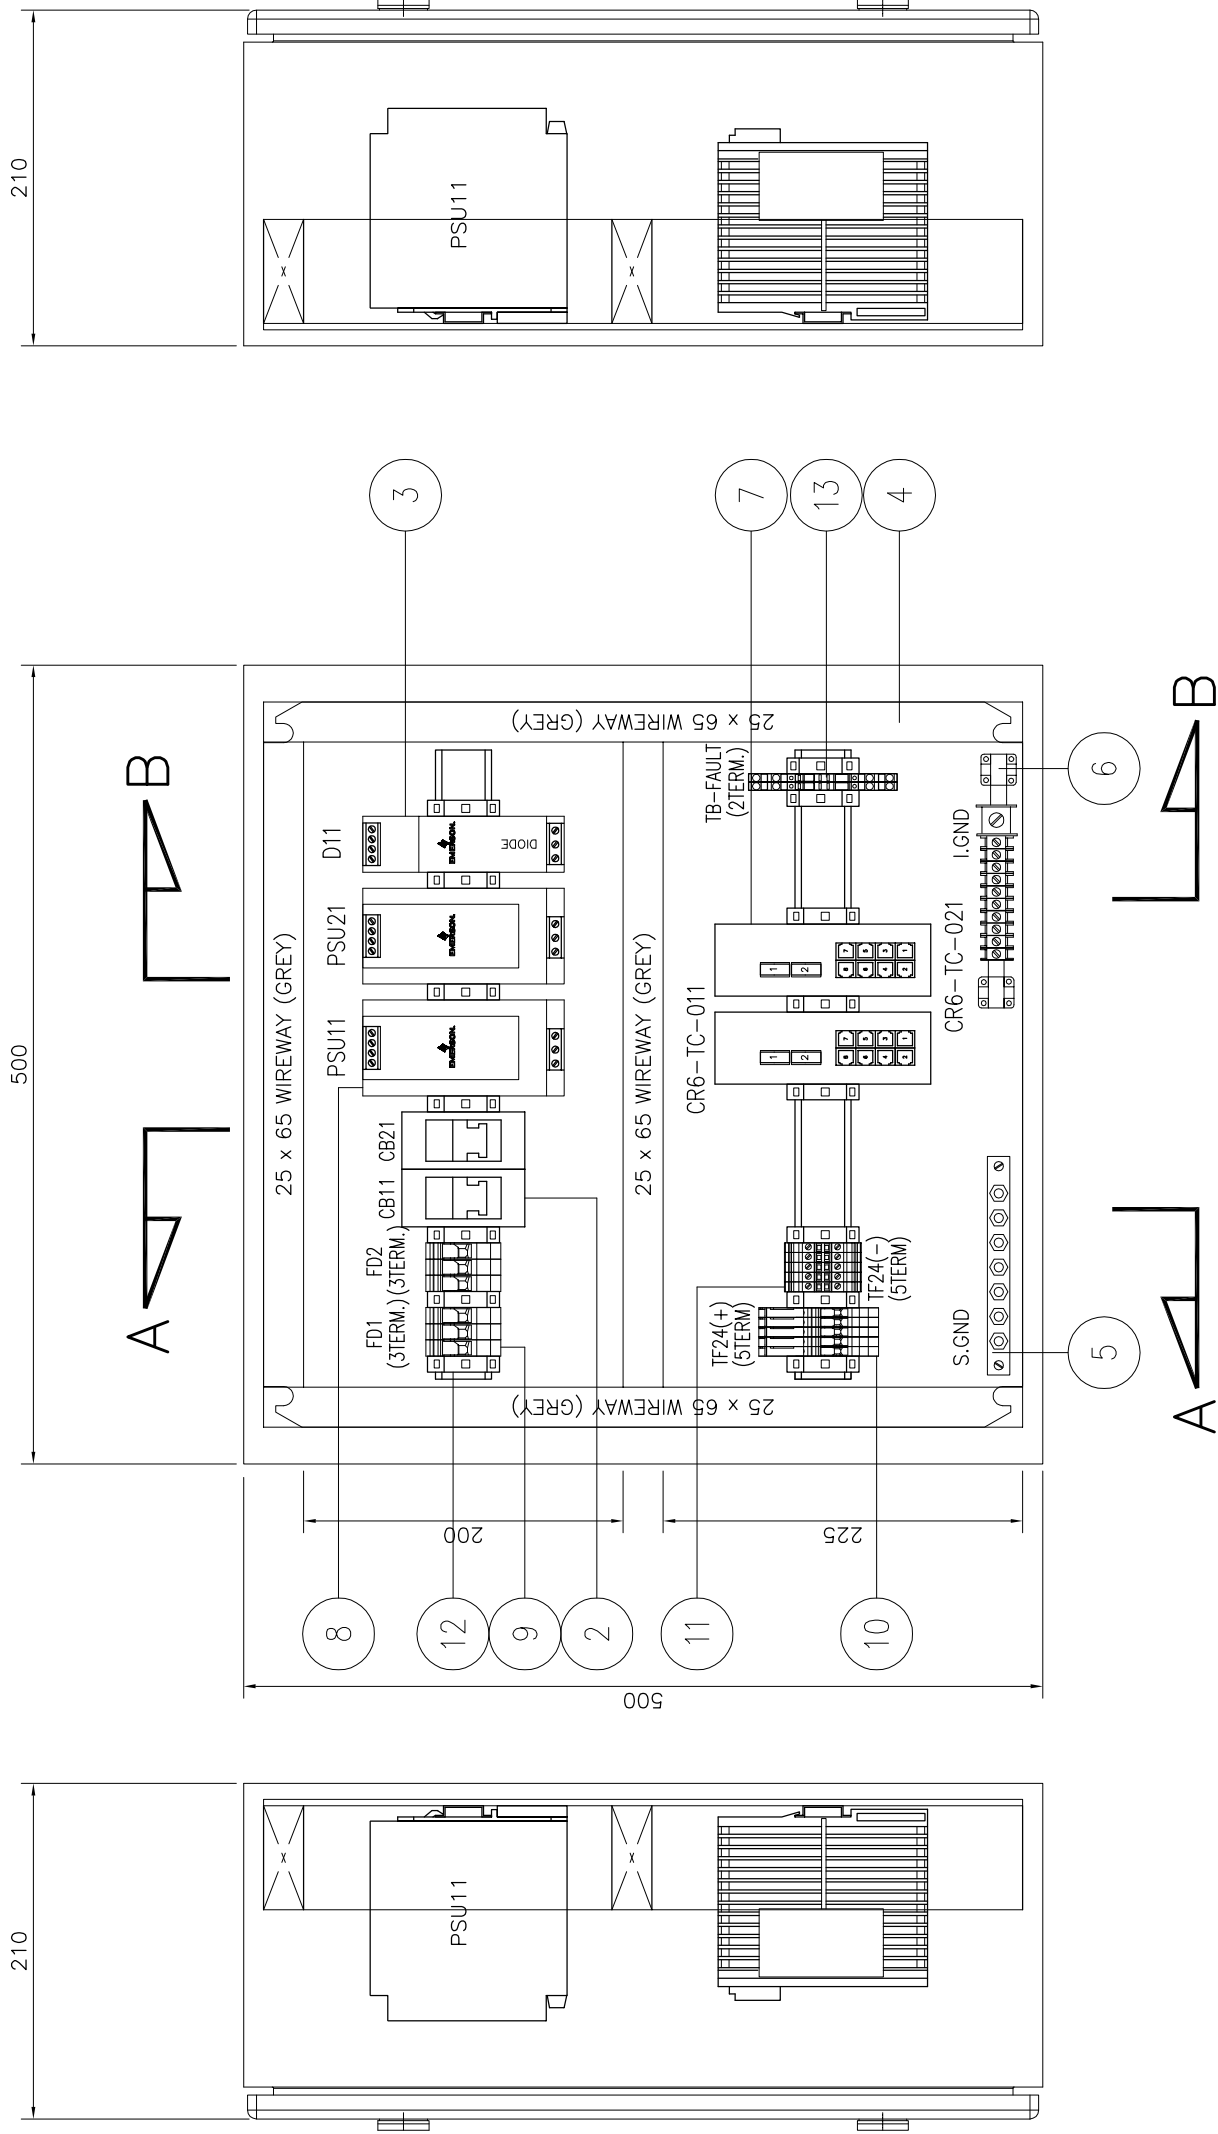

SECTION A-A

NETWORK CABINET – CR6–NET–001

FRONT VIEW

NETWORK CABINET – CR6–NET–001

SECTION B-B

NETWORK CABINET – CR6–NET–001



PERMIT STAMP AND PROFESSIONAL STAMP
AFFIXED ABOVE SHALL APPLY ONLY TO REV(s)



SCALE: NTS
UNITS: mm (inch)
SIZE: A3
© 2018

EMERSON PROJECT NO.: 3258585

PROJECT TITLE: DCS SERANG PROJECT

TITLE:
NETWORK CABINET CR6–NET–001
(FRONT VIEW,
SECTION A-A & SECTION B-B)

EMERSON DRAWING NO.: 3258585–PSS–PASH–DWG–00010

CUSTOMER DRAWING NO.: –

SHEET NO:

035

REV:

0

BILL OF MATERIALS

ITEM NO.	DESCRIPTION		PART NUMBER	QTY.	MANUFACTURER
01	RITTAL CABINET (W500 X H500 X D210) FRONT ACCESS		AE1050.500	1 SET	RITTAL
02	AC MCB 2POLE (6A)		IK60N C6A	2 PCS	SCHNEIDER
03	DELTAV BULK POWER SUPPLY REDUNDANCY MODULE, 12 V DC TO 28 V DC, 20 A		VE5134	1 PC	EMERSON PROCESS
04	25 X 65 mm PVC WIREWAY (GREY)		-	1 LOT	CONTRACTOR
05	SAFETY GROUND BAR		-	1 LOT	CONTRACTOR
06	INSTRUMENT GROUND BAR		-	1 LOT	CONTRACTOR
07	ETHERNET SWITCH 8-PORT		ISF3010D	2 PCS	INHAND
08	DELTAV BULK POWER SUPPLY 100-240 V AC TO 24 V DC, 10A		VE5123	2 PCS	EMERSON PROCESS
09	2-COND THROUGH TERMINAL BLOCK, 10MM SQ		2010-1201	6 PCS	WAGO
10	FUSE DISCONNECT TB WITH FUSE BLOW INDICATOR, 24VDC, 4MM SQ		2004-1611/1000-0541	5 PCS	WAGO
11	2-COND THROUGH TERMINAL BLOCK, 4MM SQ		2004-1201	5 PCS	WAGO
12	END STOPPER		249-117	1 LOT	WAGO
13	DOUBLE DECK DISCONNECT TERMINAL BLOCK, 2.5MM SQ		2002-2671	2 PCS	WAGO
14					
15					
PERMIT STAMP AND PROFESSIONAL STAMP
AFFIXED ABOVE SHALL APPLY ONLY TO REV(s)



EMERSON PROJECT NO.: 3258585
PROJECT TITLE: DCS SERANG PROJECT

SCALE: NTS
UNITS: mm (inch)

SIZE: A3
© 2018

TITLE: NETWORK CABINET CR6-NET-001
BILL OF MATERIAL

EMERSON DRAWING NO.: 3258585-PSS-PASH-DWG-00010
CUSTOMER DRAWING NO.: -

SHEET NO: 036

REV: 0

