


DOCUMENT STATUS	
FOR INFORMATION	☐
COMMENTED	☐
APPROVED WITH COMMENTS	☐
APPROVED FOR DESIGN/CONSTRUCTION	☐
REJECTED	☐

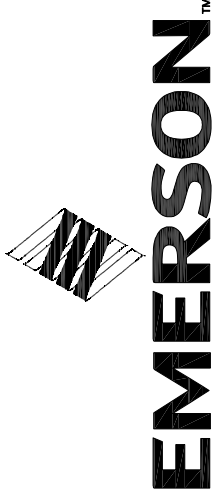

GENERAL AND INTERNAL ARRANGEMENT DRAWING -

REFINERY 1


DCS SERANG PROJECT

							CUSTOMER : WILMAR INDUSTRIAL COMPLEX PT MNA SERANG, INDONESIA
							CONTRACT NO. : -
0	AS BUILT	29/08/19	AS/NAM	LKL	MNI		PROJECT TITLE : DCS SERANG PROJECT
B	ISSUE FOR COMMENT	04/10/18	AS	LKL	MNI		CUSTOMER PROJECT NO. : -
A	ISSUE FOR COMMENT	14/09/18	AS	LKL	MNI		
REV.	DESCRIPTION	DATE	DRAWN BY	CHECKED BY	APPROVED BY		


	PERMIT STAMP AND PROFESSIONAL STAMP AFFIXED ABOVE SHALL APPLY ONLY TO REV(s)		SCALE: NTS	SIZE: A3	EMERSON PROJECT NO.: 3258585	PROJECT TITLE: DCS SERANG PROJECT	TITLE: COVER SHEET	EMERSON DRAWING NO.: 3258585-PSS-PASH-DWG-00011	SHEET NO.: 001
								CUSTOMER DRAWING NO.: -	REV.: 0

DRAWING INDEX & REVISION


DRAWING NO.		DRAWING TITLE										DATE	REV.	DATE	REV.	DATE	REV.	DATE	REV.	
3258585-PSS-PASH-DWG-00011	SHT.001	COVER SHEET										14/09/18	A	04/10/18	B	29/08/19	0			
3258585-PSS-PASH-DWG-00011	SHT.002	DRAWING INDEX & REVISION										14/09/18	A	04/10/18	B	29/08/19	0			
3258585-PSS-PASH-DWG-00011	SHT.003	RIO CABINET – RF1–RIO–001 – (FRONT DOOR VIEW, RIGHT SIDE & LEFT SIDE VIEW)										14/09/18	A	04/10/18	B	29/08/19	0			
3258585-PSS-PASH-DWG-00011	SHT.004	RIO CABINET – RF1–RIO–001 – (FRONT VIEW, SECTION A–A & SECTION B–B)										14/09/18	A	04/10/18	B	29/08/19	0			
3258585-PSS-PASH-DWG-00011	SHT.005	RIO CABINET – RF1–RIO–001 – BILL OF MATERIAL										14/09/18	A	04/10/18	B	29/08/19	0			
3258585-PSS-PASH-DWG-00011	SHT.006	RIO CABINET – RF1–RIO–002 – (FRONT DOOR VIEW, RIGHT SIDE & LEFT SIDE VIEW)										14/09/18	A	04/10/18	B	29/08/19	0			
3258585-PSS-PASH-DWG-00011	SHT.007	RIO CABINET – RF1–RIO–002 – (FRONT VIEW, SECTION A–A & SECTION B–B)										14/09/18	A	04/10/18	B	29/08/19	0			
3258585-PSS-PASH-DWG-00011	SHT.008	RIO CABINET – RF1–RIO–002 – BILL OF MATERIAL										14/09/18	A	04/10/18	B	29/08/19	0			
3258585-PSS-PASH-DWG-00011	SHT.009	RIO CABINET – RF1–RIO–003 – (FRONT DOOR VIEW, RIGHT SIDE & LEFT SIDE VIEW)										14/09/18	A	04/10/18	B	29/08/19	0			
3258585-PSS-PASH-DWG-00011	SHT.010	RIO CABINET – RF1–RIO–003 – (FRONT VIEW, SECTION A–A & SECTION B–B)										14/09/18	A	04/10/18	B	29/08/19	0			
3258585-PSS-PASH-DWG-00011	SHT.011	RIO CABINET – RF1–RIO–003 – BILL OF MATERIAL										14/09/18	A	04/10/18	B	29/08/19	0			
3258585-PSS-PASH-DWG-00011	SHT.012	RIO CABINET – RF1–RIO–004 – (FRONT DOOR VIEW, RIGHT SIDE & LEFT SIDE VIEW)										14/09/18	A	04/10/18	B	29/08/19	0			
3258585-PSS-PASH-DWG-00011	SHT.013	RIO CABINET – RF1–RIO–004 – (FRONT VIEW, SECTION A–A & SECTION B–B)										14/09/18	A	04/10/18	B	29/08/19	0			
3258585-PSS-PASH-DWG-00011	SHT.014	RIO CABINET – RF1–RIO–004 – BILL OF MATERIAL										14/09/18	A	04/10/18	B	29/08/19	0			
3258585-PSS-PASH-DWG-00011	SHT.015	RIO CABINET – RF1–RIO–005 – (FRONT DOOR VIEW, RIGHT SIDE & LEFT SIDE VIEW)										14/09/18	A	04/10/18	B	29/08/19	0			
3258585-PSS-PASH-DWG-00011	SHT.016	RIO CABINET – RF1–RIO–005 – (FRONT VIEW, SECTION A–A & SECTION B–B)										14/09/18	A	04/10/18	B	29/08/19	0			
3258585-PSS-PASH-DWG-00011	SHT.017	RIO CABINET – RF1–RIO–005 – BILL OF MATERIAL										14/09/18	A	04/10/18	B	29/08/19	0			

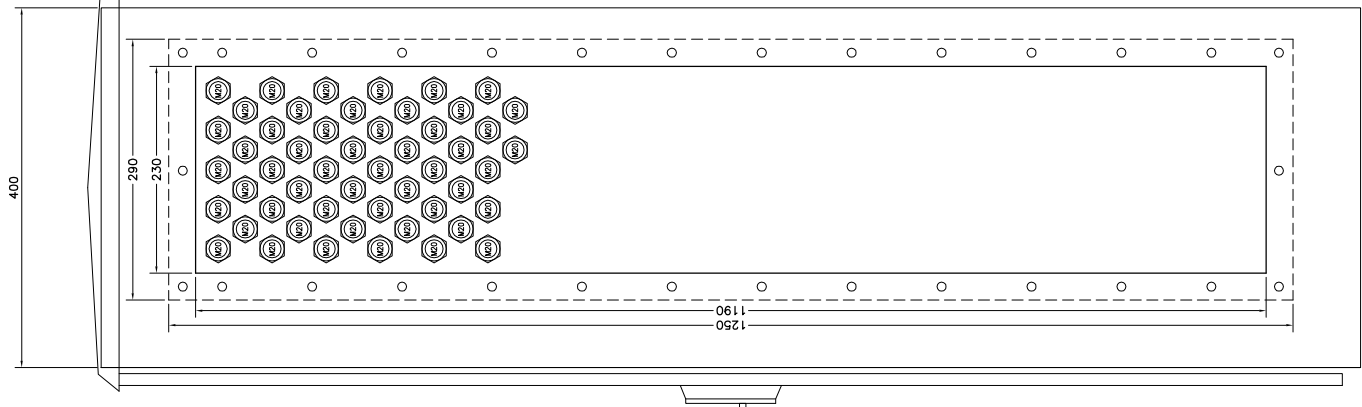

LEFT SIDE VIEW
RIO CABINET – RF1–RIO–001

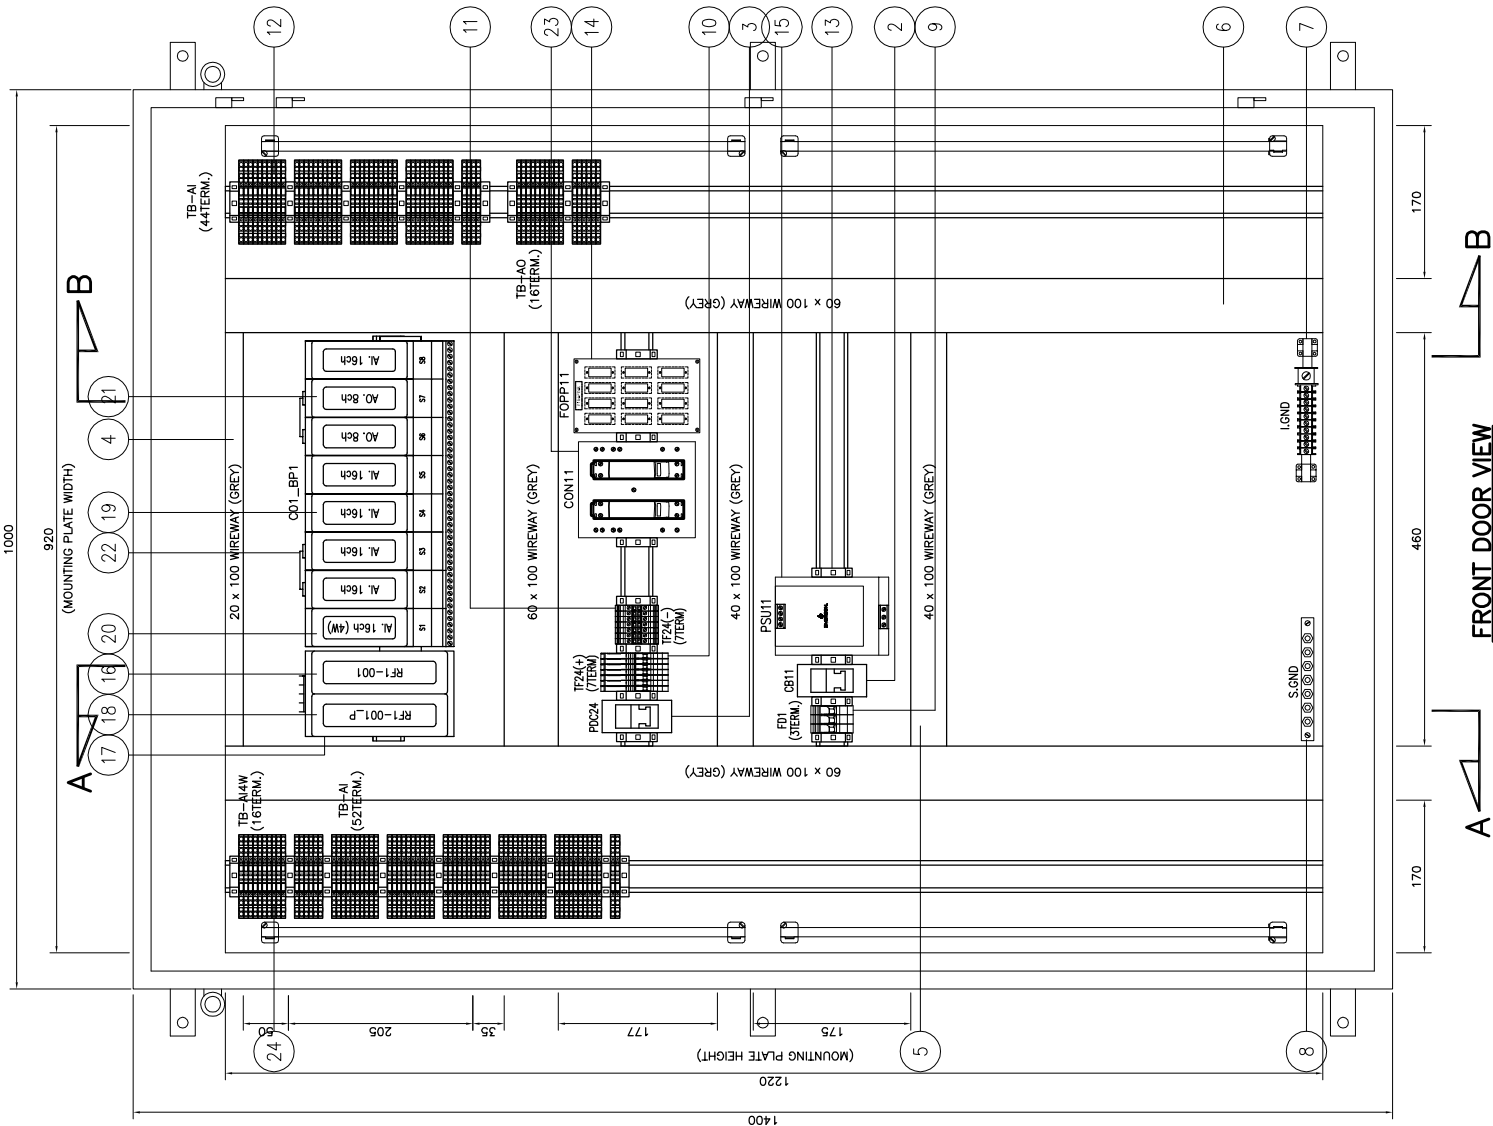

FRONT DOOR VIEW
RIO CABINET – RF1–RIO–001

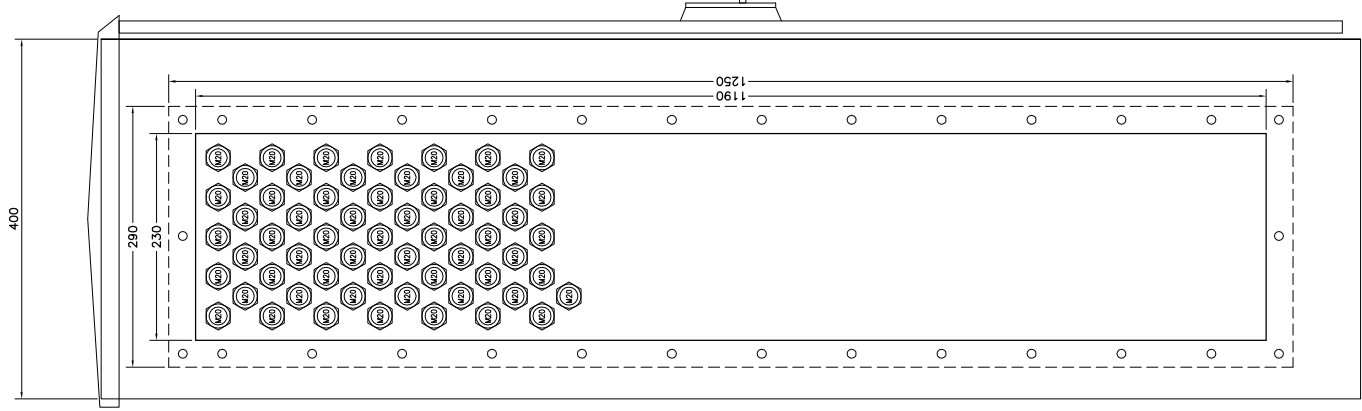

RIGHT SIDE VIEW
RIO CABINET – RF1–RIO–001



PERMIT STAMP AND PROFESSIONAL STAMP
AFFIXED ABOVE SHALL APPLY ONLY TO REV(s)

SCALE: NTS
SIZE: A3
UNITS: mm (inch)
© 2018

PROJECT TITLE:
DCS SERANG PROJECT

TITLE:
RIO CABINET – RF1–RIO–001
(FRONT VIEW,
SECTION A–A & SECTION B–B)

EMERSON DRAWING NO.:
3258585–PSS–PASH–DWG–00011
CUSTOMER DRAWING NO.:
–

SHEET NO.:
004
REV.:
0

BILL OF MATERIALS

ITEM NO.	DESCRIPTION		PART NUMBER	QTY.	MANUFACTURER
01	RIO CABINET (W1000 X H1400 X D400) FRONT ACCESS		NKD-3262869-02	1 SET	GRP INDUSTRIES
02	AC MCB 2POLE (10A)		IK60N C10A	1 PC	SCHNEIDER
03	DC MCB 2POLE (20A)		C60H-DC C20A	1 PC	SCHNEIDER
04	20 X 100 mm PVC WIREWAY (GREY)		-	1 LOT	CONTRACTOR
05	40 X 100 mm PVC WIREWAY (GREY)		-	1 LOT	CONTRACTOR
06	60 X 100 mm PVC WIREWAY (GREY)		-	1 LOT	CONTRACTOR
07	INSTRUMENT GROUND BAR		-	1 LOT	CONTRACTOR
08	SAFETY GROUND BAR		-	1 LOT	CONTRACTOR
09	2-COND THROUGH TERMINAL BLOCK, 10MM SQ		2010-1201	3 PCS	WAGO
10	FUSE DISCONNECT TB WITH FUSE BLOW INDICATOR, 24VDC, 4MM SQ		2004-1611/1000-0541	7 PCS	WAGO
11	2-COND THROUGH TERMINAL BLOCK, 4MM SQ		2004-1201	7 PCS	WAGO
12	DOUBLE DECK DISCONNECT TERMINAL BLOCK, 2.5MM SQ		2002-2671	112 PCS	WAGO
13	END STOPPER		249-117	1 LOT	WAGO
14	FIBER OPTIC PATCH PANEL (BY OTHERS)		TBA	1 PC	TBA
15	DELTAV BULK POWER SUPPLY 100-240 V AC TO 24 V DC, 20A		VE5126	1 PC	EMERSON PROCESS
16	REMOTE INTERFACE UNIT FOR ZONE 2 REMOTE I/O		VE4021	1 PC	EMERSON PROCESS
17	2-WIDE POWER/CONTROLLER CARRIER		VE3051C0	1 PC	EMERSON PROCESS
18	ENHANCED SYSTEM POWER SUPPLY; (DUAL DC/DC) INPUT		VE5009	1 PC	EMERSON PROCESS
19	ANALOG INPUT CARD; 16 CHANNELS; 4-20 MA; HART; I/O TERMINATION BLOCK		VE4003S2B6	5 PCS	EMERSON PROCESS
20	ANALOG INPUT CARD; 16 CHANNELS; 4-20 MA; HART; 4-WIRE; I/O TERMINATION BLOCK		VE4003S2B7	1 PC	EMERSON PROCESS
21	ANALOG OUTPUT, 8 CHANNELS 4-20 MA, HART, STANDARD I/O TERMINATION BLOCK		VE4005S2B1	2 PCS	EMERSON PROCESS
22	8-WIDE I/O INTERFACE CARRIER WITH CARRIER SHIELD BAR		VE3051C0	1 PC	EMERSON PROCESS
23	DUAL SINGLE MODE MEDIA CONVERTER ASSEMBLY		VE6060	1 PC	EMERSON PROCESS
24	DOUBLE DECK FUSE TERMINAL BLOCK WITH INDICATOR, 2.5MM SQ		2002-2611	16 PCS	WAGO
25					
26					
27					
28					





PERMIT STAMP AND PROFESSIONAL STAMP
AFFIXED ABOVE SHALL APPLY ONLY TO REV(s)

EMERSON PROJECT NO.: 3258585

PROJECT TITLE:
DCS SERANG PROJECT

SCALE: NTS

SIZE: A3

UNITS: mm (inch)

2018


TITLE:
RIO CABINET – RF1–RIO–001
BILL OF MATERIAL

EMERSON DRAWING NO.: 3258585–PSS–PASH–DWG–00011

CUSTOMER DRAWING NO.: –

SHEET NO: 005

REV: 0

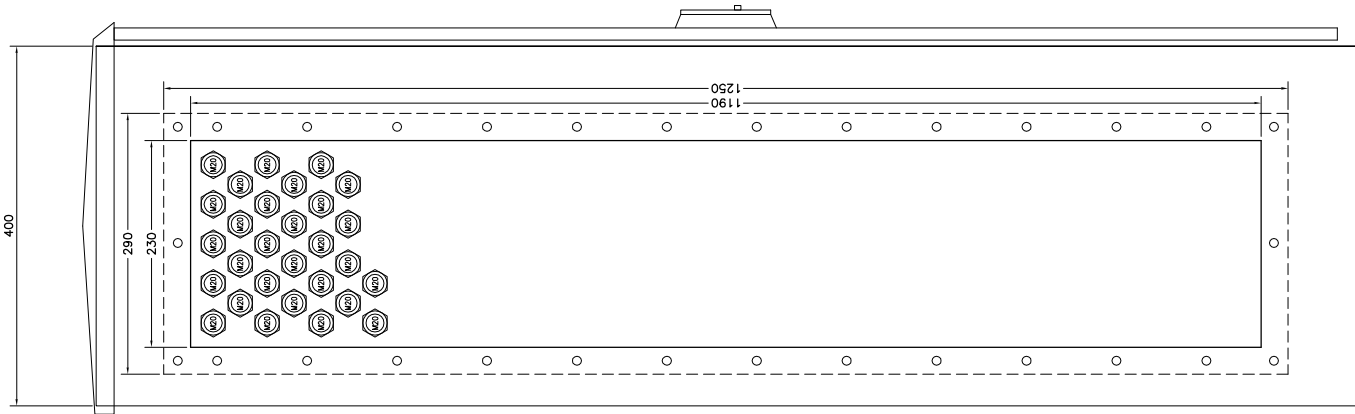

RIGHT SIDE VIEW
RIO CABINET – RF1 –RIO–002

THIS DRAWING IS THE PROPERTY OF EMERSON PROCESS MANAGEMENT. INFORMATION AND KNOW-HOW HEREIN ARE CONFIDENTIAL AND MAY NOT BE USED, REPRODUCED OR REVEALED TO OTHERS EXCEPT IN ACCORDANCE WITH CONTRACT OR OTHER WRITTEN CONSENT OF EMERSON PROCESS MANAGEMENT. ANY PERMITTED REPRODUCTION IN WHOLE OR IN PART, INCLUDING SHOP DRAWINGS MUST BEAR OR REFER TO THIS LEGEND.

BILL OF MATERIALS

ITEM NO.	DESCRIPTION		PART NUMBER	QTY.	MANUFACTURER
01	RIO CABINET (W1000 X H1400 X D400) FRONT ACCESS		NKD-3262869-02	1 SET	GRP INDUSTRIES
02	AC MCB 2POLE (10A)		IK60N C10A	1 PC	SCHNEIDER
03	DC MCB 2POLE (20A)		C60H-DC C20A	1 PC	SCHNEIDER
04	20 X 100 mm PVC WIREWAY (GREY)		-	1 LOT	CONTRACTOR
05	40 X 100 mm PVC WIREWAY (GREY)		-	1 LOT	CONTRACTOR
06	60 X 100 mm PVC WIREWAY (GREY)		-	1 LOT	CONTRACTOR
07	INSTRUMENT GROUND BAR		-	1 LOT	CONTRACTOR
08	SAFETY GROUND BAR		-	1 LOT	CONTRACTOR
09	2-COND THROUGH TERMINAL BLOCK, 10MM SQ		2010-1201	3 PCS	WAGO
10	FUSE DISCONNECT TB WITH FUSE BLOW INDICATOR, 24VDC, 4MM SQ		2004-1611/1000-0541	7 PCS	WAGO
11	2-COND THROUGH TERMINAL BLOCK, 4MM SQ		2004-1201	7 PCS	WAGO
12	DOUBLE DECK DISCONNECT TERMINAL BLOCK, 2.5MM SQ		2002-2671	56 PCS	WAGO
13	END STOPPER		249-117	1 LOT	WAGO
14	FIBER OPTIC PATCH PANEL (BY OTHERS)		TBA	1 PC	TBA
15	DELTAV BULK POWER SUPPLY 100-240 V AC TO 24 V DC, 20A		VE5126	1 PC	EMERSON PROCESS
16	REMOTE INTERFACE UNIT FOR ZONE 2 REMOTE I/O		VE4021	1 PC	EMERSON PROCESS
17	2-WIDE POWER/CONTROLLER CARRIER		VE3051C0	1 PC	EMERSON PROCESS
18	ENHANCED SYSTEM POWER SUPPLY; (DUAL DC/DC) INPUT		VE5009	1 PC	EMERSON PROCESS
19	ANALOG INPUT CARD; 16 CHANNELS; 4-20 MA; HART; I/O TERMINATION BLOCK		VE4003S2B6	3 PCS	EMERSON PROCESS
20	CARRIER BLANK CAP		VE6101	4 PCS	EMERSON PROCESS
21	ANALOG OUTPUT, 8 CHANNELS 4-20 MA, HART, STANDARD I/O TERMINATION BLOCK		VE4005S2B1	1 PC	EMERSON PROCESS
22	8-WIDE I/O INTERFACE CARRIER WITH CARRIER SHIELD BAR		VE3051C0	1 PC	EMERSON PROCESS
23	DUAL SINGLE MODE MEDIA CONVERTER ASSEMBLY		VE6060	1 PC	EMERSON PROCESS
24					
25					
26					
27					
28					



PERMIT STAMP AND PROFESSIONAL STAMP
AFFIXED ABOVE SHALL APPLY ONLY TO REV(s)



EMERSON PROJECT NO.: 3258585
PROJECT TITLE:
DCS SERANG PROJECT

TITLE:
RIO CABINET – RF1-RIO-002
BILL OF MATERIAL

EMERSON DRAWING NO.:
3258585-PSS-PASH-DWG-00011


CUSTOMER DRAWING NO.:
-

SHEET NO:


008

REV:

0

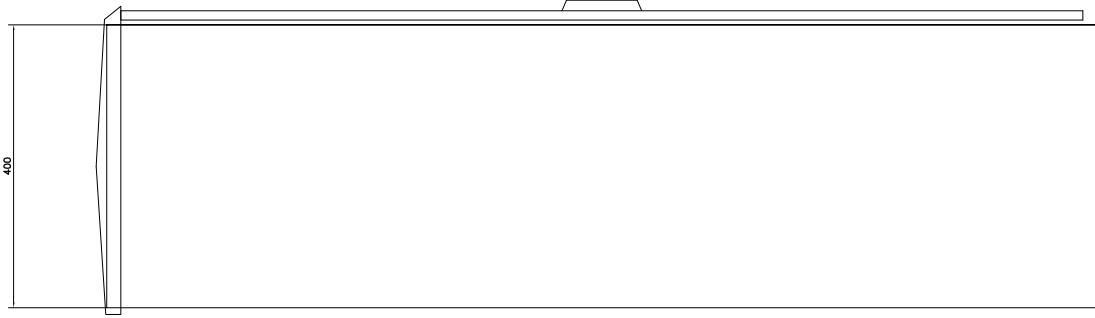

RIGHT SIDE VIEW
RIO CABINET - RF1-RIO-003

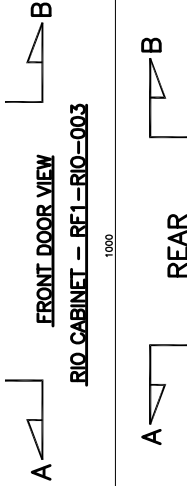


RIO CABINET - RF1-RIO-003




FRONT
BOTTOM VIEW
RIO CABINET - RF1-RIO-003


	PERMIT STAMP AND PROFESSIONAL STAMP AFFIXED ABOVE SHALL APPLY ONLY TO REV(S)	 EMERSON.	SCALE:	NTS	SIZE:	A3	EMERSON PROJECT NO.: 3258585 PROJECT TITLE: DCS SERANG PROJECT	TITLE: RIO CABINET -- RF1-RIO-003 (FRONT DOOR VIEW, RIGHT SIDE & LEFT SIDE VIEW)	EMERSON DRAWING NO.:	SHEET NO:
			UNITS:	mm (inch)	©	2018			CUSTOMER DRAWING NO.:	REV.:
									3258585-PSS-PASH-DWG-00011	009
									—	0

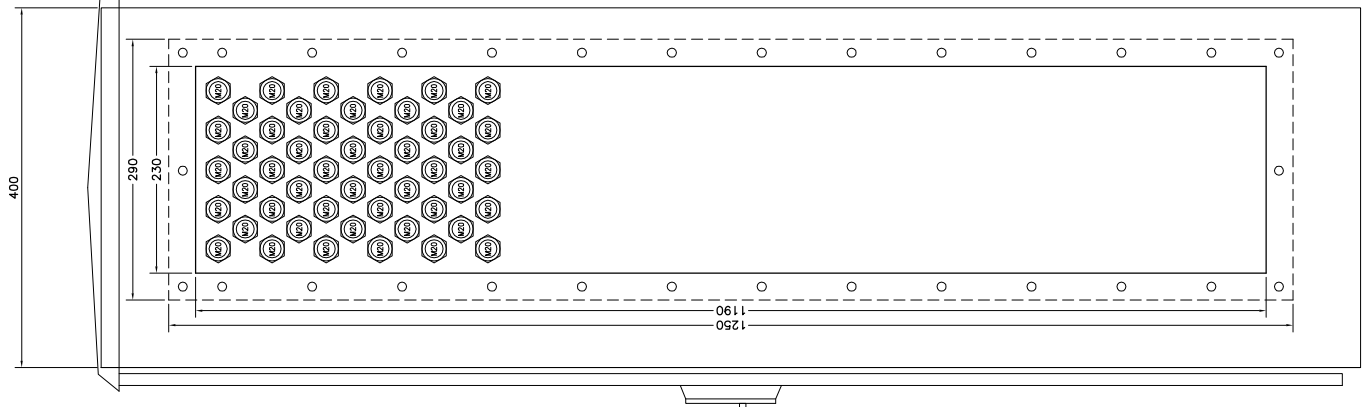

LEFT SIDE VIEW
RIO CABINET – RF1–RIO–003

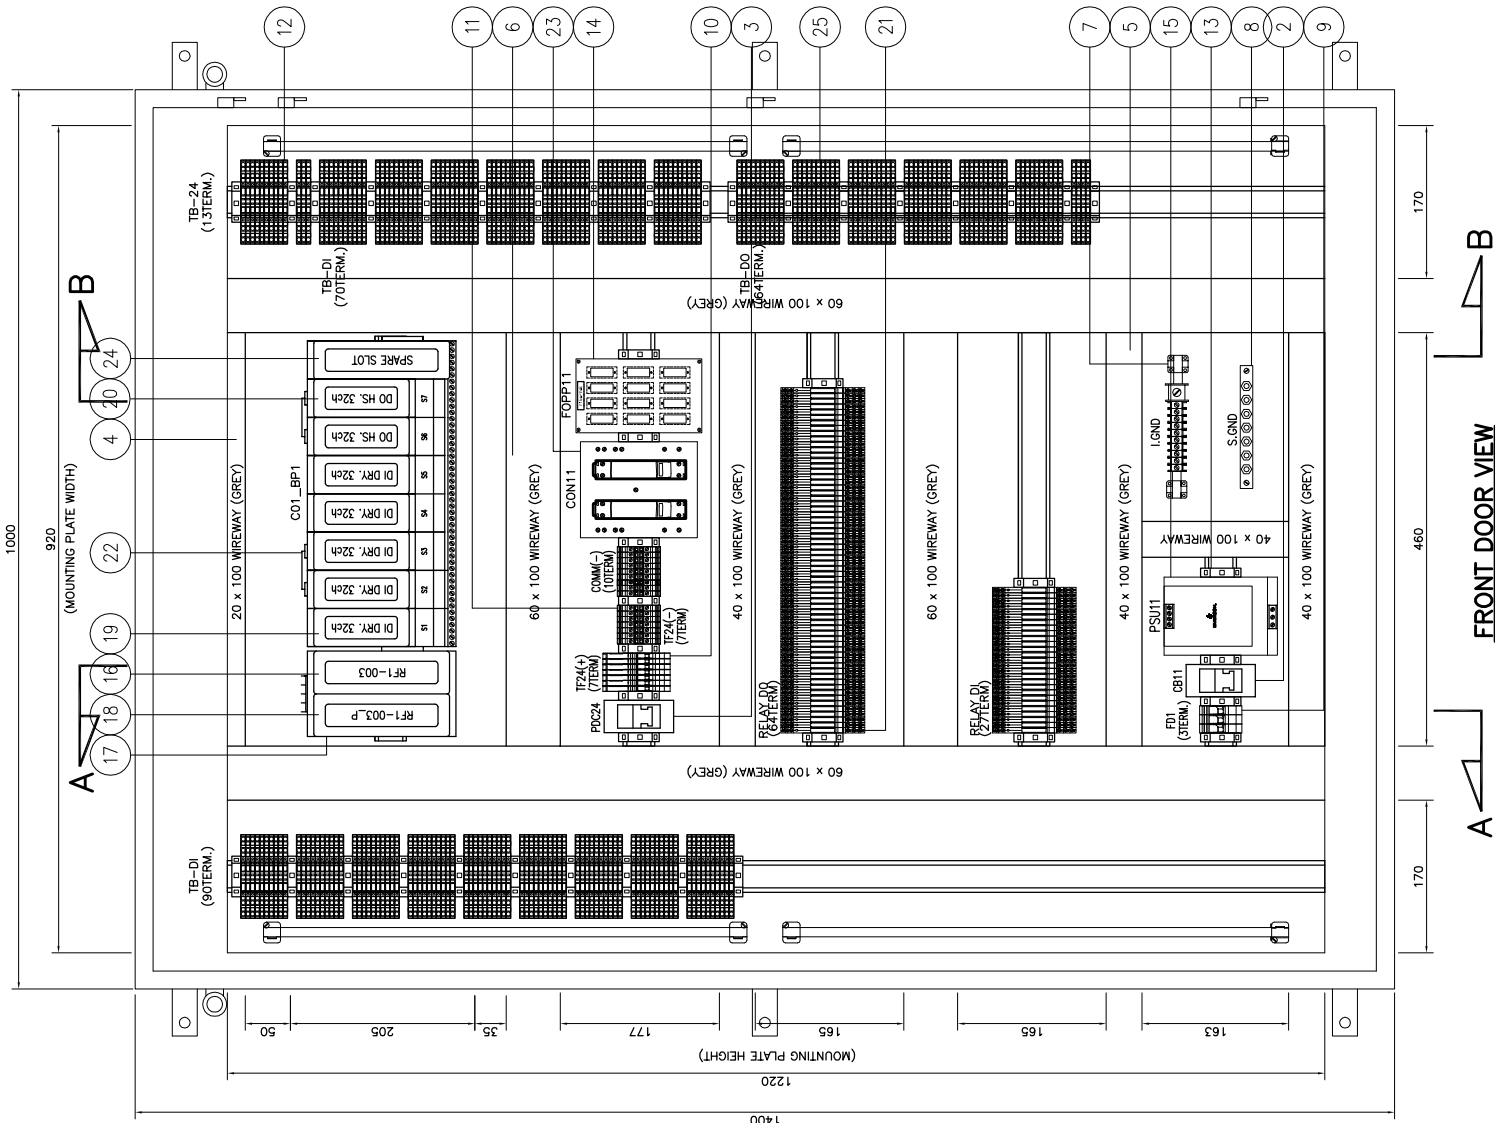

FRONT DOOR VIEW
RIO CABINET – RF1–RIO–003

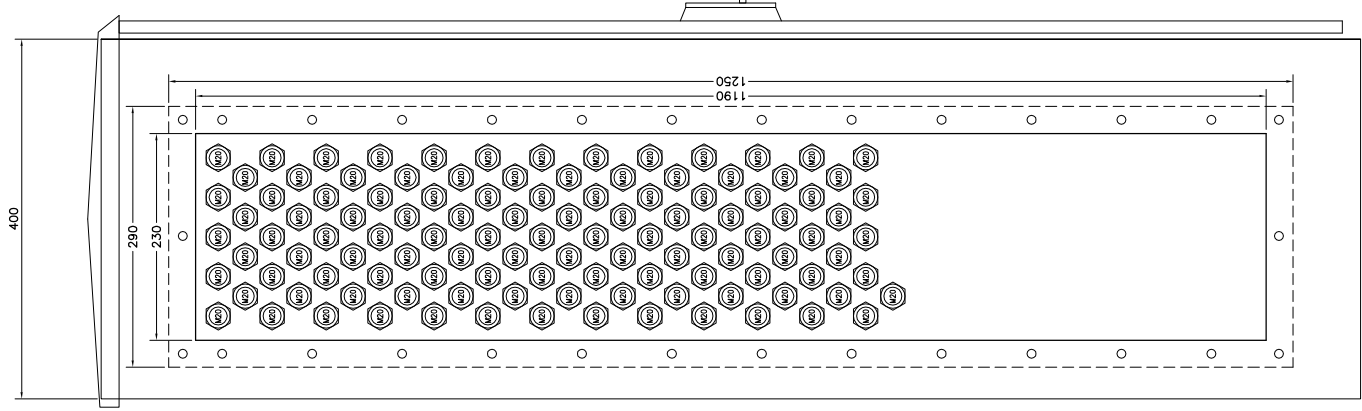

RIGHT SIDE VIEW
RIO CABINET – RF1–RIO–003



PERMIT STAMP AND PROFESSIONAL STAMP
AFFIXED ABOVE SHALL APPLY ONLY TO REV(s)

EMERSON PROJECT NO.: **3258585**
PROJECT TITLE:
DCS SERANG PROJECT

SCALE: **NTS** SIZE: **A3**
UNITS: **mm** (inch) **2018**

TITLE:
RIO CABINET – RF1–RIO–003
(FRONT VIEW,
SECTION A–A & SECTION B–B)

EMERSON DRAWING NO.:
3258585–PSS–PASH–DWG–00011

SHEET NO.:
010
REV.:
0

BILL OF MATERIALS

ITEM NO.	DESCRIPTION		PART NUMBER	QTY.	MANUFACTURER
01	RIO CABINET (W1000 X H1400 X D400) FRONT ACCESS		NKD-3262869-02	1 SET	GRP INDUSTRIES
02	AC MCB 2POLE (10A)		IK60N C10A	1 PC	SCHNEIDER
03	DC MCB 2POLE (20A)		C60H-DC C20A	1 PC	SCHNEIDER
04	20 X 100 mm PVC WIREWAY (GREY)		-	1 LOT	CONTRACTOR
05	40 X 100 mm PVC WIREWAY (GREY)		-	1 LOT	CONTRACTOR
06	60 X 100 mm PVC WIREWAY (GREY)		-	1 LOT	CONTRACTOR
07	INSTRUMENT GROUND BAR		-	1 LOT	CONTRACTOR
08	SAFETY GROUND BAR		-	1 LOT	CONTRACTOR
09	2-COND THROUGH TERMINAL BLOCK, 10MM SQ		2010-1201	3 PCS	WAGO
10	FUSE DISCONNECT TB WITH FUSE BLOW INDICATOR, 24VDC, 4MM SQ		2004-1611/1000-0541	7 PCS	WAGO
11	2-COND THROUGH TERMINAL BLOCK, 4MM SQ		2004-1201	17 PCS	WAGO
12	DOUBLE DECK DISCONNECT TERMINAL BLOCK, 2.5MM SQ		2002-2671	160 PCS	WAGO
13	END STOPPER		249-117	1 LOT	WAGO
14	FIBER OPTIC PATCH PANEL (BY OTHERS)		TBA	1 PC	TBA
15	DELTAV BULK POWER SUPPLY 100-240 V AC TO 24 V DC, 20A		VE5126	1 PC	EMERSON PROCESS
16	REMOTE INTERFACE UNIT FOR ZONE 2 REMOTE I/O		VE4021	1 PC	EMERSON PROCESS
17	2-WIDE POWER/CONTROLLER CARRIER		VE3051C0	1 PC	EMERSON PROCESS
18	ENHANCED SYSTEM POWER SUPPLY; (DUAL DC/DC) INPUT		VE5009	1 PC	EMERSON PROCESS
19	DISCRETE INPUT CARD: 32 CHANNELS 24 VDC; DRY CONTACT; TERMINATION BLOCK		VE4001S2T2B4	5 PCS	EMERSON PROCESS
20	DISCRETE OUTPUT CARD 32 CHANNELS 24 VDC; HIGH SIDE; I/O TERMINATION BLOCK		VE4002S1T2B5	2 PCS	EMERSON PROCESS
21	RELAY MODULE PLC-RSC-24DC/21		2966171	91 PCS	PHOENIX CONTACT
22	8-WIDE I/O INTERFACE CARRIER WITH CARRIER SHIELD BAR		VE3051C0	1 PC	EMERSON PROCESS
23	DUAL SINGLE MODE MEDIA CONVERTER ASSEMBLY		VE6060	1 PC	EMERSON PROCESS
24	CARRIER BLANK CAP		VE6101	1 PC	EMERSON PROCESS
25	DOUBLE DECK FUSE TERMINAL BLOCK WITH INDICATOR, 2.5MM SQ		2002-2611	105 PCS	WAGO
26					
27					
28					





PERMIT STAMP AND PROFESSIONAL STAMP
AFFIXED ABOVE SHALL APPLY ONLY TO REV(s)

EMERSON PROJECT NO.: 3258585
PROJECT TITLE: DCS SERANG PROJECT


SCALE: NTS
UNITS: mm (inch)

SIZE: A3
2018


TITLE: RIO CABINET - RF1-RIO-003
BILL OF MATERIAL

EMERSON DRAWING NO.: 3258585-PSS-PASH-DWG-00011
CUSTOMER DRAWING NO.: -


SHEET NO: 011
REV: 0

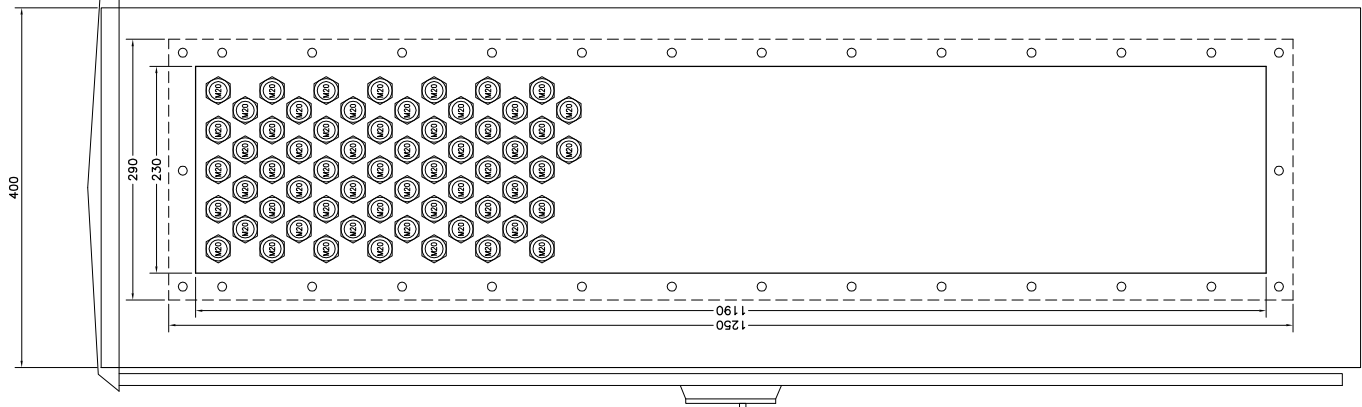

LEFT SIDE VIEW
RIO CABINET – RF1–RIO–004

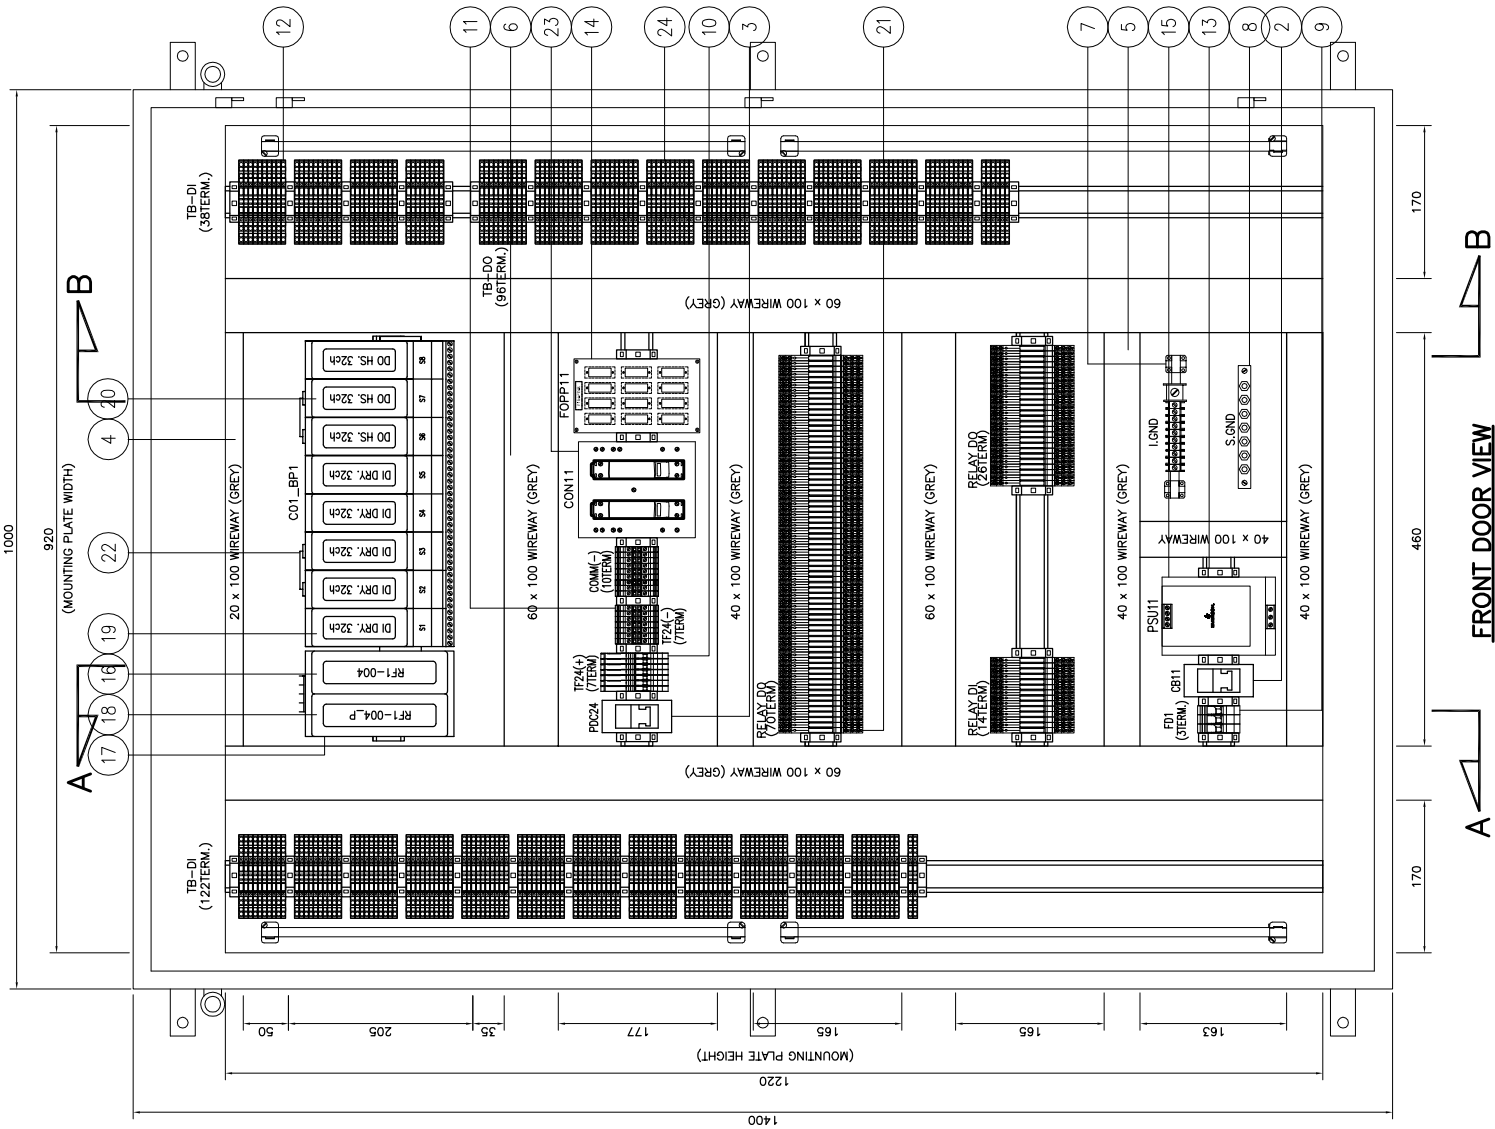

FRONT DOOR VIEW
RIO CABINET – RF1–RIO–004

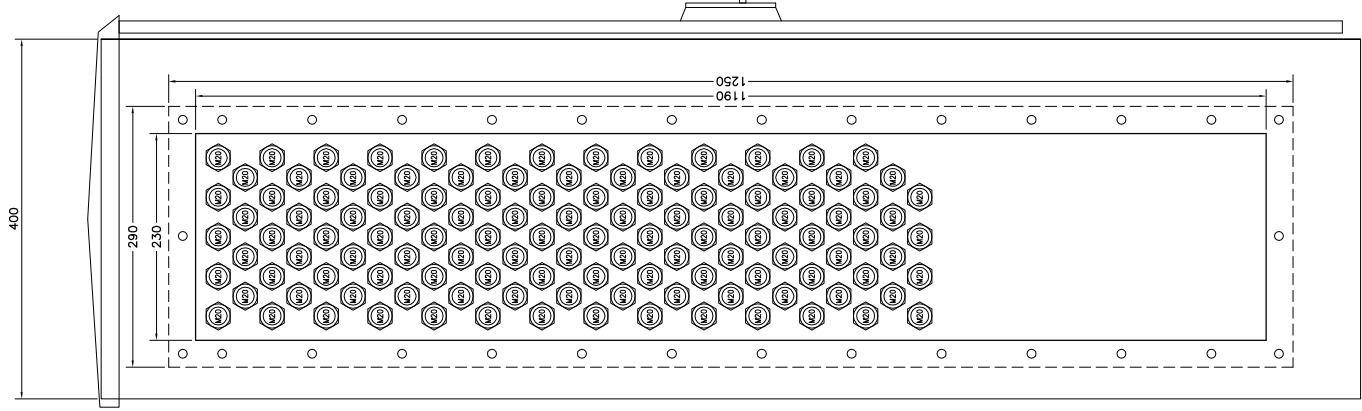

RIGHT SIDE VIEW
RIO CABINET – RF1–RIO–004



PERMIT STAMP AND PROFESSIONAL STAMP
AFFIXED ABOVE SHALL APPLY ONLY TO REV(s)

EMERSON PROJECT NO.: 3258585
PROJECT TITLE:
DCS SERANG PROJECT

SCALE: NTS
SIZE: A3
UNITS: mm (inch)
2018

TITLE:
RIO CABINET – RF1–RIO–004
(FRONT VIEW,
SECTION A–A & SECTION B–B)

EMERSON DRAWING NO.:
3258585–PSS–PASH–DWG–00011

SHEET NO.: 013
REV.: 0

BILL OF MATERIALS

ITEM NO.	DESCRIPTION		PART NUMBER	QTY.	MANUFACTURER
01	RIO CABINET (W1000 X H1400 X D400) FRONT ACCESS		NKD-3262869-02	1 SET	GRP INDUSTRIES
02	AC MCB 2POLE (10A)		IK60N C10A	1 PC	SCHNEIDER
03	DC MCB 2POLE (20A)		C60H-DC C20A	1 PC	SCHNEIDER
04	20 X 100 mm PVC WIREWAY (GREY)		-	1 LOT	CONTRACTOR
05	40 X 100 mm PVC WIREWAY (GREY)		-	1 LOT	CONTRACTOR
06	60 X 100 mm PVC WIREWAY (GREY)		-	1 LOT	CONTRACTOR
07	INSTRUMENT GROUND BAR		-	1 LOT	CONTRACTOR
08	SAFETY GROUND BAR		-	1 LOT	CONTRACTOR
09	2-COND THROUGH TERMINAL BLOCK, 10MM SQ		2010-1201	3 PCS	WAGO
10	FUSE DISCONNECT TB WITH FUSE BLOW INDICATOR, 24VDC, 4MM SQ		2004-1611/1000-0541	7 PCS	WAGO
11	2-COND THROUGH TERMINAL BLOCK, 4MM SQ		2004-1201	17 PCS	WAGO
12	DOUBLE DECK DISCONNECT TERMINAL BLOCK, 2.5MM SQ		2002-2671	160 PCS	WAGO
13	END STOPPER		249-117	1 LOT	WAGO
14	FIBER OPTIC PATCH PANEL (BY OTHERS)		TBA	1 PC	TBA
15	DELTAV BULK POWER SUPPLY 100-240 V AC TO 24 V DC, 20A		VE5126	1 PC	EMERSON PROCESS
16	REMOTE INTERFACE UNIT FOR ZONE 2 REMOTE I/O		VE4021	1 PC	EMERSON PROCESS
17	2-WIDE POWER/CONTROLLER CARRIER		VE3051C0	1 PC	EMERSON PROCESS
18	ENHANCED SYSTEM POWER SUPPLY; (DUAL DC/DC) INPUT		VE5009	1 PC	EMERSON PROCESS
19	DISCRETE INPUT CARD: 32 CHANNELS 24 VDC; DRY CONTACT; TERMINATION BLOCK		VE4001S2T2B4	5 PCS	EMERSON PROCESS
20	DISCRETE OUTPUT CARD 32 CHANNELS 24 VDC; HIGH SIDE; I/O TERMINATION BLOCK		VE4002S1T2B5	3 PCS	EMERSON PROCESS
21	RELAY MODULE PLC-RSC-24DC/21		2966171	110 PCS	PHOENIX CONTACT
22	8-WIDE I/O INTERFACE CARRIER WITH CARRIER SHIELD BAR		VE3051C0	1 PC	EMERSON PROCESS
23	DUAL SINGLE MODE MEDIA CONVERTER ASSEMBLY		VE6060	1 PC	EMERSON PROCESS
24	DOUBLE DECK FUSE TERMINAL BLOCK WITH INDICATOR, 2.5MM SQ		2002-2611	108 PCS	WAGO
25					
26					
27					
28					





PERMIT STAMP AND PROFESSIONAL STAMP
AFFIXED ABOVE SHALL APPLY ONLY TO REV(s)

EMERSON PROJECT NO.: 3258585
PROJECT TITLE: DCS SERANG PROJECT


SCALE: NTS
UNITS: mm (inch)

SIZE: A3
2018


TITLE: RIO CABINET - RF1-RIO-004
BILL OF MATERIAL

EMERSON DRAWING NO.: 3258585-PSS-PASH-DWG-00011
CUSTOMER DRAWING NO.: -

SHEET NO: 014
REV: 0

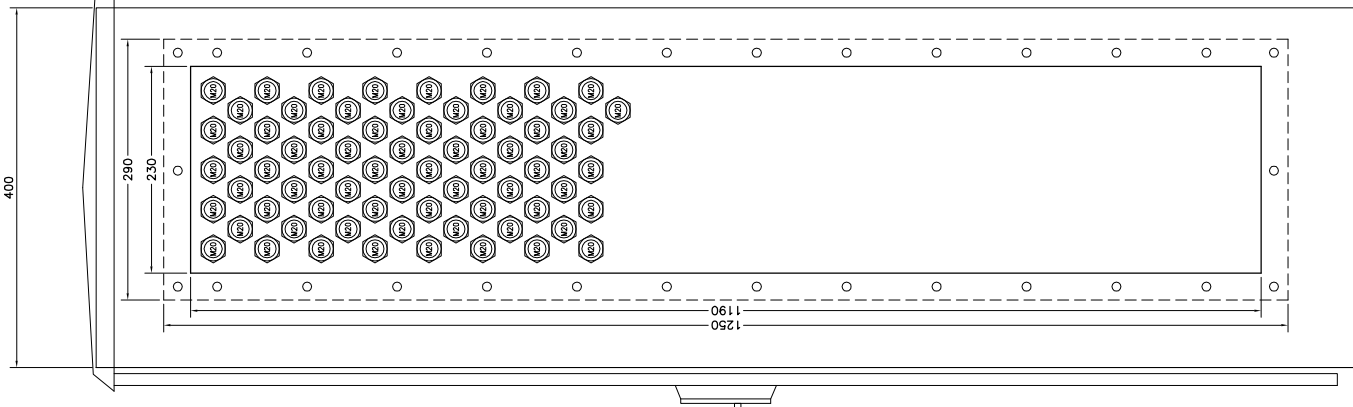

RIGHT SIDE VIEW
RIO CABINET – RF1–RIO–005

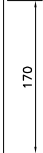

	PERMIT STAMP AND PROFESSIONAL STAMP AFFIXED ABOVE SHALL APPLY ONLY TO REV(S)	 EMERSON.	SCALE:	NTS	SIZE:	A3	EMERSON PROJECT NO.: 3258585 PROJECT TITLE: DCS SERANG PROJECT	TITLE: RIO CABINET – RF1–RIO–005 (FRONT VIEW, SECTION A–A & SECTION B–B)	EMERSON DRAWING NO.: 3258585–PSS–PASH–DWG–00011	SHEET NO.: 016
			UNITS:	mm (inch)	©	2018				CUSTOMER DRAWING NO.: —

BILL OF MATERIALS

ITEM NO.	DESCRIPTION		PART NUMBER	QTY.	MANUFACTURER
01	RIO CABINET (W1000 X H1400 X D400) FRONT ACCESS		NKD-3262869-02	1 SET	GRP INDUSTRIES
02	AC MCB 2POLE (10A)		IK60N C10A	1 PC	SCHNEIDER
03	DC MCB 2POLE (20A)		C60H-DC C20A	1 PC	SCHNEIDER
04	20 X 100 mm PVC WIREWAY (GREY)		-	1 LOT	CONTRACTOR
05	40 X 100 mm PVC WIREWAY (GREY)		-	1 LOT	CONTRACTOR
06	60 X 100 mm PVC WIREWAY (GREY)		-	1 LOT	CONTRACTOR
07	INSTRUMENT GROUND BAR		-	1 LOT	CONTRACTOR
08	SAFETY GROUND BAR		-	1 LOT	CONTRACTOR
09	2-COND THROUGH TERMINAL BLOCK, 10MM SQ		2010-1201	3 PCS	WAGO
10	FUSE DISCONNECT TB WITH FUSE BLOW INDICATOR, 24VDC, 4MM SQ		2004-1611/1000-0541	7 PCS	WAGO
11	2-COND THROUGH TERMINAL BLOCK, 4MM SQ		2004-1201	17 PCS	WAGO
12	DOUBLE DECK DISCONNECT TERMINAL BLOCK, 2.5MM SQ		2002-2671	160 PCS	WAGO
13	END STOPPER		249-117	1 LOT	WAGO
14	FIBER OPTIC PATCH PANEL (BY OTHERS)		TBA	1 PC	TBA
15	DELTAV BULK POWER SUPPLY 100-240 V AC TO 24 V DC, 20A		VE5126	1 PC	EMERSON PROCESS
16	REMOTE INTERFACE UNIT FOR ZONE 2 REMOTE I/O		VE4021	1 PC	EMERSON PROCESS
17	2-WIDE POWER/CONTROLLER CARRIER		VE3051C0	1 PC	EMERSON PROCESS
18	ENHANCED SYSTEM POWER SUPPLY; (DUAL DC/DC) INPUT		VE5009	1 PC	EMERSON PROCESS
19	DISCRETE INPUT CARD: 32 CHANNELS 24 VDC; DRY CONTACT; TERMINATION BLOCK		VE4001S2T2B4	5 PCS	EMERSON PROCESS
20	DISCRETE OUTPUT CARD 32 CHANNELS 24 VDC; HIGH SIDE; I/O TERMINATION BLOCK		VE4002S1T2B5	3 PCS	EMERSON PROCESS
21	RELAY MODULE PLC-RSC-24DC/21		2966171	111 PCS	PHOENIX CONTACT
22	8-WIDE I/O INTERFACE CARRIER WITH CARRIER SHIELD BAR		VE3051C0	1 PC	EMERSON PROCESS
23	DUAL SINGLE MODE MEDIA CONVERTER ASSEMBLY		VE6060	1 PC	EMERSON PROCESS
24	DOUBLE DECK FUSE TERMINAL BLOCK WITH INDICATOR, 2.5MM SQ		2002-2611	112 PCS	WAGO
25					
26					
27					
28					



PERMIT STAMP AND PROFESSIONAL STAMP
AFFIXED ABOVE SHALL APPLY ONLY TO REV(s)

EMERSON PROJECT NO.: 3258585
PROJECT TITLE: DCS SERANG PROJECT

SCALE: NTS
UNITS: mm (inch)

SIZE: A3
2018

TITLE: RIO CABINET - RF1-RIO-005
BILL OF MATERIAL

EMERSON DRAWING NO.: 3258585-PSS-PASH-DWG-00011
CUSTOMER DRAWING NO.: -

SHEET NO: 017

REV: 0