


DOCUMENT STATUS	
FOR INFORMATION	☐
COMMENTED	☐
APPROVED WITH COMMENTS	☐
APPROVED FOR DESIGN/CONSTRUCTION	☐
REJECTED	☐

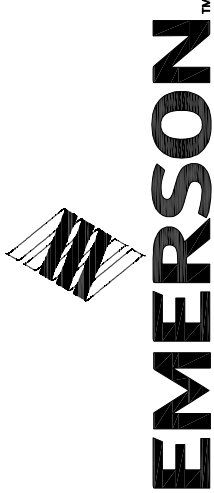

GENERAL AND INTERNAL ARRANGEMENT DRAWING -

WWTP / ETP

DCS SERANG PROJECT



							CUSTOMER :	WILMAR INDUSTRIAL COMPLEX PT MNA SERANG, INDONESIA
							CONTRACT NO. :	-
							PROJECT TITLE :	DCS SERANG PROJECT
							CUSTOMER PROJECT NO. :	-
0	AS BUILT			AS/NAM	LKL	MNI		
A	ISSUE FOR COMMENT			AS	LKL	MNI		
REV.			DATE	DRAWN BY	CHECKED BY	APPROVED BY		

	PERMIT STAMP AND PROFESSIONAL STAMP AFFIXED ABOVE SHALL APPLY ONLY TO REV(s)		SCALE: NTS	SIZE: A3	EMERSON PROJECT NO.: 3258585	TITLE: COVER SHEET	EMERSON DRAWING NO.: 3258585-PSS-PASH-DWG-00031	SHEET NO: 001
			UNITS: mm (inch)	© 2018	PROJECT TITLE: DCS SERANG PROJECT		CUSTOMER DRAWING NO.: -	REV: 0


DRAWING INDEX & REVISION

[illegible]


	PERMIT STAMP AND PROFESSIONAL STAMP AFFIXED ABOVE SHALL APPLY ONLY TO REV(S)		SCALE: NTS	SIZE: A3	EMERSON PROJECT NO.: 3258585 PROJECT TITLE: DCS SERANG PROJECT	TITLE: DRAWING INDEX & REVISION	EMERSON DRAWING NO.: 3258585-PSS-PASH-DWG-00031 CUSTOMER DRAWING NO.: —	SHEET NO: 002
			UNITS: mm (inch)	2018				REV.: 0

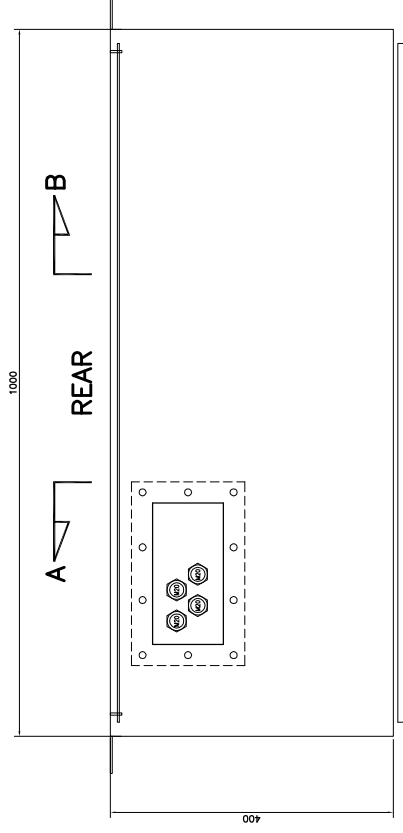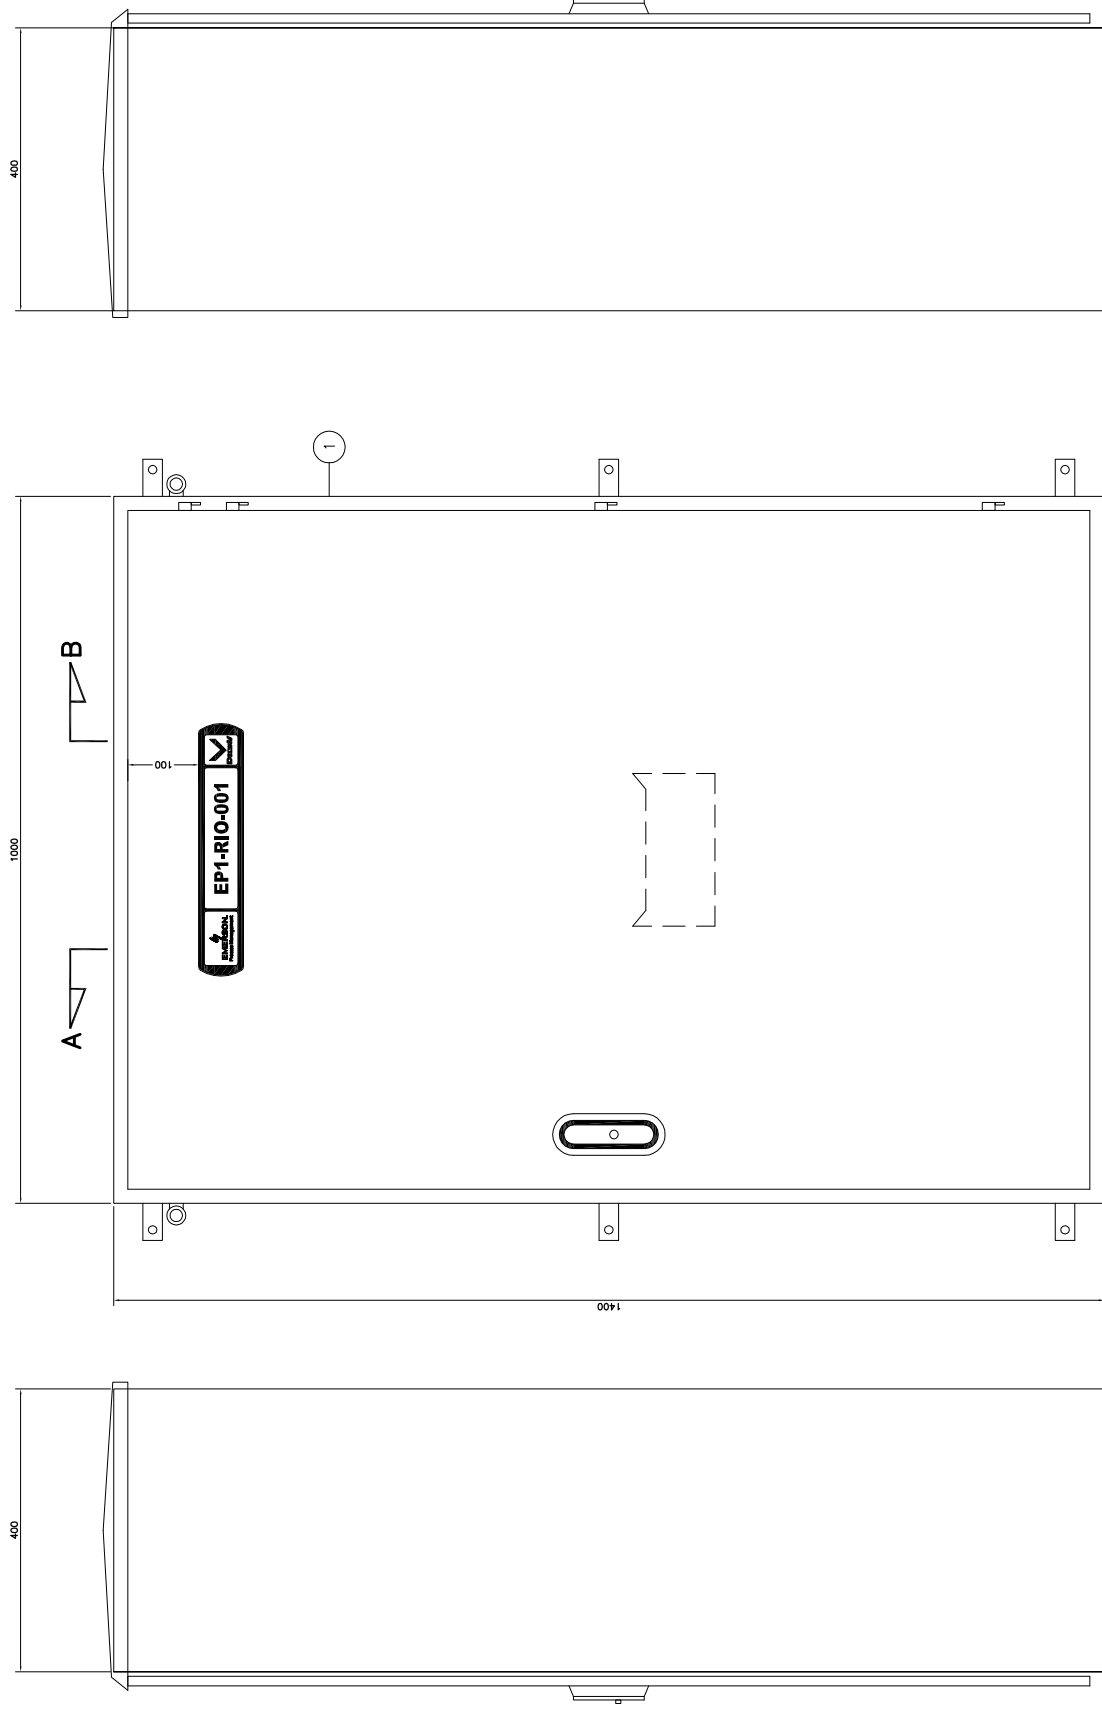


	PERMIT STAMP AND PROFESSIONAL STAMP AFFIXED ABOVE SHALL APPLY ONLY TO REV(S)		SCALE:	NTS	SIZE:	A3	EMERSON PROJECT NO.: 3258585	PROJECT TITLE: DCS SERANG PROJECT	TITLE: RIO CABINET – EP1–RIO–001 (FRONT DOOR VIEW, RIGHT SIDE & LEFT SIDE VIEW)	EMERSON DRAWING NO.: 3258585–PSS–PASH–DWG–00031	SHEET NO:	003
			UNITS:	mm (inch)	©	2018					CUSTOMER DRAWING NO.: –	REV.: 0

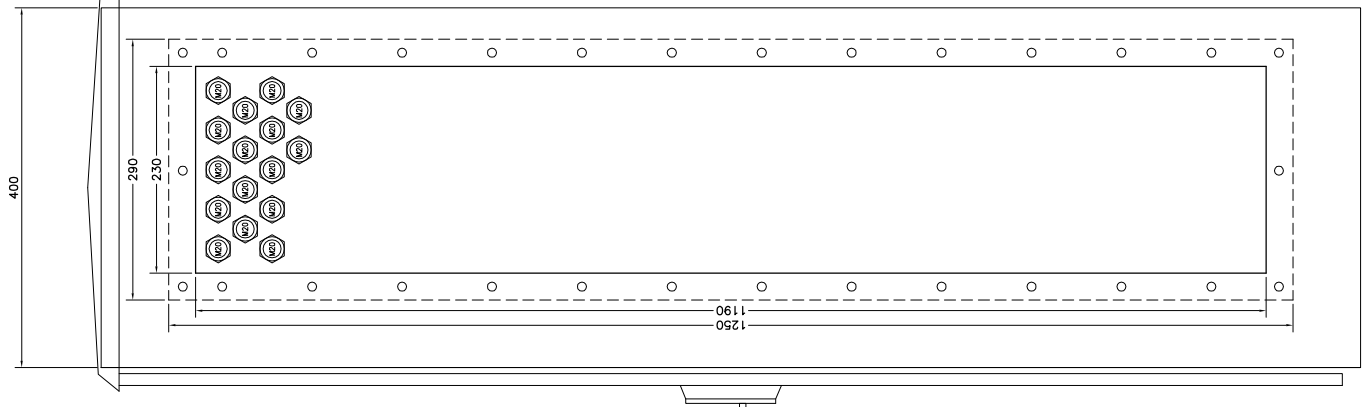

LEFT SIDE VIEW
RIO CABINET – EP1–RIO–001

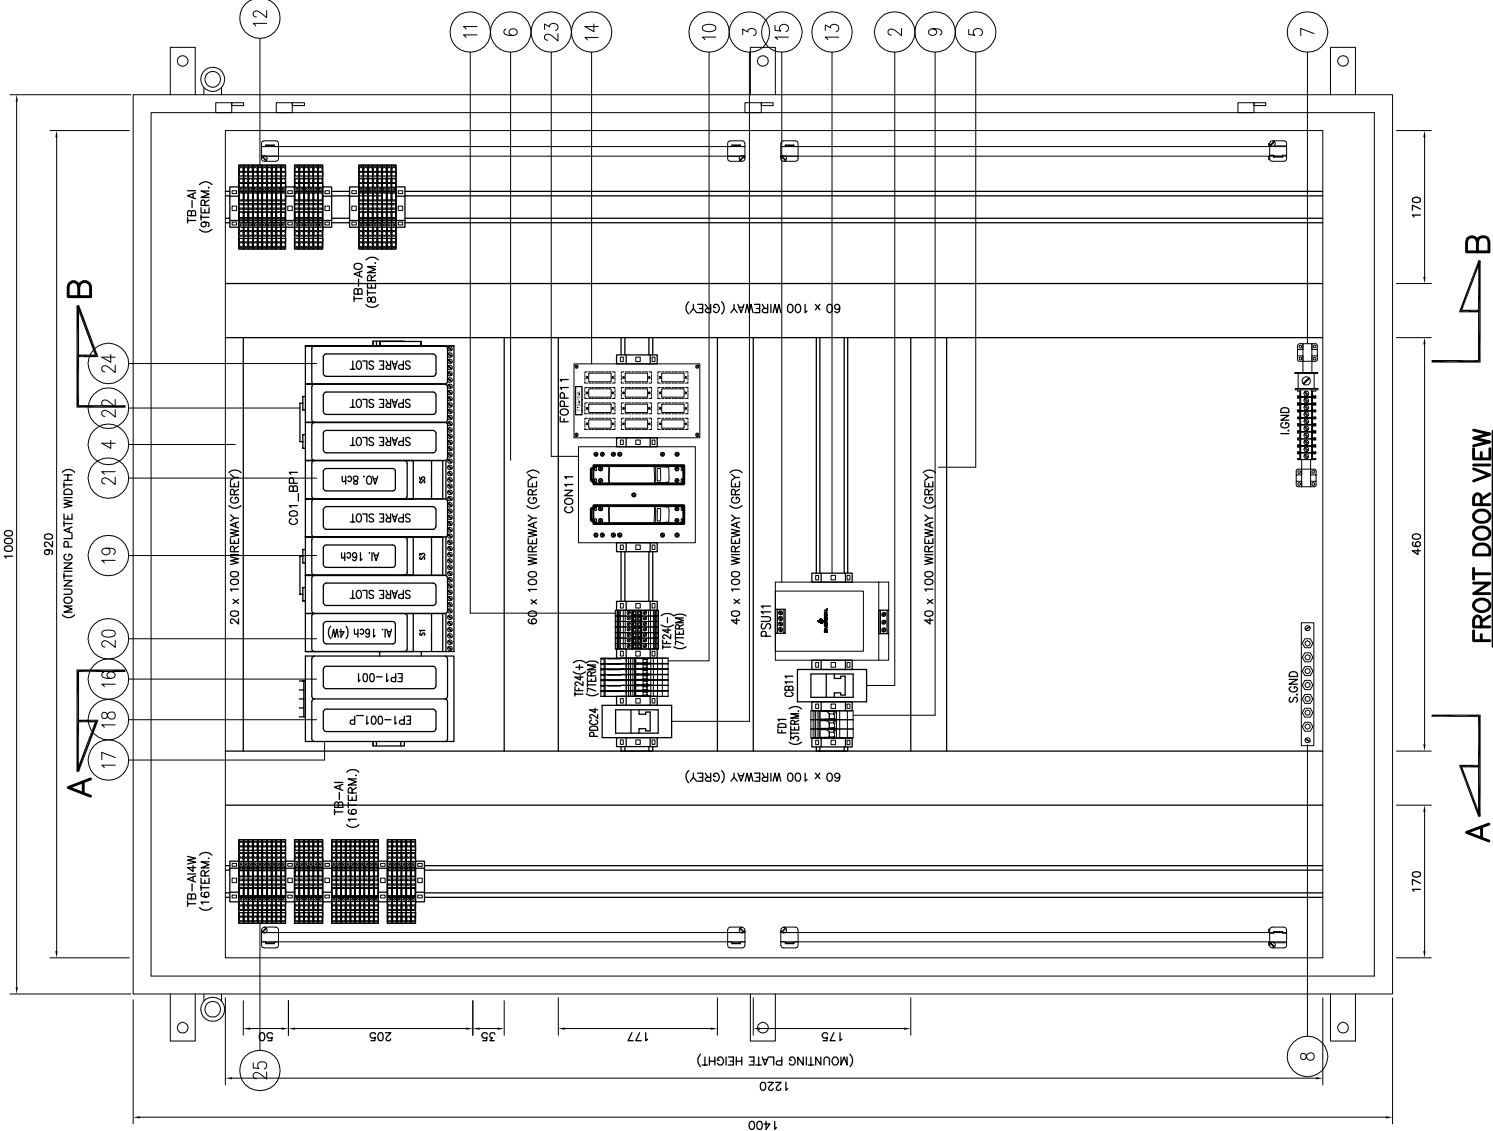

FRONT DOOR VIEW
RIO CABINET – EP1–RIO–001

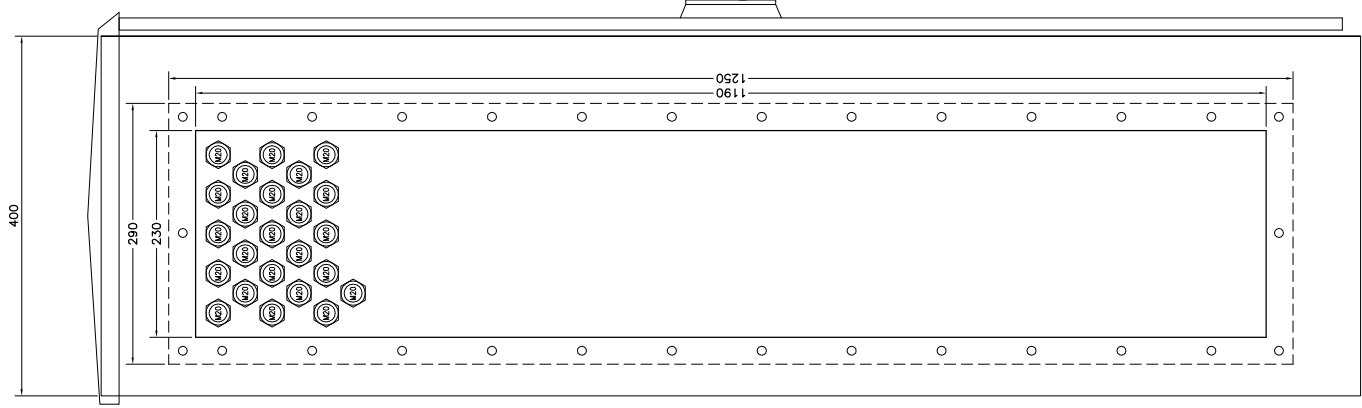

RIGHT SIDE VIEW
RIO CABINET – EP1–RIO–001



PERMIT STAMP AND PROFESSIONAL STAMP
AFFIXED ABOVE SHALL APPLY ONLY TO REV(s)

EMERSON PROJECT NO.: 3258585
PROJECT TITLE:
DCS SERANG PROJECT

SCALE: NTS
SIZE: A3
UNITS: mm (inch)
2018

TITLE:
RIO CABINET – EP1–RIO–001
(FRONT VIEW,
SECTION A–A & SECTION B–B)

EMERSON DRAWING NO.:
3258585–PSS–PASH–DWG–00031

CUSTOMER DRAWING NO.:
–

SHEET NO.:
004
REV.:
0

BILL OF MATERIALS

ITEM NO.	DESCRIPTION		PART NUMBER	QTY.	MANUFACTURER
01	RIO CABINET (W1000 X H1400 X D400) FRONT ACCESS		NKD-3262869-02	1 SET	GRP INDUSTRIES
02	AC MCB 2POLE (10A)		IK60N C10A	1 PC	SCHNEIDER
03	DC MCB 2POLE (20A)		C60H-DC C20A	1 PC	SCHNEIDER
04	20 X 100 mm PVC WIREWAY (GREY)		-	1 LOT	CONTRACTOR
05	40 X 100 mm PVC WIREWAY (GREY)		-	1 LOT	CONTRACTOR
06	60 X 100 mm PVC WIREWAY (GREY)		-	1 LOT	CONTRACTOR
07	INSTRUMENT GROUND BAR		-	1 LOT	CONTRACTOR
08	SAFETY GROUND BAR		-	1 LOT	CONTRACTOR
09	2-COND THROUGH TERMINAL BLOCK, 10MM SQ		2010-1201	3 PCS	WAGO
10	FUSE DISCONNECT TB WITH FUSE BLOW INDICATOR, 24VDC, 4MM SQ		2004-1611/1000-0541	7 PCS	WAGO
11	2-COND THROUGH TERMINAL BLOCK, 4MM SQ		2004-1201	7 PCS	WAGO
12	DOUBLE DECK DISCONNECT TERMINAL BLOCK, 2.5MM SQ		2002-2671	40 PCS	WAGO
13	END STOPPER		249-117	1 LOT	WAGO
14	FIBER OPTIC PATCH PANEL (BY OTHERS)		TBA	1 PC	TBA
15	DELTAV BULK POWER SUPPLY 100-240 V AC TO 24 V DC, 20A		VE5126	1 PC	EMERSON PROCESS
16	REMOTE INTERFACE UNIT FOR ZONE 2 REMOTE I/O		VE4021	1 PC	EMERSON PROCESS
17	2-WIDE POWER/CONTROLLER CARRIER		VE3051C0	1 PC	EMERSON PROCESS
18	ENHANCED SYSTEM POWER SUPPLY; (DUAL DC/DC) INPUT		VE5009	1 PC	EMERSON PROCESS
19	ANALOG INPUT CARD; 16 CHANNELS; 4-20 MA; HART; I/O TERMINATION BLOCK		VE4003S2B6	1 PC	EMERSON PROCESS
20	ANALOG INPUT CARD; 16 CHANNELS; 4-20 MA; HART; 4-WIRE; I/O TERMINATION BLOCK		VE4003S2B7	1 PC	EMERSON PROCESS
21	ANALOG OUTPUT, 8 CHANNELS 4-20 MA, HART, STANDARD I/O TERMINATION BLOCK		VE4005S2B1	1 PC	EMERSON PROCESS
22	8-WIDE I/O INTERFACE CARRIER WITH CARRIER SHIELD BAR		VE3051C0	1 PC	EMERSON PROCESS
23	DUAL SINGLE MODE MEDIA CONVERTER ASSEMBLY		VE6060	1 PC	EMERSON PROCESS
24	CARRIER BLANK CAP		VE6101	5 PCS	EMERSON PROCESS
25	DOUBLE DECK FUSE TERMINAL BLOCK WITH INDICATOR, 2.5MM SQ		2002-2611	16 PCS	WAGO
26					
27					
28					



PERMIT STAMP AND PROFESSIONAL STAMP
AFFIXED ABOVE SHALL APPLY ONLY TO REV(s)

EMERSON PROJECT NO.: 3258585
PROJECT TITLE:
DCS SERANG PROJECT


SCALE: NTS
UNITS: mm (inch)

SIZE: A3
2018


TITLE:
RIO CABINET – EP1-RIO-001
BILL OF MATERIAL

EMERSON DRAWING NO.: 3258585-PSS-PASH-DWG-00031
CUSTOMER DRAWING NO.: -


SHEET NO: 005
REV: 0

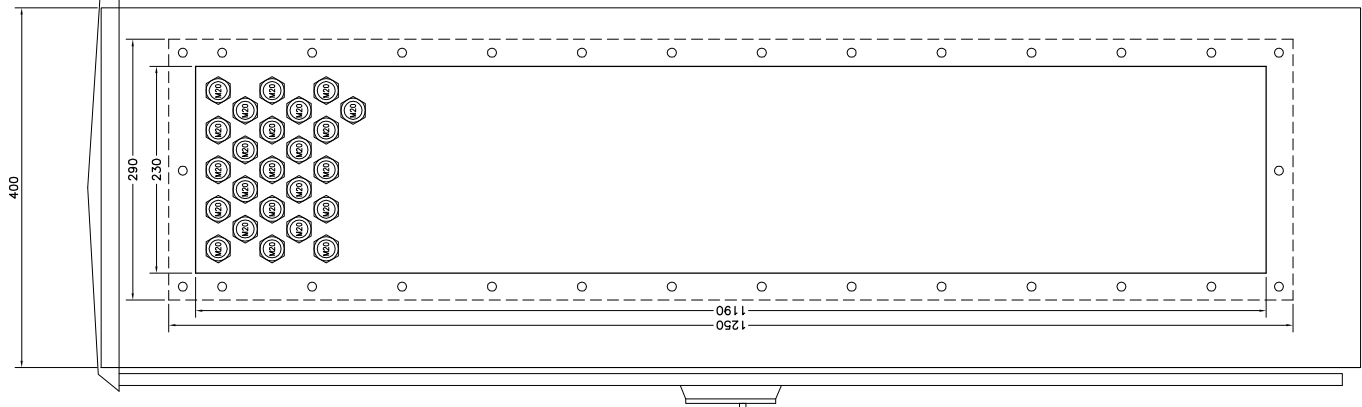

LEFT SIDE VIEW
RIO CABINET – EP1–RIO–002

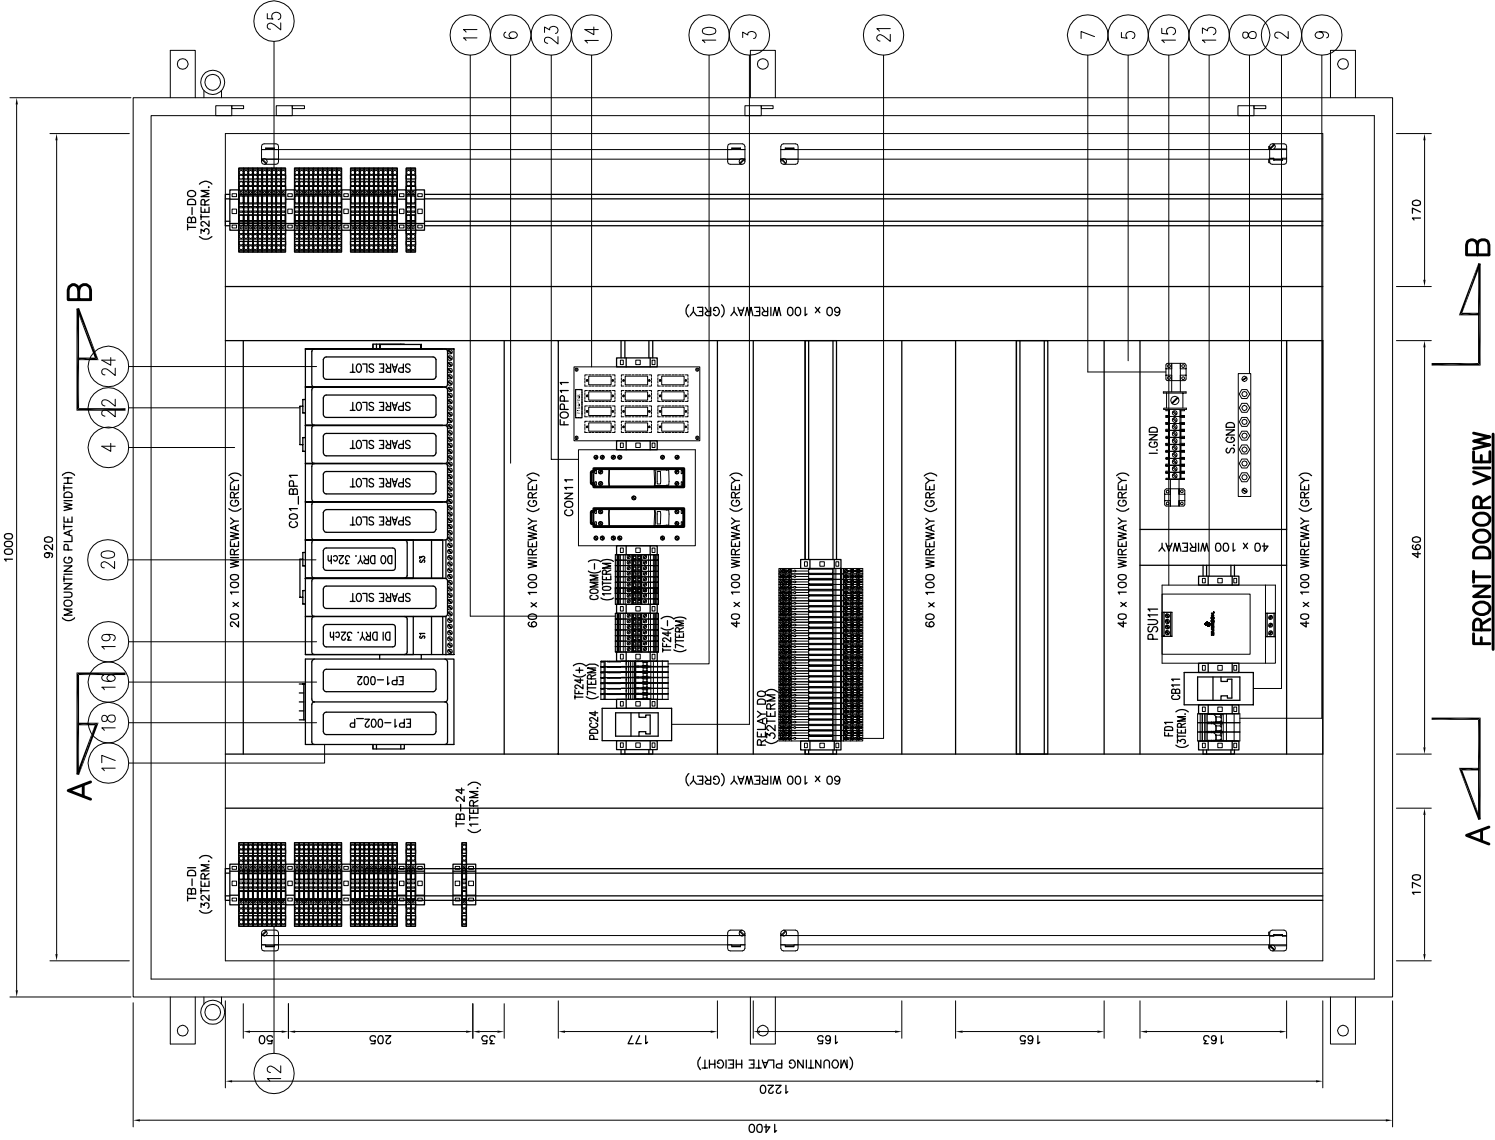

FRONT DOOR VIEW
RIO CABINET – EP1–RIO–002

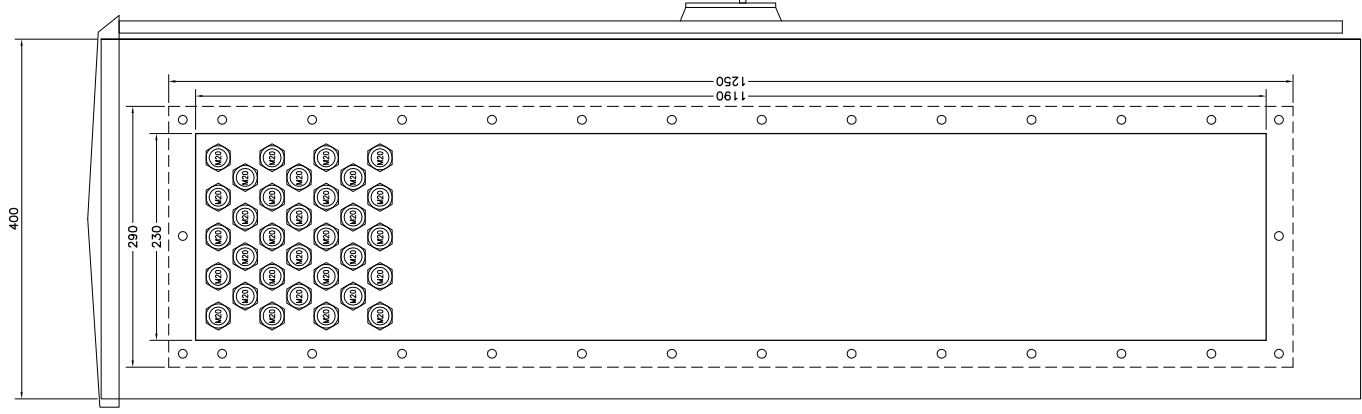

RIGHT SIDE VIEW
RIO CABINET – EP1–RIO–002



PERMIT STAMP AND PROFESSIONAL STAMP
AFFIXED ABOVE SHALL APPLY ONLY TO REV(s)

TITLE: RIO CABINET – EP1-RIO-002 (FRONT VIEW, SECTION A-A & SECTION B-B)		EMERSON DRAWING NO.: 3258585-PSS-PASH-DWG-00031	SHEET NO.: 007
		CUSTOMER DRAWING NO.: —	REV.: 0

BILL OF MATERIALS

ITEM NO.	DESCRIPTION		PART NUMBER	QTY.	MANUFACTURER
01	RIO CABINET (W1000 X H1400 X D400) FRONT ACCESS		NKD-3262869-02	1 SET	GRP INDUSTRIES
02	AC MCB 2POLE (10A)		IK60N C10A	1 PC	SCHNEIDER
03	DC MCB 2POLE (20A)		C60H-DC C20A	1 PC	SCHNEIDER
04	20 X 100 mm PVC WIREWAY (GREY)		-	1 LOT	CONTRACTOR
05	40 X 100 mm PVC WIREWAY (GREY)		-	1 LOT	CONTRACTOR
06	60 X 100 mm PVC WIREWAY (GREY)		-	1 LOT	CONTRACTOR
07	INSTRUMENT GROUND BAR		-	1 LOT	CONTRACTOR
08	SAFETY GROUND BAR		-	1 LOT	CONTRACTOR
09	2-COND THROUGH TERMINAL BLOCK, 10MM SQ		2010-1201	3 PCS	WAGO
10	FUSE DISCONNECT TB WITH FUSE BLOW INDICATOR, 24VDC, 4MM SQ		2004-1611/1000-0541	7 PCS	WAGO
11	2-COND THROUGH TERMINAL BLOCK, 4MM SQ		2004-1201	17 PCS	WAGO
12	DOUBLE DECK DISCONNECT TERMINAL BLOCK, 2.5MM SQ		2002-2671	32 PCS	WAGO
13	END STOPPER		249-117	1 LOT	WAGO
14	FIBER OPTIC PATCH PANEL (BY OTHERS)		TBA	1 PC	TBA
15	DELTAV BULK POWER SUPPLY 100-240 V AC TO 24 V DC, 20A		VE5126	1 PC	EMERSON PROCESS
16	REMOTE INTERFACE UNIT FOR ZONE 2 REMOTE I/O		VE4021	1 PC	EMERSON PROCESS
17	2-WIDE POWER/CONTROLLER CARRIER		VE3051C0	1 PC	EMERSON PROCESS
18	ENHANCED SYSTEM POWER SUPPLY; (DUAL DC/DC) INPUT		VE5009	1 PC	EMERSON PROCESS
19	DISCRETE INPUT CARD: 32 CHANNELS 24 VDC; DRY CONTACT; TERMINATION BLOCK		VE4001S2T2B4	1 PC	EMERSON PROCESS
20	DISCRETE OUTPUT CARD 32 CHANNELS 24 VDC; HIGH SIDE; I/O TERMINATION BLOCK		VE4002S1T2B5	1 PC	EMERSON PROCESS
21	RELAY MODULE PLC-RSC-24DC/21		2966171	32 PCS	PHOENIX CONTACT
22	8-WIDE I/O INTERFACE CARRIER WITH CARRIER SHIELD BAR		VE3051C0	1 PC	EMERSON PROCESS
23	DUAL SINGLE MODE MEDIA CONVERTER ASSEMBLY		VE6060	1 PC	EMERSON PROCESS
24	CARRIER BLANK CAP		VE6101	6 PCS	EMERSON PROCESS
25	DOUBLE DECK FUSE TERMINAL BLOCK WITH INDICATOR, 2.5MM SQ		2002-2611	33 PCS	WAGO
26					
27					
28					



PERMIT STAMP AND PROFESSIONAL STAMP
AFFIXED ABOVE SHALL APPLY ONLY TO REV(s)



EMERSON PROJECT NO.: 3258585
PROJECT TITLE:
DCS SERANG PROJECT

TITLE:
RIO CABINET – EP1-RIO-002
BILL OF MATERIAL

EMERSON DRAWING NO.:
3258585-PSS-PASH-DWG-00031

CUSTOMER DRAWING NO.:
-

SHEET NO:

008

REV:

0