


DOCUMENT STATUS	
FOR INFORMATION	☐
COMMENTED	☐
APPROVED WITH COMMENTS	☐
APPROVED FOR DESIGN/CONSTRUCTION	☐
REJECTED	☐

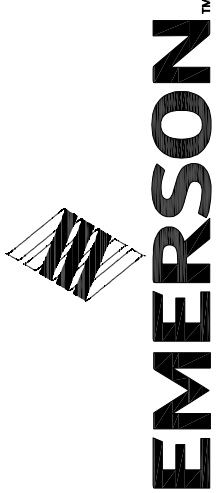

HARDWARE DRAWING - SERVER CABINET


DCS SERANG PROJECT

							CUSTOMER : WILMAR INDUSTRIAL COMPLEX PT MNA SERANG, INDONESIA
							CONTRACT NO. : -
							PROJECT TITLE : DCS SERANG PROJECT
0	AS BUILT	29/08/19	AS/NAM	LKL	MNI		CUSTOMER PROJECT NO. : -
A	ISSUE FOR COMMENT	01/08/18	AS	LKL	MNI		
REV.	DESCRIPTION	DATE	DRAWN BY	CHECKED BY	APPROVED BY		


	PERMIT STAMP AND PROFESSIONAL STAMP AFFIXED ABOVE SHALL APPLY ONLY TO REV(s)		SCALE: NTS UNITS: mm (inch)	SIZE: A3 © 2018	EMERSON PROJECT NO.: 3258585 PROJECT TITLE: DCS SERANG PROJECT	TITLE: COVER SHEET	EMERSON DRAWING NO.: 3258585-PSS-PASH-DWG-00008	SHEET NO: 001
							CUSTOMER DRAWING NO.: -	REV: 0

DRAWING INDEX & REVISION

 
[illegible]

	PERMIT STAMP AND PROFESSIONAL STAMP AFFIXED ABOVE SHALL APPLY ONLY TO REV(s)		SCALE:	NTS	SIZE:	A3	EMERSON PROJECT NO.: 3258585 PROJECT TITLE: DCS SERANG PROJECT	TITLE: DRAWING INDEX & REVISION	EMERSON DRAWING NO.: 3258585-PSS-PASH-DWG-00008	SHEET NO.: 002
			UNITS:	mm (inch)	©	2018				


PLINTH DETAILS FOR CABINET FLOOR MOUNTING

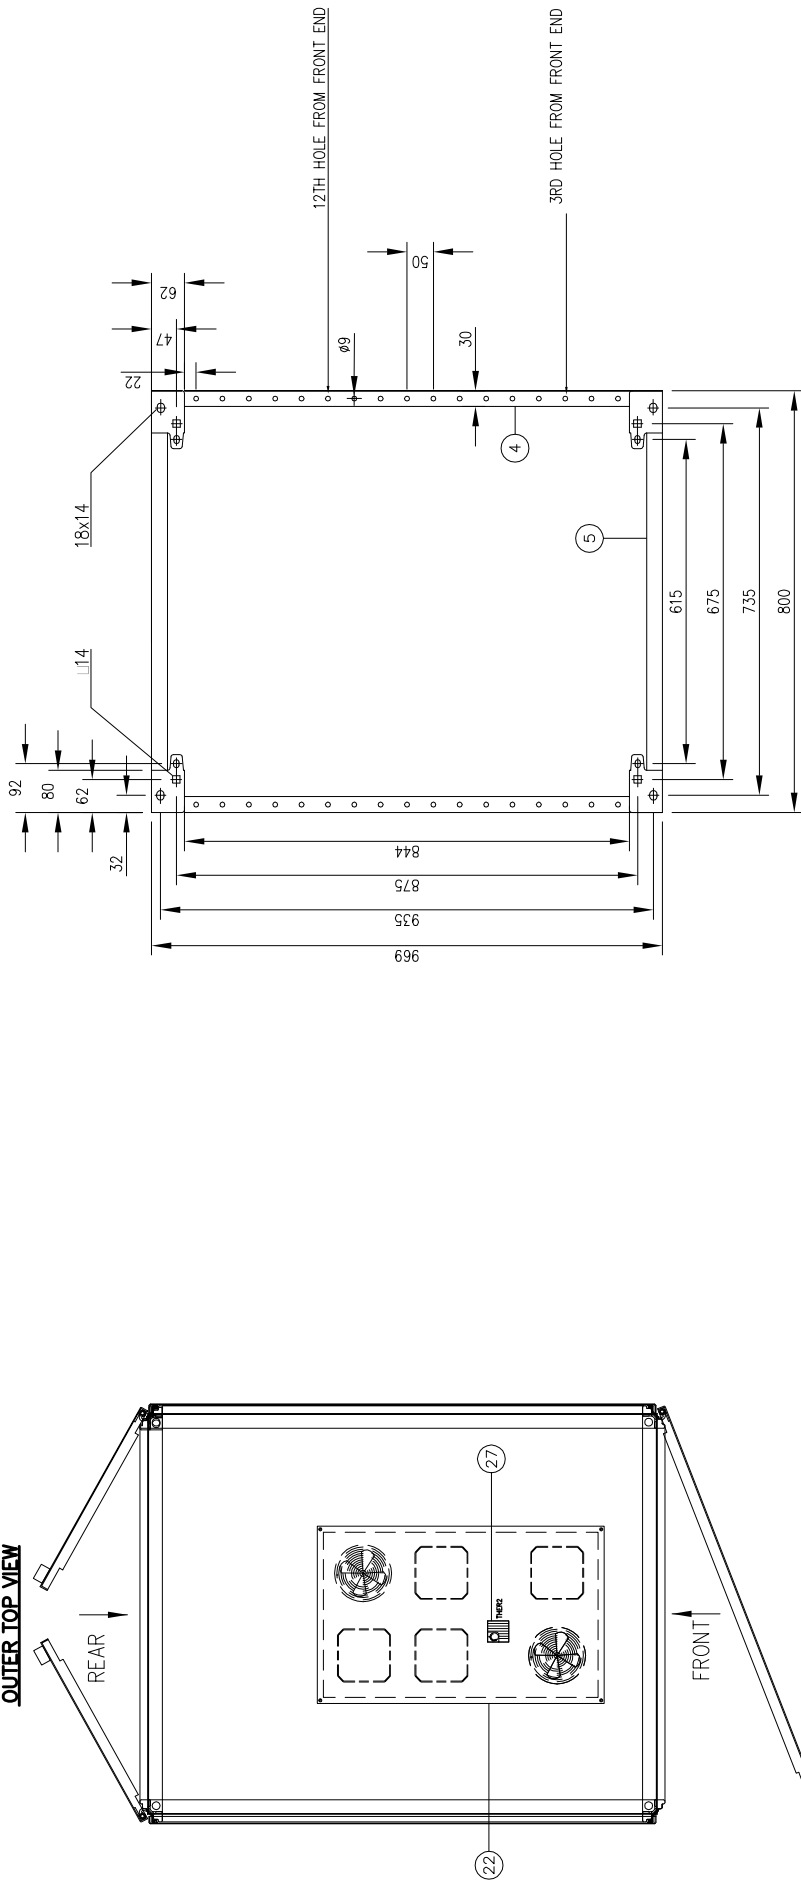

INNER TOP VIEW

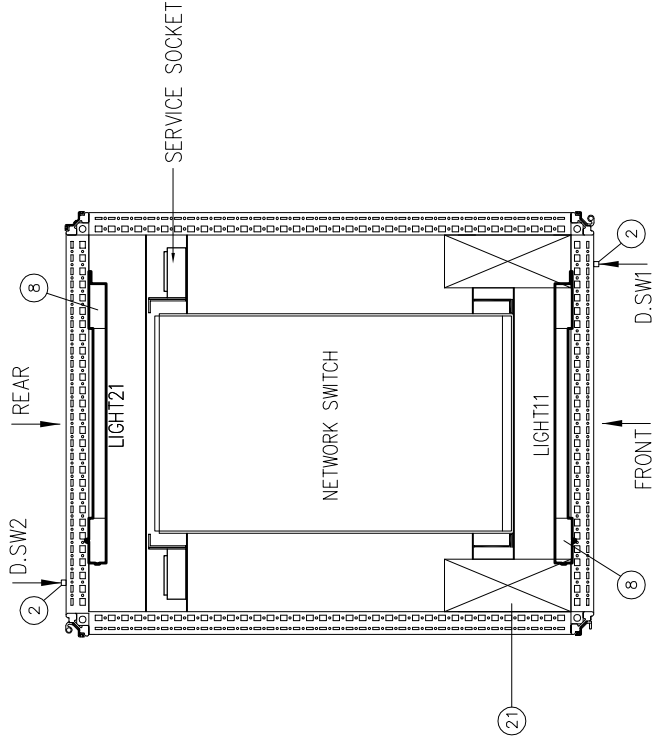

INNER BOTTOM VIEW

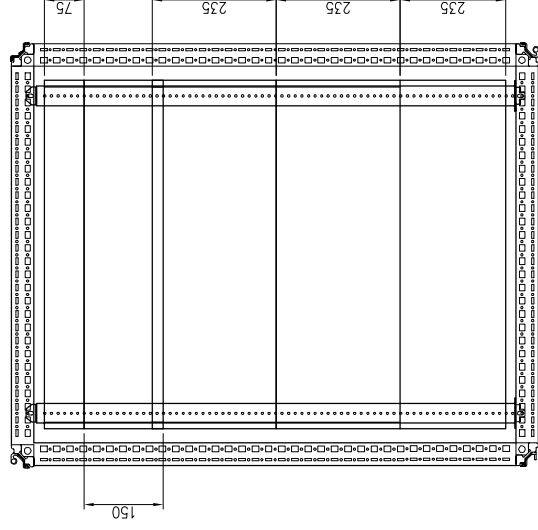

PERMIT STAMP AND PROFESSIONAL STAMP
AFFIXED ABOVE SHALL APPLY ONLY TO REV(S)


EMERSON PROJECT NO.: **3258585**
PROJECT TITLE: **DCS SERANG PROJECT**

TITLE:
SERVER CABINET CCR-SERV-001
PLINTH, OUTER & INNER VIEW

EMERSON DRAWING NO.:
3258585-PSS-PASH-DWG-00008


SHEET NO:
004

REV.:
0

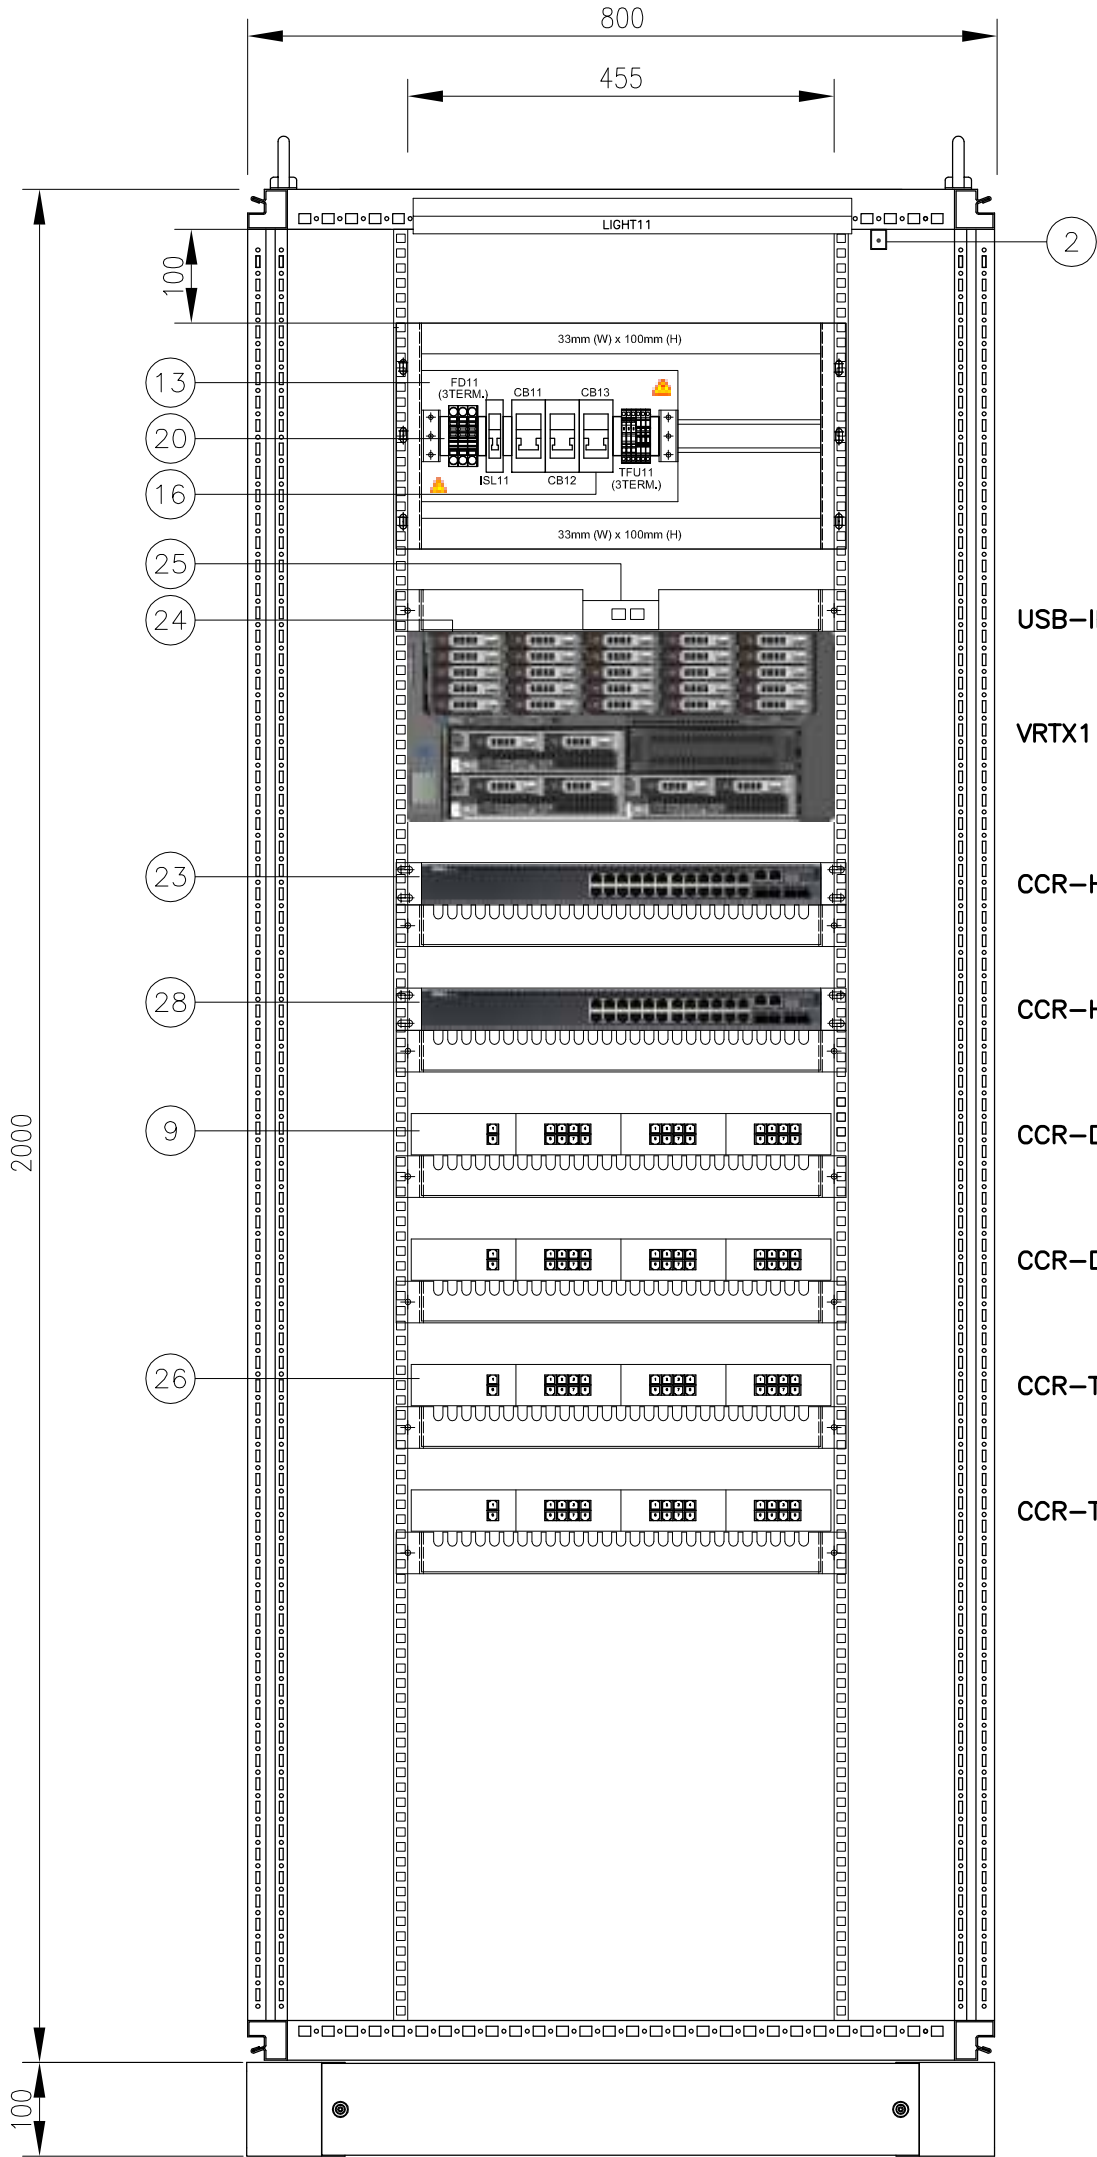

FRONT INSIDE VIEW

					SCALE: NTS	SIZE: A3	EMERSON PROJECT NO.: 3258585 PROJECT TITLE: DCS SERANG PROJECT	TITLE: SERVER CABINET CCR-SERV-001 FRONT VIEW	EMERSON DRAWING NO.: 3258585-PSS-PASH-DWG-00008	SHEET NO: 005
	PERMIT STAMP AND PROFESSIONAL STAMP AFFIXED ABOVE SHALL APPLY ONLY TO REV(s)		UNITS: mm (inch)	© 2018	CUSTOMER DRAWING NO.: —	REV: 0				

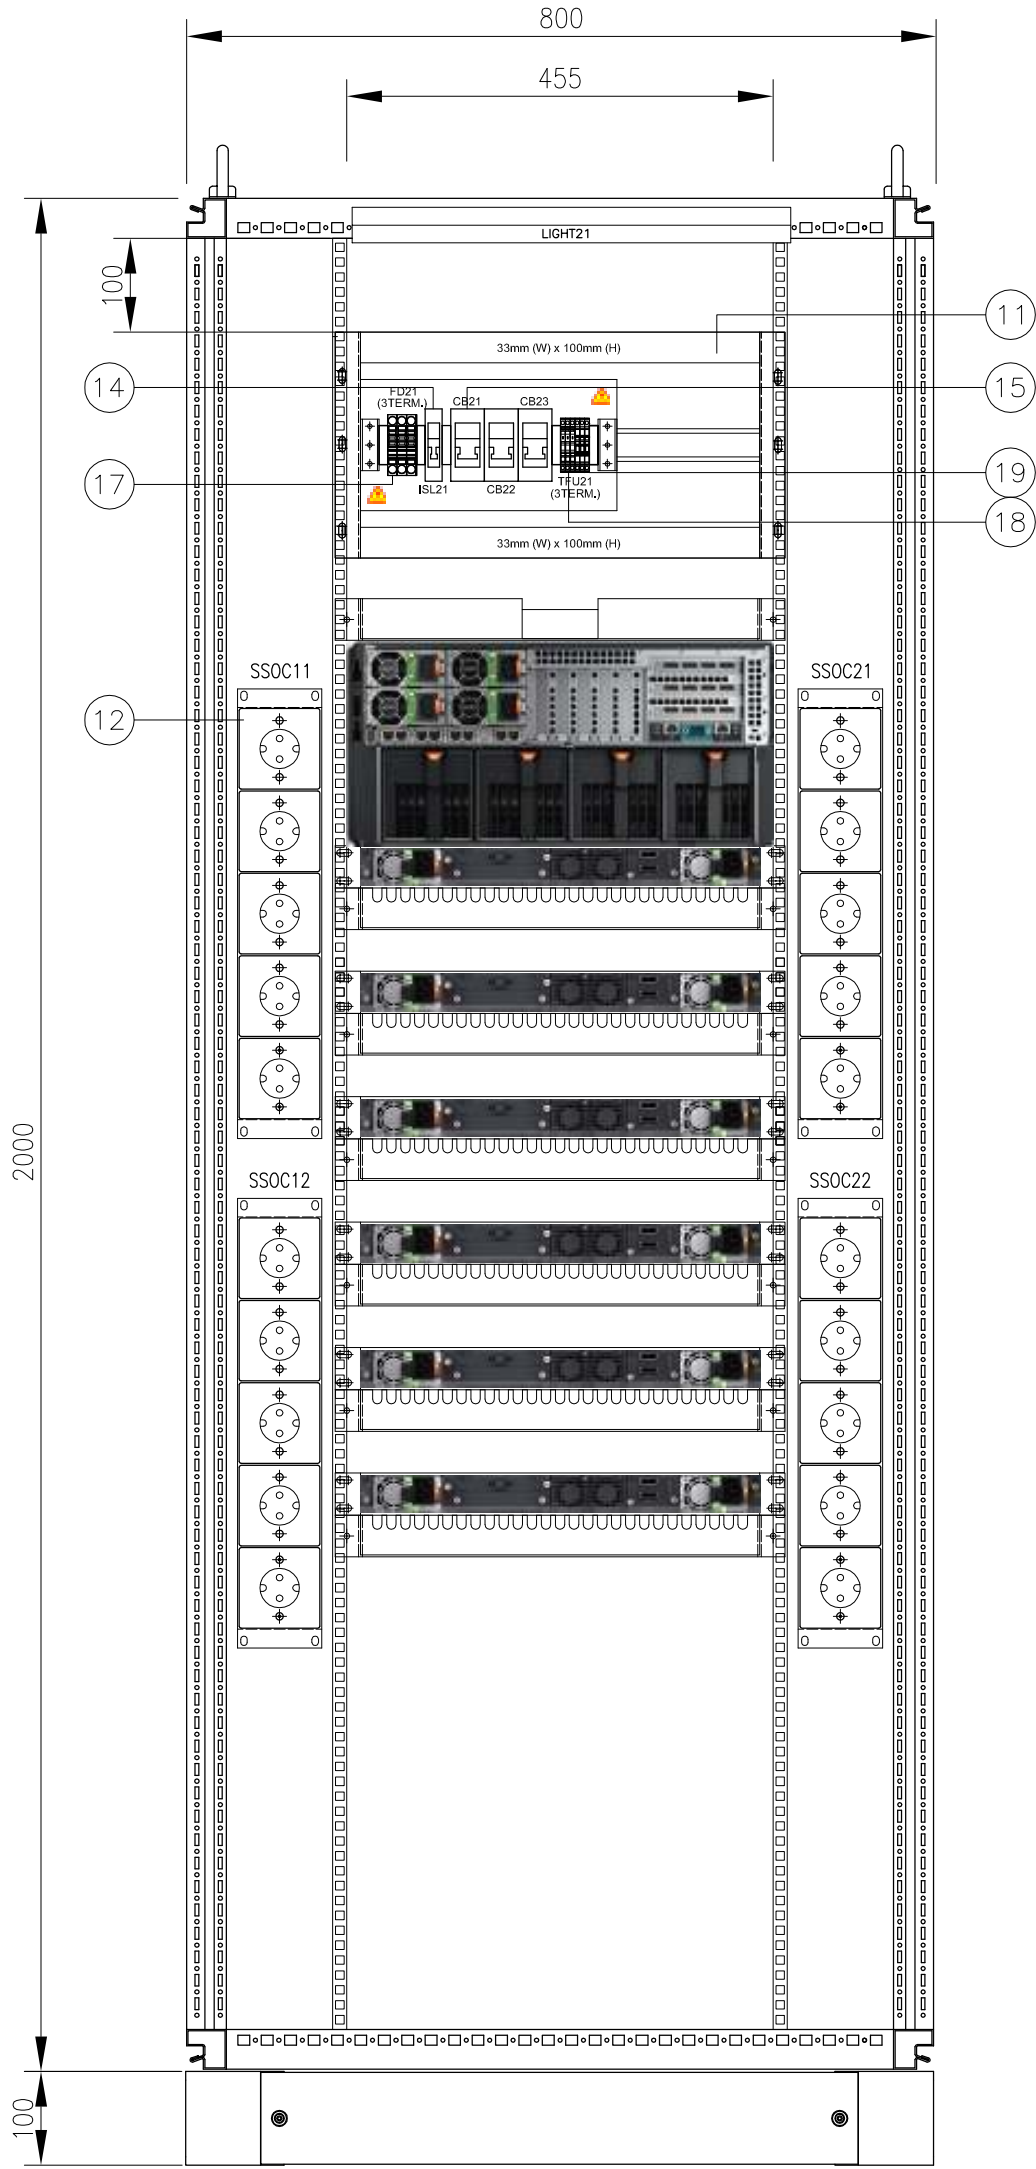

REAR INSIDE VIEW



PERMIT STAMP AND PROFESSIONAL STAMP
AFFIXED ABOVE SHALL APPLY ONLY TO REV(s)

EMERSON PROJECT NO.: 3258585
PROJECT TITLE: DCS SERANG PROJECT

SCALE: NTS
SIZE: A3
UNITS: mm (inch)
© 2018


TITLE: SERVER CABINET CCR-SERV-001
REAR VIEW

EMERSON DRAWING NO.: 3258585-PSS-PASH-DWG-00008
CUSTOMER DRAWING NO.: -

SHEET NO: 006
REV: 0

FRONT →

21

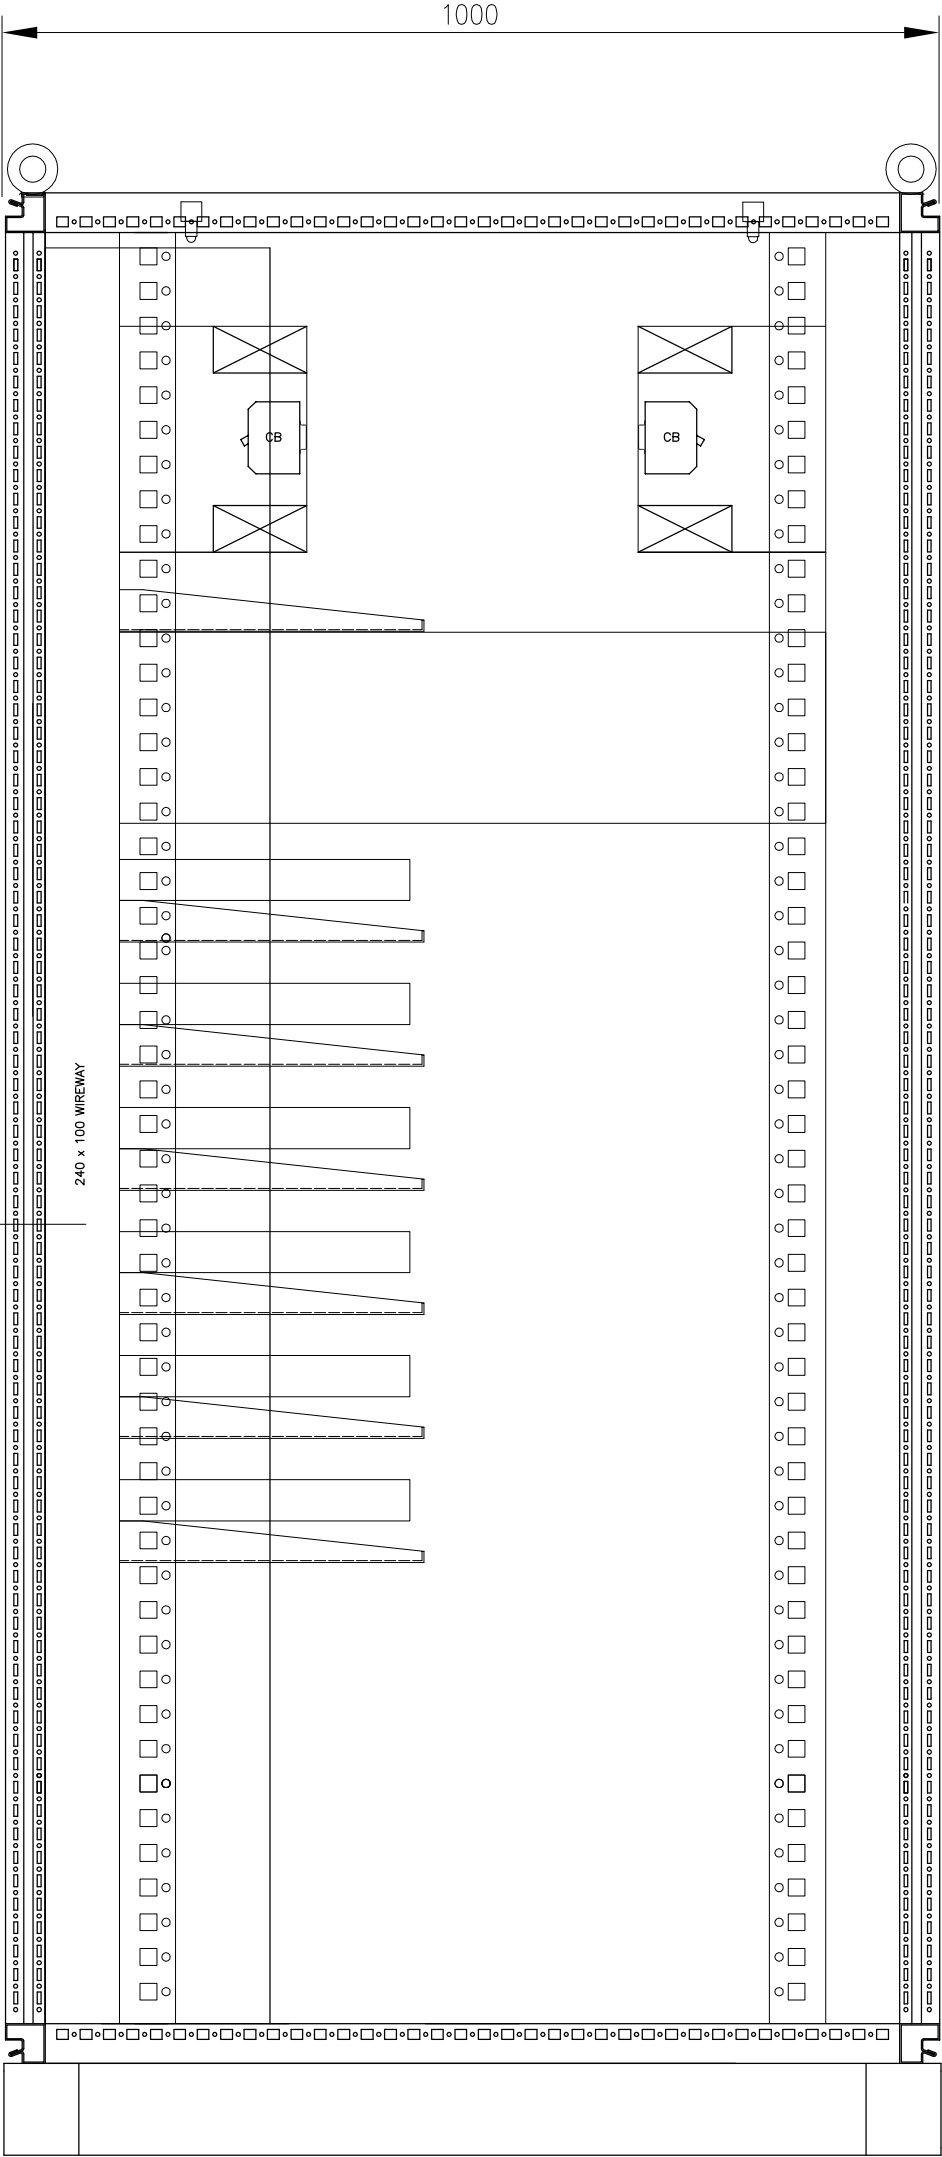

LEFT INSIDE VIEW



PERMIT STAMP AND PROFESSIONAL STAMP
AFFIXED ABOVE SHALL APPLY ONLY TO REV(S)

EMERSON PROJECT NO.: 3258585
PROJECT TITLE:
DCS SERANG PROJECT

SCALE: NTS
UNITS: mm (inch)
SIZE: A3
2018

TITLE:
SERVER CABINET CCR-SERV-001
SIDE VIEW
(SECTION A-A)

EMERSON DRAWING NO.: 3258585-PSS-PASH-DWG-00008
CUSTOMER DRAWING NO.: -

SHEET NO: 007
REV: 0

BILL OF MATERIALS

ITEM NO.	DESCRIPTION	PART NUMBER	QTY.	MANUFACTURER
01	RITTAL CABINET (W800mmxD1000mmxH2000mm) FRONT AND REAR ACCESS	DK7830.230	1 SET	RITTAL
02	DOOR LIMIT SWITCH	SZ4315.520	2 PCS	RITTAL
03	THERMOSTAT	SK3110.000	1 PC	RITTAL
04	BASE PLINTH	TS8601.802	1 SET	RITTAL
05	TRIM PLINTH	TS8601.080	1 SET	RITTAL
06	COMFORT HANDLE FOR DOORS, RAL 7035	TS8611.020	2 PCS	RITTAL
07	PUSH BUTTON AND LOCK INSERT FOR HANDLE	TS8611.200	2 PCS	RITTAL
08	LED LIGHTING 240VAC	-	2 PCS	STD. MAKE
09	SMART 8-POR1,2-SFP SWITCH; 19-INCH RACK MOUNT	VE6048R1P3	2 PCS	EMERSON PROCESS
10	P.E GROUND	-	1 PC	STD. MAKE
11	33 X 100 MM PVC WIREWAY (GREY)	-	1 LOT	STD. MAKE
12	AC 2 PIN SOCKET (1 GROUP = 5 PCS)	-	4 GRP	STD. MAKE
13	PROTECTION COVER	PLEXIGLASS	2 PCS	STD. MAKE
14	SCHNEIDER 2P (32A) ISOLATOR	A9S-60232	2 PCS	SCHNEIDER
15	SCHNEIDER 60N, 10A (6kA) CIRCUIT BREAKER (MCB)	A9F-74210	4 PCS	SCHNEIDER
16	SCHNEIDER 60N, 6A (6kA) CIRCUIT BREAKER (MCB)	A9F-76606	2 PCS	SCHNEIDER
17	2-COND THROUGH TERMINAL BLOCK, 10MM SQ	2010-1201	6 PCS	WAGO
18	FUSE DISCONNECT TB WITH FUSE BLOW INDICATOR, 240VAC, 2.5MM SQ (GREY)	2002-1611/1000-836	6 PCS	WAGO
19	DISCONNECT TERMINAL BLOCK, 2.5 MM SQ (GREY)	2002-1671	6 PCS	WAGO
20	END CLAMP (STOPPER)	249-117	10 SET	WAGO
21	CABLE DUCT 42U RAL9005	TS5502.105	2 SET	RITTAL
22	ROOF FAN MODULE TS IT, MAX 6 FAN, RAL7035	DK3139.100	1 SET	RITTAL
23	DELL NETWORKING N3024; SWITCH; 24 PORTS; MANAGED; RACK MOUNTABLE	SE6047V2P1	1 PC	DELL
24	DELL POWEREDGE VRTX SHARED INFRASTRUCTURE PLATFORM	SE2528V2B	1 PC	DELL
25	DELTAV USB TO IP CONVERTER [SEH MYUTN-50A USB DEVICE SERVER] WITH RACK KIT	VE6051P2	1 PC	EMERSON
26	SERIES MODULAR MANAGED ETHERNET SWITCH	ISM3028U	2 PCS	INHAND
27	HYGROSTAT SWITCH (HIMUDITY MONITORING)	SK3118.000	1 PC	RITTAL
28	DELL N1108T-ON	N1108T-ON	1 PC	DELL
29				
30				
31				
32				
33				
34				



PERMIT STAMP AND PROFESSIONAL STAMP
 AFFIXED ABOVE SHALL APPLY ONLY TO REV(s)

EMERSON PROJECT NO.: 3258585
 PROJECT TITLE:
 DCS SERANG PROJECT

SCALE: NTS
 SIZE: A3
 UNITS: mm (inch) 2018

TITLE:
 SERVER CABINET CCR-SERV-001
 BILL OF MATERIALS

EMERSON DRAWING NO.: 3258585-PSS-PASH-DWG-00008


SHEET NO: 009
 REV.: 0




THIS DRAWING IS THE PROPERTY OF EMERSON PROCESS MANAGEMENT. INFORMATION AND KNOW-HOW HEREIN ARE CONFIDENTIAL AND MAY NOT BE USED, REPRODUCED OR REVEALED TO OTHERS EXCEPT IN ACCORDANCE WITH CONTRACT OR OTHER WRITTEN CONSENT OF EMERSON PROCESS MANAGEMENT. ANY PERMITTED REPRODUCTION IN WHOLE OR IN PART, INCLUDING SHOP DRAWINGS MUST BEAR OR REFER TO THIS LEGEND.




THIS DRAWING IS THE PROPERTY OF EMERSON PROCESS MANAGEMENT. INFORMATION AND KNOW-HOW HEREIN ARE CONFIDENTIAL AND MAY NOT BE USED, REPRODUCED OR REVEALED TO OTHERS EXCEPT IN ACCORDANCE WITH CONTRACT OR OTHER WRITTEN CONSENT OF EMERSON PROCESS MANAGEMENT. ANY PERMITTED REPRODUCTION IN WHOLE OR IN PART, INCLUDING SHOP DRAWINGS MUST BEAR OR REFER TO THIS LEGEND.

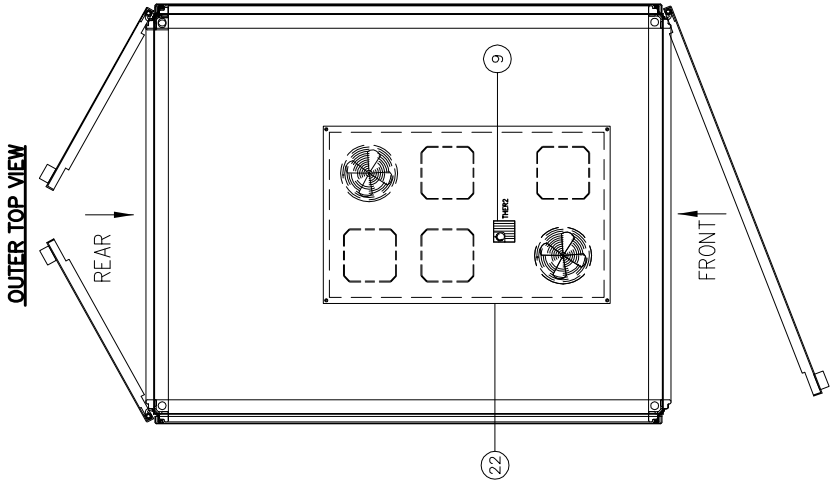


PLINTH DETAILS FOR CABINET FLOOR MOUNTING

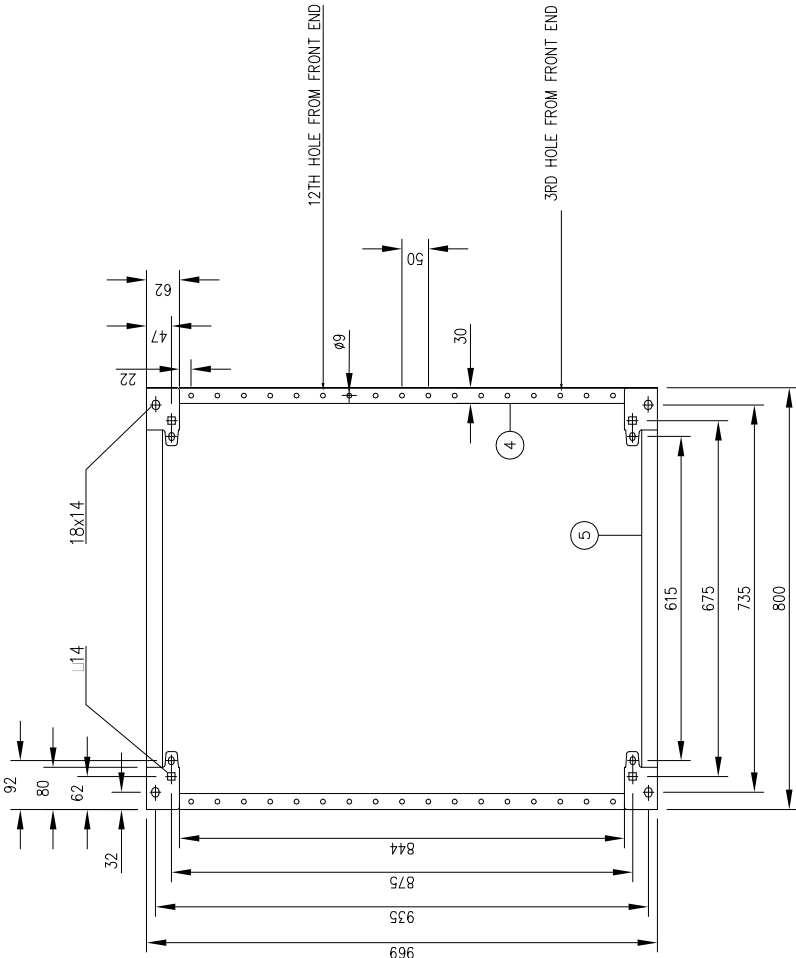

INNER TOP VIEW

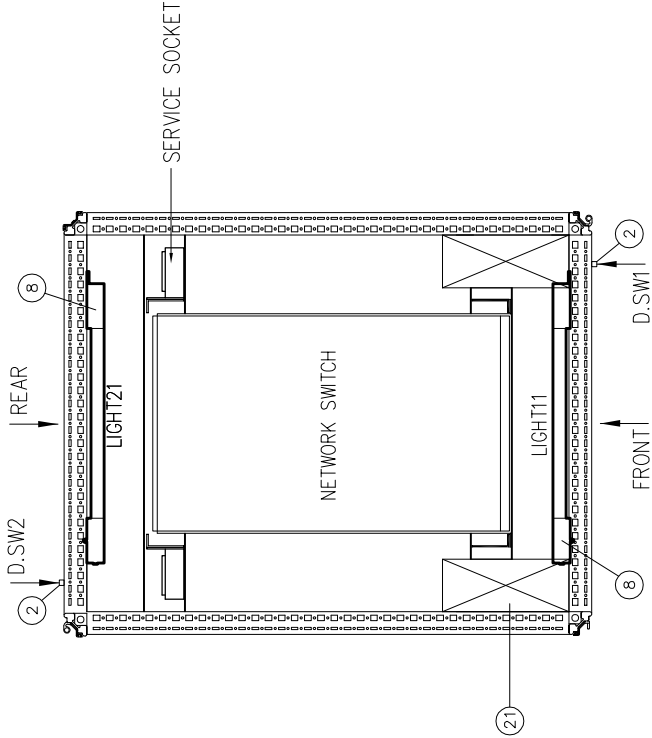

INNER BOTTOM VIEW

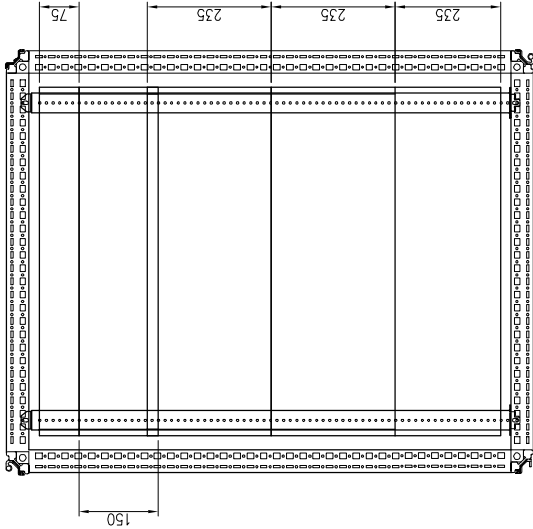

PERMIT STAMP AND PROFESSIONAL STAMP
AFFIXED ABOVE SHALL APPLY ONLY TO REV(S)


EMERSON PROJECT NO.: **3258585**
PROJECT TITLE:
DCS SERANG PROJECT

SCALE: **NTS** SIZE: **A3**
UNITS: **mm (inch)** © **2018**

TITLE:
SERVER CABINET CR3-SERV-001
PLINTH, OUTER & INNER VIEW

EMERSON DRAWING NO.: **3258585-PSS-PASH-DWG-00008**
CUSTOMER DRAWING NO.: **-**

SHEET NO.: **013**
REV.: **0**

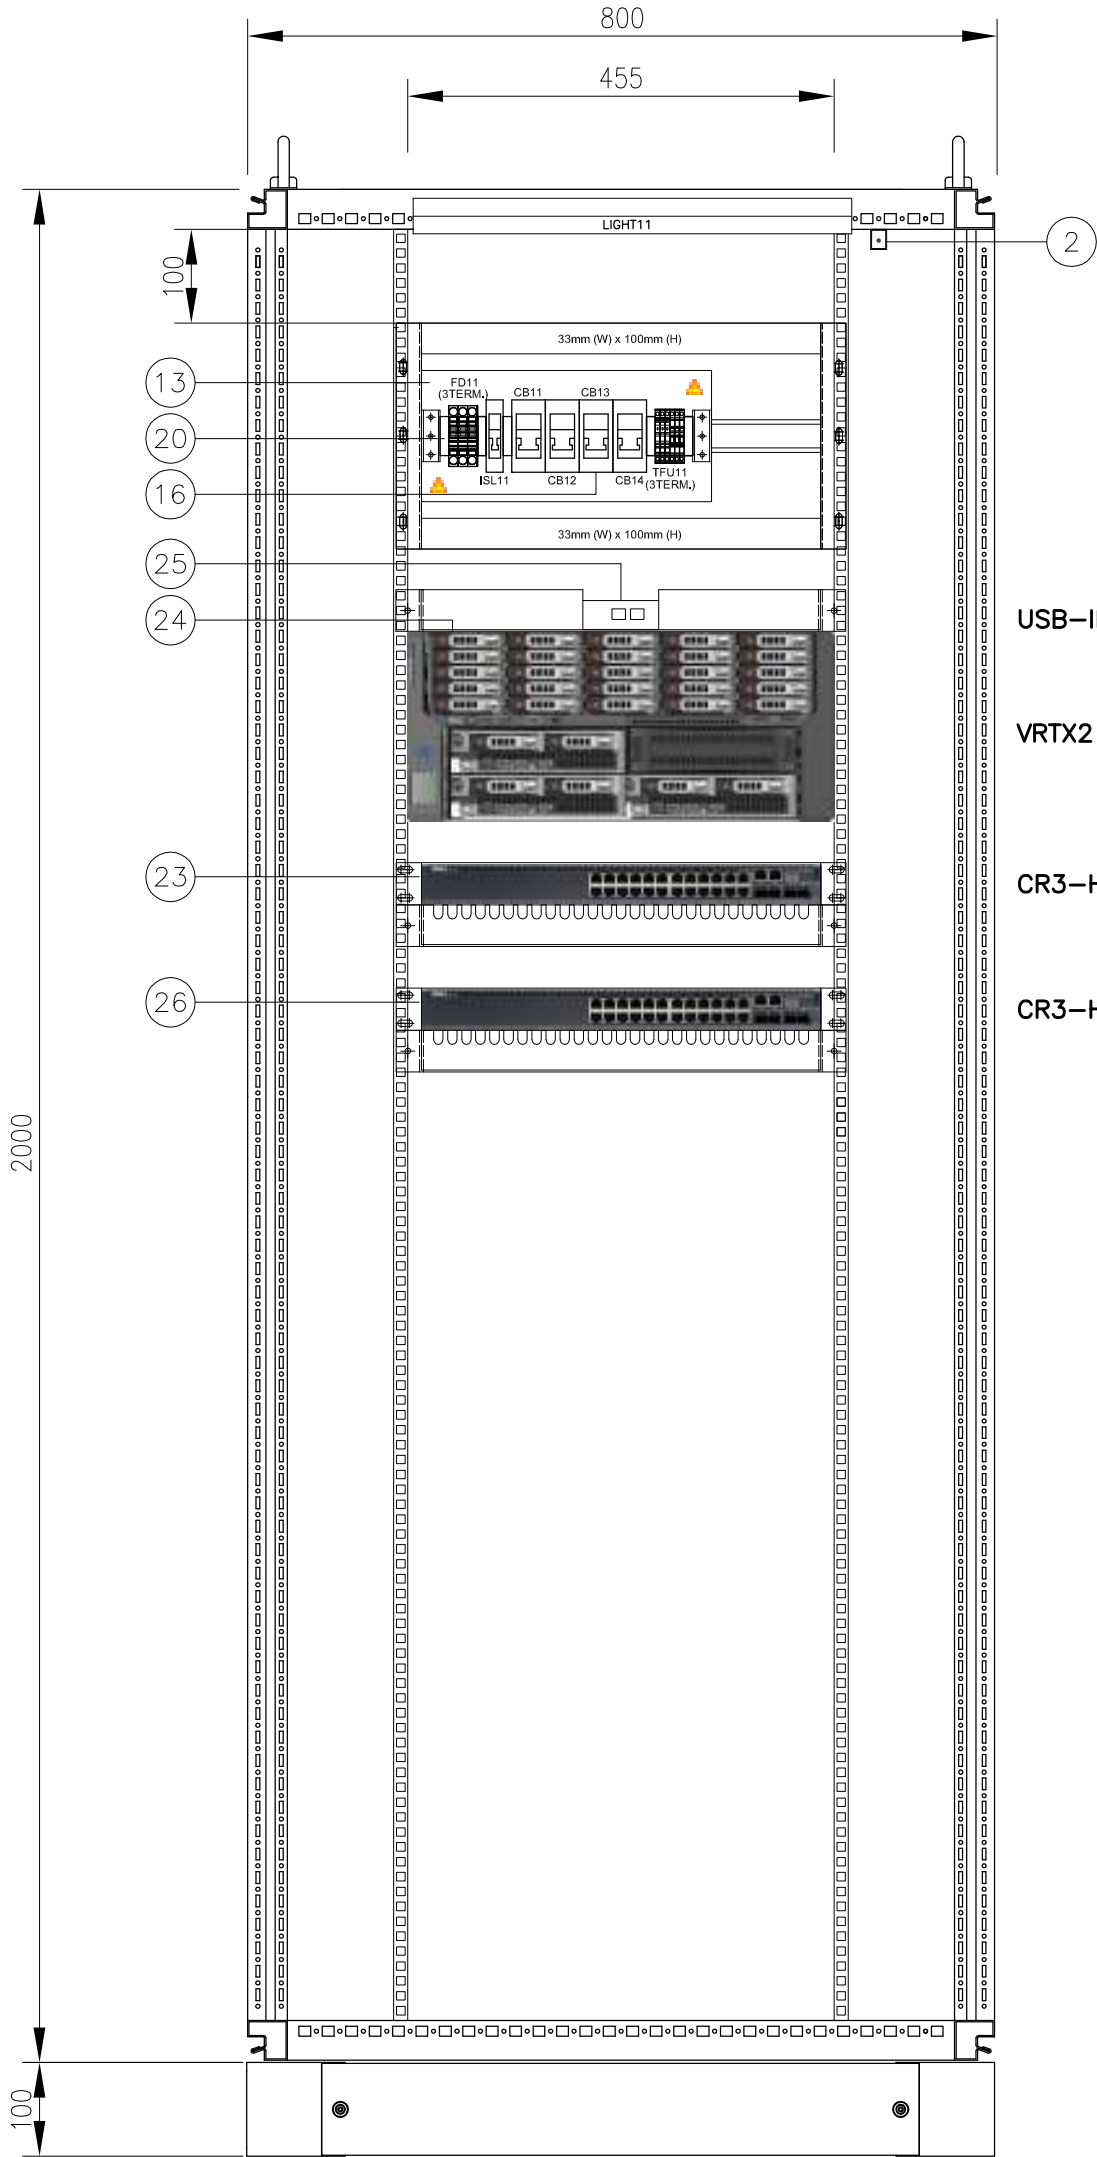

FRONT INSIDE VIEW


USB-IP CONVERTER

VRTX2

CR3-HM-021

CR3-HM-012

	PERMIT STAMP AND PROFESSIONAL STAMP AFFIXED ABOVE SHALL APPLY ONLY TO REV(s)		 EMERSON.	SCALE: NTS	SIZE: A3	EMERSON PROJECT NO.: 3258585 PROJECT TITLE: DCS SERANG PROJECT	TITLE: SERVER CABINET CR3-SERV-001 FRONT VIEW	EMERSON DRAWING NO.: 3258585-PSS-PASH-DWG-00008	SHEET NO: 014
	UNITS: mm (inch)	2018		CUSTOMER DRAWING NO.: —	REV.: 0				

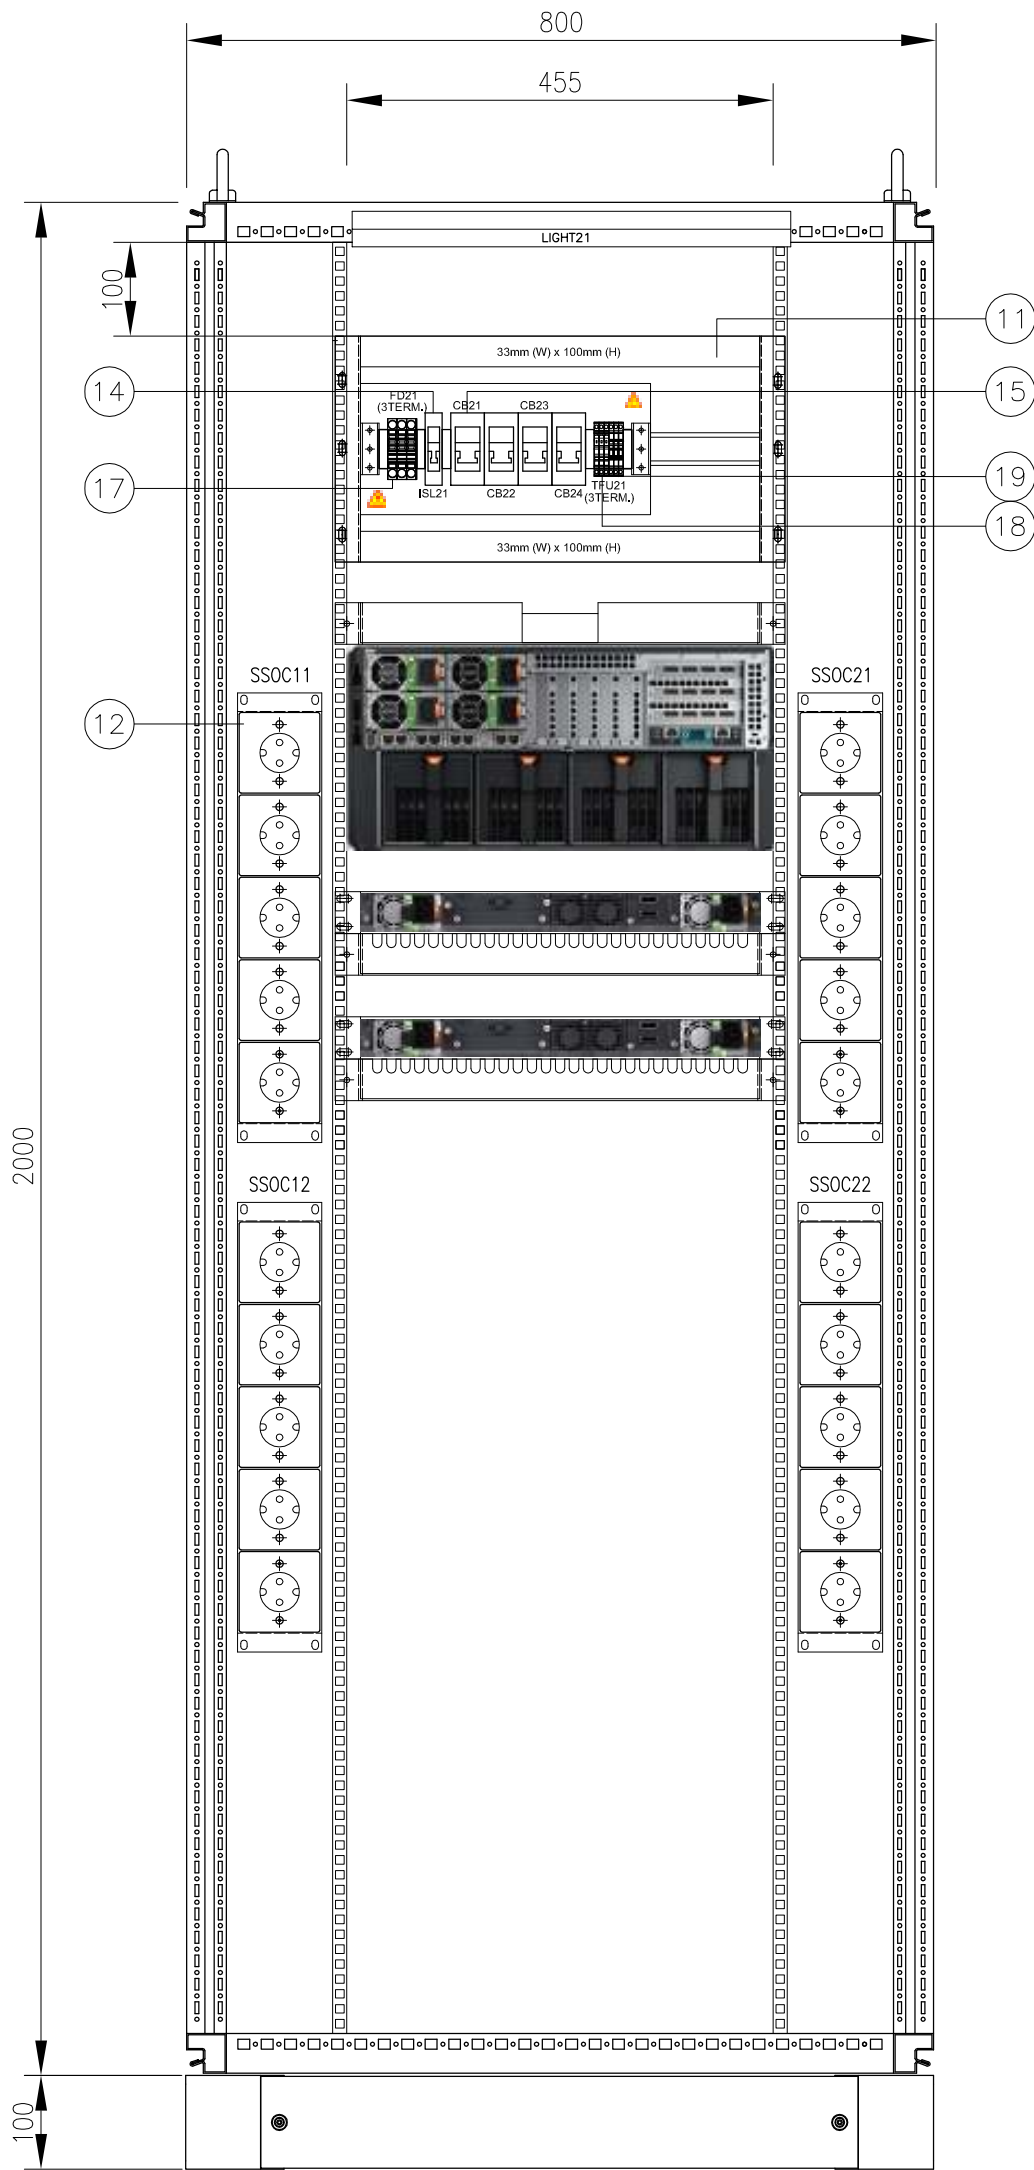


REAR INSIDE VIEW

	PERMIT STAMP AND PROFESSIONAL STAMP AFFIXED ABOVE SHALL APPLY ONLY TO REV(s)		 EMERSON.	SCALE: NTS	SIZE: A3	EMERSON PROJECT NO.: 3258585 PROJECT TITLE: DCS SERANG PROJECT	TITLE: SERVER CABINET CR3-SERV-001 REAR VIEW	EMERSON DRAWING NO.: 3258585-PSS-PASH-DWG-00008	SHEET NO: 015
				UNITS: mm (inch)	© 2018				

FRONT →

21

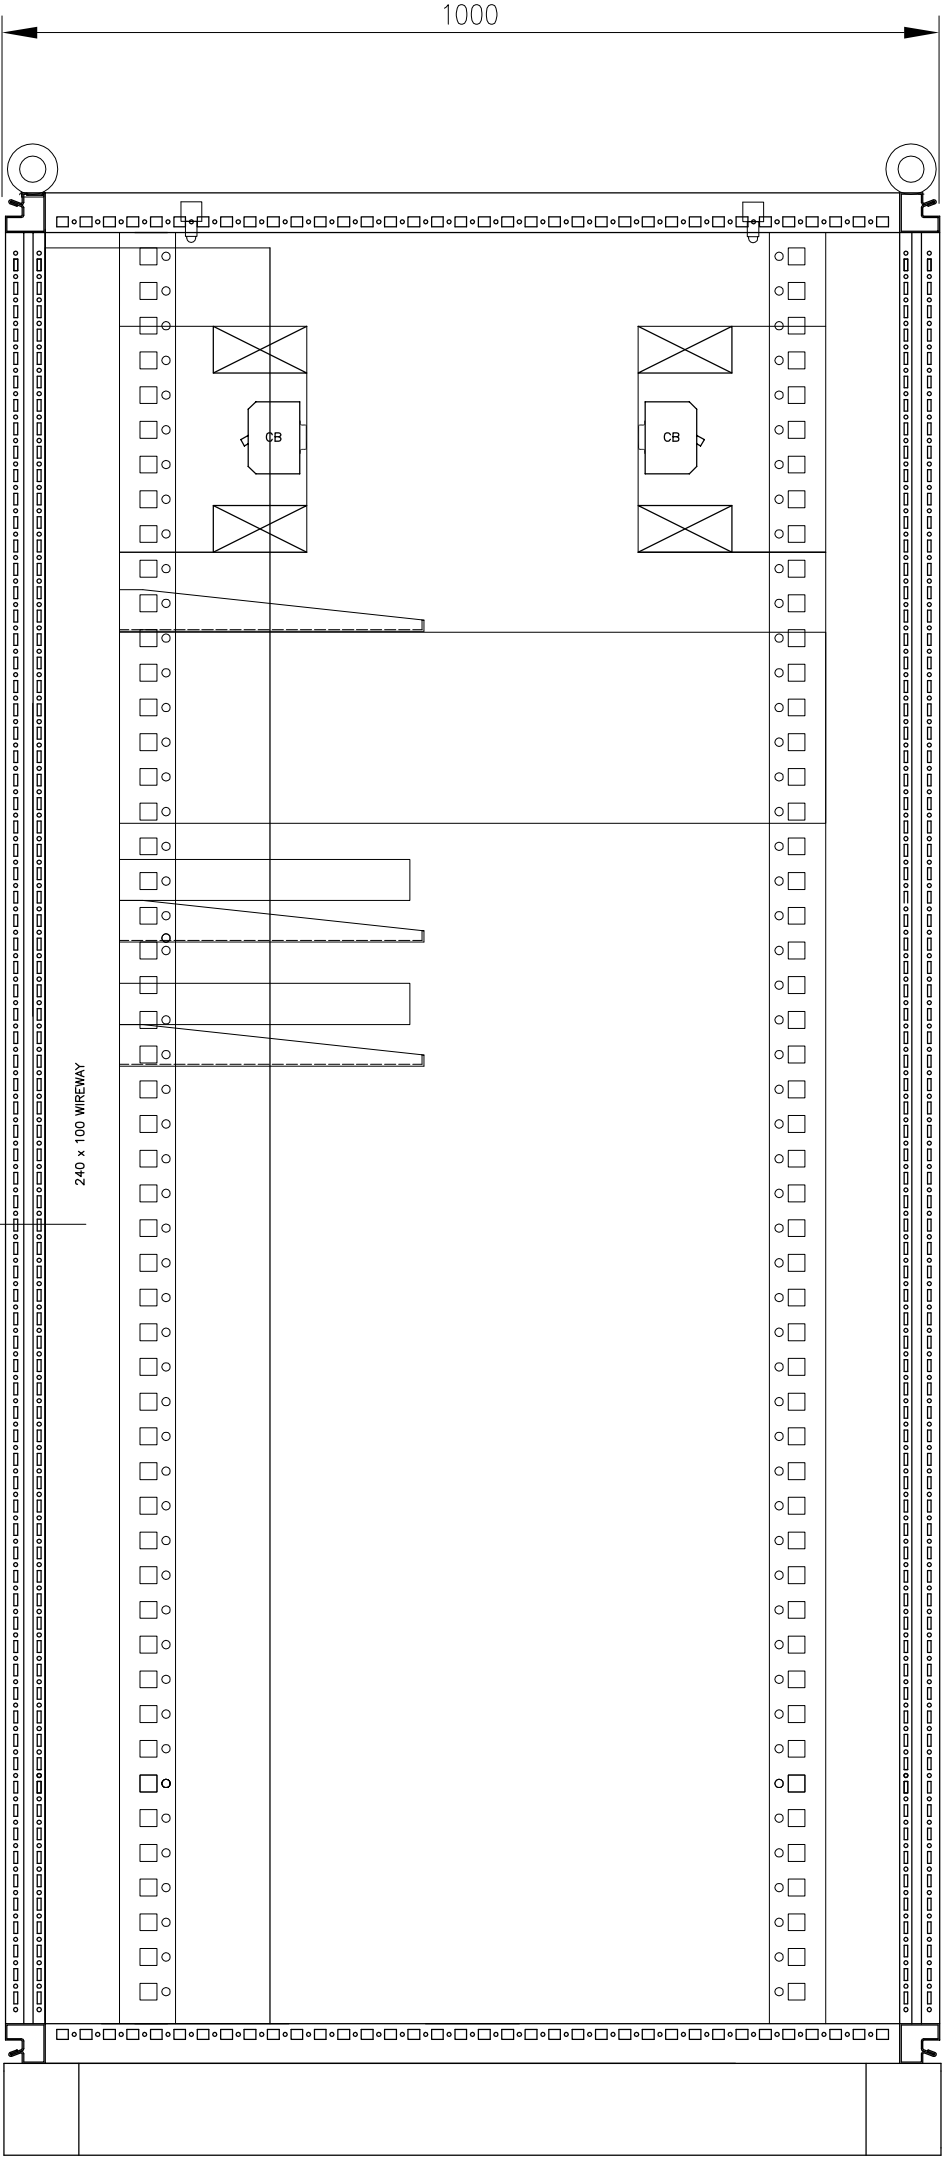

LEFT INSIDE VIEW



PERMIT STAMP AND PROFESSIONAL STAMP
AFFIXED ABOVE SHALL APPLY ONLY TO REV(S)

EMERSON PROJECT NO.: 3258585
PROJECT TITLE:
DCS SERANG PROJECT

SCALE: NTS
SIZE: A3
UNITS: mm (inch)
2018

TITLE:
SERVER CABINET CR3-SERV-001
SIDE VIEW
(SECTION A-A)

EMERSON DRAWING NO.: 3258585-PSS-PASH-DWG-00008
CUSTOMER DRAWING NO.: -

SHEET NO: 016
REV: 0



BILL OF MATERIALS

ITEM NO.	DESCRIPTION	PART NUMBER	QTY.	MANUFACTURER
01	RITTAL CABINET (W800mmxD1000mmxH2000mm) FRONT AND REAR ACCESS	DK7830.230	1 SET	RITTAL
02	DOOR LIMIT SWITCH	SZ4315.520	2 PCS	RITTAL
03	THERMOSTAT	SK3110.000	1 PC	RITTAL
04	BASE PLINTH	TS8601.802	1 SET	RITTAL
05	TRIM PLINTH	TS8601.080	1 SET	RITTAL
06	COMFORT HANDLE FOR DOORS, RAL 7035	TS8611.020	2 PCS	RITTAL
07	PUSH BUTTON AND LOCK INSERT FOR HANDLE	TS8611.200	2 PCS	RITTAL
08	LED LIGHTING 240VAC	-	2 PCS	STD. MAKE
09	HYGROSTAT SWITCH (HUMIDITY MONITORING)	SK3118.000	1 PC	RITTAL
10	P.E GROUND	-	1 PC	STD. MAKE
11	33 X 100 MM PVC WIREWAY (GREY)	-	1 LOT	STD. MAKE
12	AC 2 PIN SOCKET (1 GROUP = 5 PCS)	-	4 GRP	STD. MAKE
13	PROTECTION COVER	PLEXIGLASS	2 PCS	STD. MAKE
14	SCHNEIDER 2P (32A) ISOLATOR	A9S-60232	2 PCS	SCHNEIDER
15	SCHNEIDER 60N, 10A (6kA) CIRCUIT BREAKER (MCB)	A9F-74210	4 PCS	SCHNEIDER
16	SCHNEIDER 60N, 6A (6kA) CIRCUIT BREAKER (MCB)	A9F-76606	2 PCS	SCHNEIDER
17	2-COND THROUGH TERMINAL BLOCK, 10MM SQ	2010-1201	6 PCS	WAGO
18	FUSE DISCONNECT TB WITH FUSE BLOW INDICATOR, 240VAC, 2.5MM SQ (GREY)	2002-1611/1000-836	6 PCS	WAGO
19	DISCONNECT TERMINAL BLOCK, 2.5 MM SQ (GREY)	2002-1671	6 PCS	WAGO
20	END CLAMP (STOPPER)	249-117	14 SET	WAGO
21	CABLE DUCT 42U RAL9005	TS5502.105	2 SET	RITTAL
22	ROOF FAN MODULE TS IT, MAX 6 FAN, RAL7035	DK3139.100	1 SET	RITTAL
23	DELL NETWORKING N3024; SWITCH; 24 PORTS; MANAGED; RACK MOUNTABLE	SE6047V2P1	1 PC	DELL
24	DELL POWEREDGE VRTX SHARED INFRASTRUCTURE PLATFORM	SE2528V2B	1 PC	DELL
25	DELTAV USB TO IP CONVERTER [SEH MYUTN-50A USB DEVICE SERVER] WITH RACK KIT	VE6051P2	1 PC	EMERSON
26	DELL N1108T-ON	N1108T-ON	1 PC	DELL
27				
28				
29				
30				
31				
32				
33				
34				



PERMIT STAMP AND PROFESSIONAL STAMP
 AFFIXED ABOVE SHALL APPLY ONLY TO REV(s)

EMERSON PROJECT NO.: 3258585
 PROJECT TITLE:
 DCS SERANG PROJECT

TITLE:
 SERVER CABINET CR3-SERV-001
 BILL OF MATERIALS

EMERSON DRAWING NO.:
 3258585-PSS-PASH-DWG-00008


SHEET NO.:
 018

CUSTOMER DRAWING NO.:
 -

REV.:
 0



THIS DRAWING IS THE PROPERTY OF EMERSON PROCESS MANAGEMENT. INFORMATION AND KNOW-HOW HEREIN ARE CONFIDENTIAL AND MAY NOT BE USED, REPRODUCED OR REVEALED TO OTHERS EXCEPT IN ACCORDANCE WITH CONTRACT OR OTHER WRITTEN CONSENT OF EMERSON PROCESS MANAGEMENT. ANY PERMITTED REPRODUCTION IN WHOLE OR IN PART, INCLUDING SHOP DRAWINGS MUST BEAR OR REFER TO THIS LEGEND.

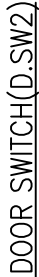

THIS DRAWING IS THE PROPERTY OF EMERSON PROCESS MANAGEMENT. INFORMATION AND KNOW-HOW HEREIN ARE CONFIDENTIAL AND MAY NOT BE USED, REPRODUCED OR REVEALED TO OTHERS EXCEPT IN ACCORDANCE WITH CONTRACT OR OTHER WRITTEN CONSENT OF EMERSON PROCESS MANAGEMENT. ANY PERMITTED REPRODUCTION IN WHOLE OR IN PART, INCLUDING SHOP DRAWINGS MUST BEAR OR REFER TO THIS LEGEND.