


AS BUILT DRAWING FRACTINATION PLANT

NO	TITLE	NO. DRAWING
1	INSTALLATION LIGHTING	FRAC-EI-DWG-AD-IL-01-09
2	LAYOUT CABLE LADDER	FRAC-EI-DWG-AD-CL-01-07
3	LAYOUT PANEL RIO	FRAC-EI-DWG-AD-LP-01-04
4	LAYOUT CCTV	FRAC-EI-DWG-AD-CC-01-04
5	LAYOUT ACCESS DOOR	FRAC-EI-DWG-AD-AD-01-01
6	LAYOUT ACCESS POINT	FRAC-EI-DWG-AD-AP-01-03
7	LAYOUT IPOS	FRAC-EI-DWG-AD-RC-01-03
8	LAYOUT REMOTE PANEL	FRAC-EI-DWG-AD-LP-01-01
9	LAYOUT GROUNDING	FRAC-EI-DWG-AD-GRD-01-02
10	GENERAL ARRANGEMENT PANEL	-



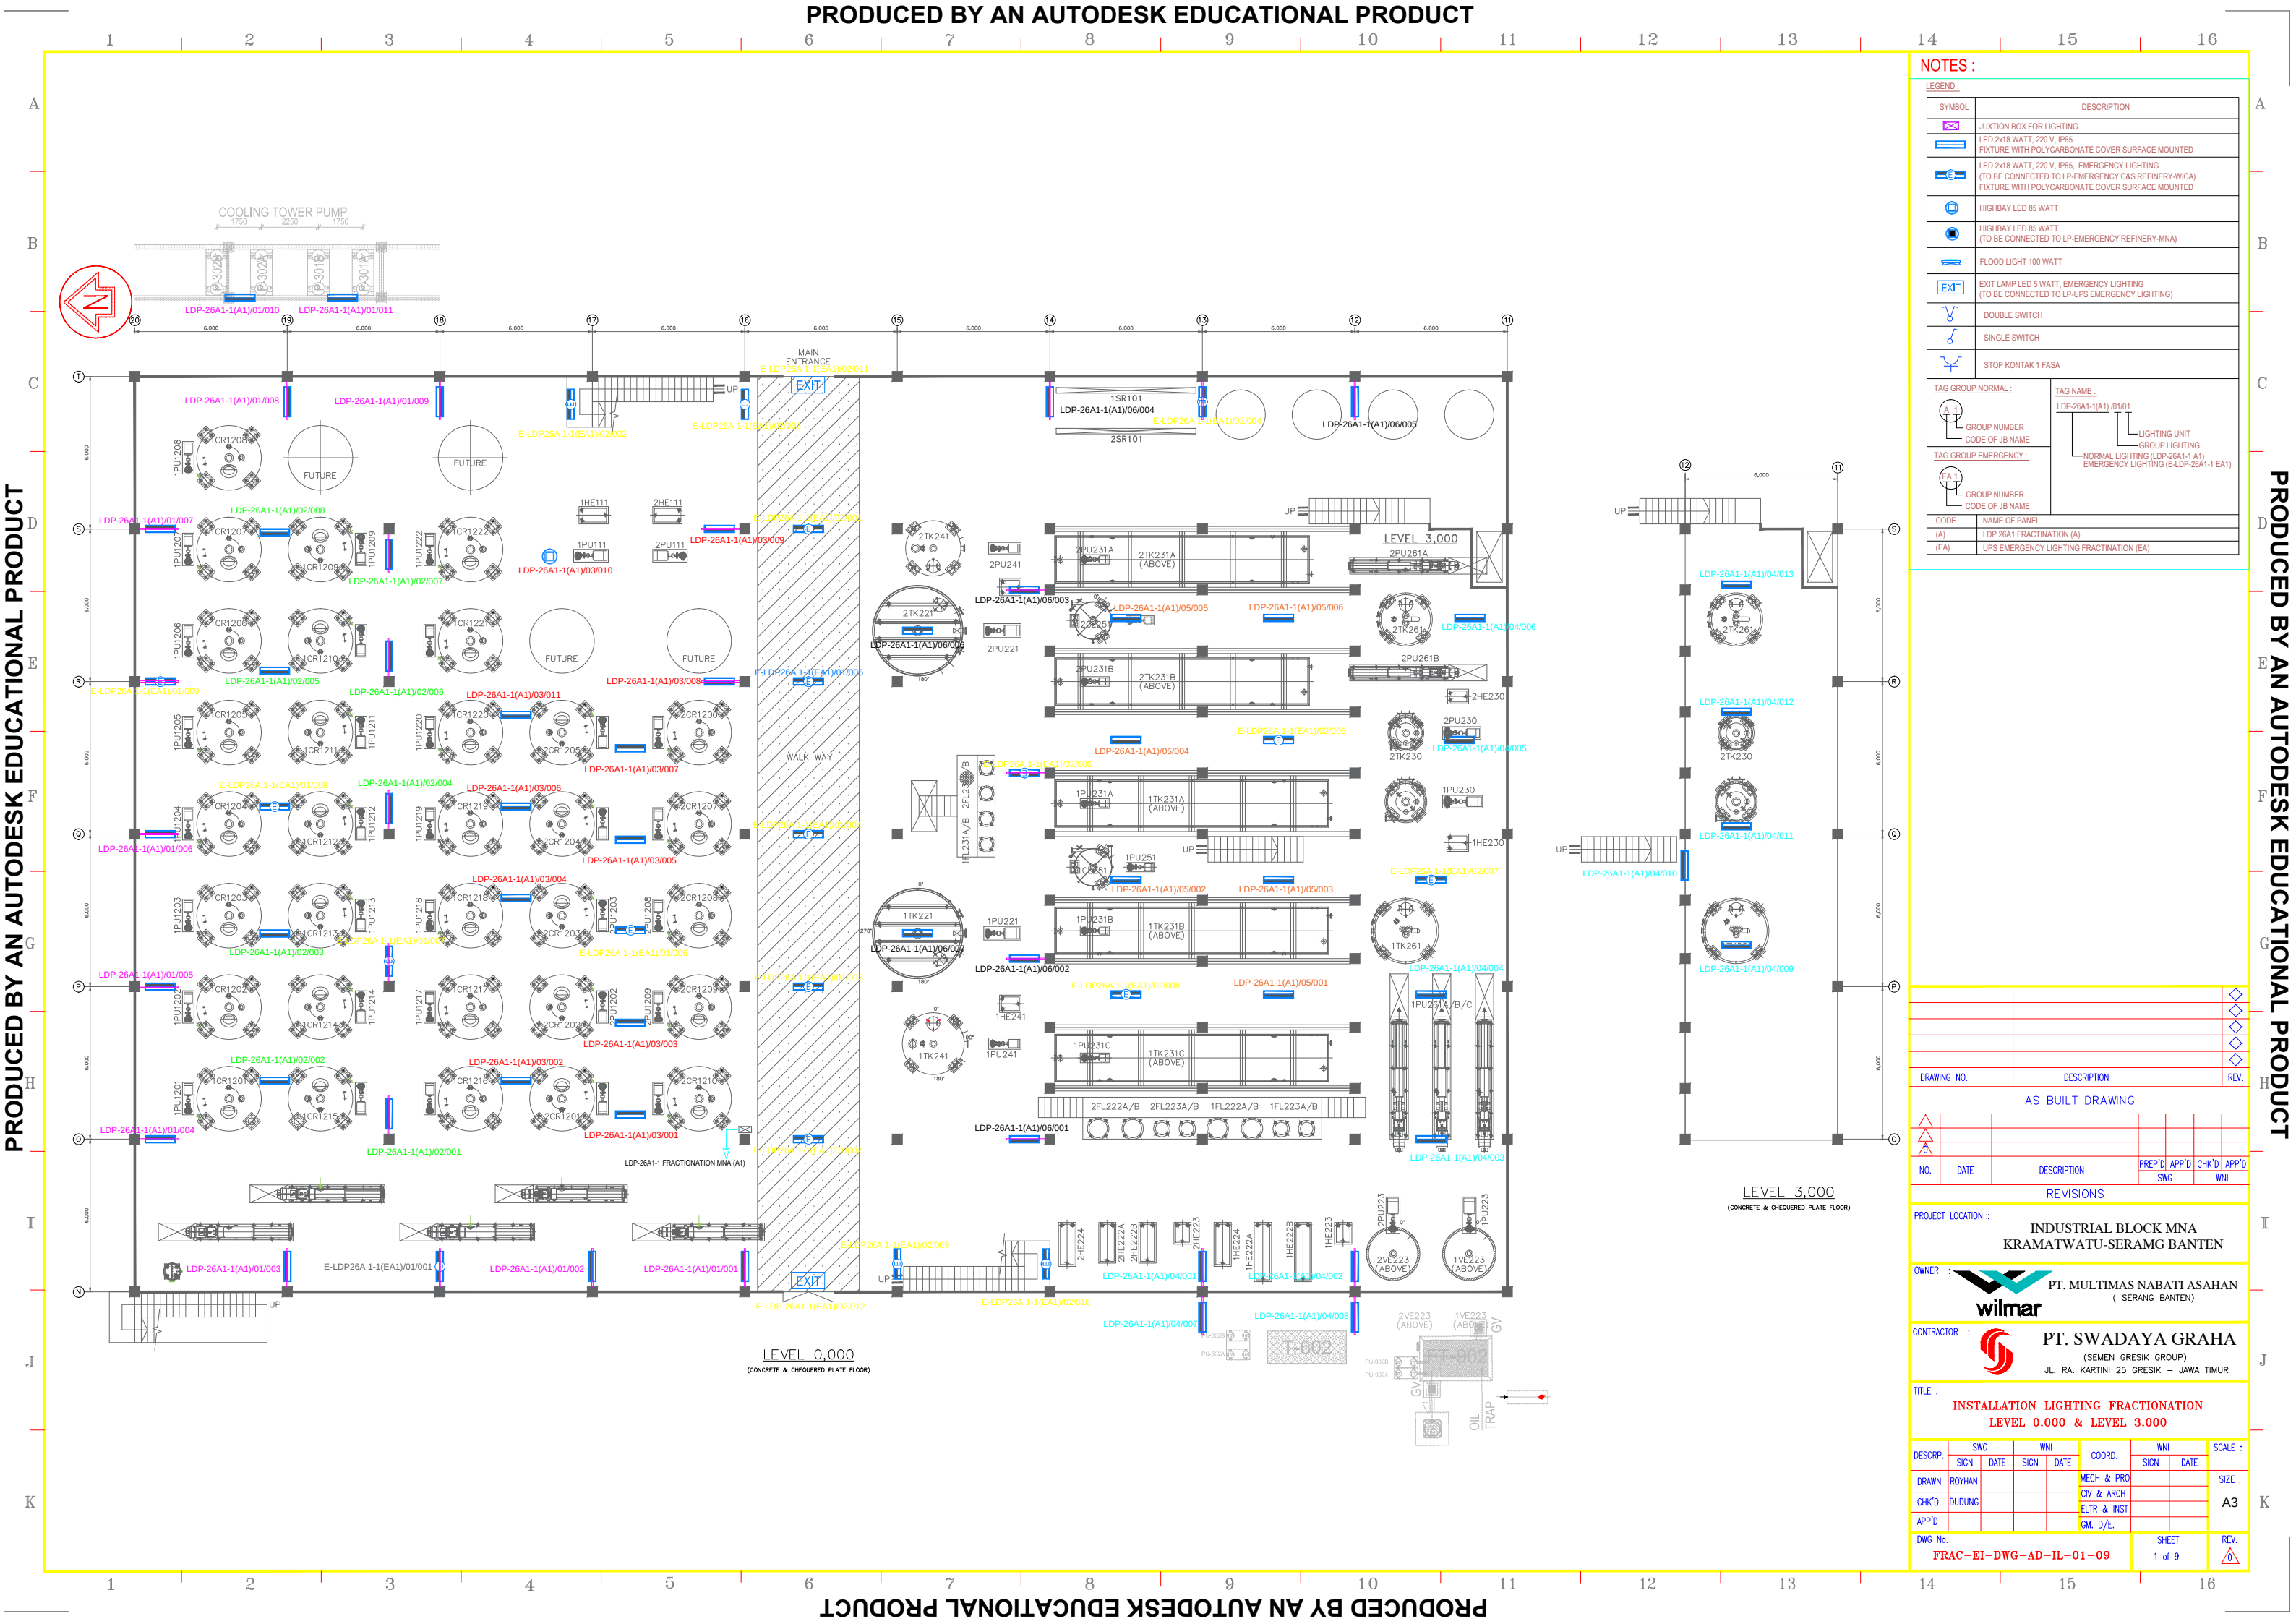

NOTES :

LEGEND :

SYMBOL	DESCRIPTION
	JUNCTION BOX FOR LIGHTING
	LED 2x18 WATT, 220 V, IP65 FIXTURE WITH POLYCARBONATE COVER SURFACE MOUNTED
	LED 2x18 WATT, 220 V, IP65, EMERGENCY LIGHTING (TO BE CONNECTED TO LP-EMERGENCY C&S REFINERY-WICA)
	HIGHBAY LED 85 WATT
	HIGHBAY LED 85 WATT (TO BE CONNECTED TO LP-EMERGENCY REFINERY-MNA)
	FLOOD LIGHT 100 WATT
	EXIT LAMP LED 5 WATT, EMERGENCY LIGHTING (TO BE CONNECTED TO LP-UPS EMERGENCY LIGHTING)
	DOUBLE SWITCH
	SINGLE SWITCH
	STOP KONTAK 1 FASA

TAG GROUP NORMAL :

GROUP NUMBER
CODE OF JB NAME

TAG GROUP EMERGENCY :

GROUP NUMBER
CODE OF JB NAME

TAG NAME :

LDP-26A1-1(A1) 01/01

LIGHTING UNIT GROUP LIGHTING
NORMAL LIGHTING (LDP-26A1-1 A1)
EMERGENCY LIGHTING (E-LDP-26A1-1 EA1)

CODE	NAME OF PANEL
(A)	LDP 26A1 FRACTIONATION (A)
(EA)	UPS EMERGENCY LIGHTING FRACTIONATION (EA)

DRAWING NO.	DESCRIPTION	REV.
	AS BUILT DRAWING	

NO.	DATE	DESCRIPTION	PREP'D SWG	APP'D WNI	CHK'D WNI	APP'D WNI

REVISIONS

PROJECT LOCATION :

INDUSTRIAL BLOCK MNA
KRATATWATU-SERAMG BANTEN

OWNER :

PT. MULTIMAS NABATI ASAHAN
(SERANG BANTEN)

CONTRACTOR :

PT. SWADAYA GRAHA
(SEMENT GRESIK GROUP)
JL. RA. KARTINI 25 GRESIK - JAWA TIMUR

TITLE :

INSTALLATION LIGHTING FRACTIONATION
LEVEL 0.000 & LEVEL 3.000

DESCRIP.	SWG	WNI	COORD.	WNI	SCALE :
SIGN	DATE	SIGN	DATE	SIGN	DATE
DRAWN	ROYHAN			MECH & PRO	
CHK'D	DUJUNG			CIV & ARCH	
APP'D				ELTR & INST	
				GM. D/E.	

DWG No.

FRAC-EI-DWG-AD-IL-01-09

SHEET

1 of 9

REV.

PRODUCED BY AN AUTODESK EDUCATIONAL PRODUCT

PRODUCED BY AN AUTODESK EDUCATIONAL PRODUCT

PRODUCED BY AN AUTODESK EDUCATIONAL PRODUCT



DRAWING NO.	DESCRIPTION	REV
AS BUILT DRAWING		
△		
△		
○		
No.	Date	Description
		PREP'D APP'D CHK'D APD
		SWG WNI


PROJECT LOCATION : **INDUSTRIAL BLOCK MNA
KRAMATWATU-SERAMG BANTEN**

wilmar PT. MULTIMAS NABATI ASAHAN
(SERANG BANTEN)

 PT. SWADAYA GRAHA
(SEMEN GRESIK GROUP)
JL. RA. KARTINI 25 GRESIK – JAWA TIMUR

INSTALLATION LIGHTING FRACTIONATION								
LEVEL 8.000								
DESCRCP.	SWG		WNI		COORD.	WNI		SCALE
	SIGN	DATE	SIGN	DATE		SIGN	DATE	
DRAWN	ROTHAN				MECH & PRO			SIZE
CHK'D	DUDUNG				CIV & ARCH			A3
					ELTR & INST			

DWG No. FRAC-EI-DWG-AD-IL-02-09	SHEET 2 of 9	REV 
---	-----------------	--

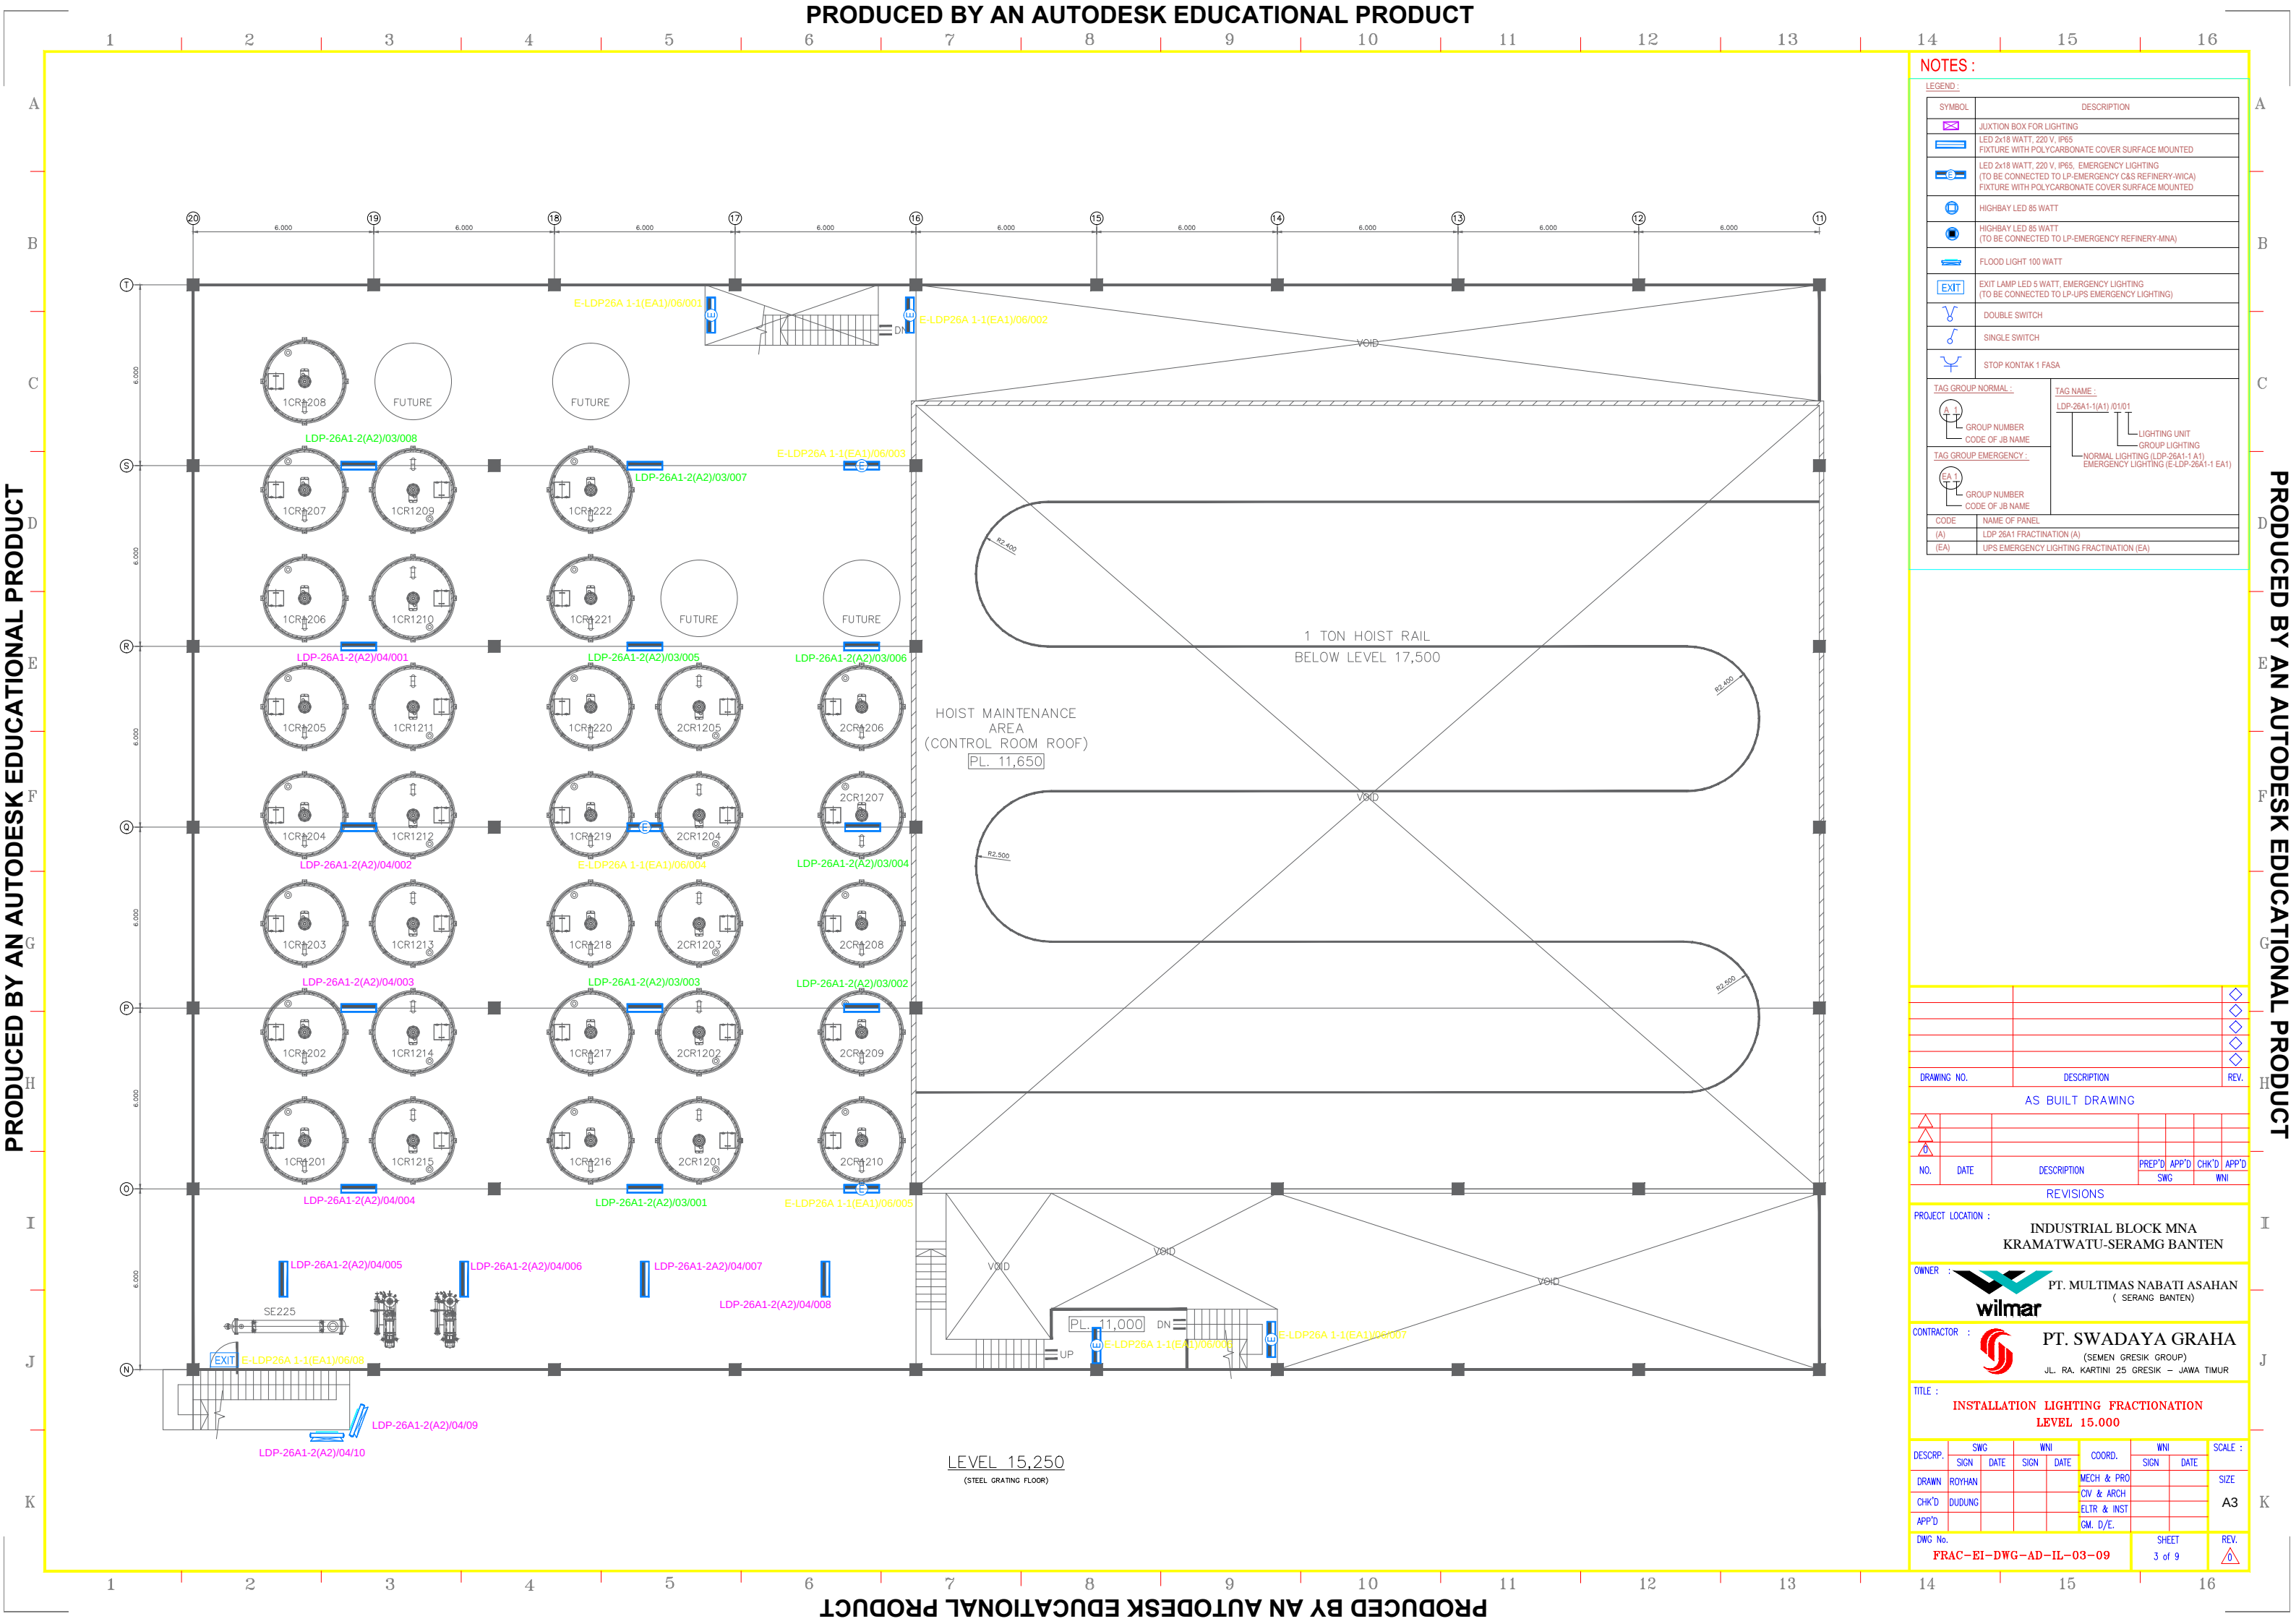

NOTES :

LEGEND :

SYMBOL	DESCRIPTION
	JUNCTION BOX FOR LIGHTING
	LED 2x18 WATT, 220 V, IP65 FIXTURE WITH POLYCARBONATE COVER SURFACE MOUNTED
	LED 2x18 WATT, 220 V, IP65, EMERGENCY LIGHTING (TO BE CONNECTED TO LP-EMERGENCY C&S REFINERY-WICA) FIXTURE WITH POLYCARBONATE COVER SURFACE MOUNTED
	HIGHBAY LED 85 WATT
	HIGHBAY LED 85 WATT (TO BE CONNECTED TO LP-EMERGENCY REFINERY-MNA)
	FLOOD LIGHT 100 WATT
	EXIT LAMP LED 5 WATT, EMERGENCY LIGHTING (TO BE CONNECTED TO LP-UPS EMERGENCY LIGHTING)
	DOUBLE SWITCH
	SINGLE SWITCH
	STOP KONTAK 1 FASA

TAG GROUP NORMAL :

GROUP NUMBER
CODE OF JB NAME

TAG GROUP EMERGENCY :

GROUP NUMBER
CODE OF JB NAME

TAG NAME :

LDP-26A1-1(A1) 0101

LIGHTING UNIT
GROUP LIGHTING

NORMAL LIGHTING (LDP-26A1-1 A1)
EMERGENCY LIGHTING (E-LDP-26A1-1 EA1)

CODE	NAME OF PANEL
(A)	LDP 26A1 FRACTIONATION (A)
(EA)	UPS EMERGENCY LIGHTING FRACTIONATION (EA)

DRAWING NO.	DESCRIPTION	REV.

AS BUILT DRAWING

NO.	DATE	DESCRIPTION	PREP'D SWG	APP'D WNI	CHK'D WNI	APP'D WNI

REVISIONS

PROJECT LOCATION :
INDUSTRIAL BLOCK MNA
KRATATWATU-SERAMG BANTEN

OWNER :

PT. MULTIMAS NABATI ASAHAN
(SERANG BANTEN)

CONTRACTOR :

PT. SWADAYA GRAHA
(SEMEN GRESIK GROUP)
JL. RA. KARTINI 25 GRESIK – JAWA TIMUR


TITLE :
INSTALLATION LIGHTING FRACTIONATION
LEVEL 15.000

DESCRIP.	SWG	WNI	COORD.	WNI	SCALE :
SIGN	DATE	SIGN	DATE	SIGN	DATE
DRAWN	ROYHAN			MECH & PRO	
CHK'D	DUUDUNG			CIV & ARCH	
APP'D				ELTR & INST	
				GM. D/E.	

DWG No.
FRAC-EI-DWG-AD-IL-03-09

SHEET
3 of 9

REV.

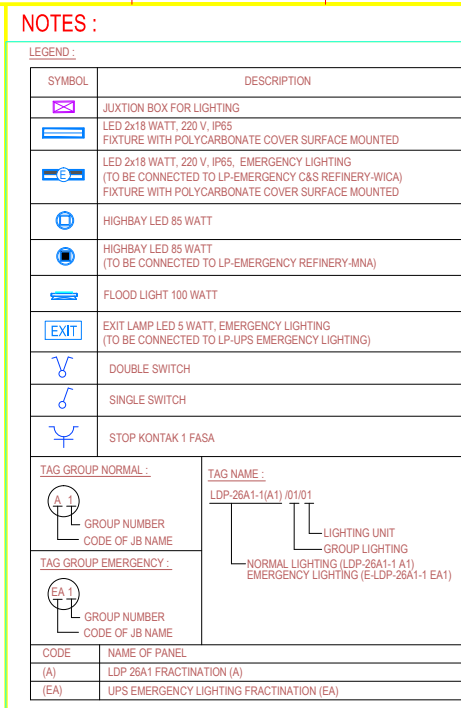

		◇
		◇
DRAWING NO.	DESCRIPTION	REVISION

AS BUILT DRAWING

△					
△					
△					
NO.	DATE	DESCRIPTION	PREP'D SWG	APP'D	CHK'D WNI
REVISIONS					

PROJECT LOCATION : **INDUSTRIAL BLOCK MNA
KRAMATWATU-SERAMG BANTEN**

OWNER :  PT. MULTIMAS NABATI ASAHAN
(SERANG BANTEN)

CONTRACTOR :  **PT. SWADAYA GRAHA**
(SEMEN GRESIK GROUP)
JL. RA. KARTINI 25 GRESIK – JAWA TIMUR

TITLE :
INSTALLATION LIGHTING FRACTIONATION
COOLING TOWER

DESCRP.	SWG		WNI		COORD.	WNI		SCALE
	SIGN	DATE	SIGN	DATE		SIGN	DATE	
DRAWN	ROYHAN				MECH & PRO CIV & ARCH ELTR & INST GM. D/E.			SIZE A3
CHK'D	DUDUNG							
APP'D								

DWG No.	SHEET	REV.
FRAC-EI-DWG-AD-IL-04-09	4 of 9	0



SYMBOL		DESCRIPTION
	JUNCTION BOX FOR LIGHTING	
	LED 2x18 WATT 220 V, IP65 FIXTURE WITH POLYCARBONATE COVER SURFACE MOUNTED	
	LED 2x18 WATT 220 V, IP65, EMERGENCY LIGHTING (TO BE CONNECTED TO LP-EMERGENCY CAS REFINERY-WICA) FIXTURE WITH POLYCARBONATE COVER SURFACE MOUNTED	
	HIGHBAY LED 85 WATT	
	HIGHBAY LED 85 WATT (TO BE CONNECTED TO LP-EMERGENCY REFINERY-MINA)	
	FLOOD LIGHT 100 WATT	
	EXIT LAMP LED 5 WATT, EMERGENCY LIGHTING (TO BE CONNECTED TO LP-UPS EMERGENCY LIGHTING)	
	DOUBLE SWITCH	
	SINGLE SWITCH	
	STOP KONTAK 1 FASA	
<u>TAG GROUP NORMAL :</u>		<u>TAG NAME :</u>
	GROUP NUMBER CODE OF JB NAME	LDP-26A1-1(A1) 01/01 GROUP LIGHTING NORMAL LIGHTING (LDP-26A1-1 A1) EMERGENCY LIGHTING (E-LDP-26A1-1 EA1)
<u>TAG GROUP EMERGENCY :</u>		
	GROUP NUMBER CODE OF JB NAME	
CODE	NAME OF PANEL	
(A)	LDP 26A1 FRACTIONATION (A)	
(EA)	UPS EMERGENCY LIGHTING FRACTIONATION (EA)	

		<
		<
		<
		<
DRAWING NO.	DESCRIPTION	F

AS BUILT DRAWING						
NO.	DATE	DESCRIPTION	PREP'D SWG	APP'D	CHK'D WNI	AI
REVISIONS						


PROJECT LOCATION : **INDUSTRIAL BLOCK MNA
KRAMATWATU-SERAMG BANTEN**

OWNER :  PT. MULTIMAS NABATI ASAHAN
(SERANG BANTEN)

CONTRACTOR :  **PT. SWADAYA GRAHA**
(SEMEN GRESIK GROUP)
JL. RA. KARTINI 25 GRESIK – JAWA TIMUR


TITLE :
INSTALLATION LIGHTING FRACTIONATION
CABLE ROOM, PANEL ROOM & TANGGA

DESCR.	SWG		WNI		COORD.	WNI		SCALE
	SIGN	DATE	SIGN	DATE		SIGN	DATE	
DRAWN	ROYHAN				MECH & PRO			SIZE A
CHK'D	DUDUNG				CIV & ARCH			
APP'D					ELTR & INST			
DWG No.					GM. D/E.			
FRAC-EI-DWG-AD-IL-05-09						SHEET 5 of 9		REVISION

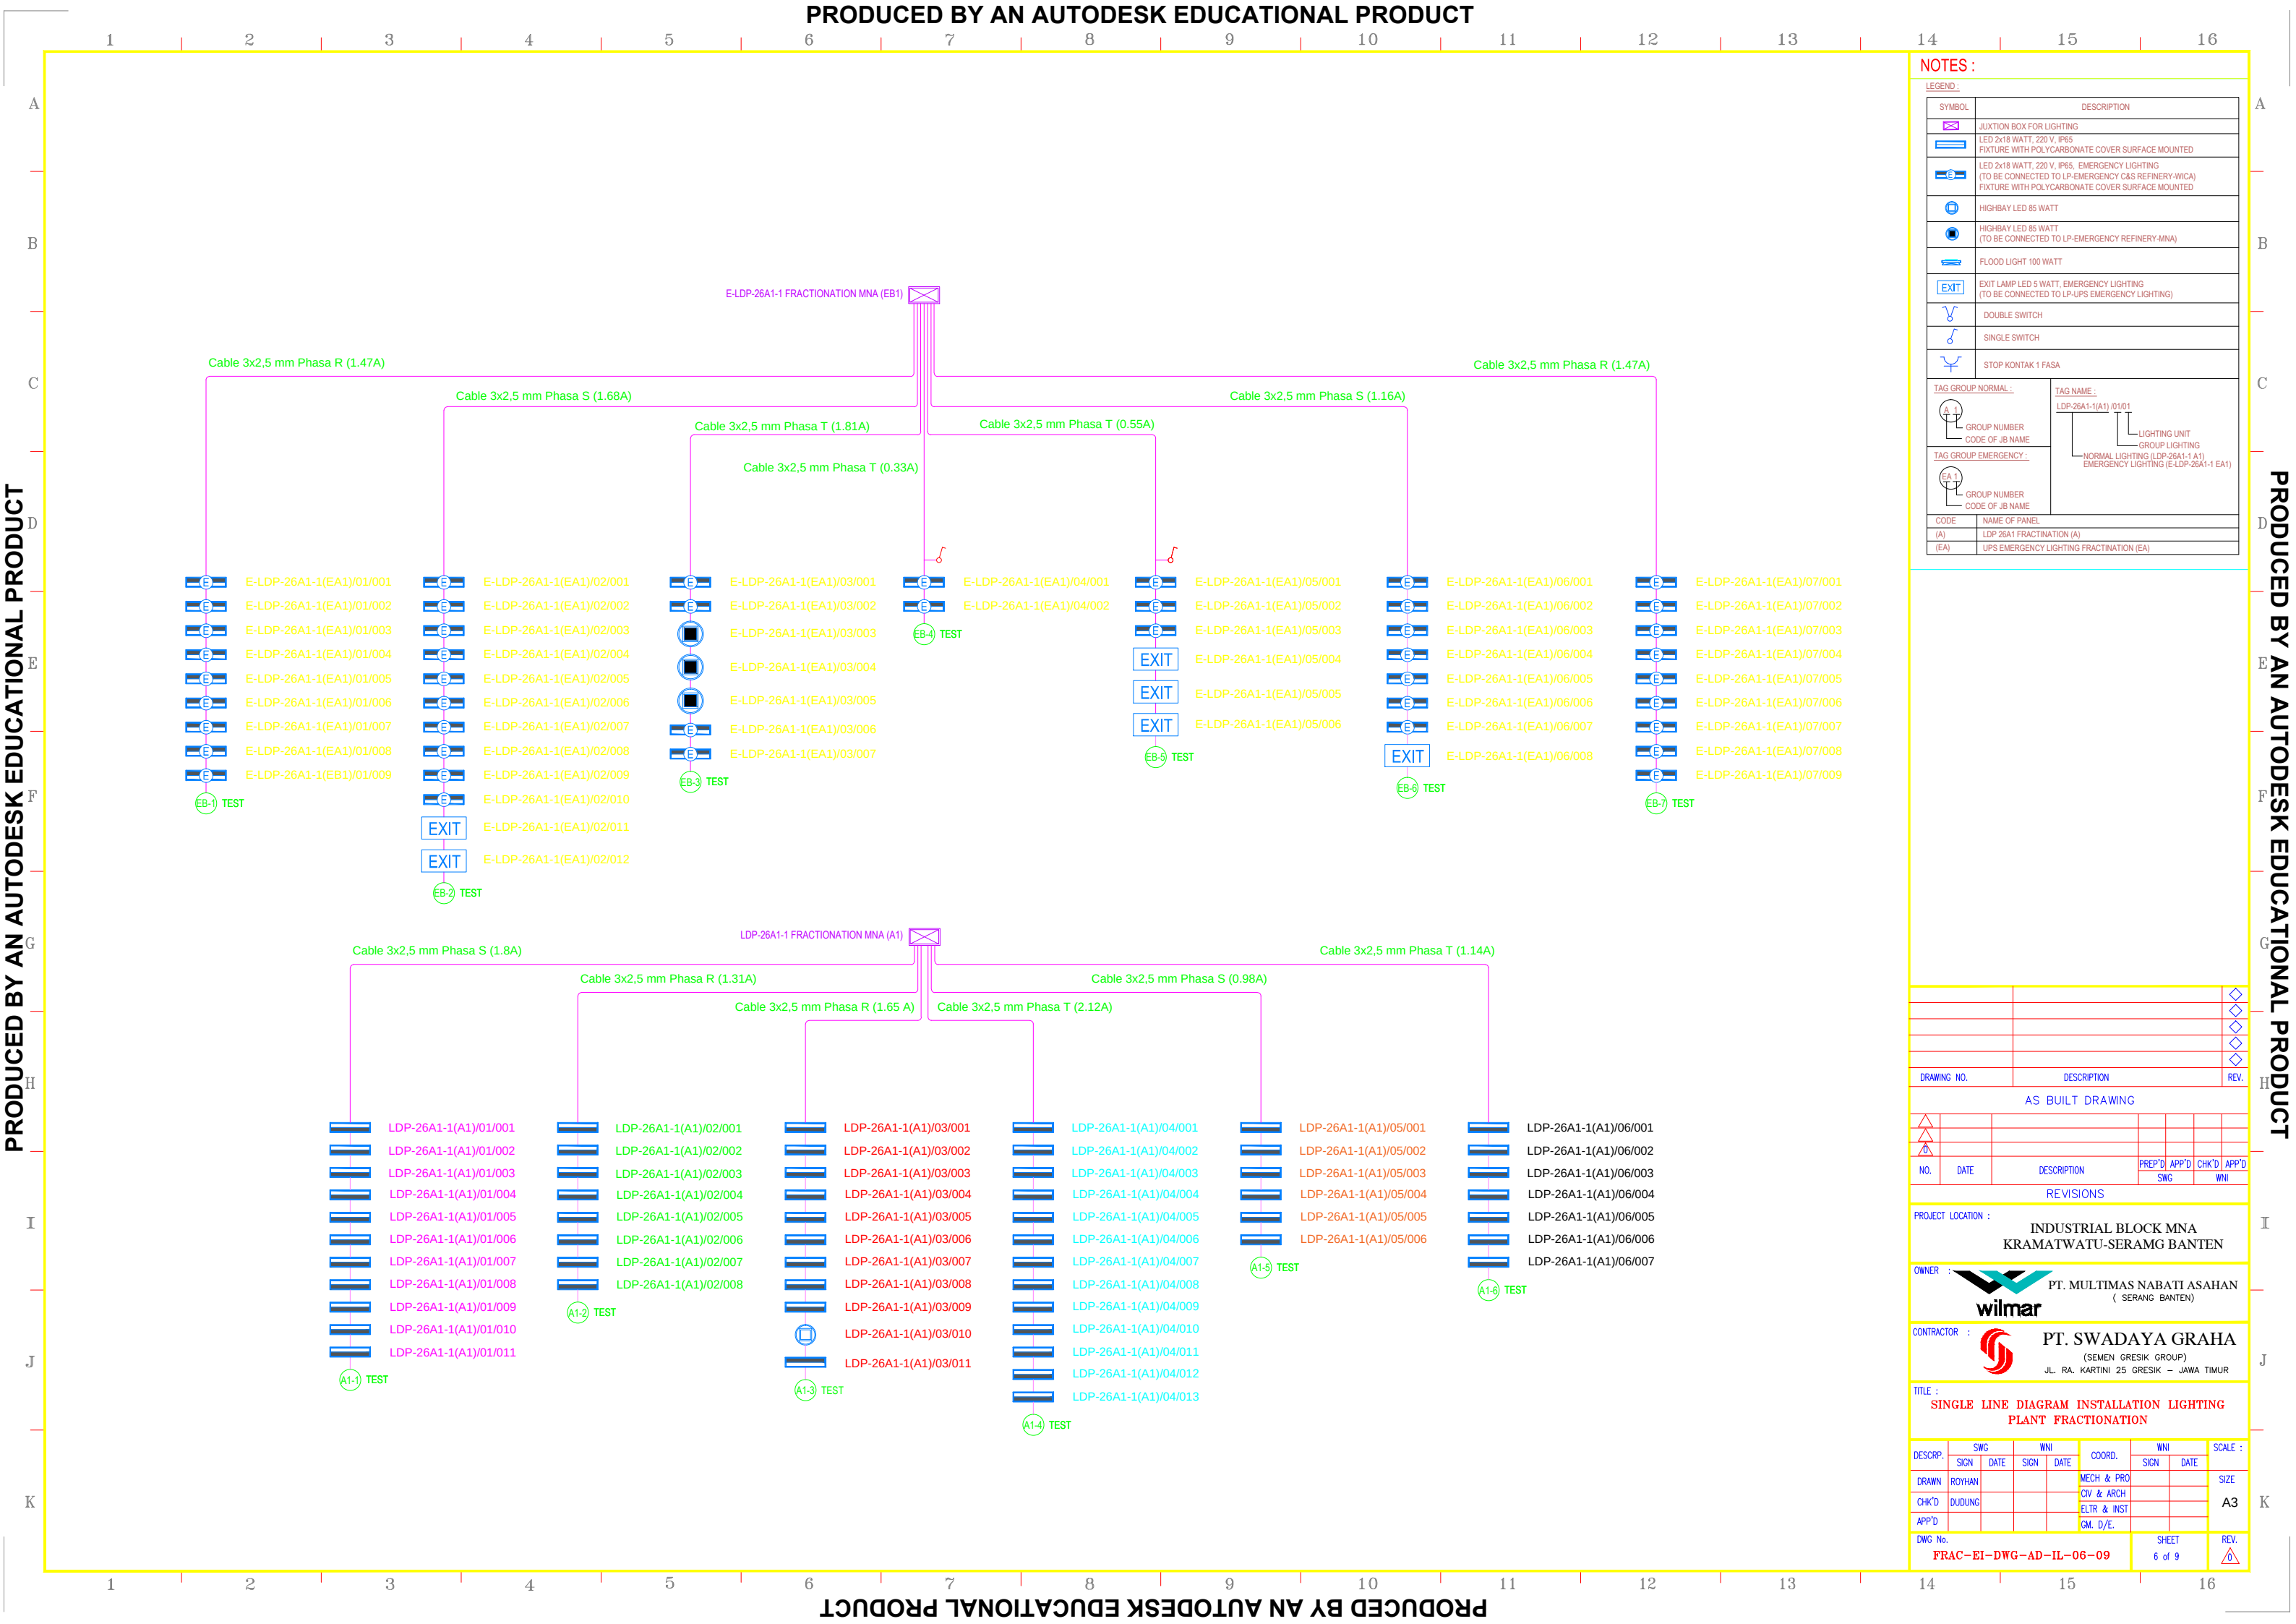

LEGEND :	
SYMBOL	DESCRIPTION
	JUNCTION BOX FOR LIGHTING
	LED 2x18 WATT, 220 V, IP65 FIXTURE WITH POLYCARBONATE COVER SURFACE MOUNTED
	LED 2x18 WATT, 220 V, IP65, EMERGENCY LIGHTING (TO BE CONNECTED TO LP-EMERGENCY C&S REFINERY-WICA) FIXTURE WITH POLYCARBONATE COVER SURFACE MOUNTED
	HIGHBAY LED 85 WATT
	HIGHBAY LED 85 WATT (TO BE CONNECTED TO LP-EMERGENCY REFINERY-MNA)
	FLOOD LIGHT 100 WATT
	EXIT LAMP LED 5 WATT, EMERGENCY LIGHTING (TO BE CONNECTED TO LP-UPS EMERGENCY LIGHTING)
	DOUBLE SWITCH
	SINGLE SWITCH
	STOP KONTAK 1 FASA
TAG GROUP NORMAL : GROUP NUMBER CODE OF JB NAME TAG GROUP EMERGENCY : GROUP NUMBER CODE OF JB NAME	
TAG NAME : LDP-26A1-1(A1) 0101 LIGHTING UNIT GROUP LIGHTING NORMAL LIGHTING (LDP-26A1-1 A1) EMERGENCY LIGHTING (E-LDP-26A1-1 EA1)	
CODE	NAME OF PANEL
(A)	LDP 26A1 FRACTIONATION (A)
(EA)	UPS EMERGENCY LIGHTING FRACTIONATION (EA)

--	--	
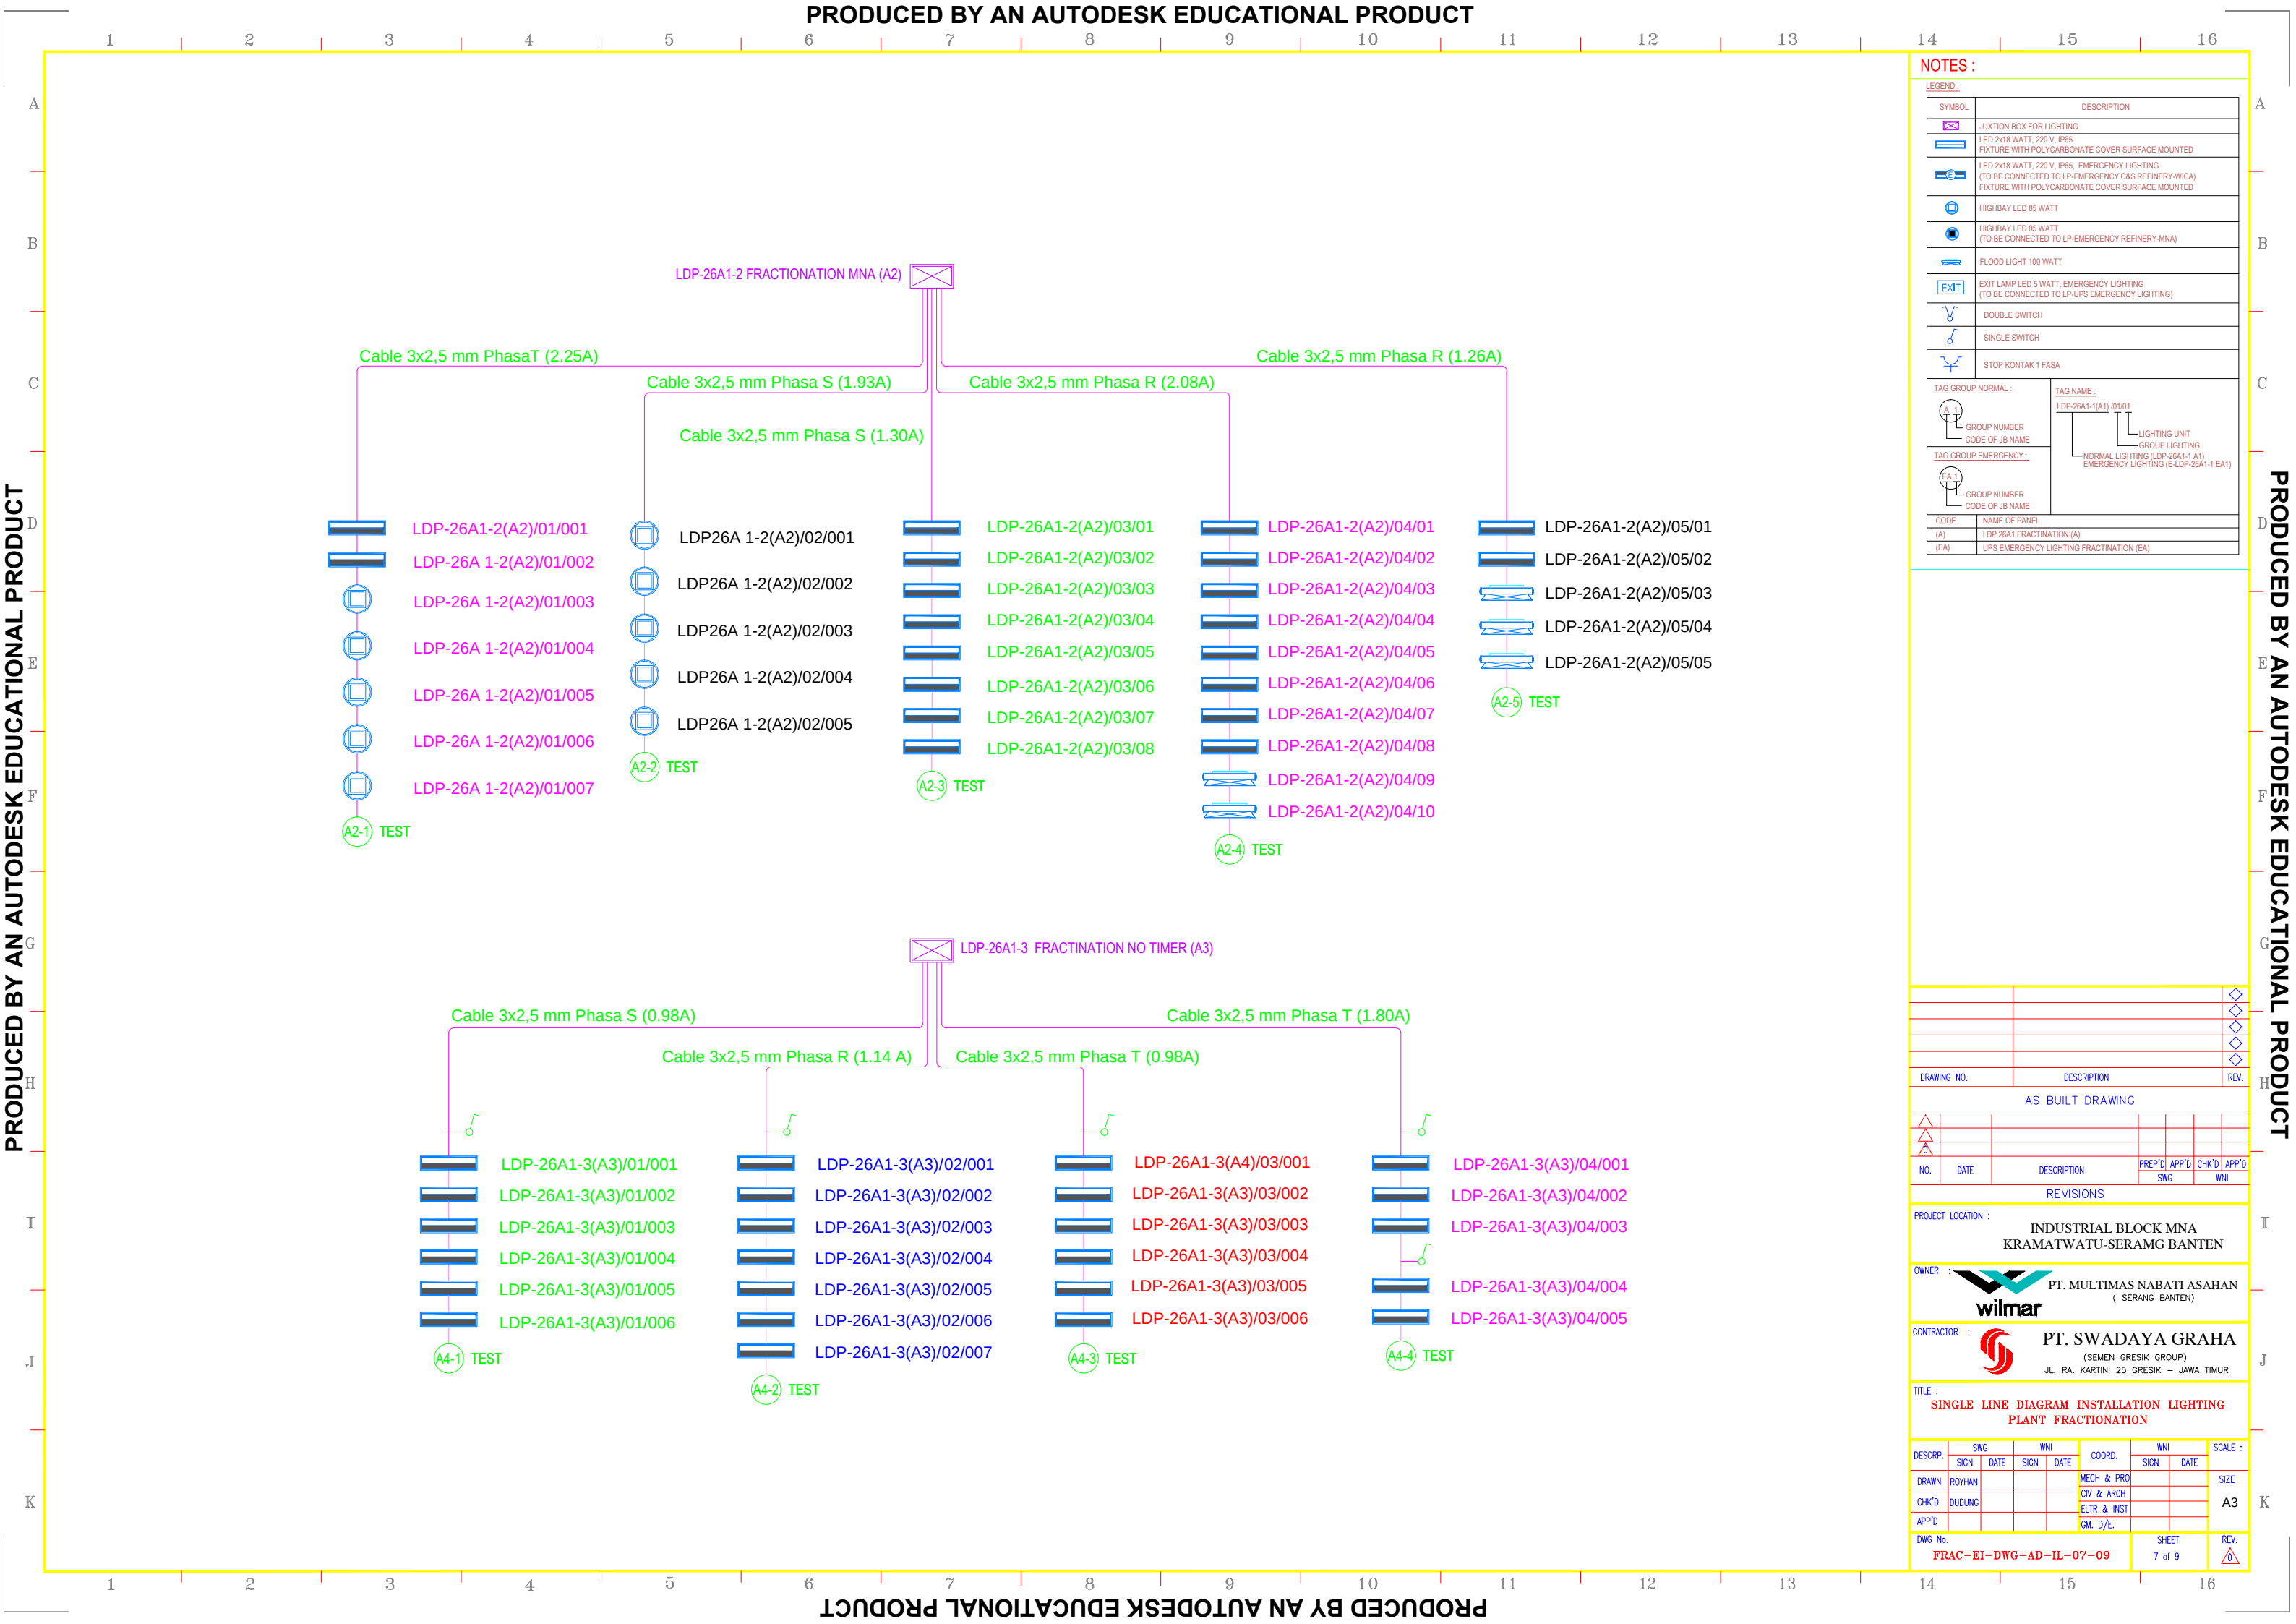

SYMBOL		DESCRIPTION
		JUNCTION BOX FOR LIGHTING
		LED 2x18 WATT, 220 V, IP65 FIXTURE WITH POLYCARBONATE COVER SURFACE MOUNTED
		LED 2x18 WATT, 220 V, IP65, EMERGENCY LIGHTING (TO BE CONNECTED TO LP-EMERGENCY CAS REFINERY-WICA) FIXTURE WITH POLYCARBONATE COVER SURFACE MOUNTED
		HIGHBAY LED 85 WATT
		HIGHBAY LED 85 WATT (TO BE CONNECTED TO LP-EMERGENCY REFINERY-MMA)
		FLOOD LIGHT 100 WATT
		EXIT LAMP LED 5 WATT, EMERGENCY LIGHTING (TO BE CONNECTED TO LP-UPS EMERGENCY LIGHTING)
		DOUBLE SWITCH
		SINGLE SWITCH
		STOP KONTAK 1 FASA
<u>TAG GROUP NORMAL :</u>		<u>TAG NAME :</u>
	GROUP NUMBER CODE OF JB NAME	LDP-26A1-1(A1) 01/01
<u>TAG GROUP EMERGENCY :</u>		
	GROUP NUMBER CODE OF JB NAME	NORMAL LIGHTING (LDP-26A1-1 A1) EMERGENCY LIGHTING (E-LDP-26A1-1 EA1)
CODE	NAME OF PANEL	
(A)	LDP 26A1 FRACTINATION (A)	
(EA)	UPS EMERGENCY LIGHTING FRACTINATION (EA)	

		<
		<
DRAWING NO.	DESCRIPTION	RE

AS BUILT DRAWING					
					
					
					
NO.	DATE	DESCRIPTION	PREP'D SWG	APP'D	CHK'D WNI

PROJECT LOCATION : **INDUSTRIAL BLOCK MNA
KRAMATWATU-SERAMG BANTEN**



OWNER :  PT. MULTIMAS NABATI ASAHAN
(SERANG BANTEN)

CONTRACTOR :  **PT. SWADAYA GRAHA**
(SEMEN GRESIK GROUP)

TITLE : DISTRIBUTION LOAD INSTALLATION LIGHTING
PLANT ERACSTATION

DESCRIP.	SWG		WNI		COORD.	WNI		SCALE
	SIGN	DATE	SIGN	DATE		SIGN	DATE	
DRAWN	ROYHAN				MECH & PRO			SIZE A3
CHK'D	DUDUNG				CIV & ARCH			
APP'D					ELTR & INST			
					CM, D/E			

DWG No.	SHEET	REV
FRAC-EI-DWG-AD-IL-08-09	8 of 9	0

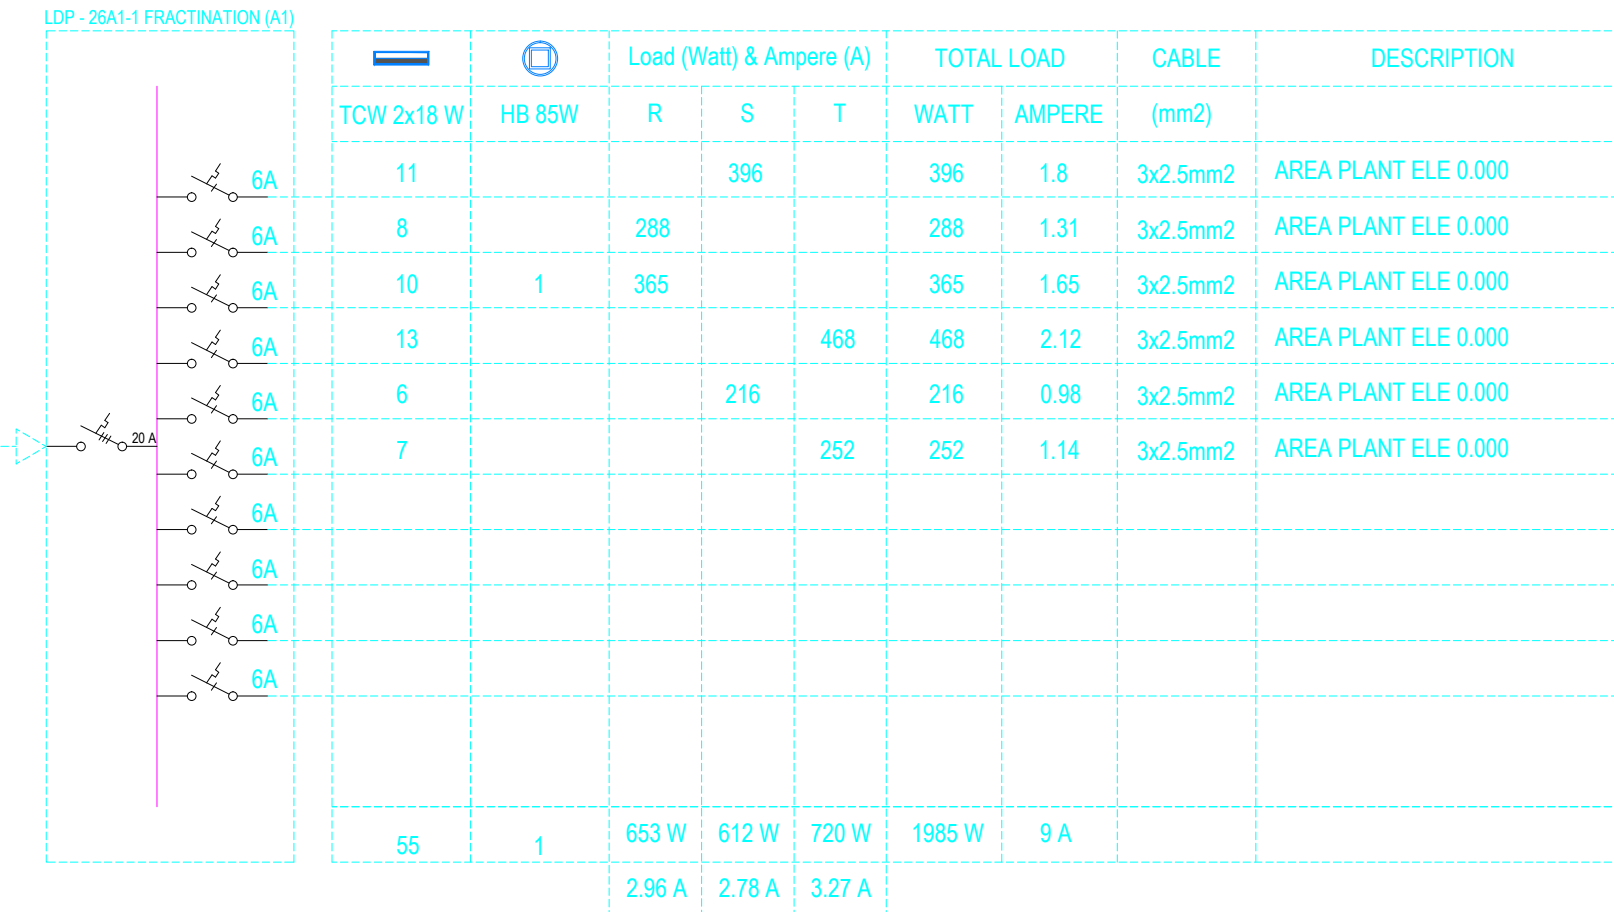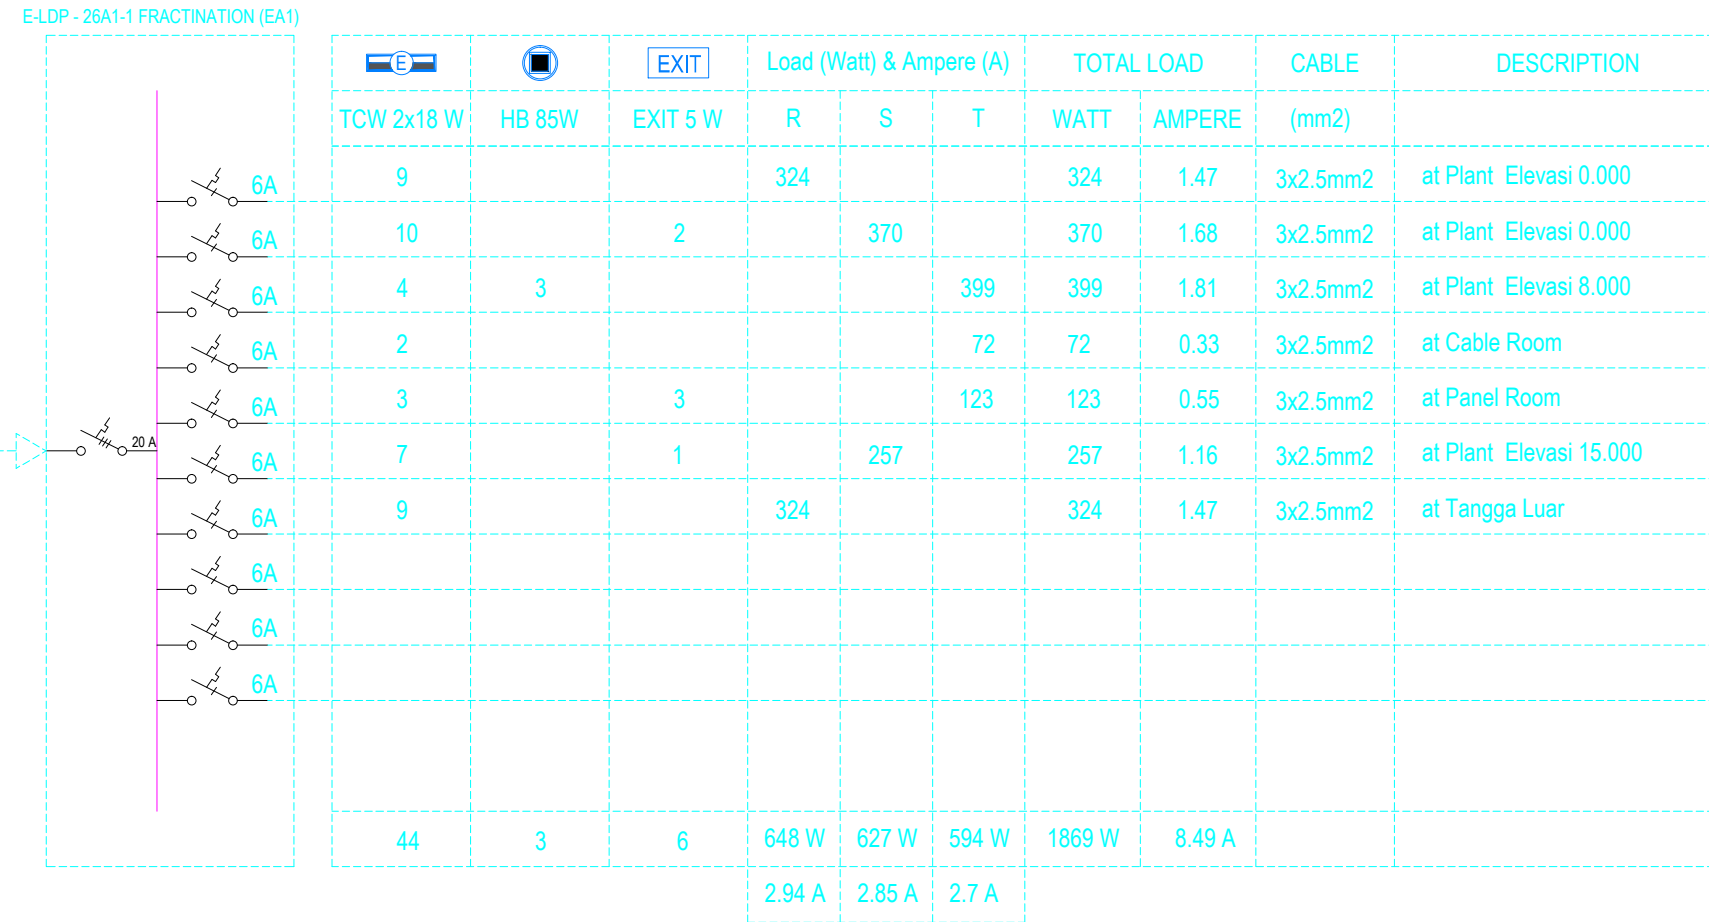

--	--	