


AS BUILT DRAWING

LUA MNA PLANT

NO	TITLE	NO. DRAWING
1	INSTALLATION LIGHTING	LUA-MNA-EI-DWG-AD-IL-01-08
2	LAYOUT CABLE LADDER	LUA-MNA-EI-DWG-AD-CL-01-010
3	LAYOUT CCTV	LUA-MNA-EI-DWG-AD-CC-01-03
4	LAYOUT ACCESS DOOR	LUA-MNA-EI-DWG-AD-AD-01-02
5	LAYOUT ACCESS POINT	LUA-MNA-EI-DWG-AD-AP-01-01
6	LAYOUT IPOS	LUA-MNA-EI-DWG-AD-RC-01-01
7	LAYOUT REMOTE PANEL	LUA-MNA-EI-DWG-AD-LP-01-02
8	LAYOUT GROUNDING	LUA-MNA-EI-DWG-AD-GRD-01-03
9	GENERAL ARRANGEMENT PANEL	-



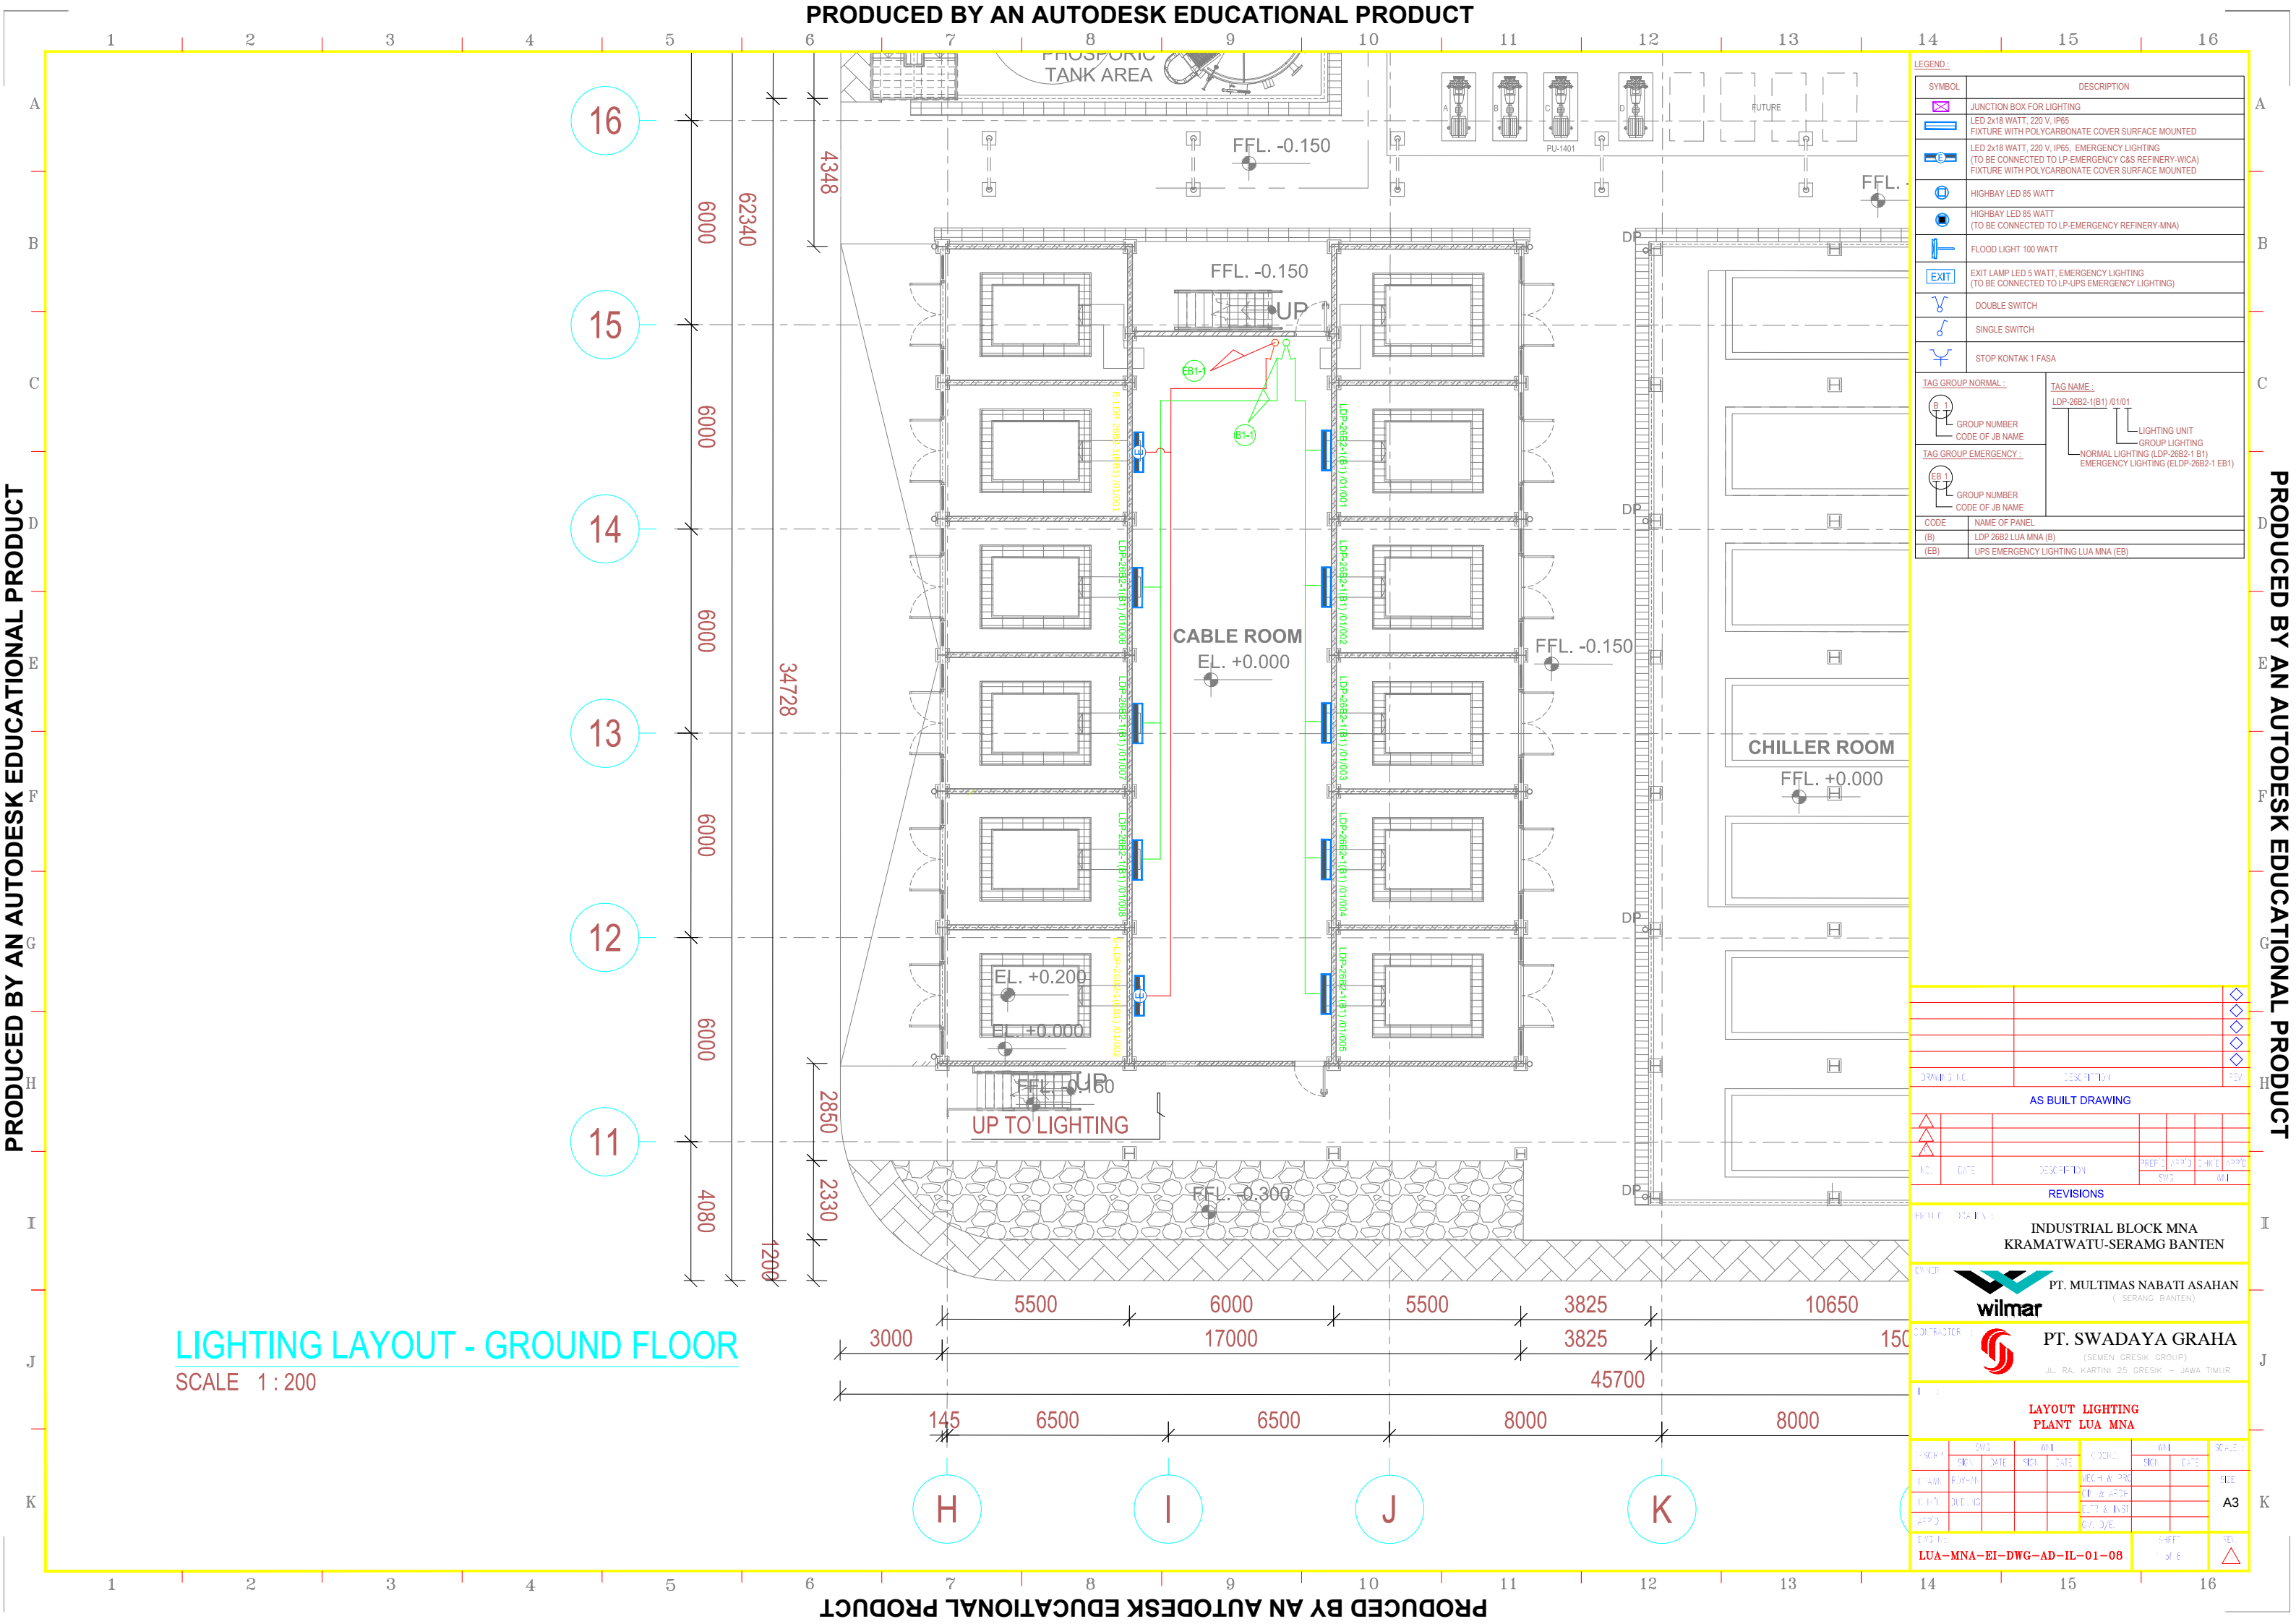

LIGHTING LAYOUT - GROUND FLOOR
SCALE 1 : 200

LEGEND :	
SYMBOL	DESCRIPTION
	JUNCTION BOX FOR LIGHTING
	LED 2x18 WATT, 220 V, IP65 FIXTURE WITH POLYCARBONATE COVER SURFACE MOUNTED
	LED 2x18 WATT, 220 V, IP65, EMERGENCY LIGHTING (TO BE CONNECTED TO LP-EMERGENCY GAS REFINERY-WICA) FIXTURE WITH POLYCARBONATE COVER SURFACE MOUNTED
	HIGHBAY LED 85 WATT
	HIGHBAY LED 85 WATT (TO BE CONNECTED TO LP-EMERGENCY REFINERY-MNA)
	FLOOD LIGHT 100 WATT
	EXIT LAMP LED 5 WATT, EMERGENCY LIGHTING (TO BE CONNECTED TO LP-UPS EMERGENCY LIGHTING)
	DOUBLE SWITCH
	SINGLE SWITCH
	STOP KONTAK 1 FASA
TAG GROUP NORMAL :	
	GROUP NUMBER CODE OF JB NAME
TAG GROUP EMERGENCY :	
	GROUP NUMBER CODE OF JB NAME
TAG NAME :	
LDP-26B2-1(B1)/01/01	
LIGHTING UNIT GROUP LIGHTING NORMAL LIGHTING (LDP-26B2-1 B1) EMERGENCY LIGHTING (ELDP-26B2-1 EB1)	
CODE	
NAME OF PANEL	
(B)	LDP 26B2 LUA MNA (B)
(EB)	UPS EMERGENCY LIGHTING LUA MNA (EB)

DRAWING NO.		DESCRIPTION	
AS BUILT DRAWING			
NO.	DATE	DESCRIPTION	PREP'D
			SWG
REVISIONS			
NO.	DATE	DESCRIPTION	PREP'D
			SWG

INDUSTRIAL BLOCK MNA KRAMATWATU-SERANG BANTEN	
PT. MULTIMAS NABATI ASAHAN (SERANG BANTEN)	
PT. SWADAYA GRAHA (SEMEN GRESIK GROUP) JL. RA. KARTINI 25 GRESIK - JAWA TIMUR	

LAYOUT LIGHTING PLANT LUA MNA								
NO.	SWG		WHI		RECD.	WHI		SCALE
	SIGN	DATE	SIGN	DATE		SIGN	DATE	
1. NAME	FOR WHI				REC'D & PRG			SIZE A3
2. DATE	DUE TO				CHK & APPR			
3. APPROV					ENR & INST			
					OFF. DATE			
LUA MNA:						SHEET		REV 
LUA-MNA-EI-DWG-AD-IL-01-08						of 8		
1.4				1.5				1.6



LEGEND :	
SYMBOL	DESCRIPTION
	JUNCTION BOX FOR LIGHTING
	LED 2x18 WATT, 220 V, IP65 FIXTURE WITH POLYCARBONATE COVER SURFACE MOUNTED
	LED 2x18 WATT, 220 V, IP65, EMERGENCY LIGHTING (TO BE CONNECTED TO LP-EMERGENCY C&S REFINERY-WICA) FIXTURE WITH POLYCARBONATE COVER SURFACE MOUNTED
	HIGHBAY LED 85 WATT
	HIGHBAY LED 85 WATT (TO BE CONNECTED TO LP-EMERGENCY REFINERY-MNA)
	FLOOD LIGHT 100 WATT
	EXIT LAMP LED 5 WATT, EMERGENCY LIGHTING (TO BE CONNECTED TO LP-UPS EMERGENCY LIGHTING)
	DOUBLE SWITCH
	SINGLE SWITCH
	STOP KONTAK 1 FASA
<u>TAG GROUP NORMAL :</u>  GROUP NUMBER CODE OF JB NAME <u>TAG NAME :</u>  LDP-26B2-1(B1) /01/01 LIGHTING UNIT GROUP LIGHTING	
<u>TAG GROUP EMERGENCY :</u>  GROUP NUMBER CODE OF JB NAME NORMAL LIGHTING (LDP-26B2-1 B1) EMERGENCY LIGHTING (ELDP-26B2-1 EB1)	
CODE	NAME OF PANEL
(B)	LDP 26B2 L1A MNA (B)
(EB)	UPS EMERGENCY LIGHTING L1A MNA (EB)

		◆
		◆
		◆
		◆
2020年12月31日	2020年度	2020


NO.		DESCRIPTION		DATE	BY
AS BUILT DRAWING					
△					
△					
△					
NO.	DATE	DESCRIPTION	PREP'D (APP'D)	CHECKED (APP'D)	
			SIG	INIT	

REVISIONS	
FROM : PT. SAICHI	INDUSTRIAL BLOCK MNA KRAMATWATU-SERANG BANTEN
OWNER	 PT. MULTIMAS NABATI ASAHAN (SERANG, BANTEN)
CONTRACTOR	 PT. SWADAYA GRAHA (SEMEN GRESIK GROUP) J. RA. KARDIATAMA 3B, GRESIK, JAWA TIMUR

 LAYOUT LIGHTING PLANT LUA MNA									
1-500V	SNG		M1		CABLE	M1		SCALE	
	SIGN	DATE	SIGN	DATE		SIGN	DATE		
100-1000	100-1000				100-1000			SIZE	
100-1000	100-1000				100-1000			A3	
100-1000	100-1000				100-1000				
100-1000	100-1000				100-1000				
DWG No.					SHEET		REV.		
LUA-MNA-EI-DWG-AD-IL-02-08					1 of 1				





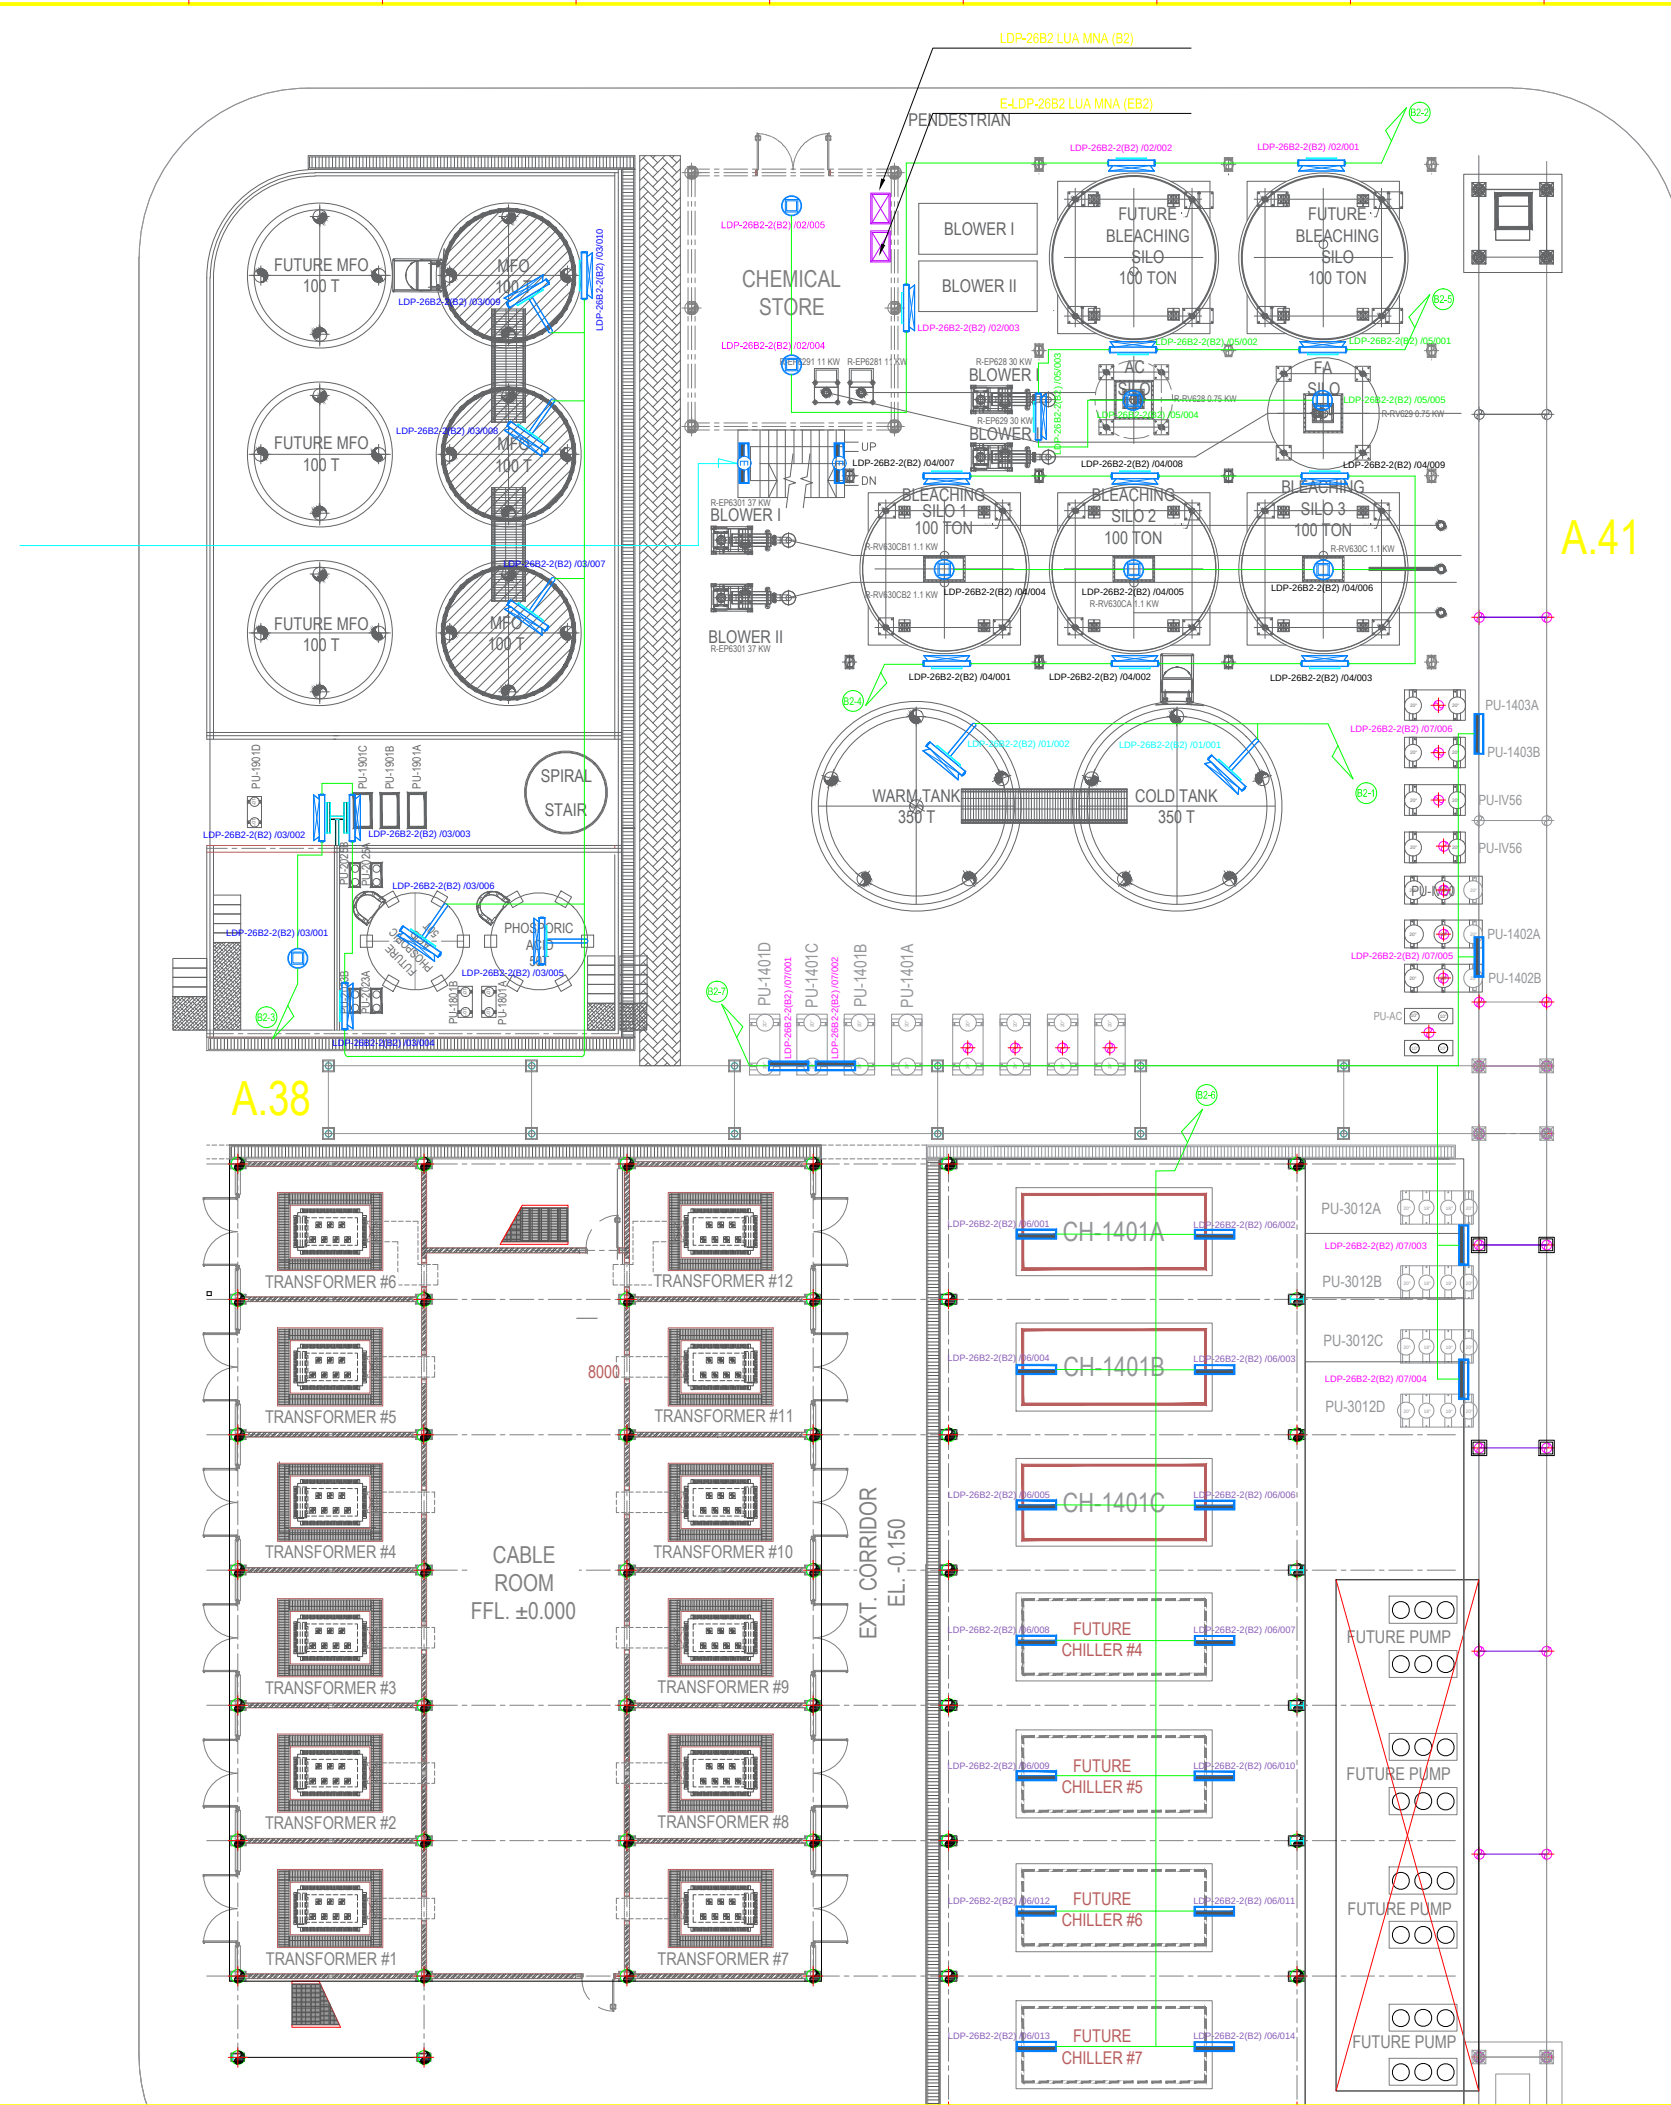

		◆
		◆
		◆
		◆
Wiederholung	Schulung	◆

AS BUILT DRAWING

△					
△					
△					
NO.	Eq. n.	3-SCF-EI	$2(EI)^2$ 50%	$2(EI)^2$ 50%	$(EI)^2$ 25%

REVISIONS

PROJECT LOCATION :

**INDUSTRIAL BLOCK MNA
KRAMATWATU-SERAMG BANTEN**

PT. MULTIMAS NABATI ASAHAN
(SERANG, BANTEN)

147


PT. SWADAYA GRAHA
(SEMEN GRESIK GROUP)
Jl. RA. KARTINI 25 GRESIK - JAWA TIMUR


LAYOUT LIGHTING

PLANT LUA MNA

DESC.	SWC		WM		CODEL.	WM		SCALE
	SWCN	DAI	SWCA	CA		SWCM	DAI	
PARAM.	DOY/AN				MECH & PROC			SIZE

CHK'E	DLD'ING				CM & APC I			A3
					I & ISI			
APD'D					GM, D/E			

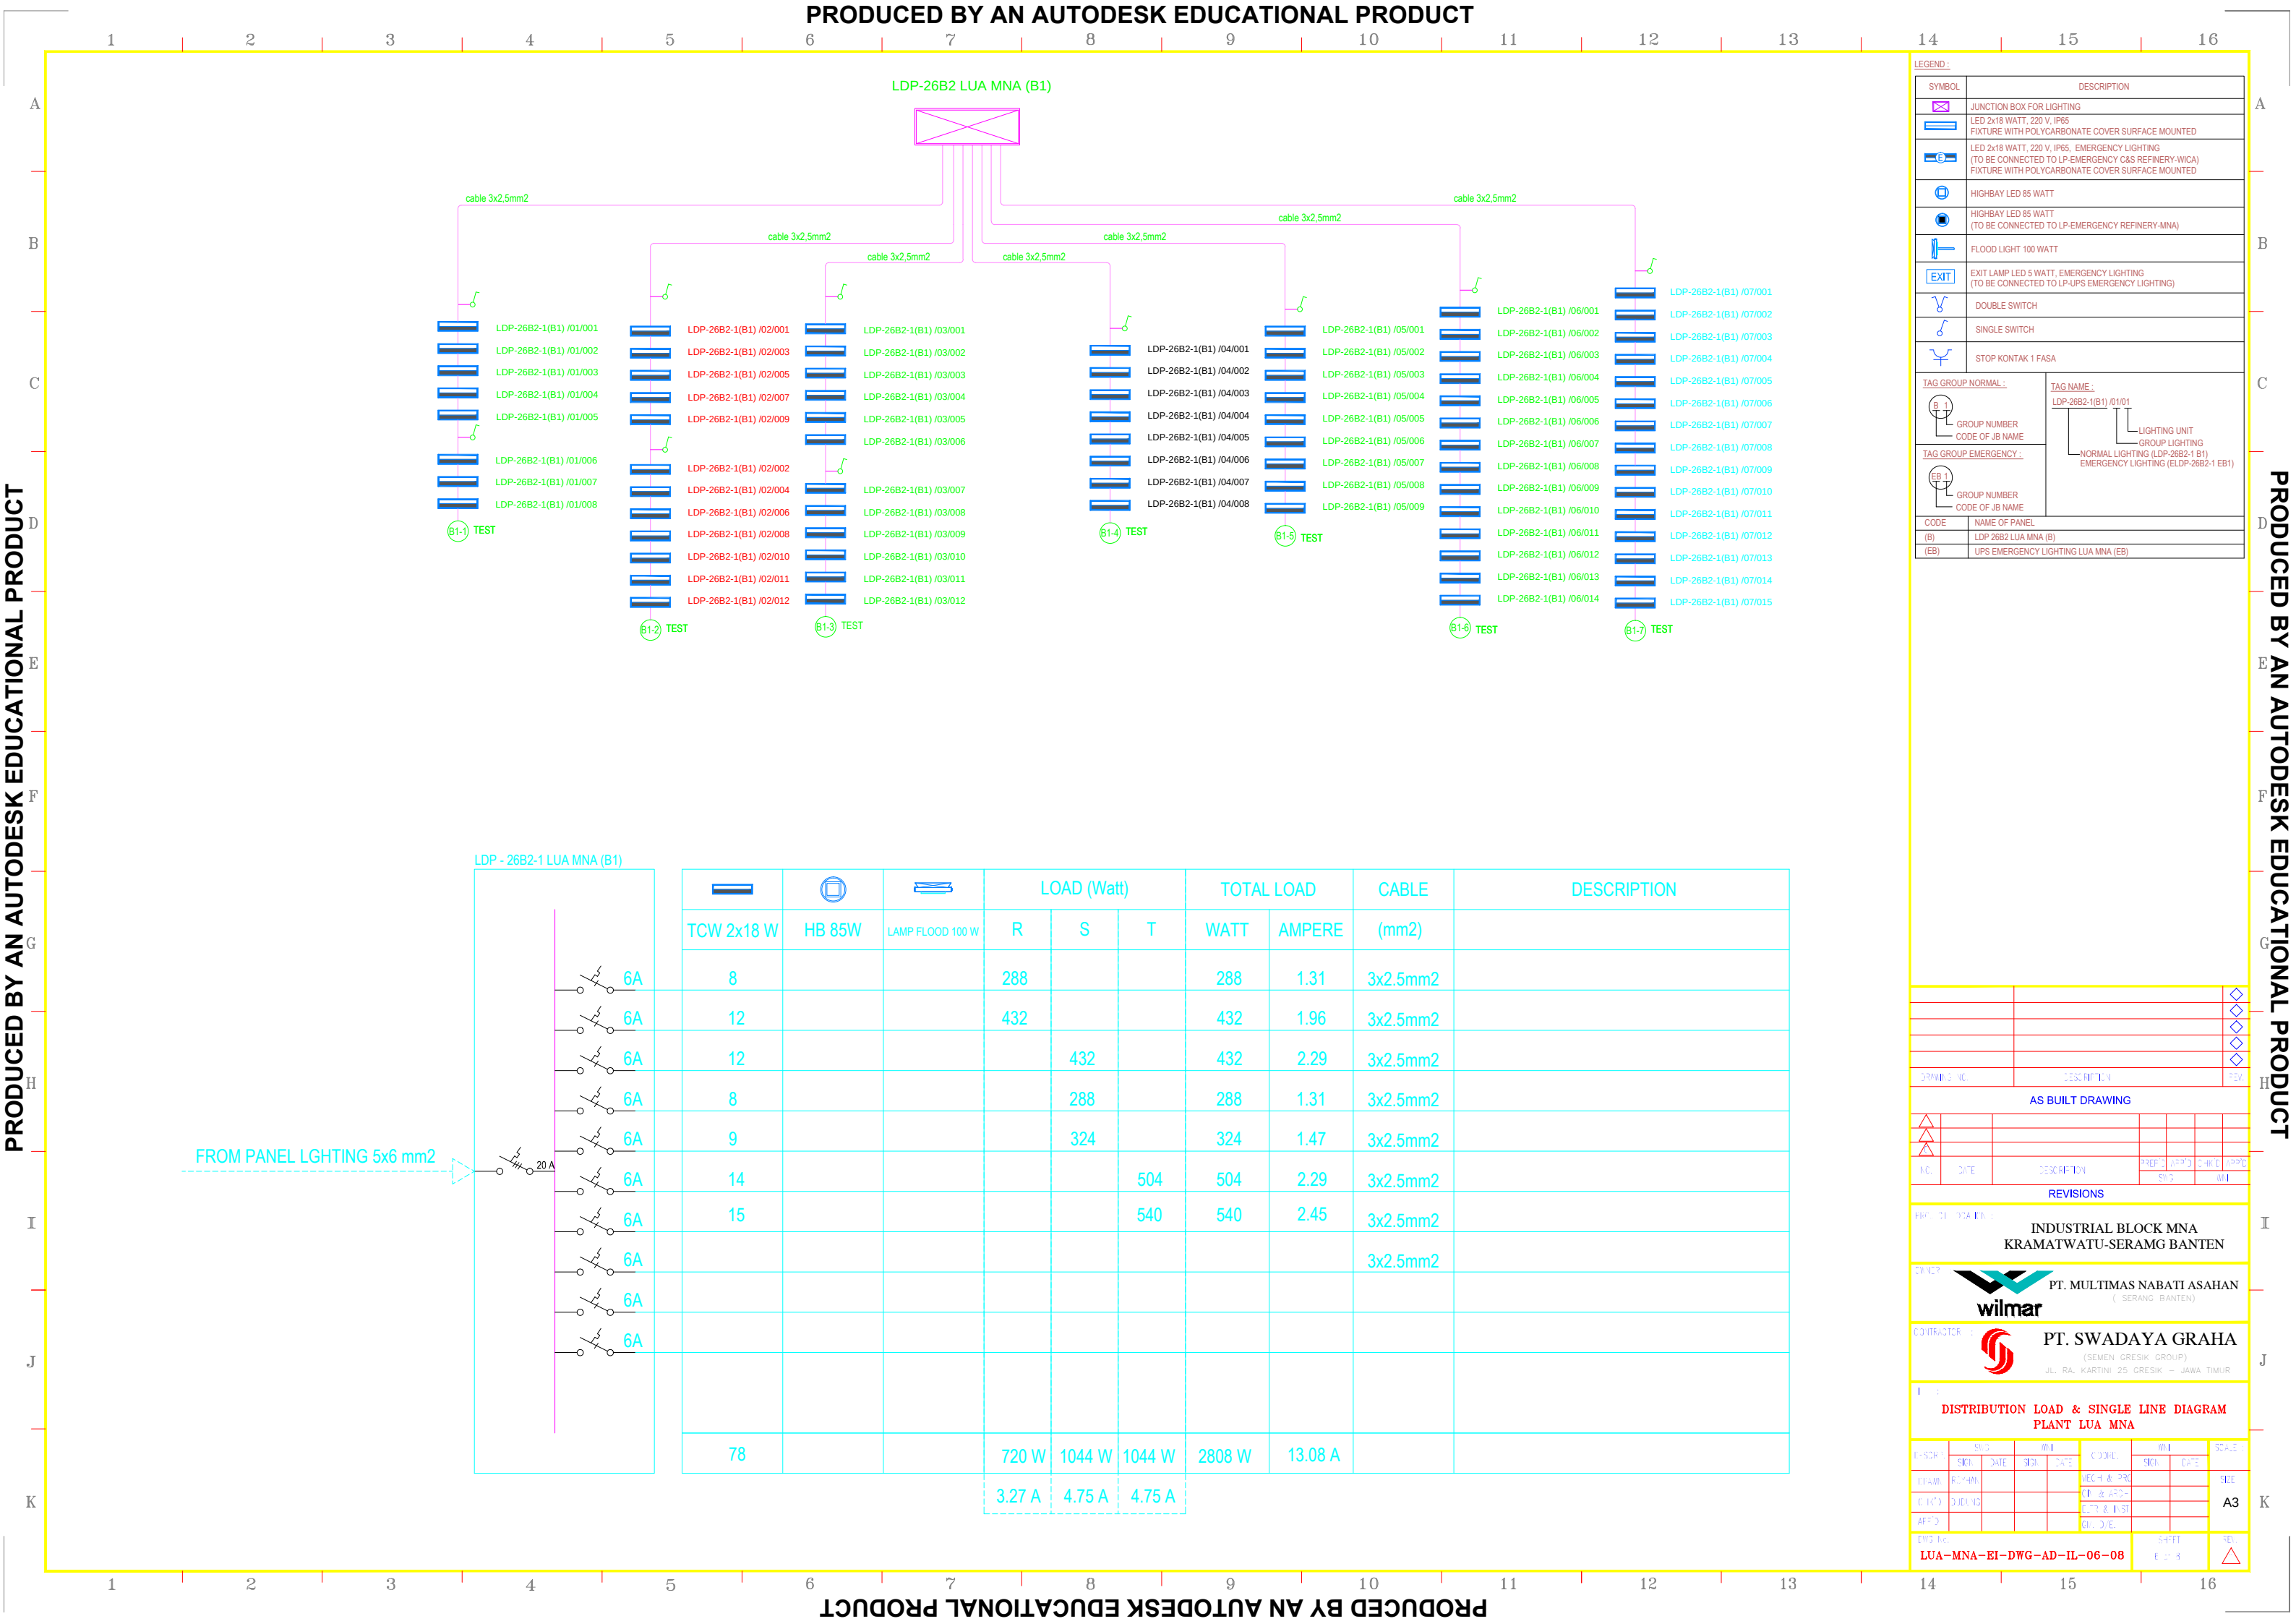

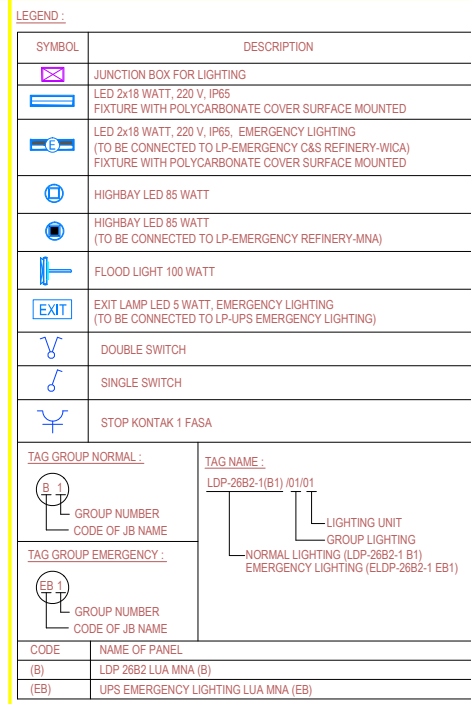[illegible]

[illegible]