

AS BUILT DRAWING LOADING UNLOADING PLANT

NO	TITLE	NO. DRAWING
1	INSTALLATION LIGHTING	LUL-MNA-EI-DWG-AD-IL-01-07
2	LAYOUT CABLE LADDER	LUL-MNA-EI-DWG-AD-CL-01-02
3	LAYOUT PANEL RIO	LUL-MNA-EI-DWG-AD-LP-01-02
4	LAYOUT CCTV	LUL-MNA-EI-DWG-AD-CC-01-02
5	LAYOUT ACCESS DOOR	LUL-MNA-EI-DWG-AD-AD-01-02
6	LAYOUT ACCESS POINT	LUL-MNA-EI-DWG-AD-AP-01-01
7	LAYOUT IPOS	LUL-MNA-EI-DWG-AD-RC-01-01
8	LYOUT REMOTE PANEL	LUL-MNA-EI-DWG-AD-LP-01-01
9	LAYOUT GROUNDING	LUL-MNA-EI-DWG-AD-GRD-01-01
10	GENERAL ARRANGEMENT PANEL	-



SYMBOL		DESCRIPTION
	JUNCTION BOX FOR LIGHTING	
	LED 2x18 WATT, 220 V, IP65 FIXTURE WITH POLYCARBONATE COVER SURFACE MOUNTED	
	LED 2x18 WATT, 220 V, IP65, EMERGENCY LIGHTING (TO BE CONNECTED TO LP-EMERGENCY GAS REFINERY-WICA) FIXTURE WITH POLYCARBONATE COVER SURFACE MOUNTED	
	HIGHBAY LED 85 WATT	
	HIGHBAY LED 85 WATT (TO BE CONNECTED TO LP-EMERGENCY REFINERY-MNA)	
	FLOOD LIGHT 100 WATT	
	EXIT LAMP LED 5 WATT, EMERGENCY LIGHTING (TO BE CONNECTED TO LP-UPS EMERGENCY LIGHTING)	
	DOWNLIGHT 12 WATT	
	DOWNLIGHT 12 WATT EMERGENCY	
	DOUBLE SWITCH	
	SINGLE SWITCH	
	STOP KONTAK 1 FASA	
<u>TAG GROUP NORMAL :</u>  GROUP NUMBER CODE OF JB NAME		<u>TAG NAME :</u> LDP-2742-1(A1) 0/0/01  LIGHTING UNIT GROUP LIGHTING
<u>TAG GROUP EMERGENCY :</u>  GROUP NUMBER CODE OF JB NAME		NORMAL LIGHTING (LDP-2742-1 A1) EMERGENCY LIGHTING (ELDP-2742-1 EA1)
CODE	NAME OF PANEL	
(A)	LDP 2742 LOADING UNLOADING (A)	
(EA)	UPS EMERGENCY LIGHTING LOADING UNLOADING (EA)	

		◇
		◇
		◇
		◇
DRAWING NO.	DESCRIPTION	REV.

AS BUILT DRAWING							
△							
△							
△							
NO.	DATE	DESCRIPTION	PREP'D SWG	APP'D	CHK'D WNI	APP'D	
REVISIONS							


PROJECT LOCATION :
INDUSTRIAL BLOCK MNA
KRAMATWATU-SERAMG BANTEN

CONTRACTOR :  **PT. MULTIMAS NABATI ASAHAN**
(SERANG BANTEN)

CONTRACTOR :  **PT. SWADAYA GRAHA**
(SEMEN GRESIK GROUP)
JL. RA. KARTINI 25 GRESIK - JAWA TIMUR

INSTALLATION LIGHTING LOADING UNLOADING
PANEL ROOM & OFFICE EL.4.000

DESCR.	SWG		WNI		COORD.	WNI		SCALE :
	SIGN	DATE	SIGN	DATE		SIGN	DATE	
DRAWN					MECH & PRO			SIZE A3
CHK'D					CIV & ARCH			
APP'D					ELTR & INST			
					GM. D/E.			
DWG No.					SHEET			REV.
LUL-EI-DWG-AD-IL-01-07					1 of 7			
								

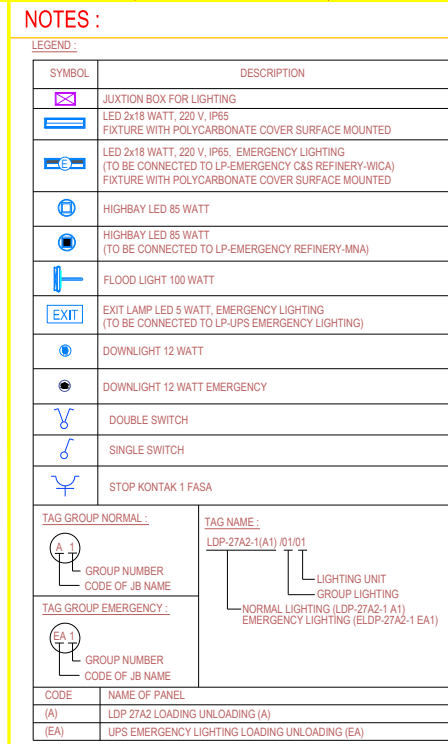


DRAWING NO.	DESCRIPTION


PROJECT LOCATION : INDUSTRIAL BLOCK MNA
KRAMATWATU-SERAMG BANTEN

CONTRACTOR :  **PT. SWADAYA GRAHA**
(SEMEN GRESIK GROUP)
Jl. RA. KARTINI 25, GRESIK - JAWA TIMUR

DESCRIP.	SWG		WNI		COORD.	WNI		SCA
	SIGN	DATE	SIGN	DATE		SIGN	DATE	
DRAWN					MECH & PRO			SI
checked					CIV & ARCH			

CHK'D				ELTR & INST		
APP'D				GM. D/E.		
DWG. No.					SHEET	
LUL-EI-DWG-AD-IL-02-07					2 of 7	

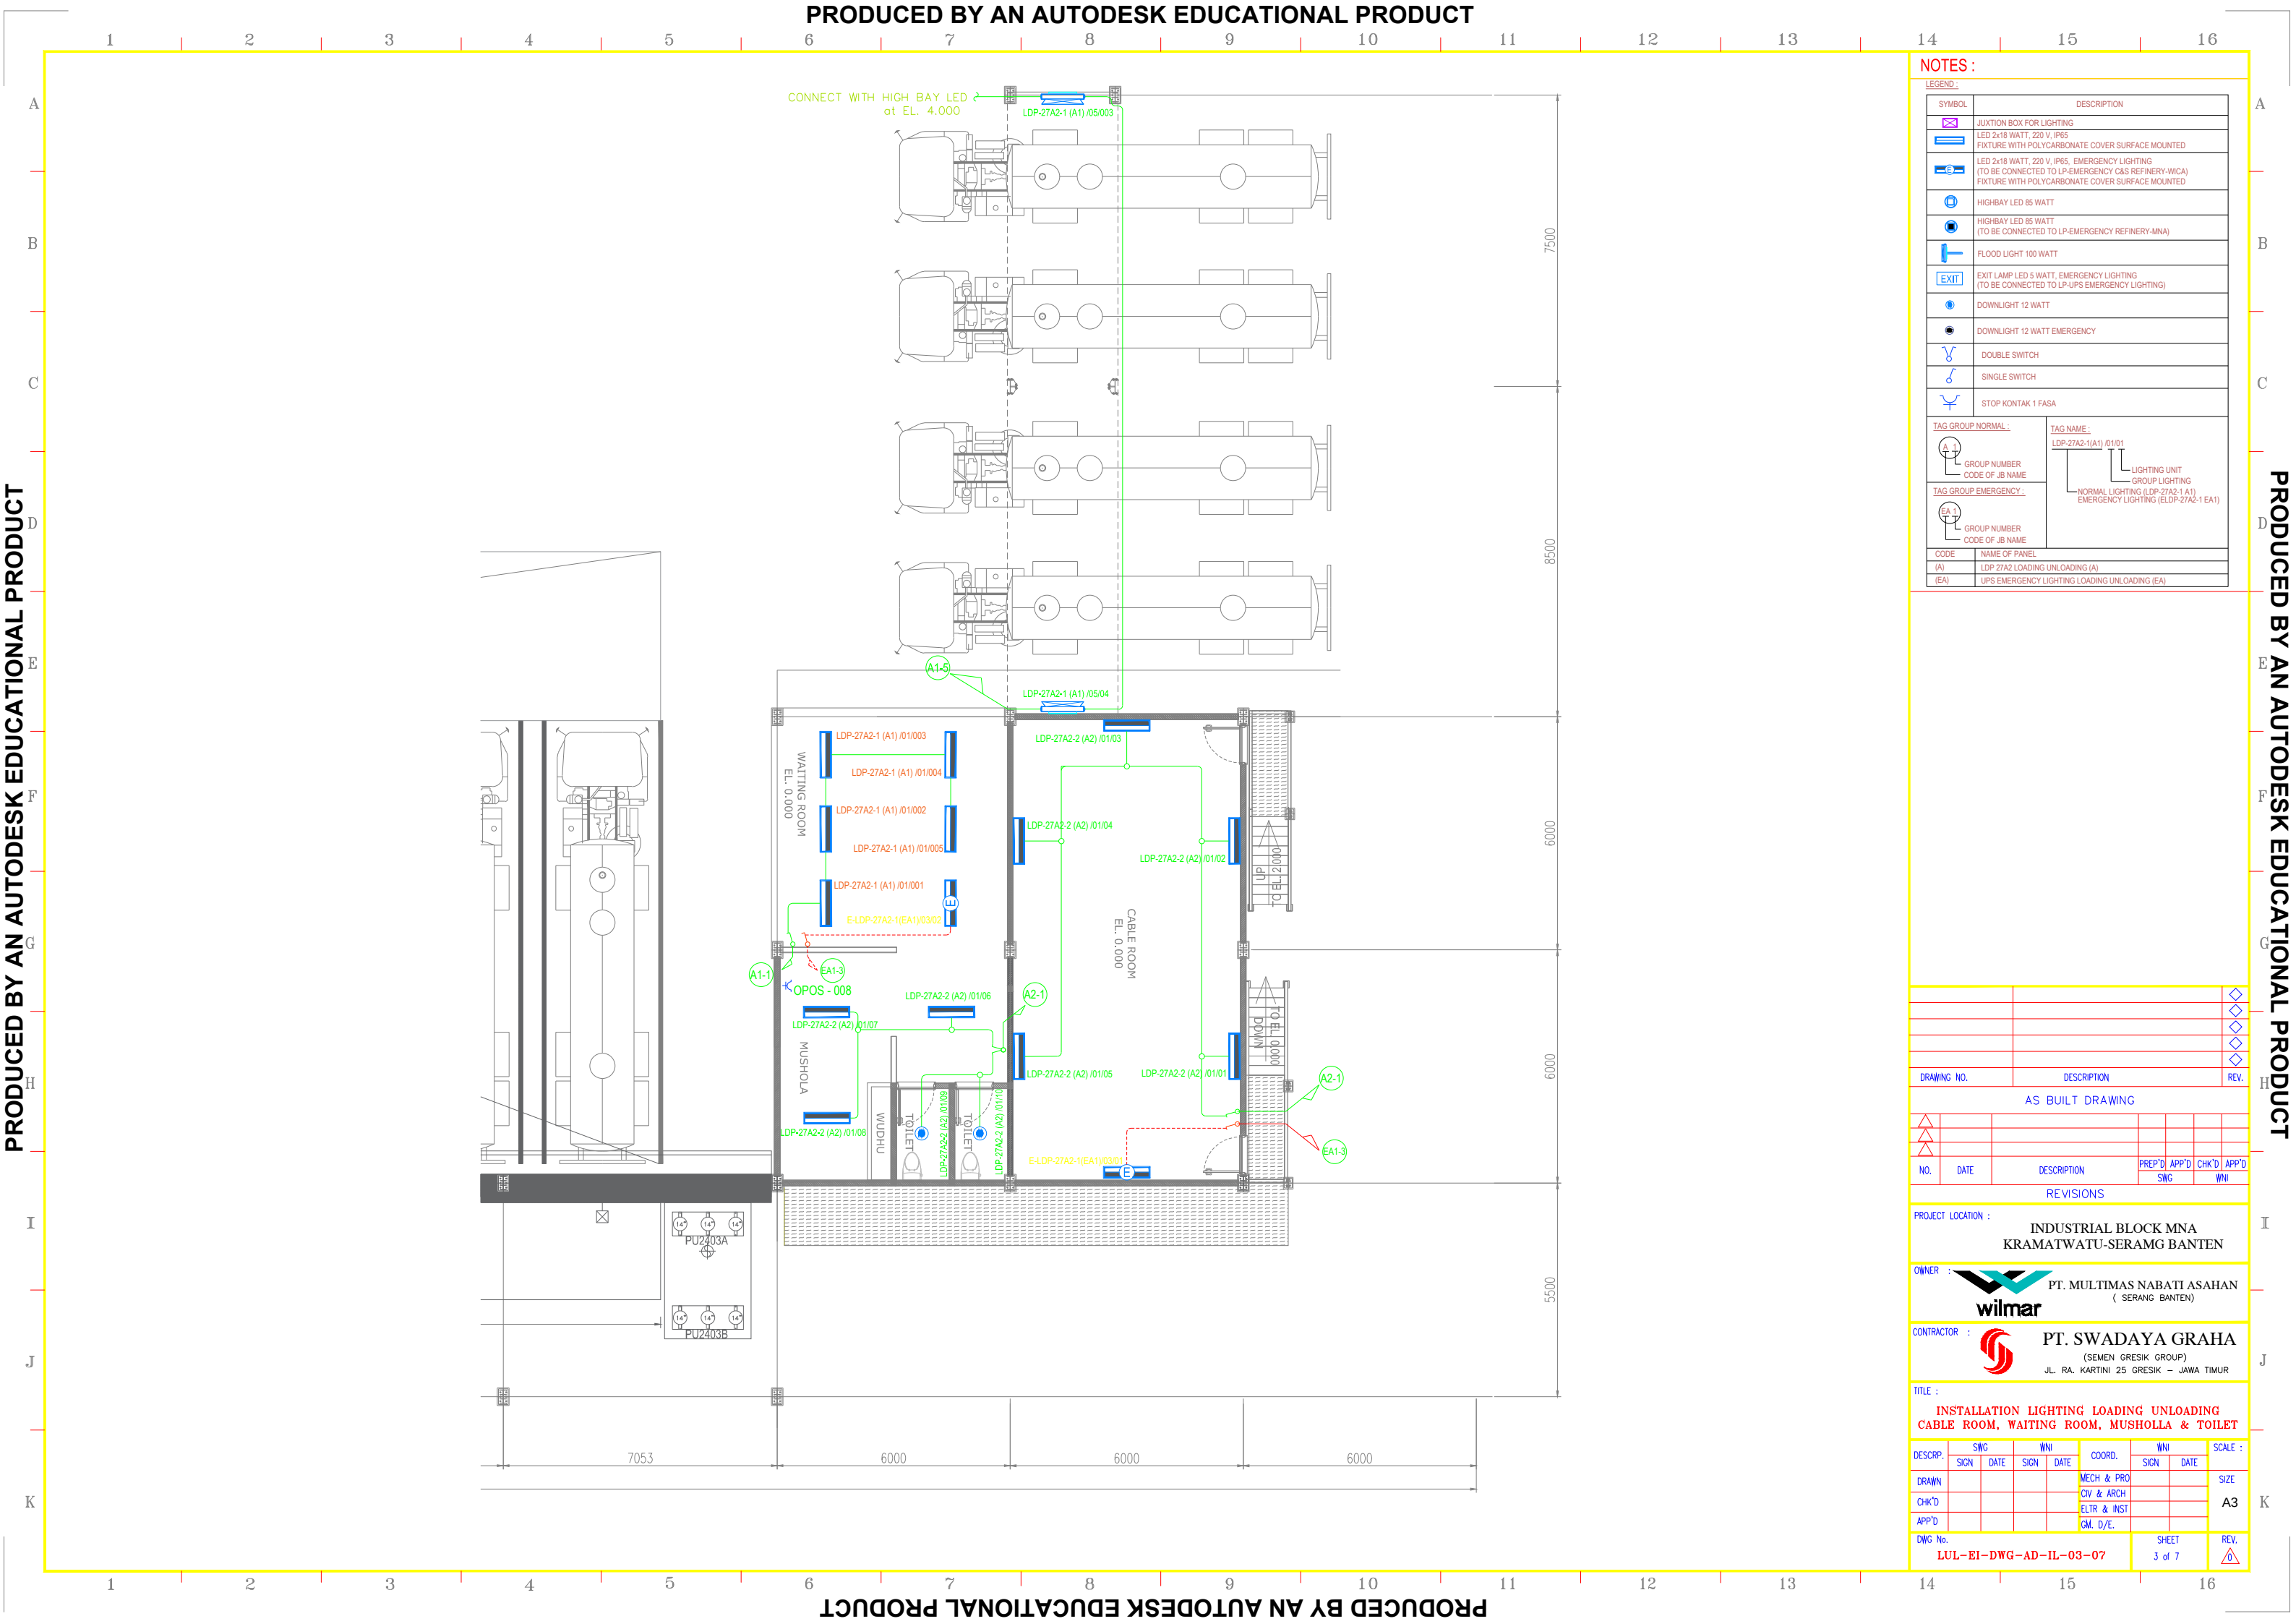

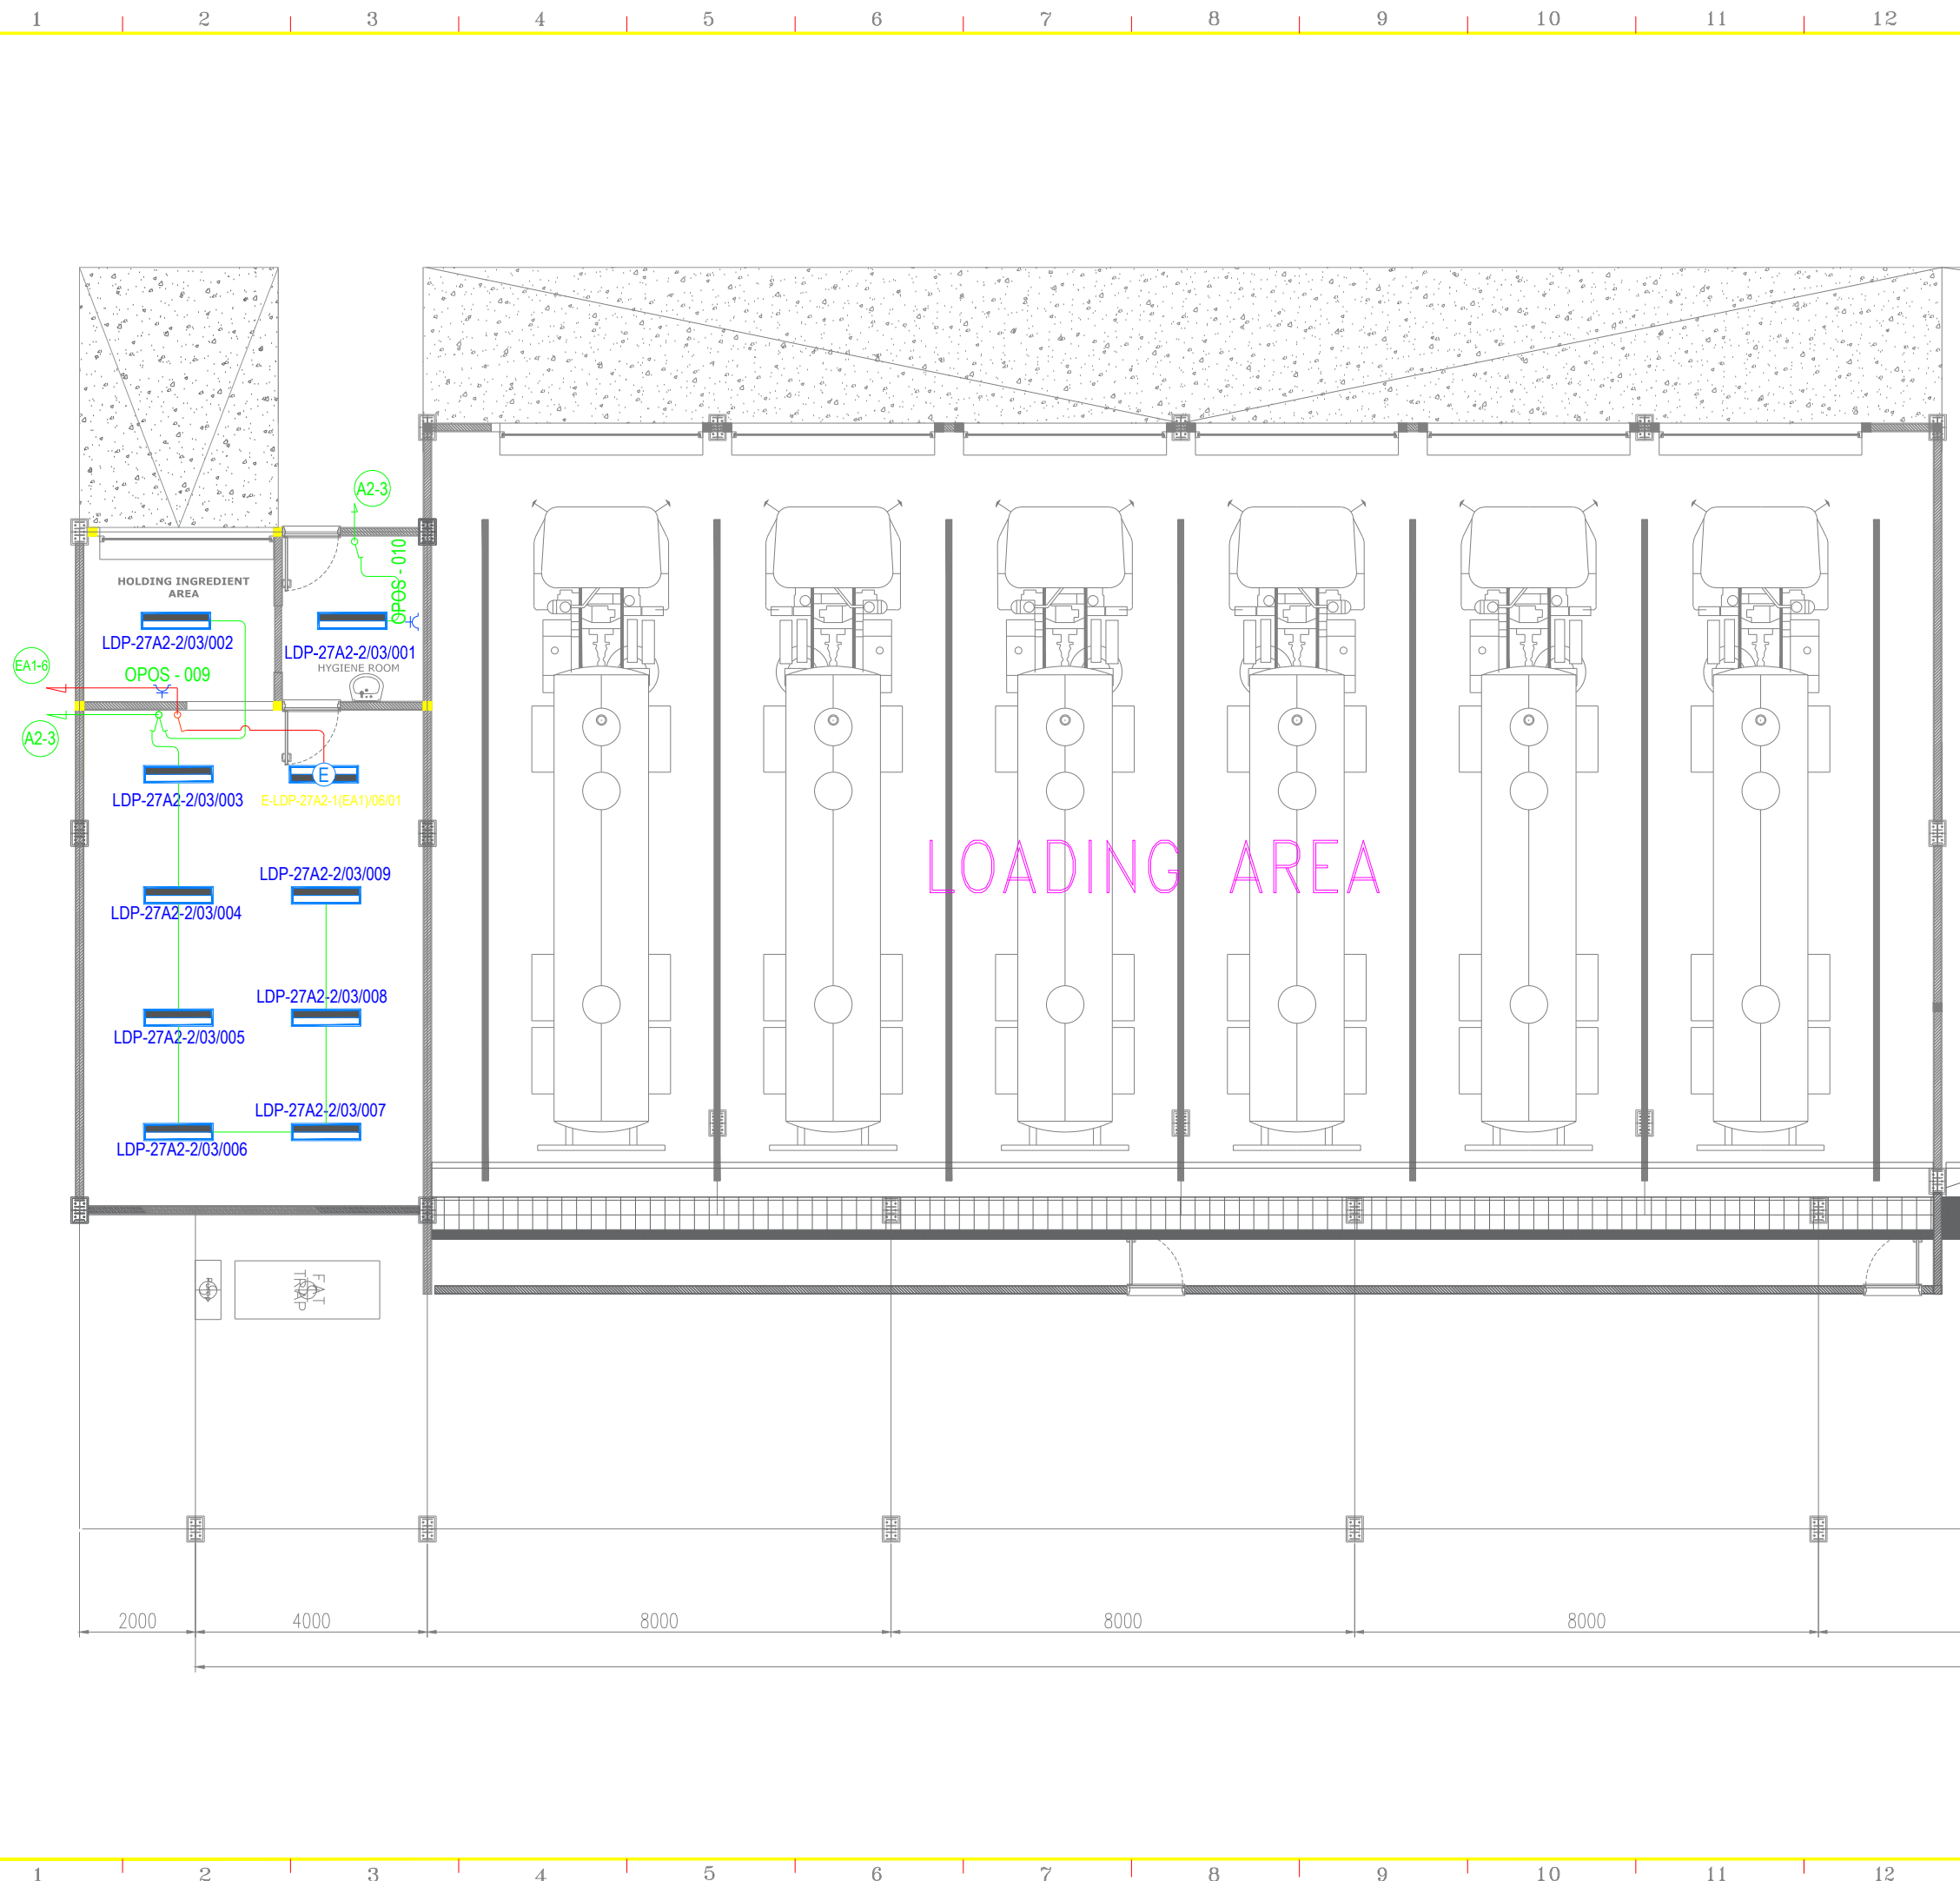

NOTES :

SYMBOL		DESCRIPTION
	JUNCTION BOX FOR LIGHTING	
	LED 2x18 WATT, 220 V, IP65 FIXTURE WITH POLYCARBONATE COVER SURFACE MOUNTED	
	LED 2x18 WATT, 220 V, IP65, EMERGENCY LIGHTING (TO BE CONNECTED TO LP-EMERGENCY C&S REFINERY-WICA) FIXTURE WITH POLYCARBONATE COVER SURFACE MOUNTED	
	HIGHBAY LED 85 WATT	
	HIGHBAY LED 85 WATT (TO BE CONNECTED TO LP-EMERGENCY REFINERY-MNA)	
	FLOOD LIGHT 100 WATT	
	EXIT LAMP LED 5 WATT, EMERGENCY LIGHTING (TO BE CONNECTED TO LP-UPS EMERGENCY LIGHTING)	
	DOWNLIGHT 12 WATT	
	DOWNLIGHT 12 WATT EMERGENCY	
	DOUBLE SWITCH	
	SINGLE SWITCH	
	STOP KONTAK 1 FASA	
TAG GROUP NORMAL :  GROUP NUMBER CODE OF JB NAME		TAG NAME : LDP-27A2-1(A1) /01/01  LIGHTING UNIT (GROUP LIGHTING)
TAG GROUP EMERGENCY :  GROUP NUMBER CODE OF JB NAME		NORMAL LIGHTING (LDP-27A2-1 A1) EMERGENCY LIGHTING (ELDP-27A2-1 EA1)
CODE	NAME OF PANEL	
(A)	LDP 27A2 LOADING UNLOADING (A)	
(EA)	UPS EMERGENCY LIGHTING LOADING UNLOADING (EA)	

		◆
		◆
DRAWING NO.	DESCRIPTION	REV.

△					
△					
NO.	DATE	DESCRIPTION	PREP'D SWG	APP'D	CHK'D WNI

PROJECT LOCATION : **INDUSTRIAL BLOCK MNA
KRAMATWATU-SERAMG BANTEN**


OWNER :  **PT. MULTIMAS NABATI ASAHAN**
(SERANG BANTEN)


CONTRACTOR :  **PT. SWADAYA GRAHA**
(SEMEN GRESIK GROUP)

TITLE :

**INSTALLATION LIGHTING LOADING UNLOADING
PLANT, HOLDING INGREDIENT & HYGIENE ROOM**

DESCR.	SIGN	DATE	SIGN	DATE	COORD.	SIGN	DATE	SIZE
DRAWN					MECH & PRO			A3
CHK'D					CIV & ARCH			
APP'D					ELTR & INST			
DWG No.								
LUL-EI-DWG-AD-IL-04-07						SHEET 4 of 7		REV. 0

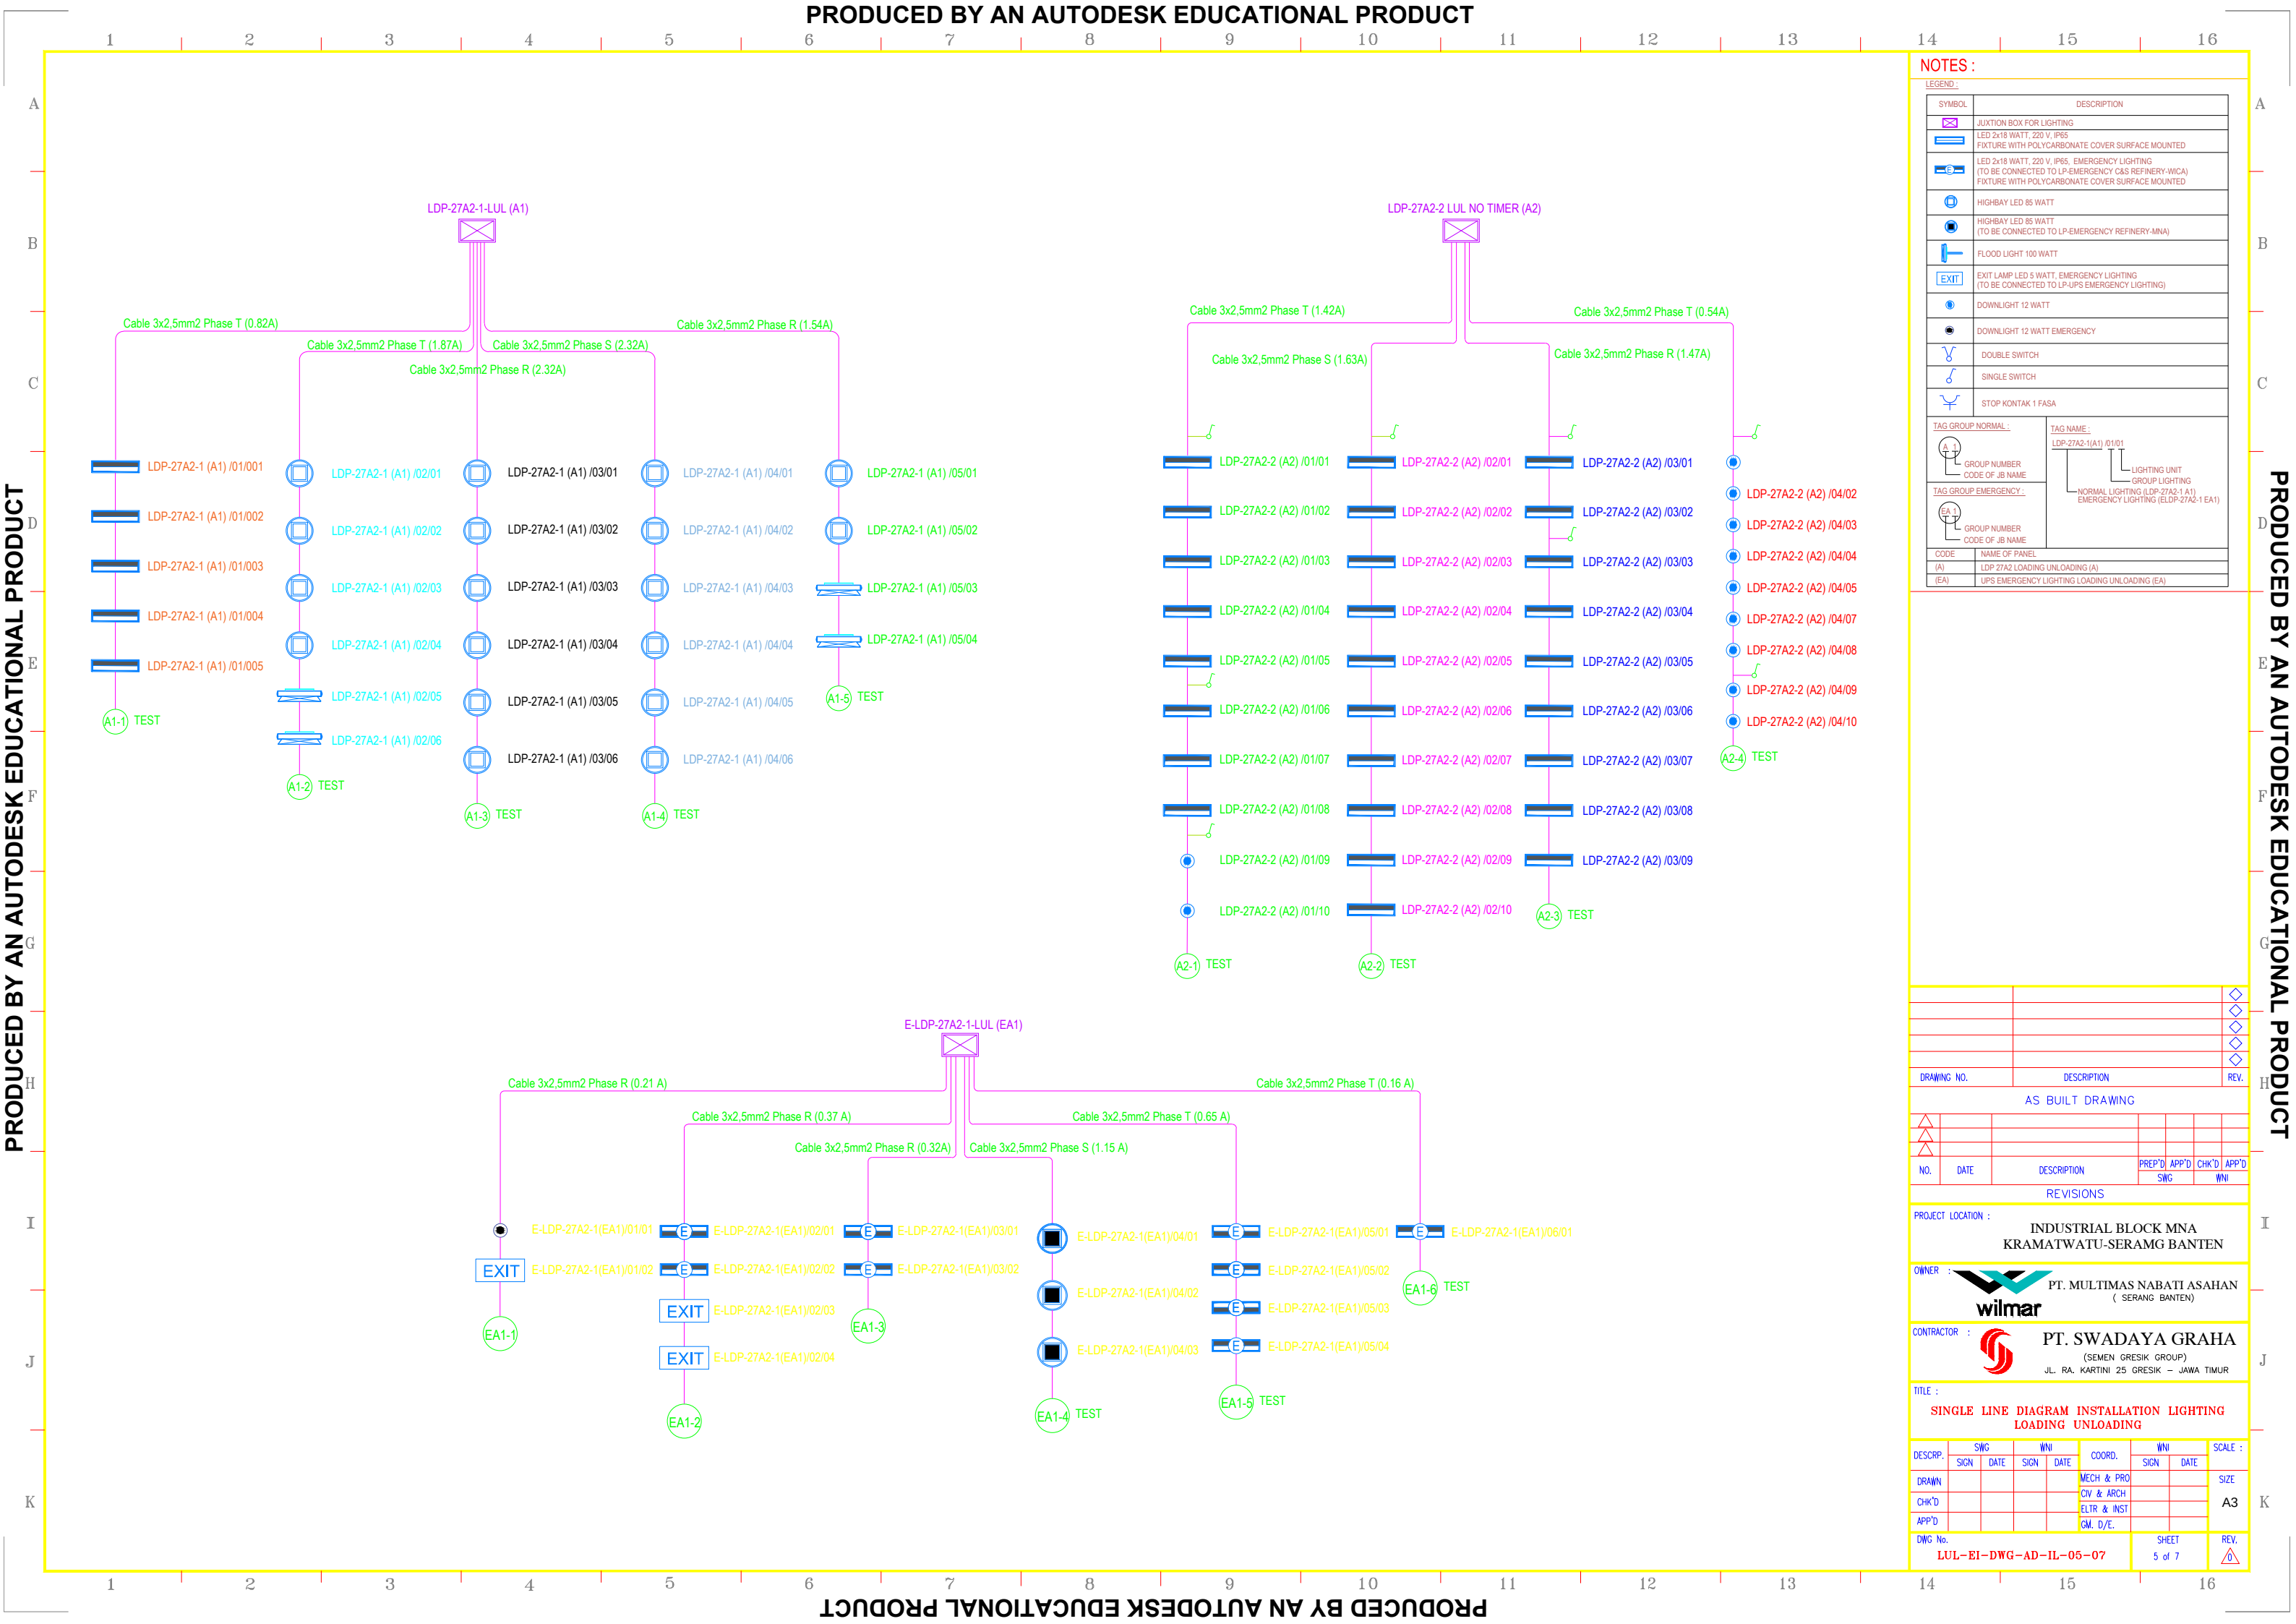

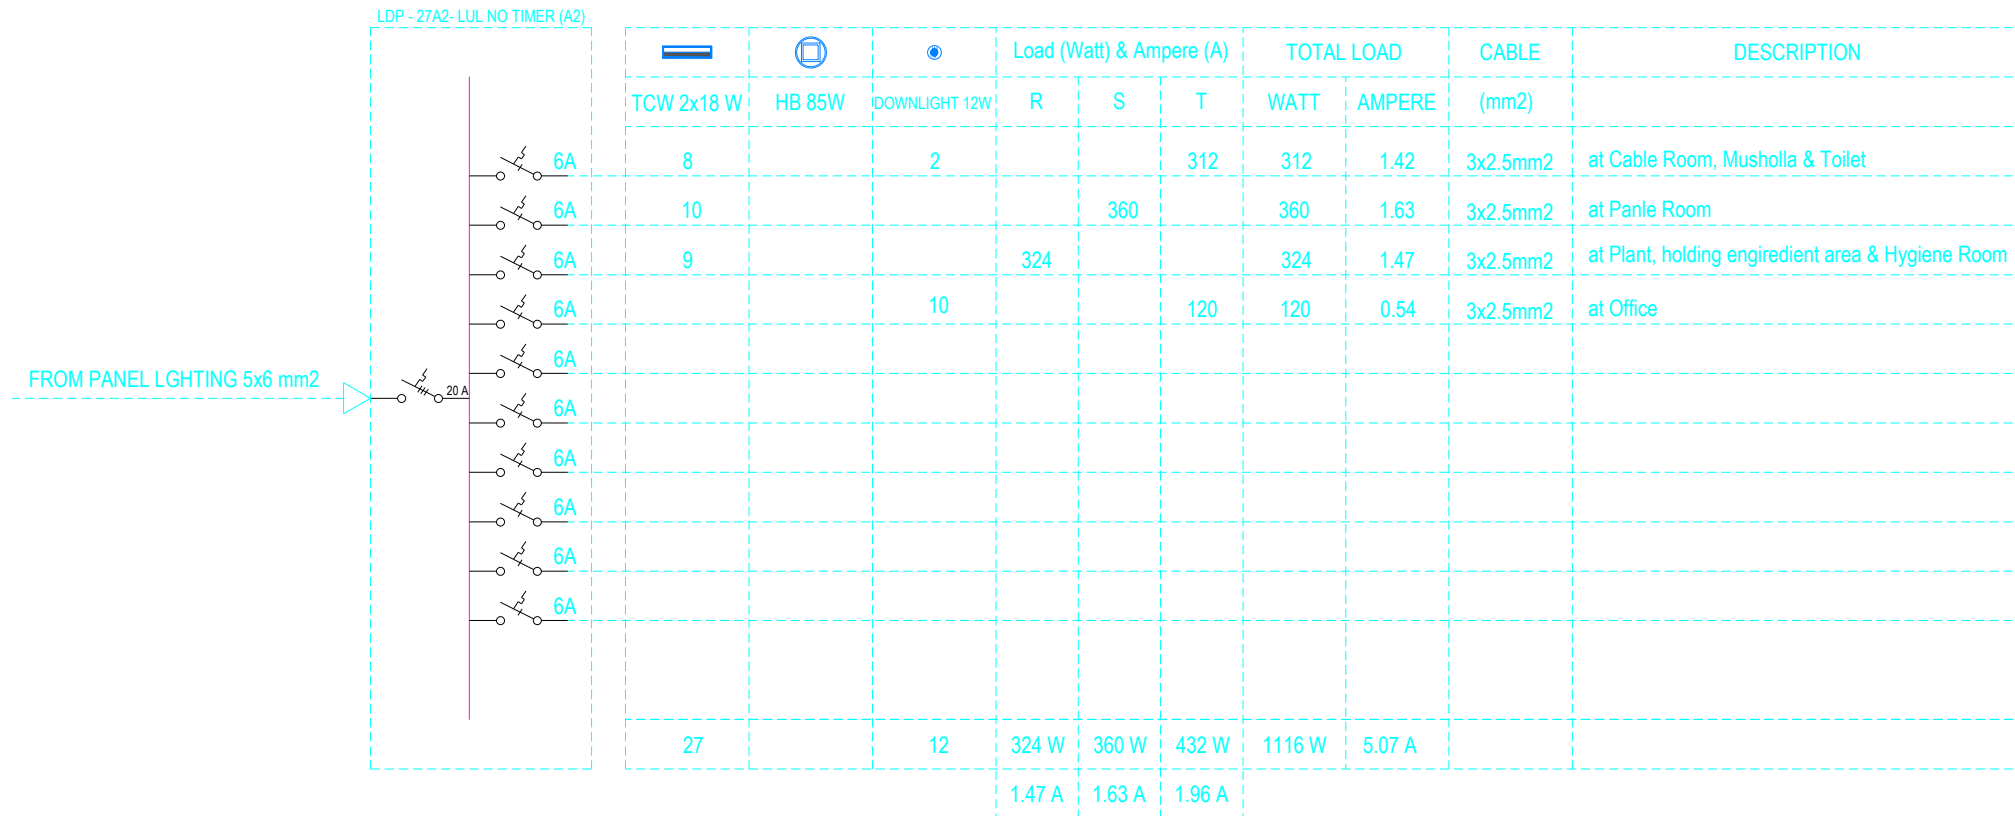

DRAWING NO.	DESCRIPTION

PROJECT LOCATION : INDUSTRIAL BLOCK MNA
KRAMATWATU-SERAMG BANTEN

CONTRACTOR :  PT. SWADAYA GRAHA

TITLE :
DISTRIBUTION LOAD INSTALLATION LIGHTING
LOADING UNLOADING

APP D				GM. D/E.		
DWG No. LUL-EI-DWG-AD-IL-06-07					SHEET 6 of 7	



DRAWING NO.	DESCRIPTION

AS BUILT DRAWING						
NO.	DATE	DESCRIPTION	PREP'D SWG	APP'D	CHK'D	WN
△						
△						
△						

PROJECT LOCATION : **INDUSTRIAL BLOCK MNA
KRAMATWATU-SERAMG BANTEN**

OWNER :  **PT. MULTIMAS NABATI ASAHA**
(SERANG BANTEN)

CONTRACTOR :  **PT. SWADAYA GRAHA**
(SEMEN GRESIK GROUP)
JL. RA. KARTINI 25 GRESIK – JAWA TIMUR

TITLE : DISTRIBUTION LOAD INSTALLATION LIGHTING LOADING UNLOADING								
DESCRIP.	SWG		WNI		COORD.	WNI		SCALE
	SIGN	DATE	SIGN	DATE		SIGN	DATE	
DRAWN					MECH & PRO			SHEET
CHK'D					CIV & ARCH			7 of 7
APP'D					ELTR & INST			
					GM. D/E.			
DWG No. LUL-EI-DWG-AD-IL-07-07						SHEET 7 of 7		