
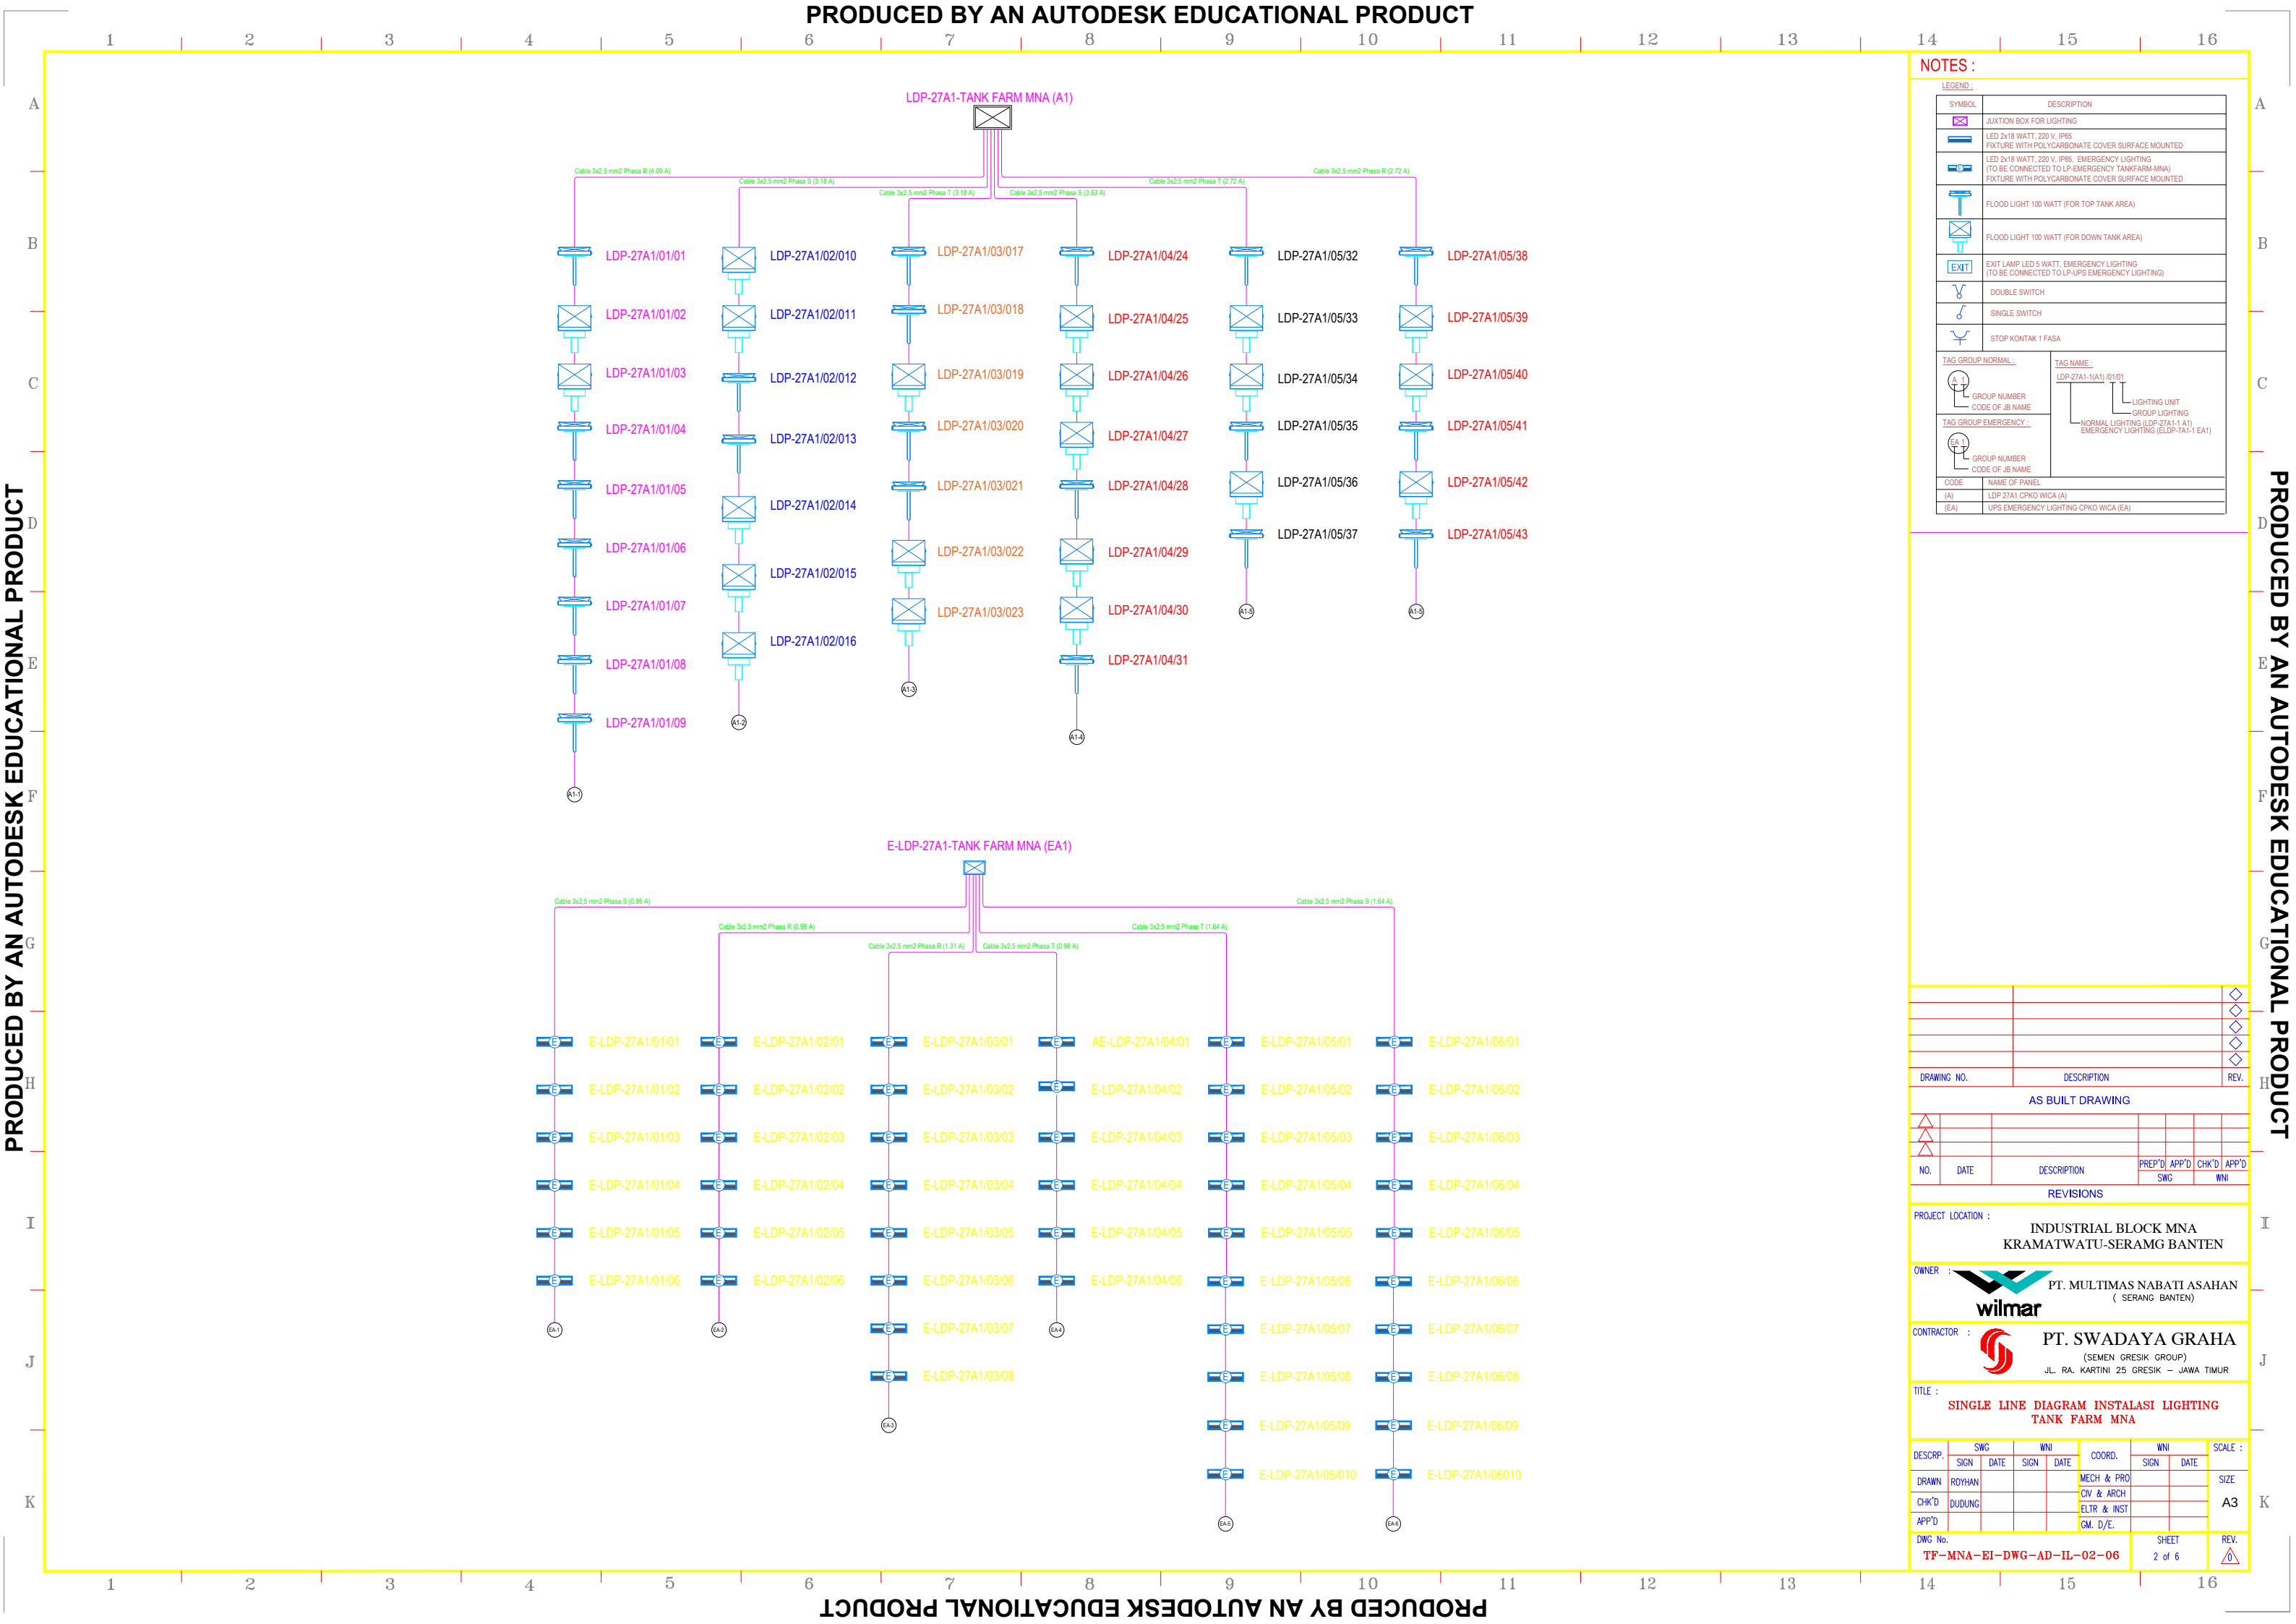
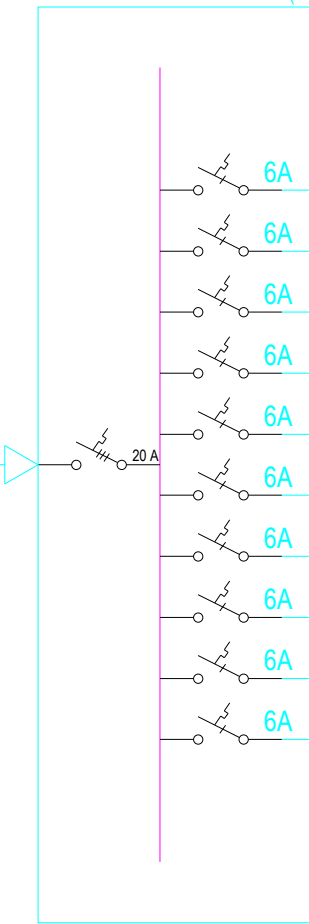


AS BUILT DRAWING TANK FARM MNA PLANT


NO	TITLE	NO. DRAWING
1	INSTALLATION LIGHTING	TF-MNA-EI-DWG-AD-IL-01-06
2	LAYOUT CABLE LADDER	TF-MNA-EI-DWG-AD-CL-01-06
3	LAYOUT PANEL RIO	TF-MNA-EI-DWG-AD-LP-01-02
4	LAYOUT CCTV	TF-MNA-EI-DWG-AD-CC-01-02
5	LAYOUT ACCESS DOOR	TF-MNA-EI-DWG-AD-AD-01-01
6	LAYOUT ACCESS POINT	TF-MNA-EI-DWG-AD-AP-01-01
7	LAYOUT IPOS	TF-MNA-EI-DWG-AD-RC-01-01
8	LAYOUT REMOTE PANEL	TF-MNA-EI-DWG-AD-LP-01-02
9	LAYOUT GROUNDING	TF-MNA-EI-DWG-AD-GRD-01-03
10	GENERAL ARRANGEMENT PANEL	-

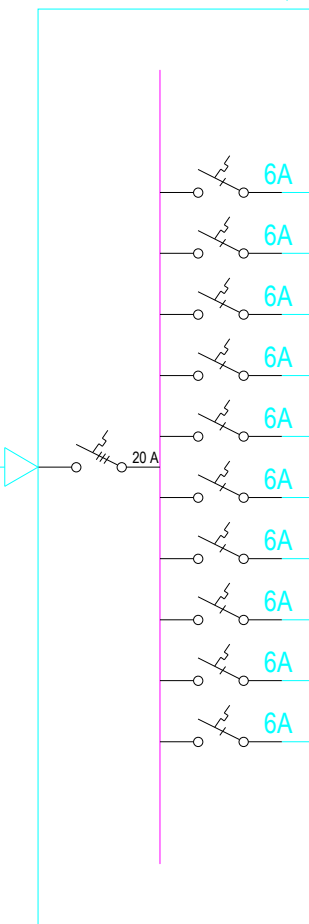

E-LDP - 27A1-1 TANKFARM MNA (EA1)

FROM UPS LGHTING 5x16 mm2

A horizontal number line with tick marks at 14, 15, and 16. The segment between 14 and 15 is labeled "14 to 15" and the segment between 15 and 16 is labeled "15 to 16".

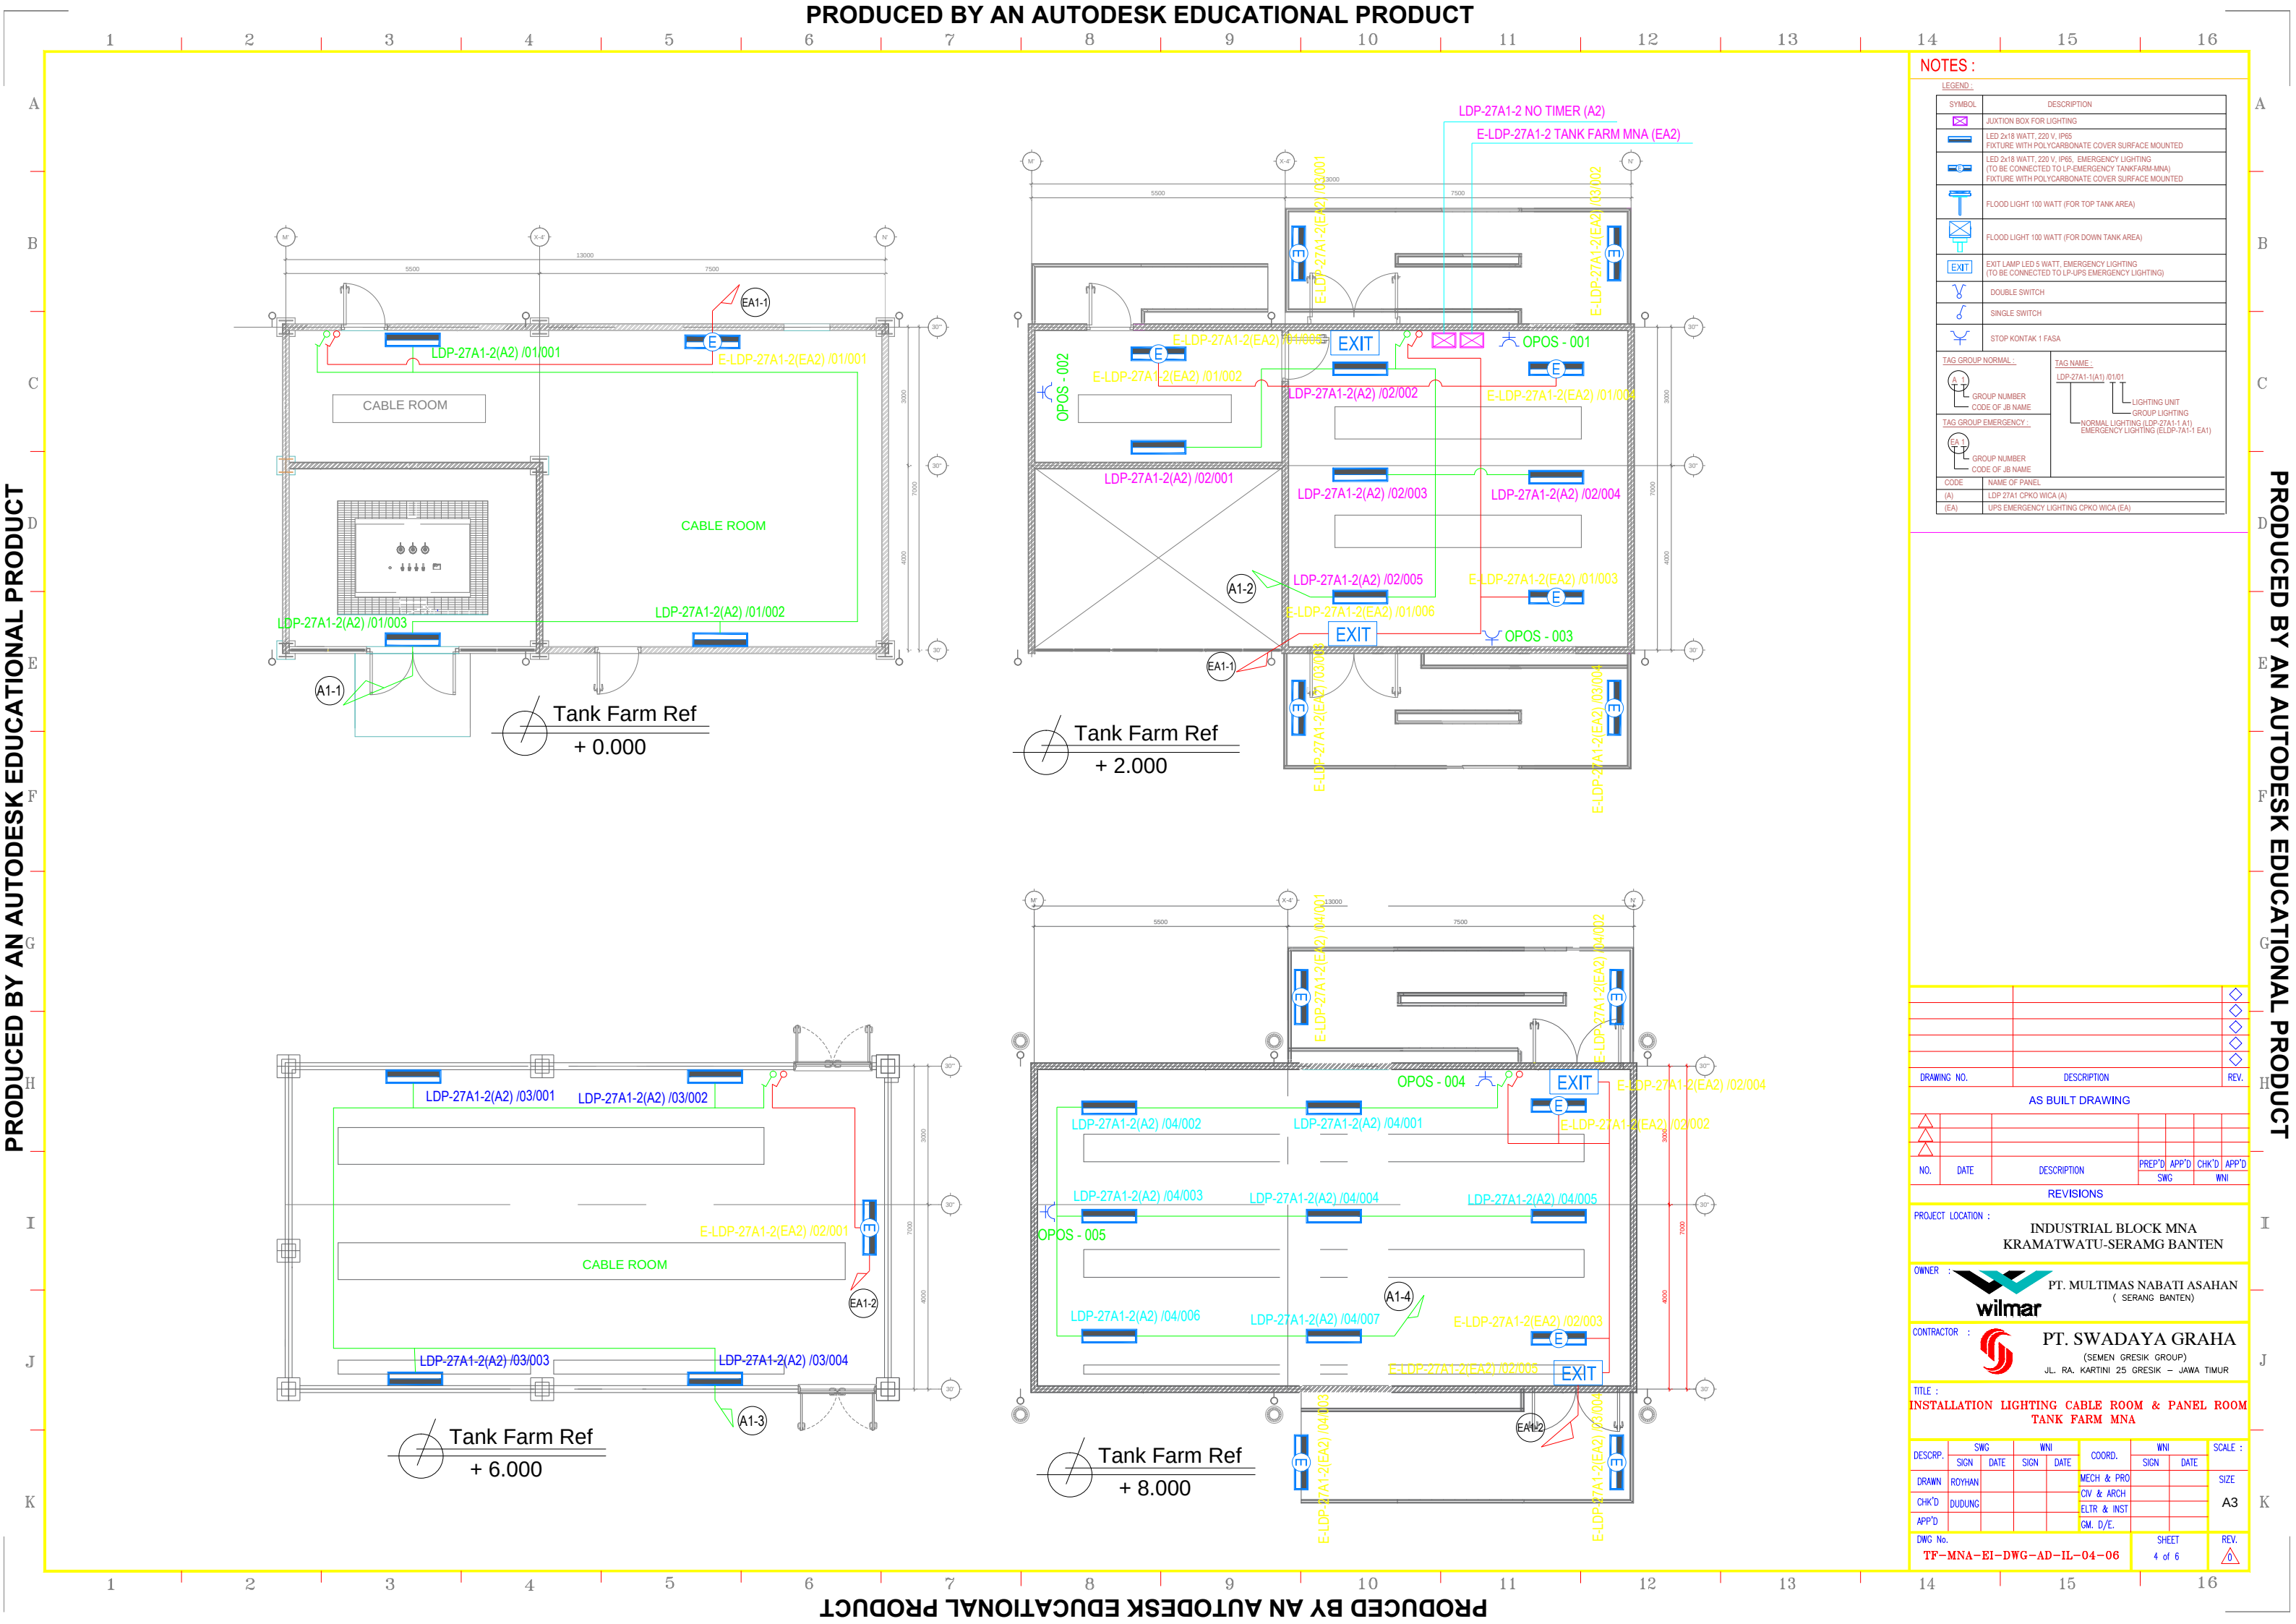


LEGEND :	
SYMBOL	DESCRIPTION
	JUNCTION BOX FOR LIGHTING
	LED 2x18 WATT, 220 V, IP65, FIXTURE WITH POLYCARBONATE COVER SURFACE MOUNTED
	LED 2x18 WATT, 220 V, IP65, EMERGENCY LIGHTING (TO BE CONNECTED TO LP-EMERGENCY TANKFARM-MNA) FIXTURE WITH POLYCARBONATE COVER SURFACE MOUNTED
	FLOOD LIGHT 100 WATT (FOR TOP TANK AREA)
	FLOOD LIGHT 100 WATT (FOR DOWN TANK AREA)
	EXIT LAMP LED 5 WATT, EMERGENCY LIGHTING (TO BE CONNECTED TO LP-UPS EMERGENCY LIGHTING)
	DOUBLE SWITCH
	SINGLE SWITCH
	STOP KONTAK 1 FASA
TAG GROUP NORMAL :	
	GROUP NUMBER CODE OF JB NAME
TAG GROUP EMERGENCY :	
	GROUP NUMBER CODE OF JB NAME
TAG NAME :	
LDP-27A1-1(A1) /01/01	
LIGHTING UNIT GROUP LIGHTING NORMAL LIGHTING (LDP-27A1-1 A1) EMERGENCY LIGHTING (E-LDP-27A1-1 EA1)	
CODE	NAME OF PANEL
(A)	LDP 27A1 CPKO WICA (A)
(EA)	UPS EMERGENCY LIGHTING CPKO WICA (EA)

DRAWING NO.	DESCRIPTION	REV.

AS BUILT DRAWING					

REVISIONS					

TITLE :										INSTALLATION LIGHTING CABLE ROOM & PANEL ROOM TANK FARM MNA									
DESCRIP.		SWG		WNI		COORD.		WNI		SCALE :									
		SIGN	DATE	SIGN	DATE			SIGN	DATE										
DRAWN		ROYHAN						MECH & PRO		SHEET 4 of 6									
CHK'D		DUDUNG						CIV & ARCH											
APP'D								ELTR & INST											
								GM. D/E.											
DWG No.		TF-MNA-EI-DWG-AD-IL-04-06										REV.							

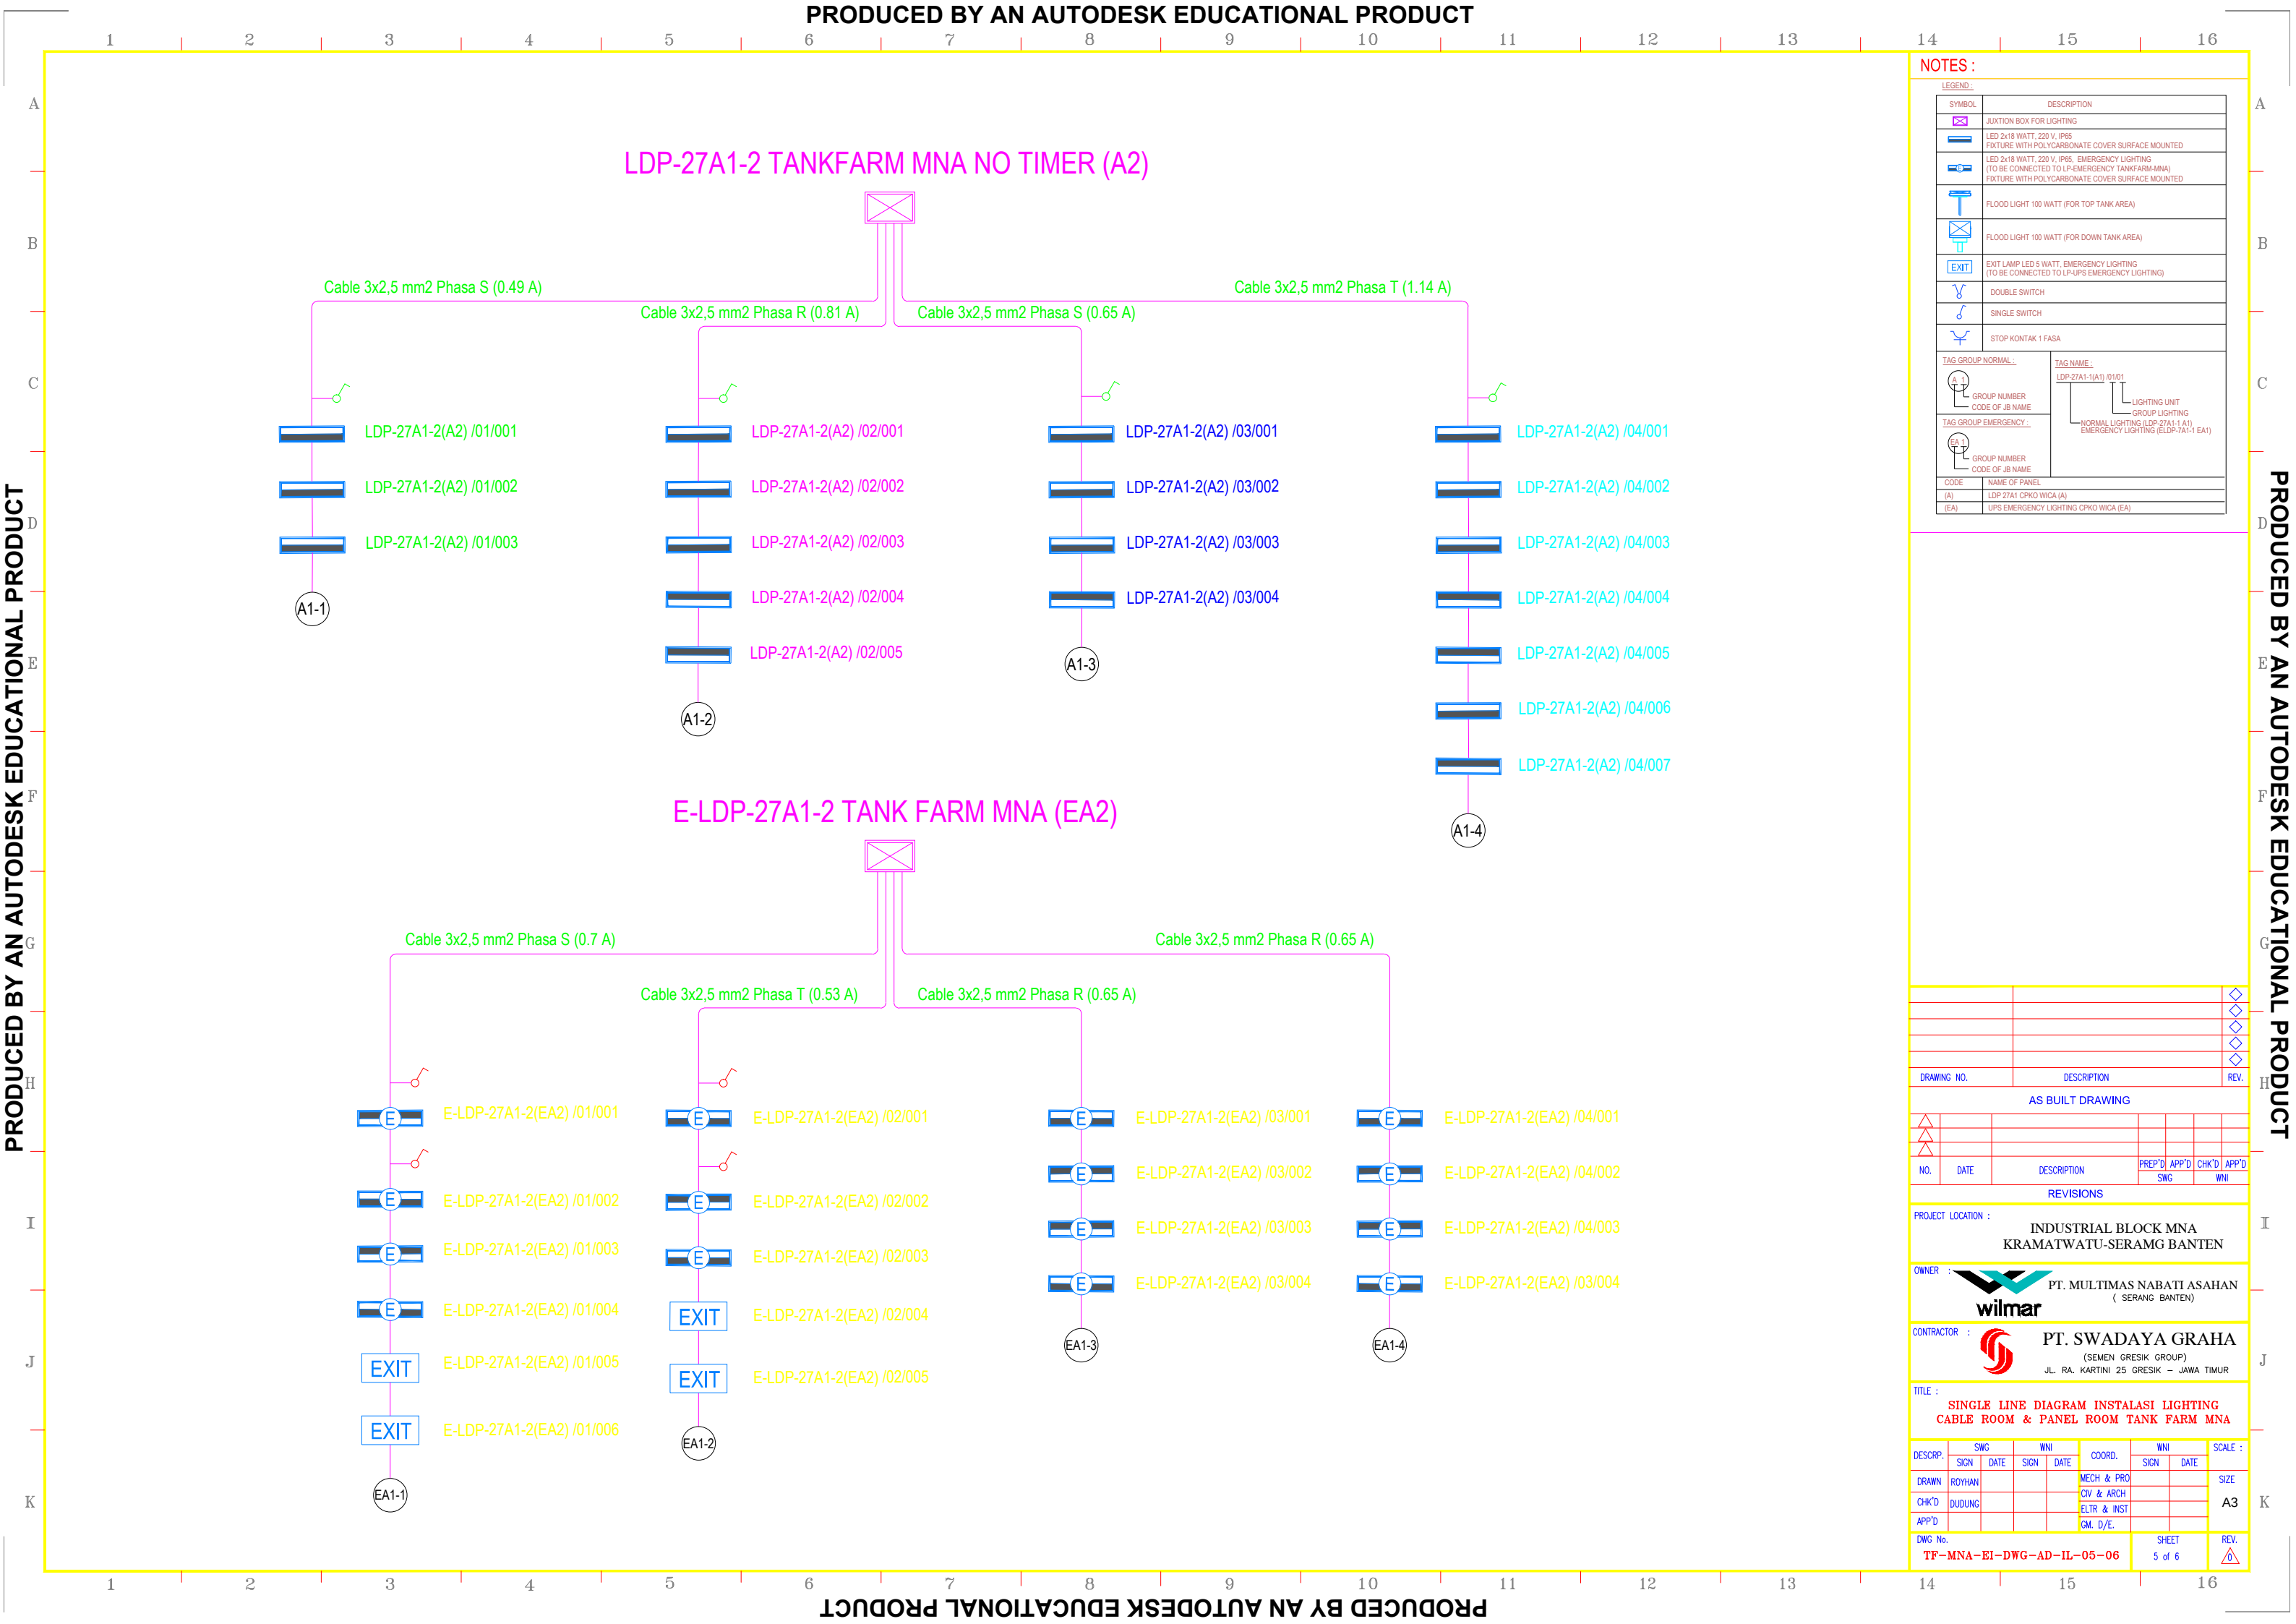

LEGEND :	
SYMBOL	DESCRIPTION
	JUNCTION BOX FOR LIGHTING
	LED 2x18 WATT, 220 V, IP65, FIXTURE WITH POLYCARBONATE COVER SURFACE MOUNTED
	LED 2x18 WATT, 220 V, IP65, EMERGENCY LIGHTING (TO BE CONNECTED TO LP-EMERGENCY TANKFARM-MNA) FIXTURE WITH POLYCARBONATE COVER SURFACE MOUNTED
	FLOOD LIGHT 100 WATT (FOR TOP TANK AREA)
	FLOOD LIGHT 100 WATT (FOR DOWN TANK AREA)
	EXIT LAMP LED 5 WATT, EMERGENCY LIGHTING (TO BE CONNECTED TO LP-UPS EMERGENCY LIGHTING)
	DOUBLE SWITCH
	SINGLE SWITCH
	STOP KONTAK 1 FASA
TAG GROUP NORMAL :	
	GROUP NUMBER CODE OF JB NAME
TAG GROUP EMERGENCY :	
	GROUP NUMBER CODE OF JB NAME
TAG NAME :	
LDP-27A1-1(A1) /01/01	
LIGHTING UNIT	
GROUP LIGHTING	
NORMAL LIGHTING (LDP-27A1-1 A1)	
EMERGENCY LIGHTING (E-LDP-7A1-1 EA1)	
CODE	NAME OF PANEL
(A)	LDP 27A1 CPKO WICA (A)
(EA)	UPS EMERGENCY LIGHTING CPKO WICA (EA)

DRAWING NO.	DESCRIPTION	REV.

AS BUILT DRAWING						
NO.	DATE	DESCRIPTION	PREP'D SWG	APP'D WNI	CHK'D WNI	APP'D WNI

REVISIONS


PROJECT LOCATION :
INDUSTRIAL BLOCK MNA
KRAMATWATU-SERAMG BANTEN

OWNER :
 PT. MULTIMAS NABATI ASAHAN
(SERANG BANTEN)

CONTRACTOR :
 PT. SWADAYA GRAHA
(SEMEN GRESIK GROUP)
JL. RA. KARTINI 25 GRESIK – JAWA TIMUR

TITLE :
SINGLE LINE DIAGRAM INSTALASI LIGHTING
CABLE ROOM & PANEL ROOM TANK FARM MNA

DESCRIP.	SWG		WNI		COORD.	WNI		SCALE :
	SIGN	DATE	SIGN	DATE		SIGN	DATE	
DRAWN	ROYHAN				MECH & PRO			A3
CHK'D	DUDUNG				CIV & ARCH			
APP'D					ELTR & INST			
GM. D/E.								
DWC No.						SHEET		REV.
TF-MNA-BI-DWG-AD-IL-05-06						5 of 6		

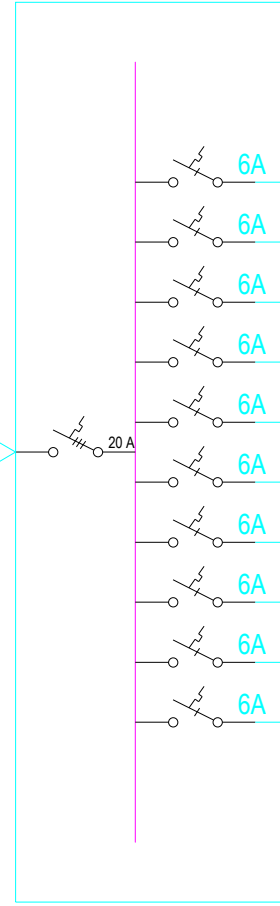

The diagram illustrates the electrical layout of a 27A1-2 Tankfarm MNA (EA2). A central vertical purple line represents the main busbar. To the left of this busbar, there is a single circuit breaker labeled '20 A'. To the right of the busbar, there are ten circuit breakers, each labeled '6A'. Each 6A breaker is connected to the main busbar and has a corresponding line extending to the right. The breakers are arranged in a vertical column, with the 20A breaker at the top and the 6A breakers below it.

NOTES :

<u>TAG GROUP NORMAL :</u>  GROUP NUMBER CODE OF JB NAME	<u>TAG NAME :</u>  LIGHTING UNIT GROUP LIGHTING
<u>TAG GROUP EMERGENCY :</u>  GROUP NUMBER CODE OF JB NAME	<u>TAG NAME :</u>  EMERGENCY LIGHTING (ELDP-27A1-1 EA1)

CODE	NAME OF PANEL
(A)	LDP 27A1 CPKO WICA (A)
(EA)	UPS EMERGENCY LIGHTING CPKO WICA (EA)

AS BUILT DRAWING						
△						
△						
△						
NO.	DATE	DESCRIPTION	PREP'D SWG	APP'D	CHK'D	APP'D WNI

PROJECT LOCATION : **INDUSTRIAL BLOCK MNA
KRAMATWATU-SERAMG BANTEN**

OWNER :  PT. MULTIMAS NABATI ASAHAN
(SERANG BANTEN)

CONTRACTOR :  **PT. SWADAYA GRAHA**
(SEMEN GRESIK GROUP)
JL. RA. KARTINI 25 GRESIK – JAWA TIMUR

TITLE : DISTRIBUTION LOAD INSTALATION LIGHTING
CABLE ROOM & PANEL ROOMTANK FARM MNA

DESCRIP.	SWG		WNI		COORD.	WNI		SCALE : <
----------	-----	--	-----	--	--------	-----	--	--