


DOCUMENT STATUS	
FOR INFORMATION	☐
COMMENTED	☐
APPROVED WITH COMMENTS	☐
APPROVED FOR DESIGN/CONSTRUCTION	☐
REJECTED	☐

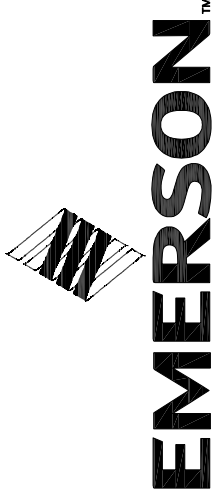

HARDWARE TYPICAL DRAWING - NETWORK CABINET

DCS SERANG PROJECT




							CUSTOMER : WILMAR INDUSTRIAL COMPLEX PT MNA SERANG, INDONESIA
							CONTRACT NO. : -
							PROJECT TITLE : DCS SERANG PROJECT
0	AS BUILT	29/08/19	AS/NAM	LKL	MNI		CUSTOMER PROJECT NO. : -
A	ISSUE FOR COMMENT	28/06/18	AS	LKL	MNI		
REV.	DESCRIPTION	DATE	DRAWN BY	CHECKED BY	APPROVED BY		

	PERMIT STAMP AND PROFESSIONAL STAMP AFFIXED ABOVE SHALL APPLY ONLY TO REV(s)		SCALE: NTS	SIZE: A3	EMERSON PROJECT NO.: 3258585	TITLE: COVER SHEET	EMERSON DRAWING NO.: 3258585-PSS-PASH-DWG-00002	SHEET NO: 001
			UNITS: mm (inch)	© 2018	PROJECT TITLE: DCS SERANG PROJECT		CUSTOMER DRAWING NO.: -	REV: 0

DRAWING INDEX & REVISION

[illegible]

	PERMIT STAMP AND PROFESSIONAL STAMP AFFIXED ABOVE SHALL APPLY ONLY TO REV(s)		SCALE:	NTS	SIZE:	A3	EMERSON PROJECT NO.: 3258585 PROJECT TITLE: DCS SERANG PROJECT	TITLE: DRAWING INDEX & REVISION	EMERSON DRAWING NO.: 3258585-PSS-PASH-DWG-00002	SHEET NO: 002
			UNITS:	mm (inch)		2018				

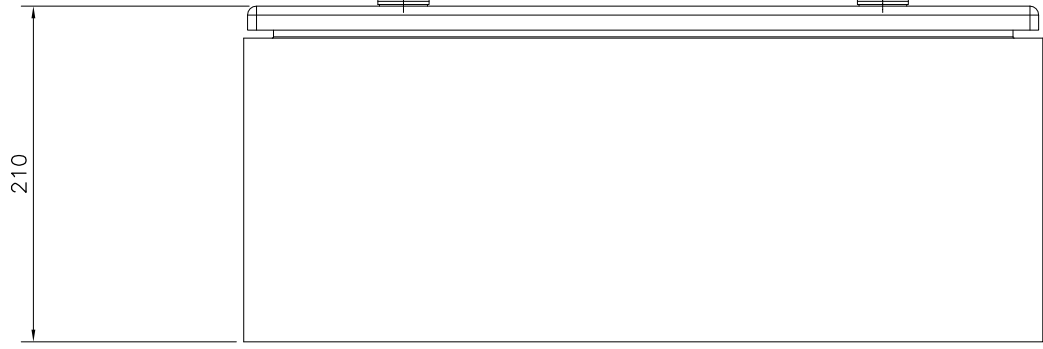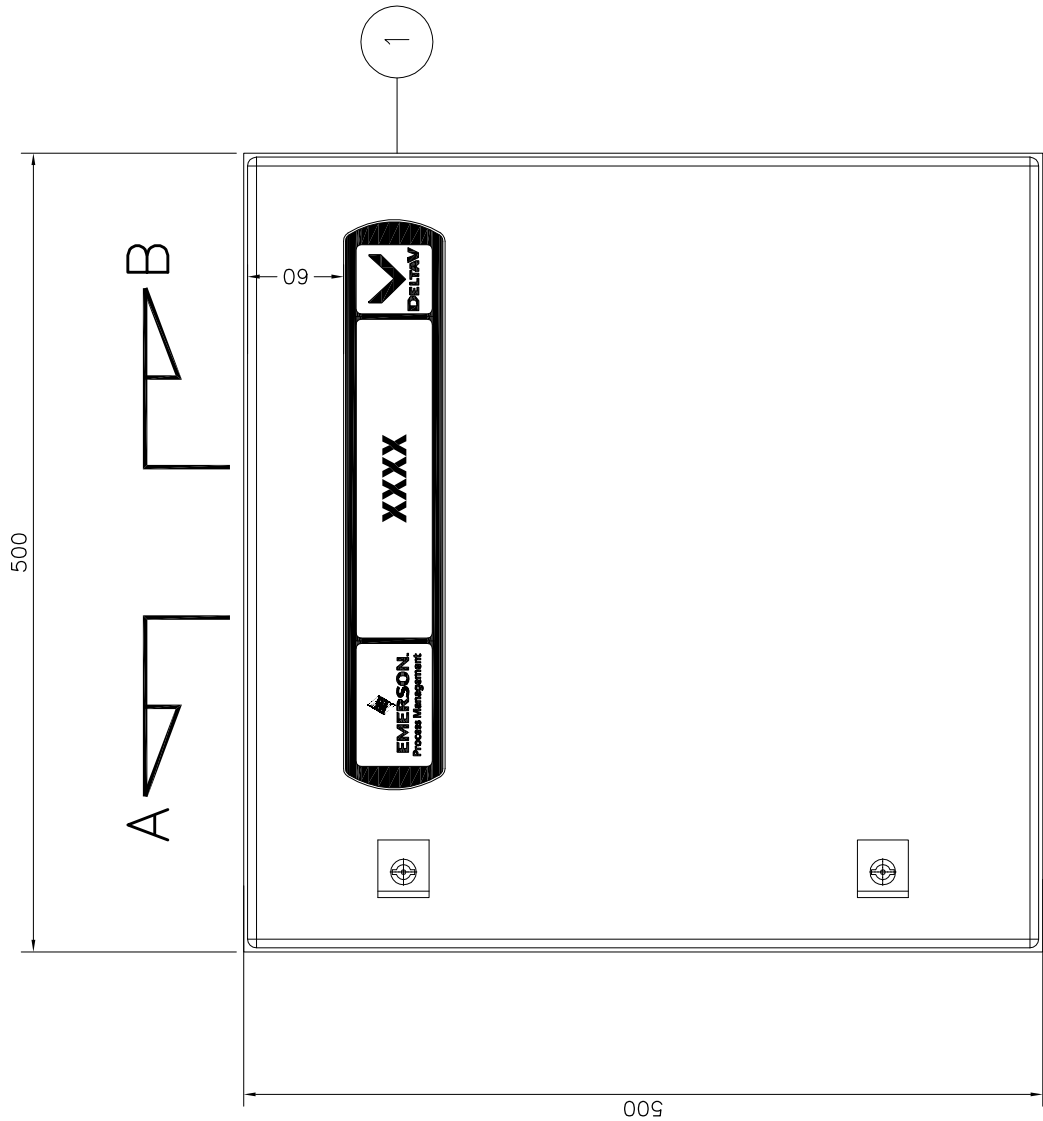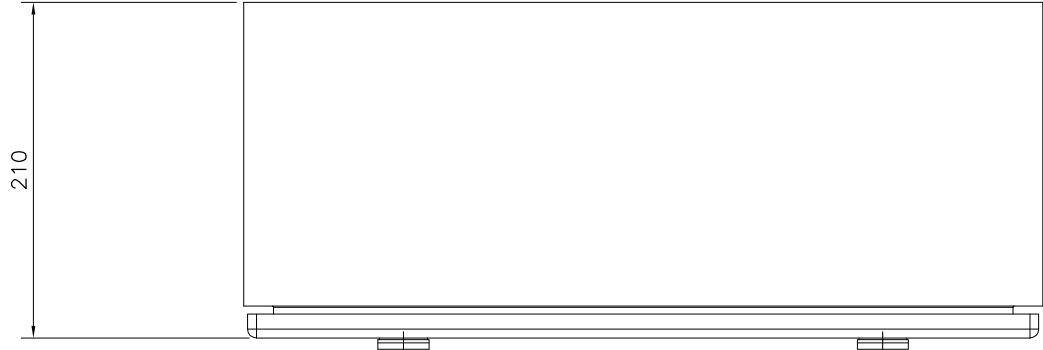


LEFT SIDE VIEW
NETWORK CABINET – XXXX

FRONT DOOR VIEW
NETWORK CABINET – XXXX

RIGHT SIDE VIEW
NETWORK CABINET – XXXX

NOTE: NETWORK CABINET FOR THIN CLIENT
IN CONTROL ROOMS

		SCALE: NTS UNITS: mm (inch)	SIZE: A3 © 2018	EMERSON PROJECT NO.: 3258585 PROJECT TITLE: DCS SERANG PROJECT	TITLE: TYPICAL RIOS CABINET ANALOG (FRONT DOOR VIEW, RIGHT SIDE & LEFT SIDE VIEW)	EMERSON DRAWING NO.: 3258585-PSS-PASH-DWG-00002	SHEET NO: 003
						CUSTOMER DRAWING NO.: -	REV: 0

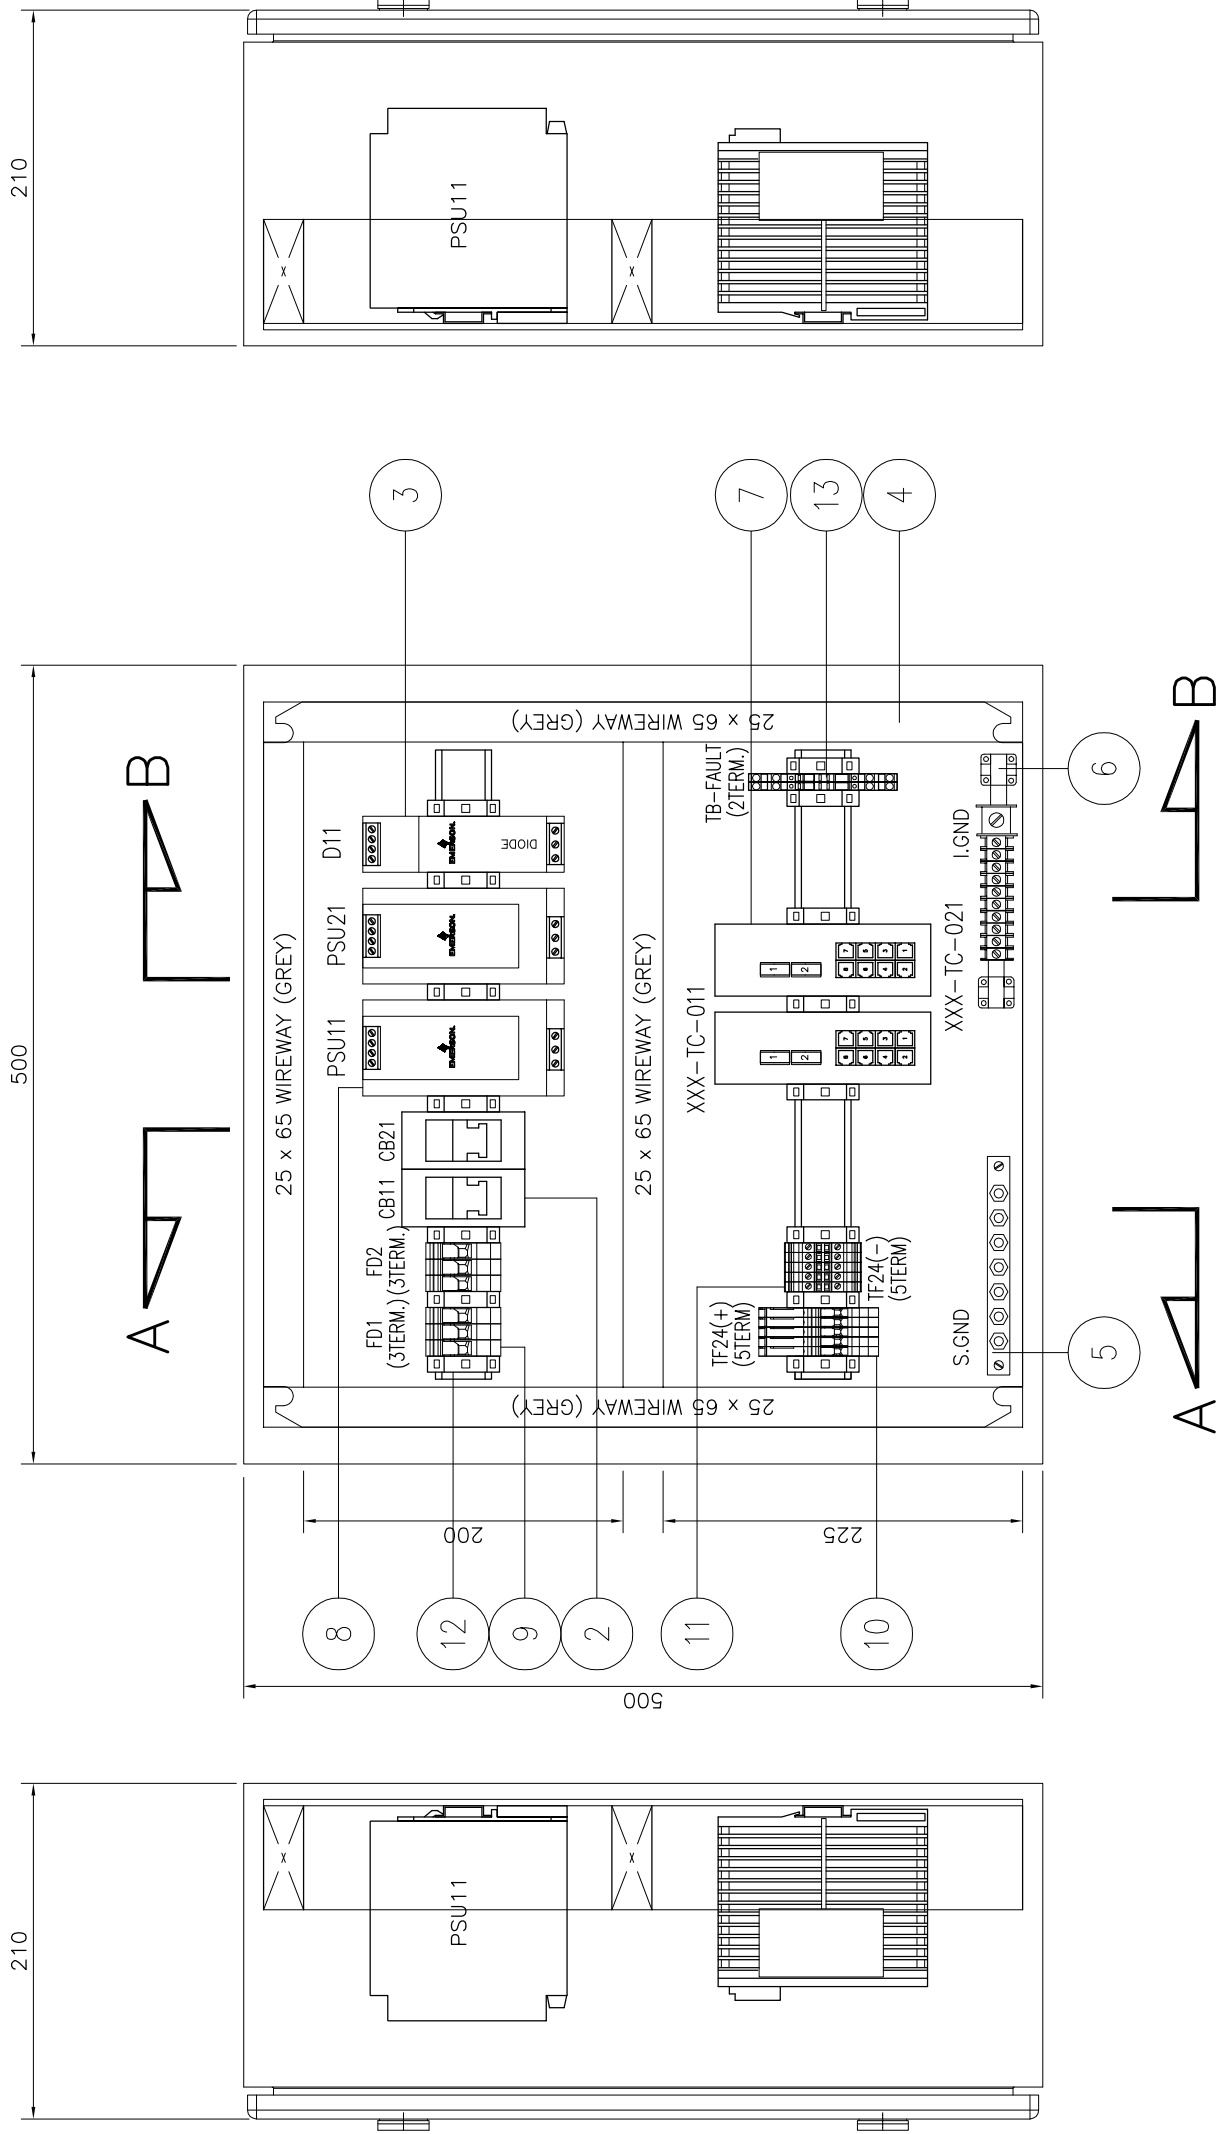

SECTION A-A
NETWORK CABINET – XXXX

FRONT VIEW
NETWORK CABINET – XXXX

SECTION B-B
NETWORK CABINET – XXXX

	PERMIT STAMP AND PROFESSIONAL STAMP AFFIXED ABOVE SHALL APPLY ONLY TO REV(s)		SCALE: NTS UNITS: mm (inch)	SIZE: A3 © 2018	EMERSON PROJECT NO.: 3258585 PROJECT TITLE: DCS SERANG PROJECT	TITLE: TYPICAL RIOS CABINET ANALOG (FRONT VIEW, SECTION A-A & SECTION B-B)	EMERSON DRAWING NO.: 3258585-PSS-PASH-DWG-00002	SHEET NO: 005
							CUSTOMER DRAWING NO.: -	REV: 0

BILL OF MATERIALS

ITEM NO.	DESCRIPTION		PART NUMBER	QTY.	MANUFACTURER
01	RITTAL CABINET (W500 X H500 X D210) FRONT ACCESS		AE1050.500	1 SET	RITTAL
02	AC MCB 2POLE (6A)		IK60N C6A	2 PCS	SCHNEIDER
03	DELTA V BULK POWER SUPPLY REDUNDANCY MODULE, 12 V DC TO 28 V DC, 20 A		VE5134	1 PC	EMERSON PROCESS
04	25 X 65 mm PVC WIREWAY (GREY)		-	1 LOT	CONTRACTOR
05	SAFETY GROUND BAR		-	1 LOT	CONTRACTOR
06	INSTRUMENT GROUND BAR		-	1 LOT	CONTRACTOR
07	ETHERNET SWITCH 8-PORT		ISF3010D	2 PCS	INHAND
08	DELTA V BULK POWER SUPPLY 100-240 V AC TO 24 V DC, 10A		VE5123	2 PCS	EMERSON PROCESS
09	2-COND THROUGH TERMINAL BLOCK, 10MM SQ		2010-1201	6 PCS	WAGO
10	FUSE DISCONNECT TB WITH FUSE BLOW INDICATOR, 24VDC, 4MM SQ		2004-1611/1000-0541	5 PCS	WAGO
11	2-COND THROUGH TERMINAL BLOCK, 4MM SQ		2004-1201	5 PCS	WAGO
12	END STOPPER		249-117	1 LOT	WAGO
13	DOUBLE DECK DISCONNECT TERMINAL BLOCK, 2.5MM SQ		2002-2671	2 PCS	WAGO
14					
15					
PERMIT STAMP AND PROFESSIONAL STAMP
AFFIXED ABOVE SHALL APPLY ONLY TO REV(s)



EMERSON PROJECT NO.: 3258585
PROJECT TITLE:
DCS SERANG PROJECT

SCALE: NTS
UNITS: mm (inch)

SIZE: A3
© 2018

TITLE:
TYPICAL RIOS CABINET ANALOG
BILL OF MATERIAL

EMERSON DRAWING NO.: 3258585-PSS-PASH-DWG-00002
CUSTOMER DRAWING NO.: -

SHEET NO: 006
REV: 0

