


DOCUMENT STATUS	
FOR INFORMATION	☐
COMMENTED	☐
APPROVED WITH COMMENTS	☐
APPROVED FOR DESIGN/CONSTRUCTION	☐
REJECTED	☐

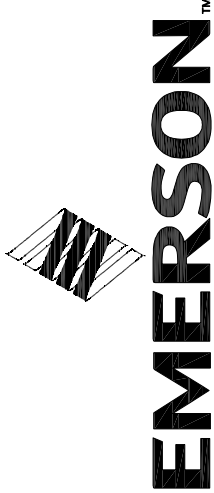

HARDWARE TYPICAL DRAWING - SYSTEM CABINET


DCS SERANG PROJECT


							CUSTOMER : WILMAR INDUSTRIAL COMPLEX PT MNA SERANG, INDONESIA
							CONTRACT NO. : -
							PROJECT TITLE : DCS SERANG PROJECT
0	AS BUILT	29/08/19	AS/NAM	LKL	MNI		CUSTOMER PROJECT NO. : -
A	ISSUE FOR COMMENT	28/06/18	AS	LKL	MNI		
REV.	DESCRIPTION	DATE	DRAWN BY	CHECKED BY	APPROVED BY		

	PERMIT STAMP AND PROFESSIONAL STAMP AFFIXED ABOVE SHALL APPLY ONLY TO REV(s)		SCALE: NTS UNITS: mm (inch)	SIZE: A3 © 2018	EMERSON PROJECT NO.: 3258585 PROJECT TITLE: DCS SERANG PROJECT	TITLE: COVER SHEET	EMERSON DRAWING NO.: 3258585-PSS-PASH-DWG-00003	SHEET NO: 001
							CUSTOMER DRAWING NO.: -	REV: 0


DRAWING INDEX & REVISION

 [illegible]


	PERMIT STAMP AND PROFESSIONAL STAMP AFFIXED ABOVE SHALL APPLY ONLY TO REV(S)		SCALE:		NTS	SIZE:	A3	EMERSON PROJECT NO.: 3258585 PROJECT TITLE: DCS SERANG PROJECT	TITLE: DRAWING INDEX & REVISION	EMERSON DRAWING NO.: 3258585-PSS-PASH-DWG-00003	SHEET NO.: 002
			UNITS:	mm (inch)	2018	REV.: 0					

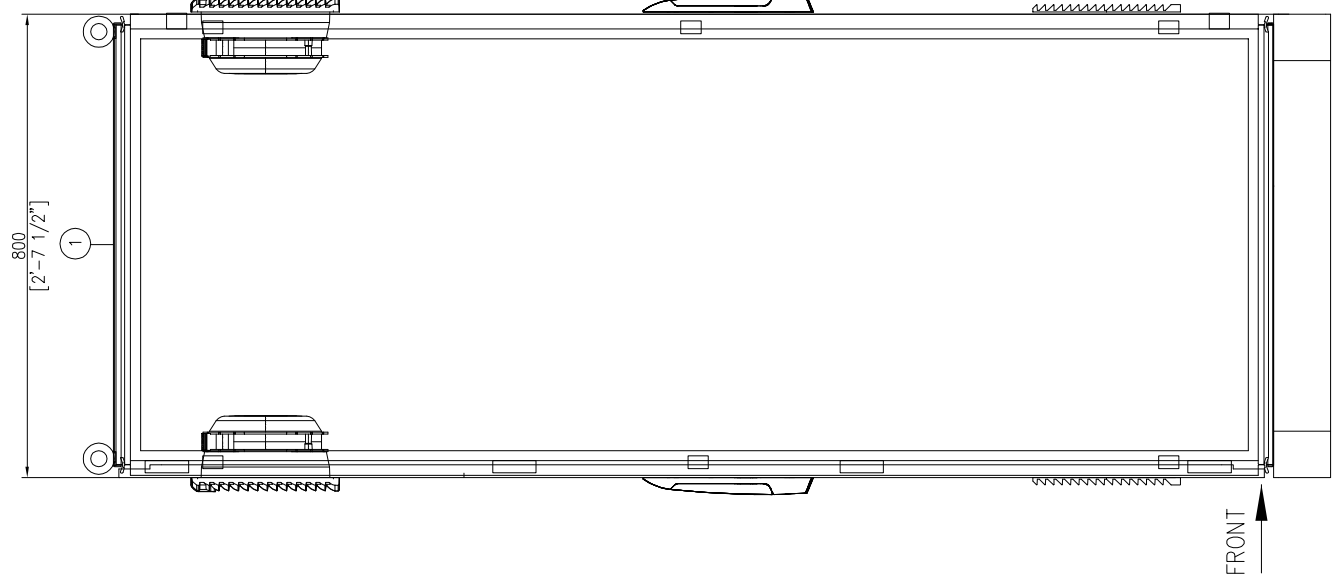


SIDE VIEW
(SECTION A-A)

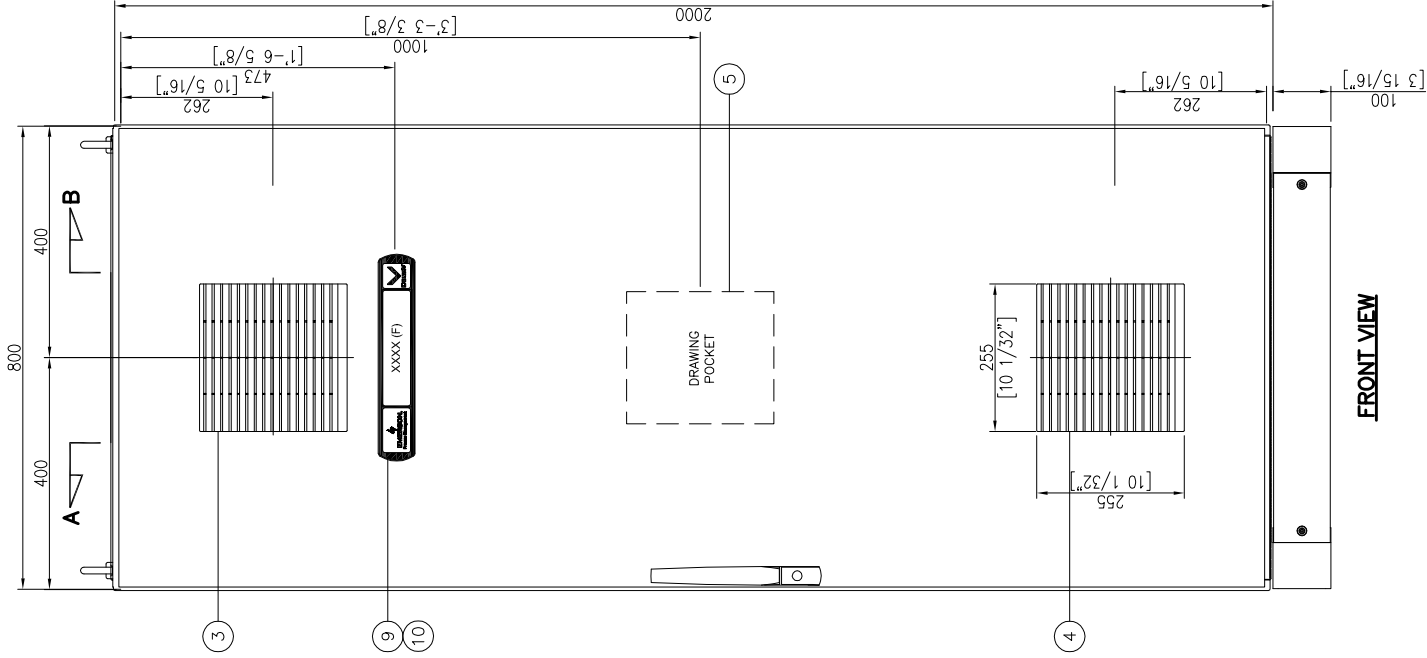

FRONT VIEW

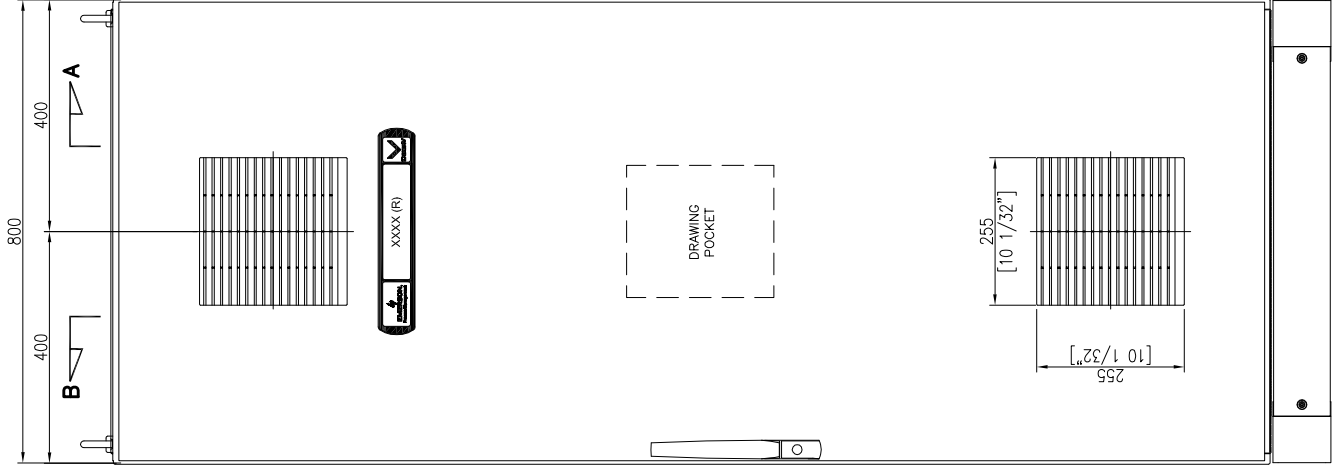

REAR VIEW

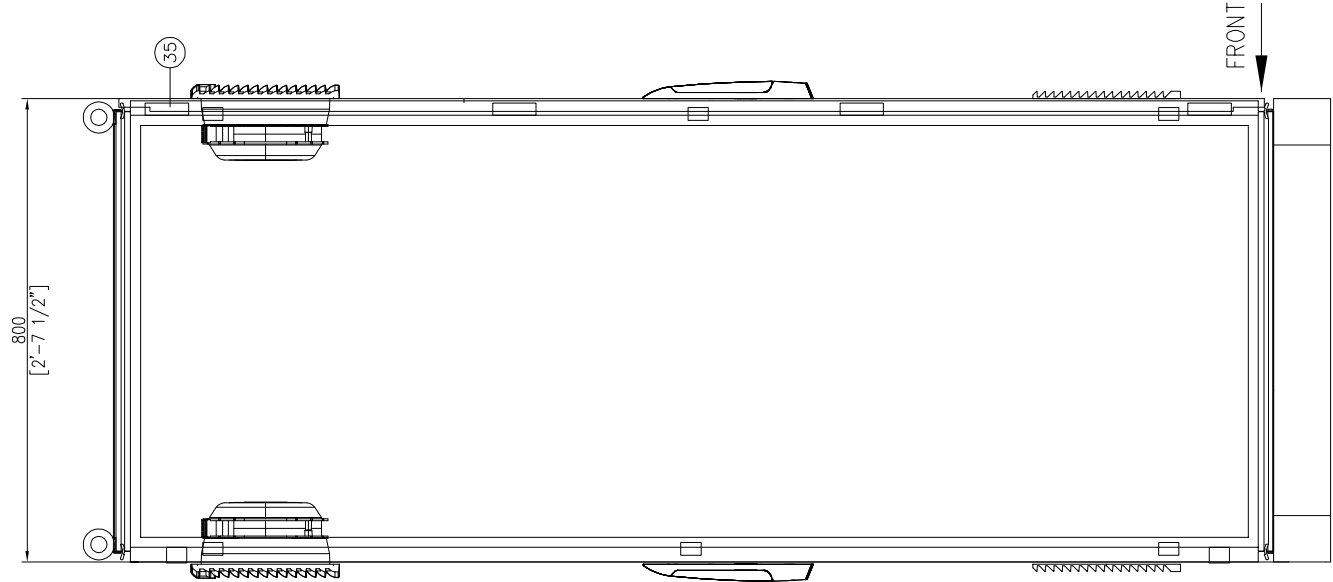

SIDE VIEW
(SECTION B-B)



PERMIT STAMP AND PROFESSIONAL STAMP
AFFIXED ABOVE SHALL APPLY ONLY TO REV(S)



SCALE: NTS
UNITS: mm (inch)


SIZE: A3
© 2018

EMERSON PROJECT NO.: 3258585
PROJECT TITLE: DCS SERANG PROJECT


TITLE: TYPICAL SYSTEM CABINET
(FRONT& REAR DOOR VIEW,
RIGHT SIDE & LEFT SIDE VIEW)

EMERSON DRAWING NO.: 3258585-PSS-PASH-DWG-00003
CUSTOMER DRAWING NO.: -

SHEET NO: 003
REV: 0

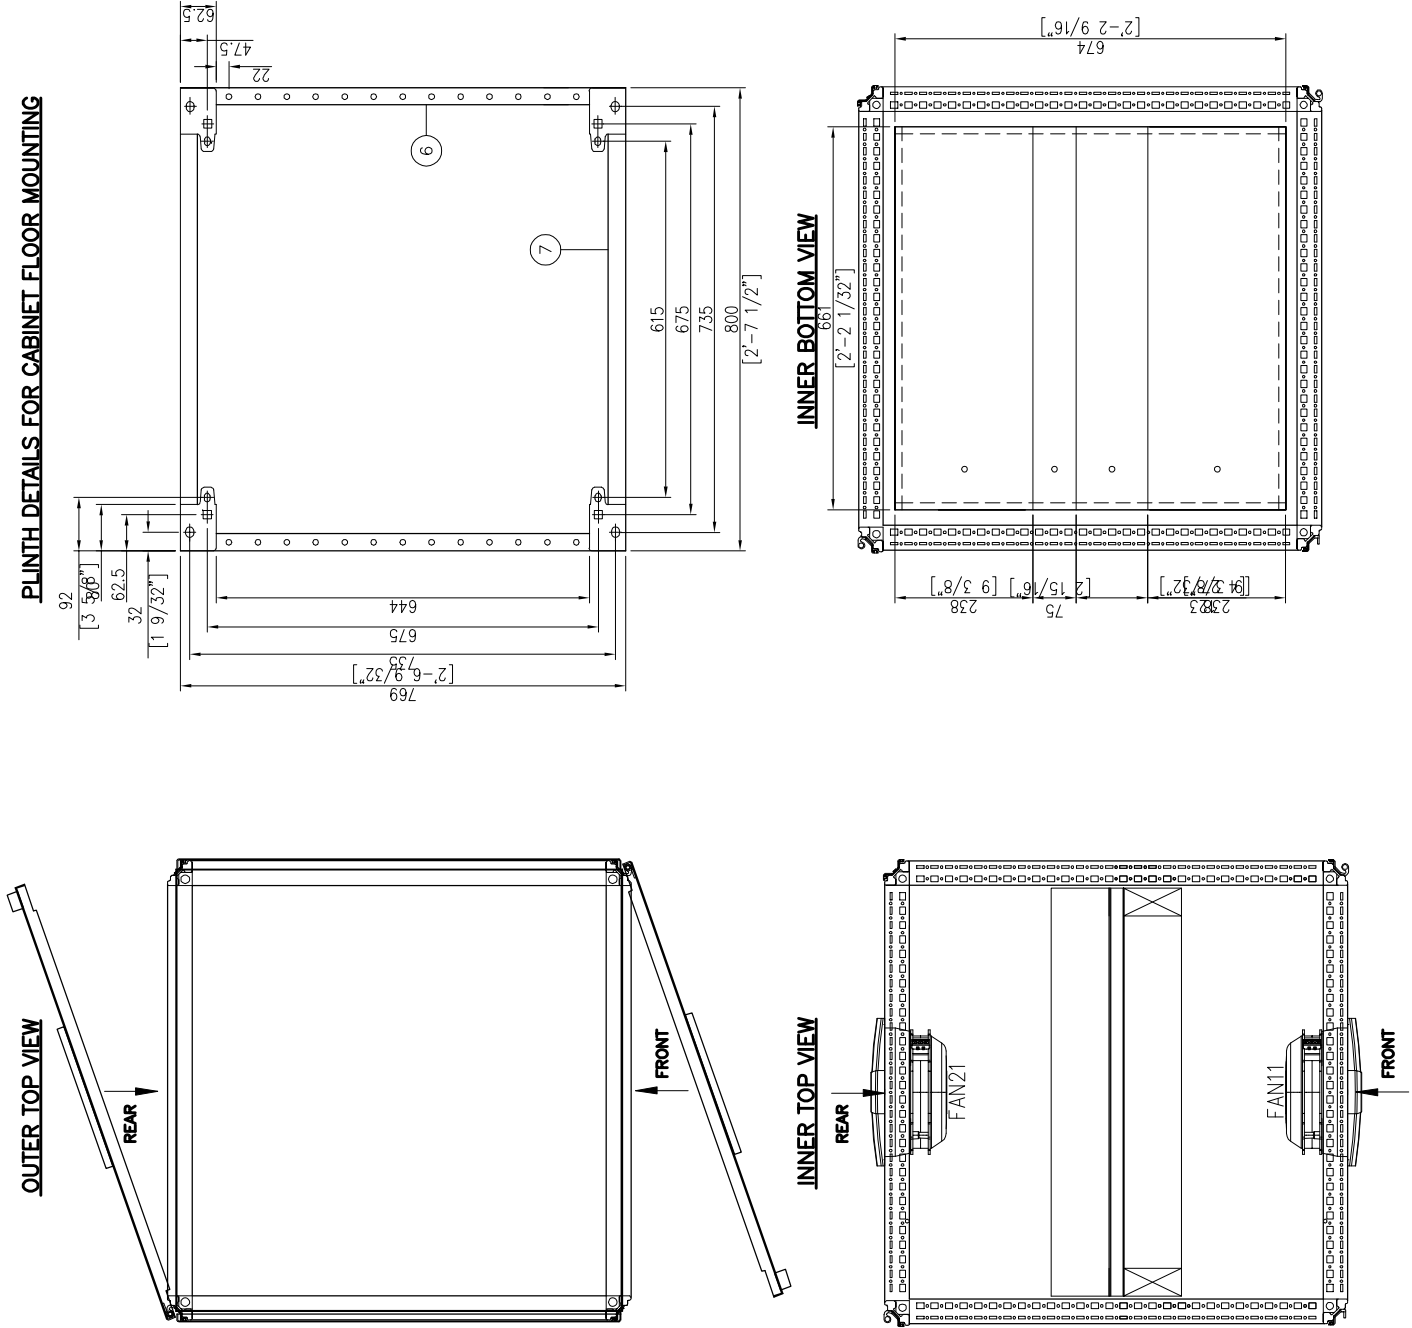


	PERMIT STAMP AND PROFESSIONAL STAMP AFFIXED ABOVE SHALL APPLY ONLY TO REV(s)			SCALE: NTS	SIZE: A3	EMERSON PROJECT NO.: 3258585	TITLE: TYPICAL SYSTEM CABINET PLINTH, OUTER & INNER VIEW		EMERSON DRAWING NO.: 3258585-PSS-PASH-DWG-00003	SHEET NO: 004
				mm (inch)	© 2018	PROJECT TITLE: DCS SERANG PROJECT			CUSTOMER DRAWING NO.: -	REV: 0

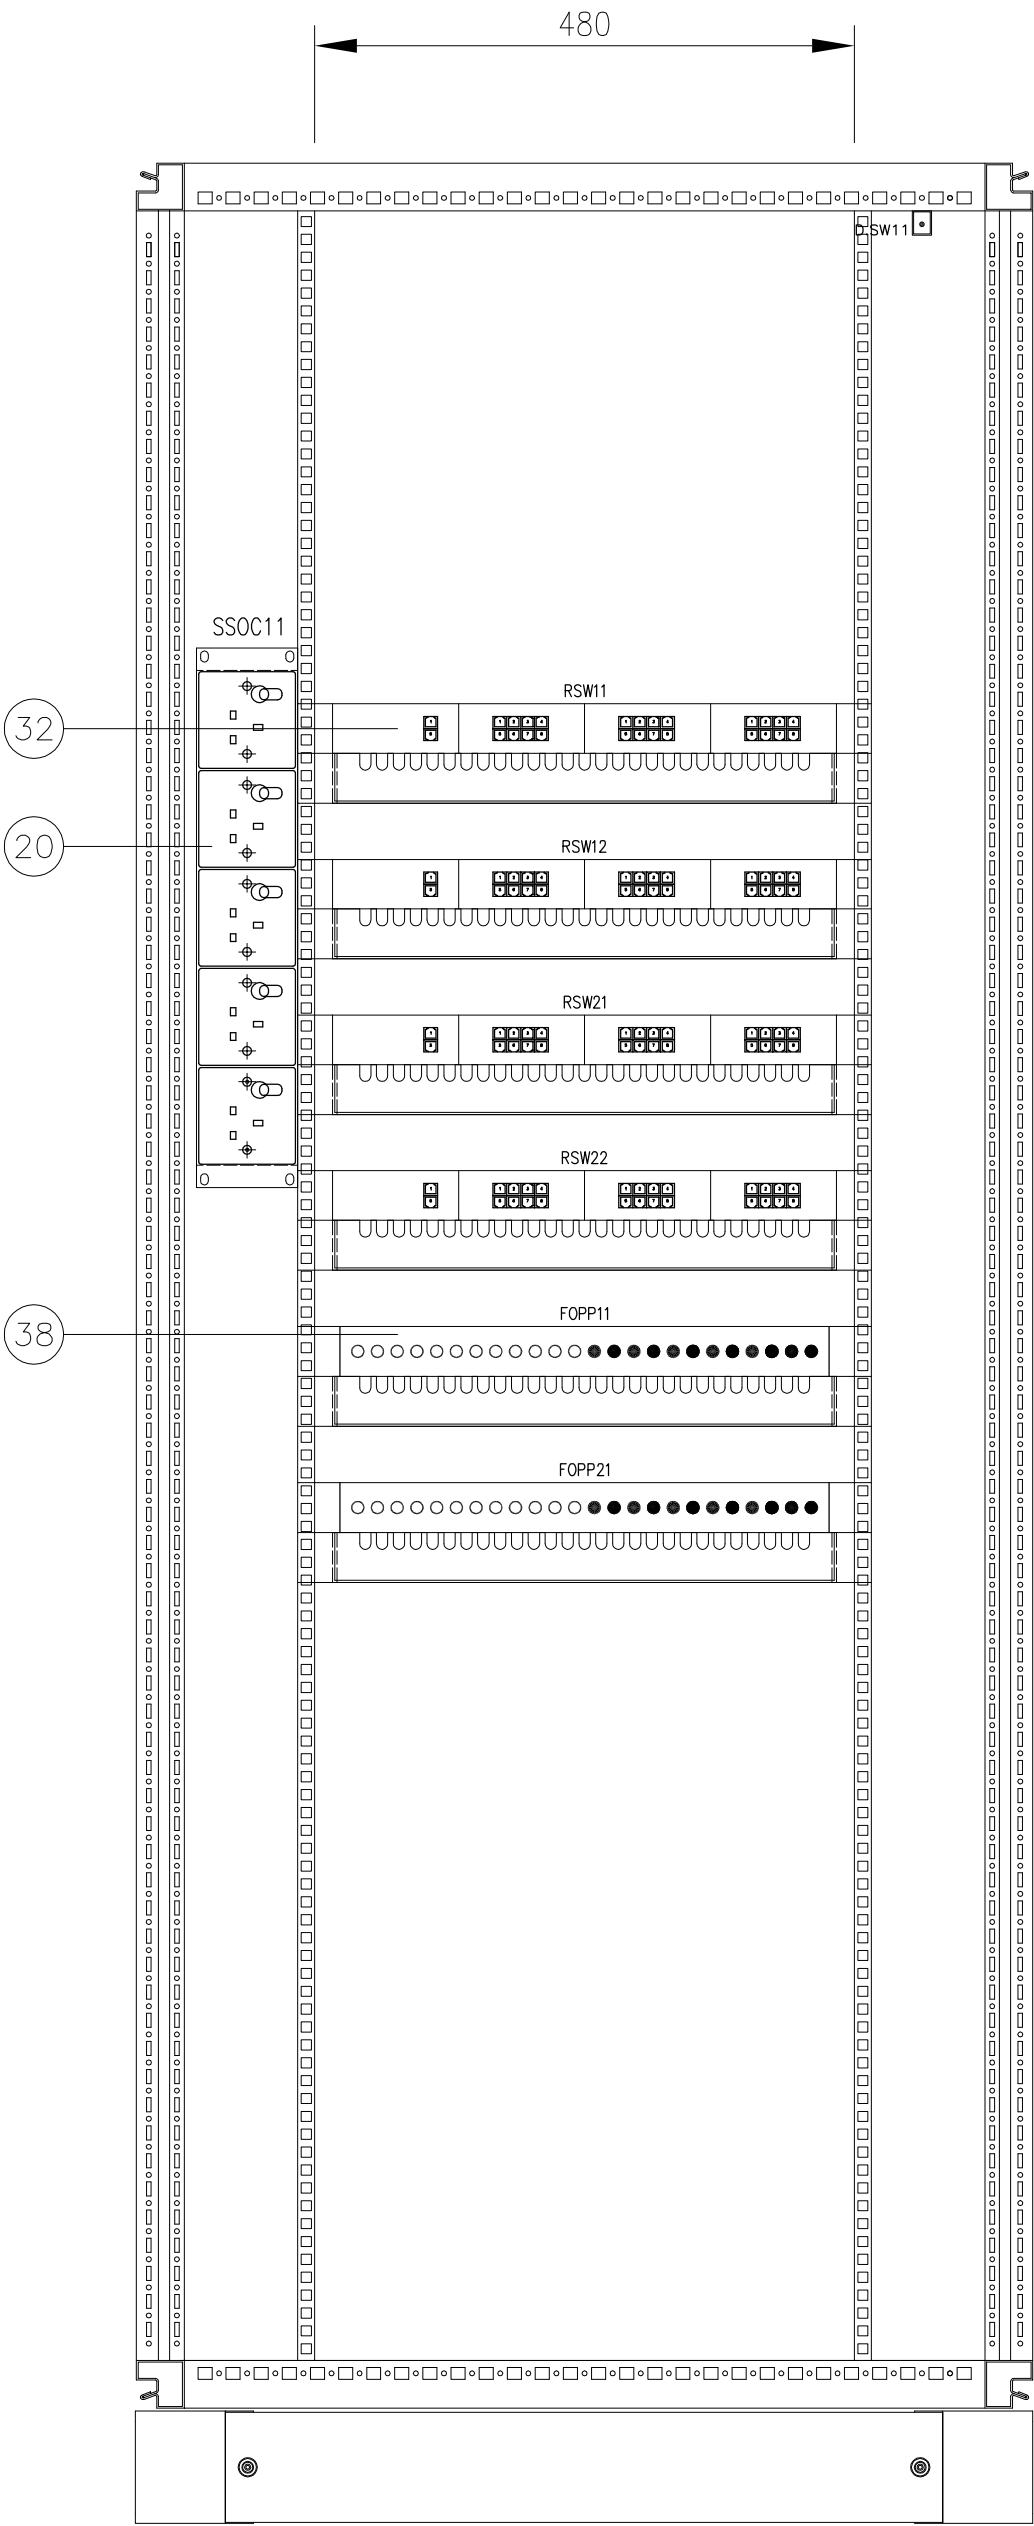

FRONT VIEW

	PERMIT STAMP AND PROFESSIONAL STAMP AFFIXED ABOVE SHALL APPLY ONLY TO REV(s)				SCALE: NTS	SIZE: A3	EMERSON PROJECT NO.: 3258585		TITLE: TYPICAL SYSTEM CABINET FRONT VIEW	EMERSON DRAWING NO.: 3258585-PSS-PASH-DWG-00003	SHEET NO.: 005
				UNITS: mm (inch)	© 2018	PROJECT TITLE: DCS SERANG PROJECT		CUSTOMER DRAWING NO.: —			

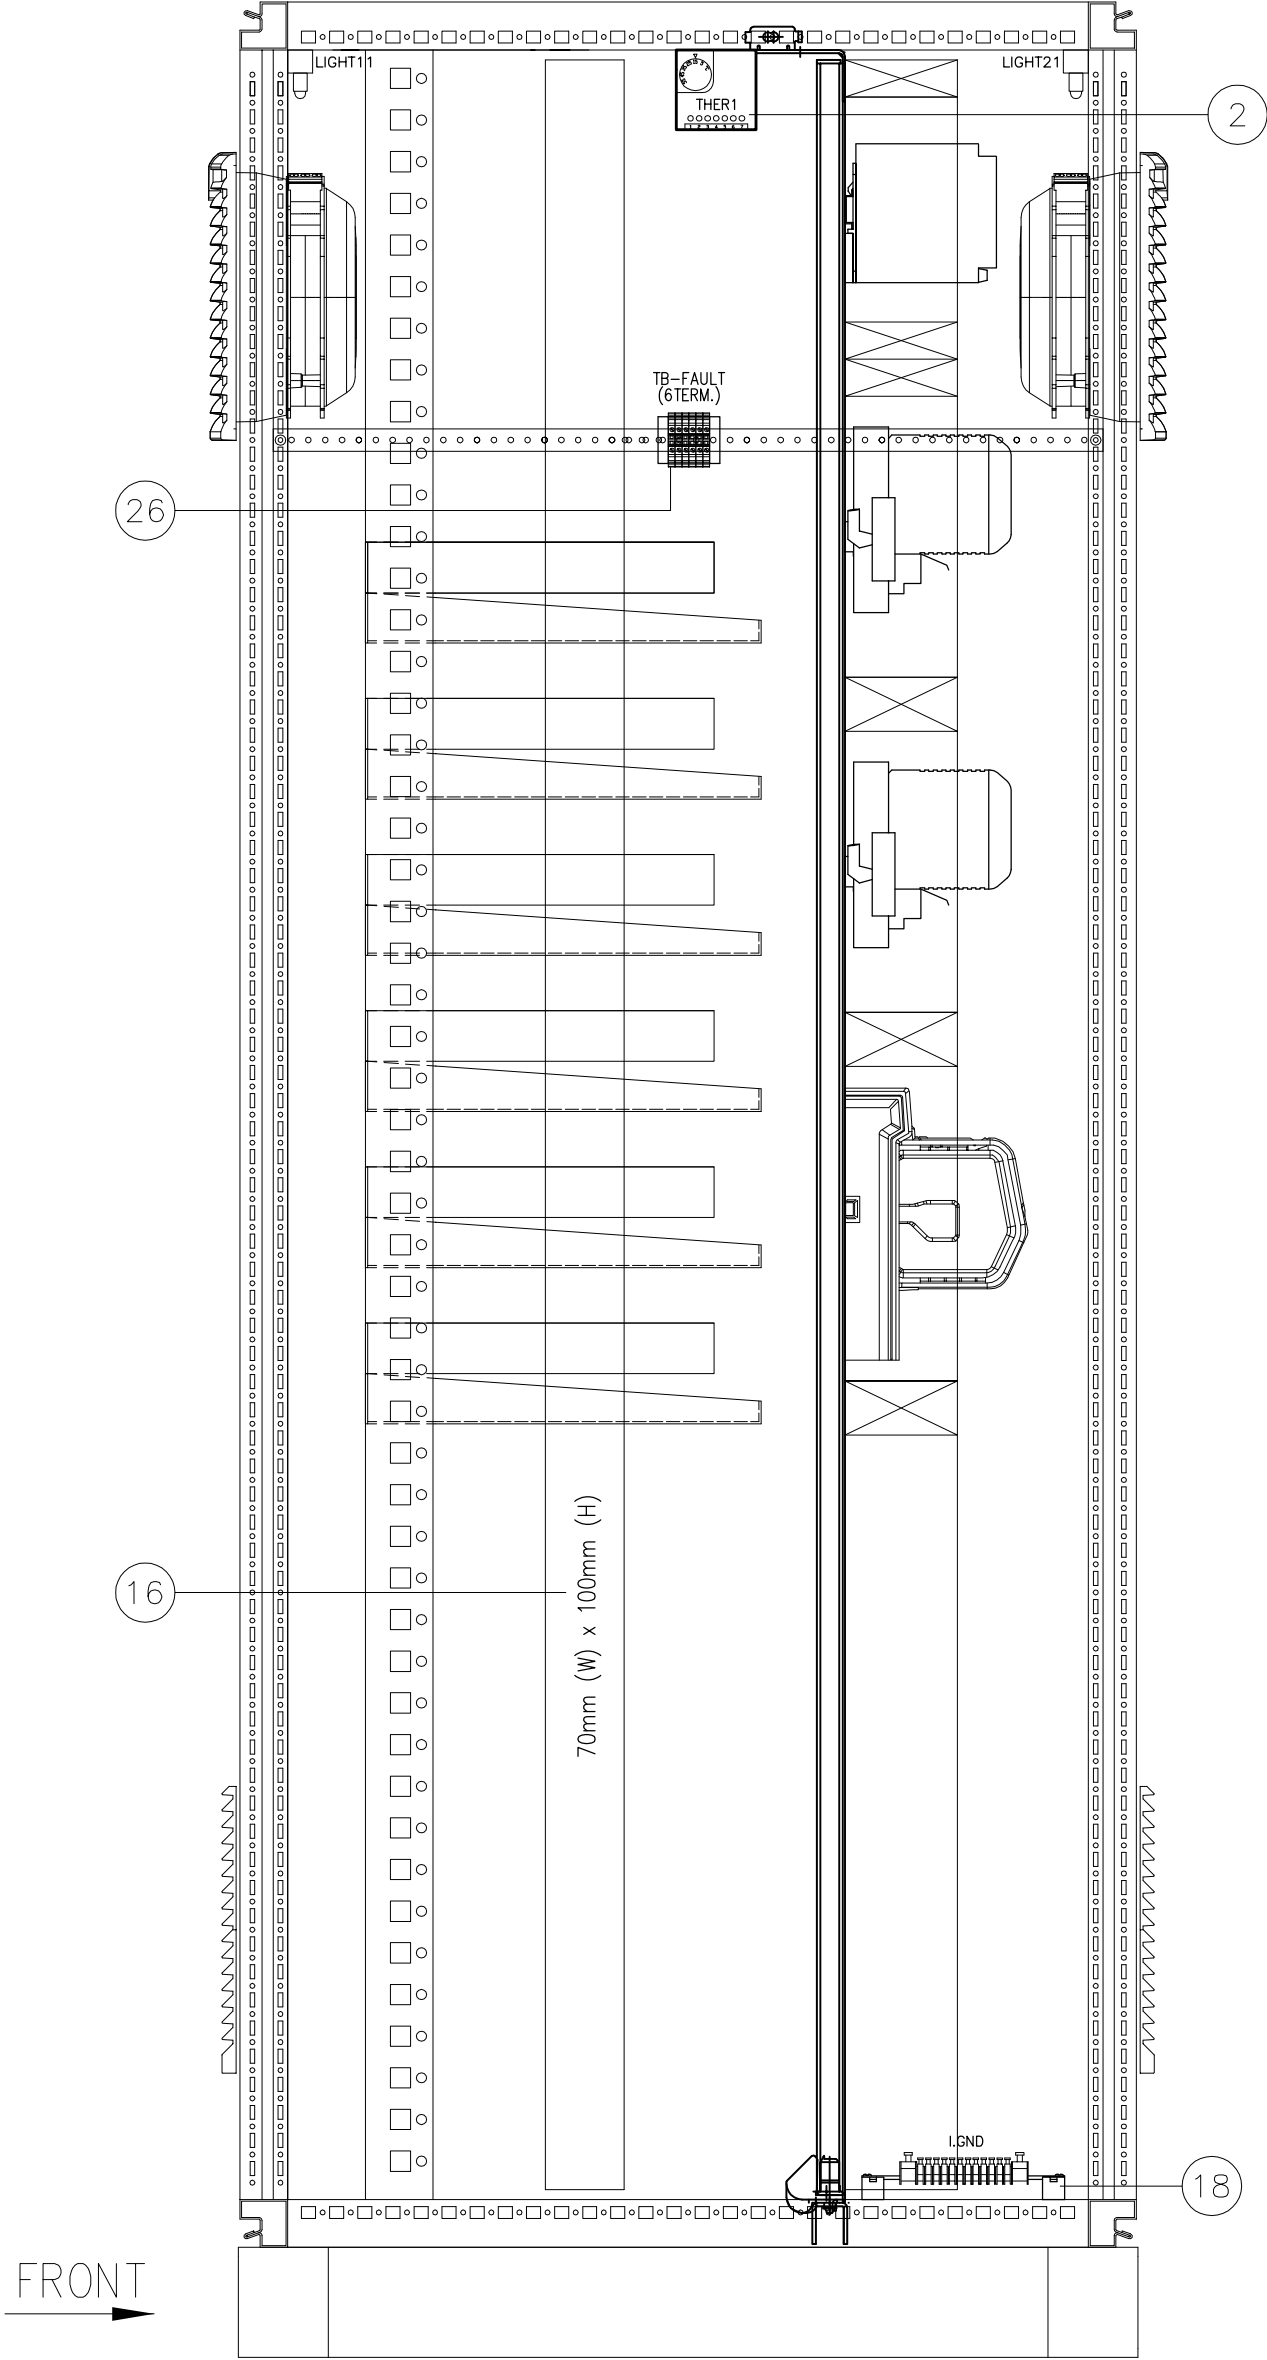

SIDE VIEW
(SECTION A-A)



PERMIT STAMP AND PROFESSIONAL STAMP
AFFIXED ABOVE SHALL APPLY ONLY TO REV(s)



SCALE: NTS
UNITS: mm (inch)

SIZE: A3
© 2018


EMERSON PROJECT NO.: 3258585
PROJECT TITLE: DCS SERANG PROJECT

TITLE: TYPICAL SYSTEM CABINET
SIDE VIEW
(SECTION A-A)

EMERSON DRAWING NO.: 3258585-PSS-PASH-DWG-00003

SHEET NO: 007

CUSTOMER DRAWING NO.: -
REV: 0

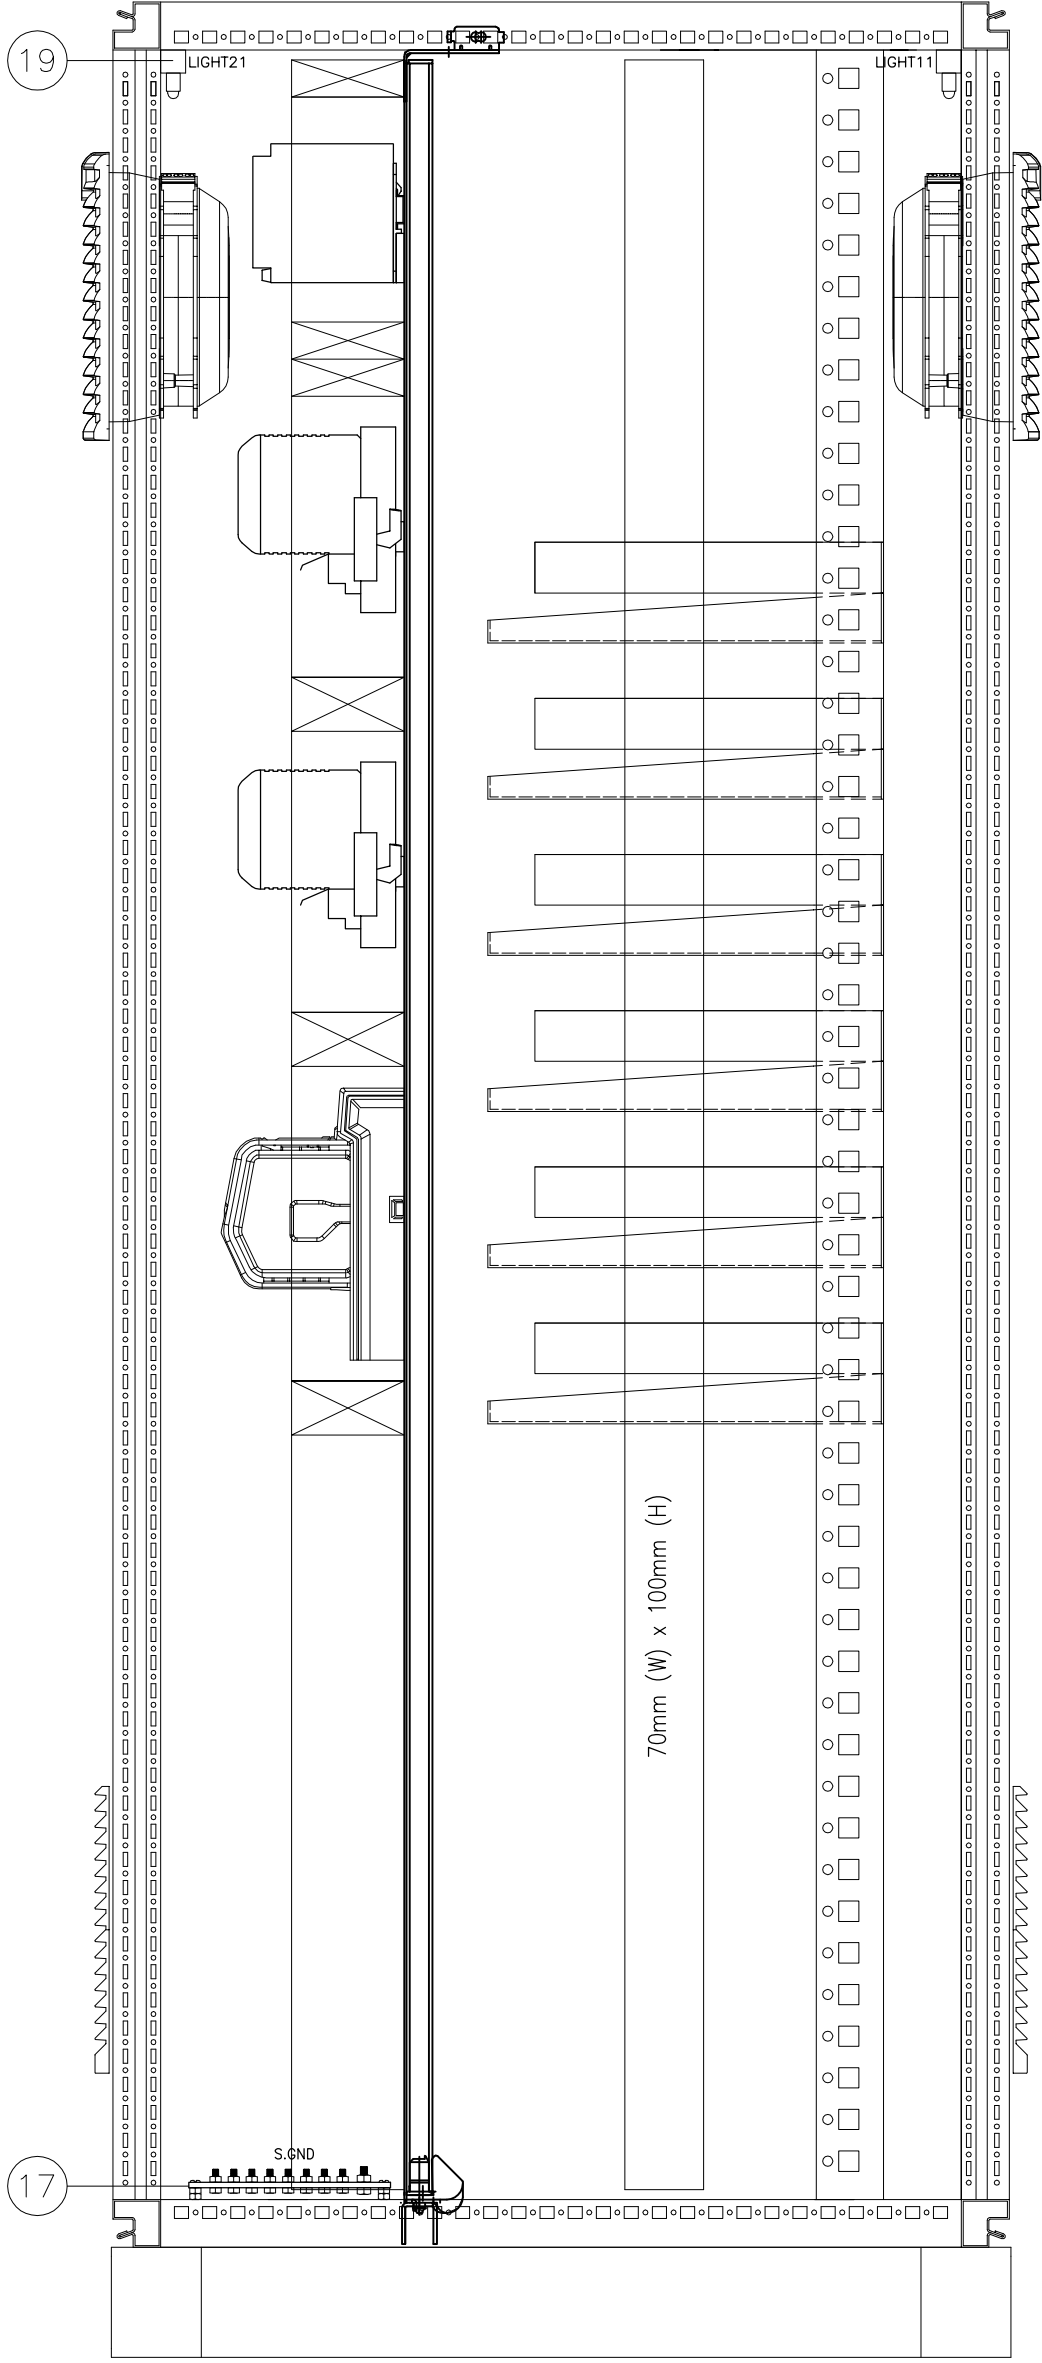

SIDE VIEW
(SECTION B-B)

FRONT



PERMIT STAMP AND PROFESSIONAL STAMP
AFFIXED ABOVE SHALL APPLY ONLY TO REV(S)



SCALE: NTS
UNITS: mm (inch)

SIZE: A3
© 2018

EMERSON PROJECT NO.: 3258585
PROJECT TITLE: DCS SERANG PROJECT

TITLE: TYPICAL SYSTEM CABINET
SIDE VIEW
(SECTION B-B)

EMERSON DRAWING NO.: 3258585-PSS-PASH-DWG-00003

CUSTOMER DRAWING NO.: -

SHEET NO: 008

REV: 0

BILL OF MATERIALS

ITEM NO.	DESCRIPTION		PART NUMBER	QTY.	MANUFACTURER
01	RITTAL CABINET (W800mmxD800mmxH2000mm) FRONT AND REAR ACCESS		TS8808.521	1 SET	RITTAL
02	THERMOSTAT		SK3110.000	1 PC	RITTAL
03	FAN WITH FILTER,240VAC,105m3/h		SK3241.100	2 PCS	RITTAL
04	OUTLET FILTER INCLUDING FILTER MAT		SK3240.200	2 PCS	RITTAL
05	PLASTIC WIRING PLAN POCKET, A4 POTRAIT, RAL7035		SZ2514.000	2 PCS	RITTAL
06	BASE PLINTH		TS8601.800	1 SET	RITTAL
07	TRIM PLINTH		TS8601.080	1 SET	RITTAL
08	DOOR–OPERATED SWITCH,WITHOUT CONNECTION CABLE		SZ4315.520	2 PCS	RITTAL
09	CABINET NAMEPLATE HOLDER		KJ4010X1–BX3	2 PCS	EMERSON PROCESS
10	CABINET NAMEPLATE BLANK INSERT		KJ4010X1–BX2	2 PCS	EMERSON PROCESS
11	AC MCB 2POLE (20A)		–	1 PC	TBA
12	AC MCB 2POLE (6A)		–	1 PC	TBA
13	DC MCB 2POLE (20A)		–	1 PC	TBA
14	33 X 100 mm PVC WIREWAY (GREY)		–	1 LOT	CONTRACTOR
15	48 X 100 mm PVC WIREWAY (GREY)		–	1 LOT	CONTRACTOR
16	70 X 100 mm PVC WIREWAY (GREY)		–	1 LOT	CONTRACTOR
17	SAFETY GROUND BAR		–	1 LOT	CONTRACTOR
18	INSTRUMENT GROUND BAR		–	1 LOT	CONTRACTOR
19	STANDARD LIGHT		–	2 PCS	CONTRACTOR
20	3PIN SOCKET 5–GANG		–	1 PC	CONTRACTOR
21	MX CONTROLLER		VE3007	3 PCS	EMERSON PROCESS
22	2–WIDE POWER/CONTROLLER CARRIER		VE3051C0	4 PCS	EMERSON PROCESS
23	ENHANCED SYSTEM POWER SUPPLY; (DUAL DC/DC) INPUT		VE5009	4 PCS	EMERSON PROCESS
24	DEVICENET I/O INTERFACE WITH TERMINATION BLOCK		VE4016	1 PC	EMERSON PROCESS
25	CARRIER BLANK CAP		VE6101	7 PCS	EMERSON PROCESS
26	8–WIDE I/O INTERFACE CARRIER WITH CARRIER SHIELD BAR		VE3051C0	1 PC	EMERSON PROCESS
27	VIRTUAL I/O MODULE 2		VE4026	1 PC	EMERSON PROCESS
28	SIMPLEX ETHERNET I/O CARD (EIOC) ASSEMBLY		SE4100	1 PC	EMERSON PROCESS
29	SWITCH FOR VIM MODBUS		TBA	1 PC	TBA
30	SWITCH FOR VIM PROFINET		TBA	1 PC	TBA
31	SWITCH FOR EIOC		TBA	1 PC	TBA
32	SMART 24–PORT SWITCH; 19–INCH RACK MOUNT		VE6048R1P3	4 PCS	EMERSON PROCESS
33	DELTA V BULK POWER SUPPLY 100–240 V AC TO 24 V DC, 20A		VE5126	1 PC	EMERSON PROCESS
34	10MM FEED–THROUGH TERMINAL BLOCK		TBA	3 PCS	TBA



PERMIT STAMP AND PROFESSIONAL STAMP
 AFFIXED ABOVE SHALL APPLY ONLY TO REV(s)



EMERSON PROJECT NO.: 3258585
 PROJECT TITLE:
 DCS SERANG PROJECT

SCALE: NTS
 UNITS: mm (inch)
 SIZE: A3
 2018

TITLE:
 TYPICAL SYSTEM CABINET
 BILL OF MATERIALS

EMERSON DRAWING NO.: 3258585–PSS–PASH–DWG–00003
 CUSTOMER DRAWING NO.: –

SHEET NO: 009
 REV: 0

BILL OF MATERIALS

ITEM NO.	DESCRIPTION	PART NUMBER	QTY.	MANUFACTURER
35	4MM FUSE MODULAR TERMINAL BLOCK	TBA	15 PCS	TBA
36	4MM FEED-THROUGH TERMINAL BLOCK	TBA	15 PCS	TBA
37	END CLAMP	TBA	1 LOT	TBA
38	FIBER OPTIC PATCH PANEL (BY OTHERS)	TBA	2 PCS	TBA
39				
40				
PERMIT STAMP AND PROFESSIONAL STAMP
 AFFIXED ABOVE SHALL APPLY ONLY TO REV(S)



SCALE: NTS
 UNITS: mm (inch)


SIZE: A3
 © 2018

EMERSON PROJECT NO.: 3258585
 PROJECT TITLE: DCS SERANG PROJECT

TITLE: TYPICAL SYSTEM CABINET
 BILL OF MATERIALS

EMERSON DRAWING NO.: 3258585-PSS-PASH-DWG-00003
 CUSTOMER DRAWING NO.: -

SHEET NO: 010
 REV: 0

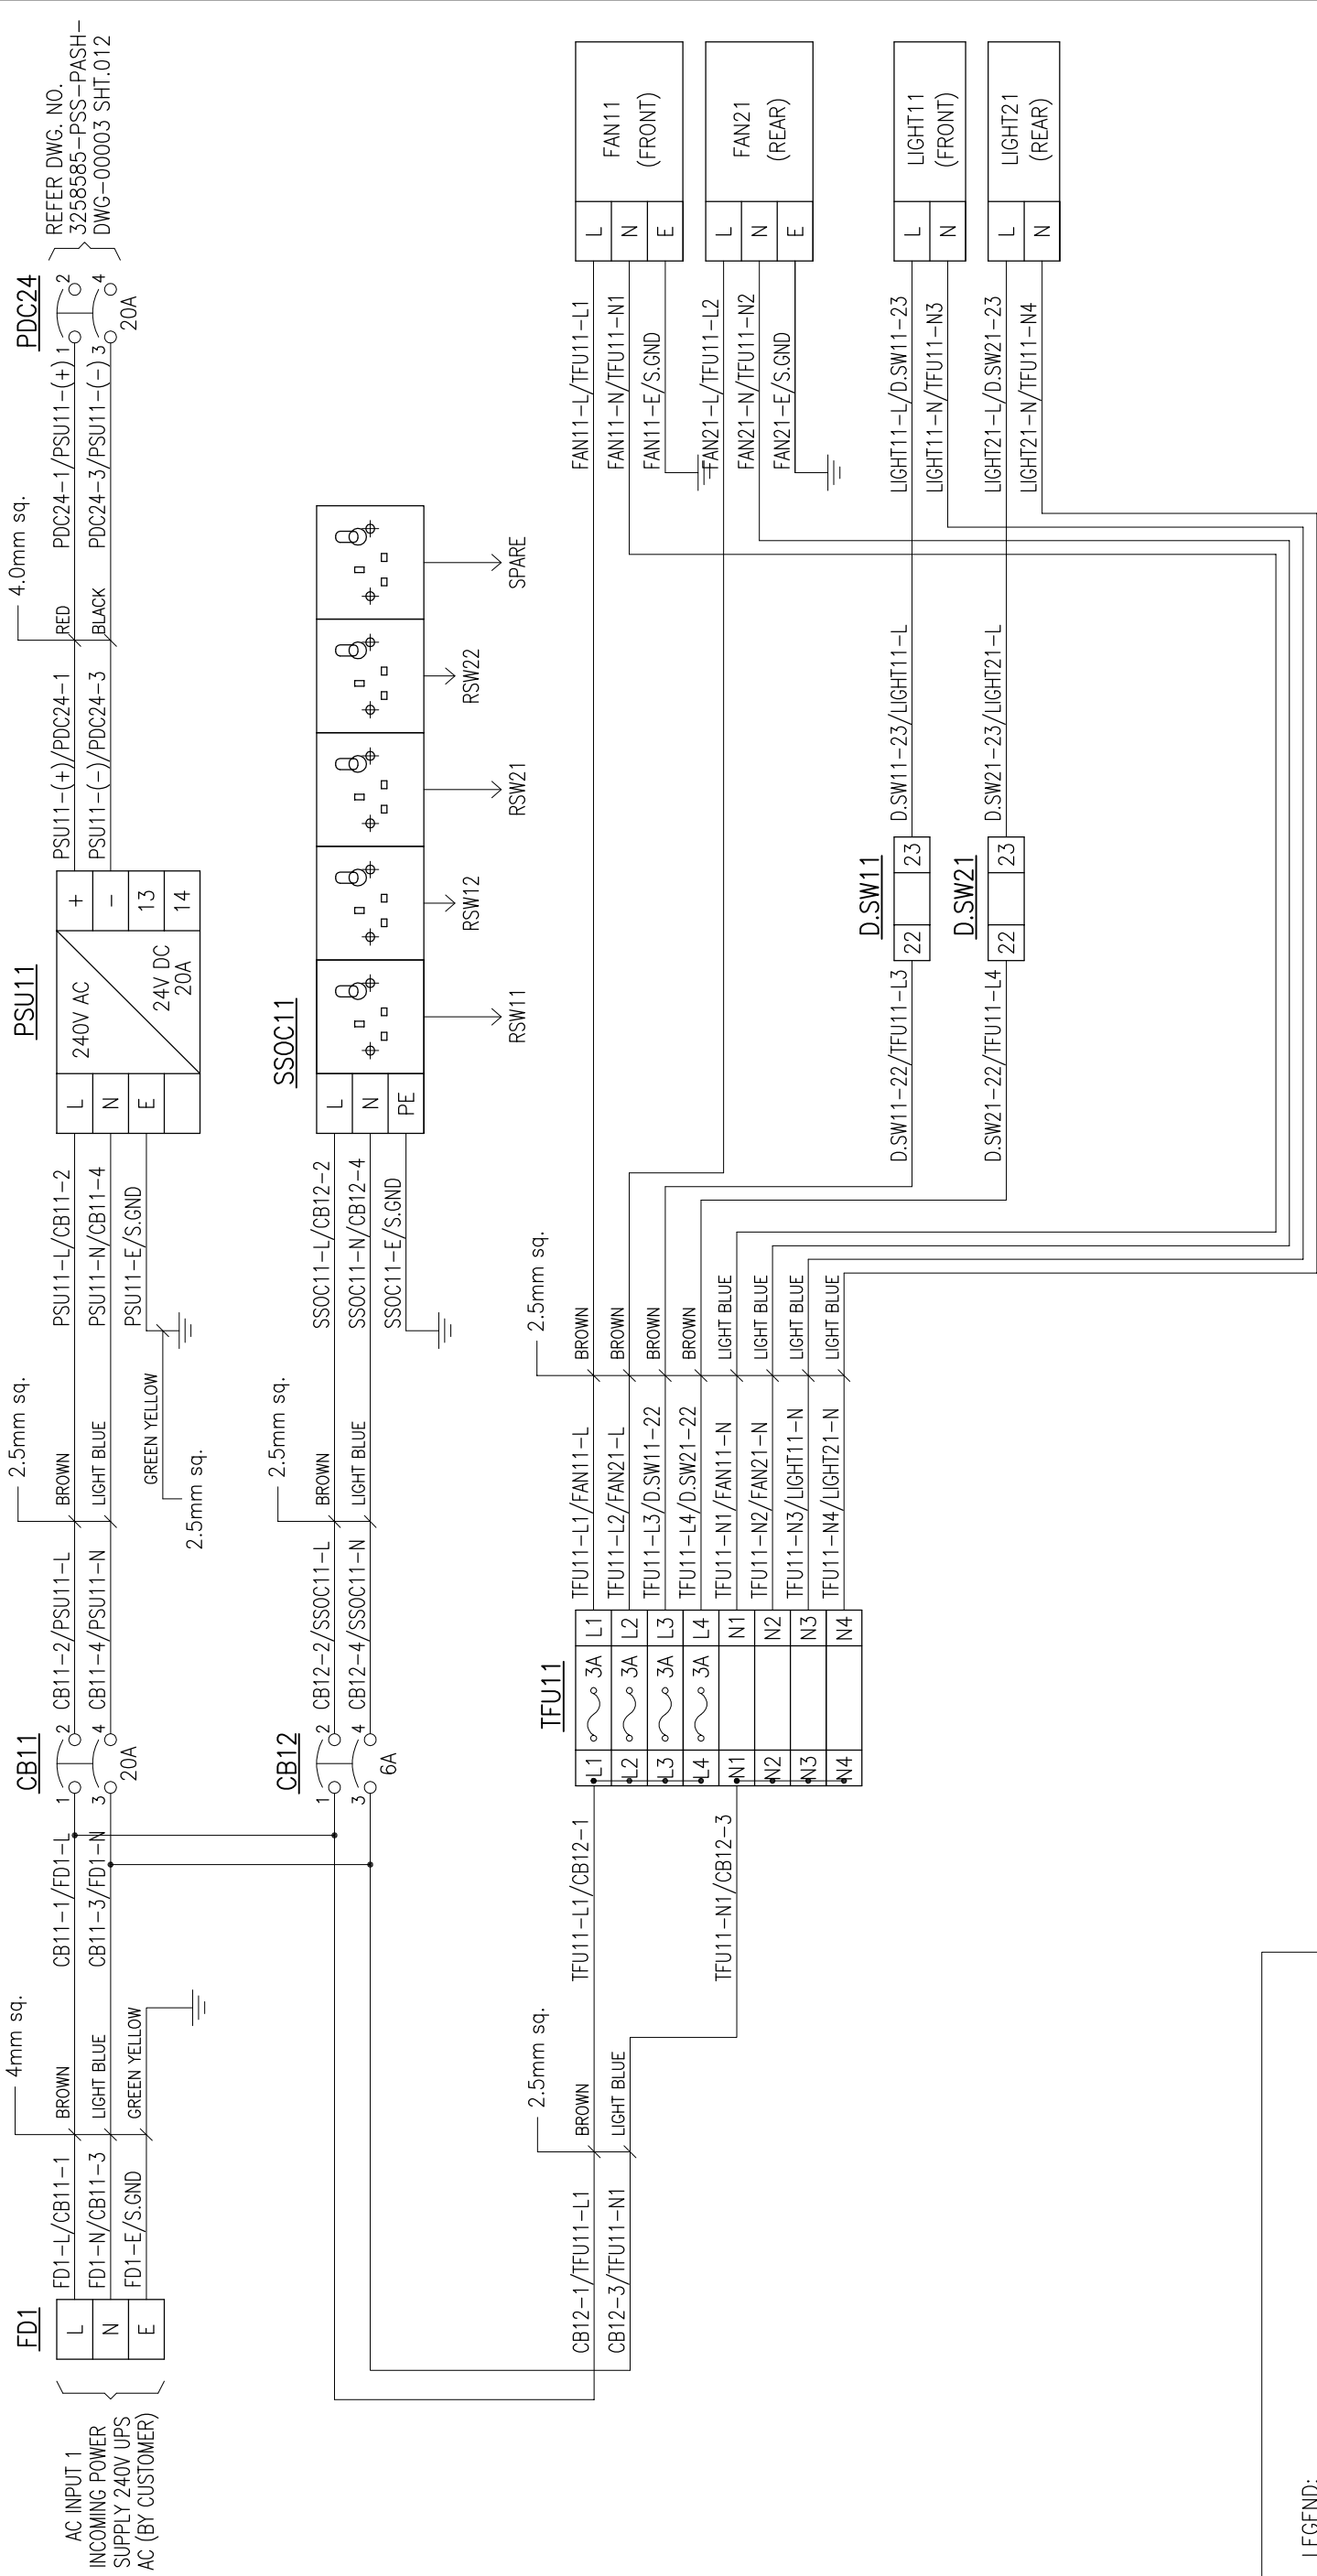

	TERMINAL & POINT NO.	TERMINAL & POINT NO.
1		
2		
PERMIT STAMP AND PROFESSIONAL STAMP
AFFIXED ABOVE SHALL APPLY ONLY TO REV(S)

EMERSON PROJECT NO.: 32585585
PROJECT TITLE:
DCS SERANG PROJECT

TITLE:
TYPICAL SYSTEM CABINET
240VAC UPS POWER DISTRIBUTION
DIAGRAM


EMERSON DRAWING NO.:
3258585-PSS-PASH-DWG-00003

SHEET NO:
011

REV.:
0

REFER DWG. NO.
3258585-PSS-PASH-
DWG-00003 SHT.011

PDC24

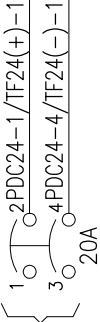

4.0mm sq.

TF24(+)-1/PDC24(+)-1

TF24(+)

1	6.3A	1
2	6.3A	2
3	6.3A	3
4	6.3A	4
5	6.3A	5
6	6.3A	6
7	6.3A	7
8	6.3A	8
9	6.3A	9
10	6.3A	10
11	6.3A	11
12	6.3A	12
13	6.3A	13
14	6.3A	14
15	6.3A	15

SPARE

2.5mm sq.

VMXXXX_PP-(3+)/TF24(+)-1

VMXXXX_PP-(4-)/TF24(-)-1

CTRLXXXX_PP-(3+)/TF24(+)-2

CTRLXXXX_PP-(4-)/TF24(-)-2

CTRLXXXX_PP-(3+)/TF24(+)-3

CTRLXXXX_PP-(4-)/TF24(-)-3

CTRLXXXX_PS-(3+)/TF24(+)-4

CTRLXXXX_PS-(4-)/TF24(-)-4

C01_BP1-(+)/TF24(+)-5

C01_BP1-(-)/TF24(-)-5

EIOC-(+)/TF24(+)-6

EIOC-(-)/TF24(-)-6

VRSW11-(+)/TF24(+)-7

VRSW11-(-)/TF24(-)-7

VRSW12-(+)/TF24(+)-8

VRSW12-(-)/TF24(-)-8

EIOC_SW-(+)/TF24(+)-9

EIOC_SW-(-)/TF24(-)-9

TF24(-)

1		1
2		2
3		3
4		4
5		5
6		6
7		7
8		8
9		9
10		10
11		11
12		12
13		13
14		14
15		15

SPARE

TF24(-)-1/VMXXXX_PP-(4+)

TF24(-)-2/CTRLXXXX_PP-(4+)

TF24(-)-3/CTRLXXXX_PP-(4+)

TF24(-)-4/CTRLXXXX_PS-(4+)

TF24(-)-5/C01_BP1-(-)

TF24(-)-6/EIOC-(-)

TF24(-)-7/VRSW11-(-)

TF24(-)-8/VRSW12-(-)


TF24(-)-9/EIOC_SW-(-)

TF24(-)-15/L.GND-E



2.5mm sq.

LEGEND:

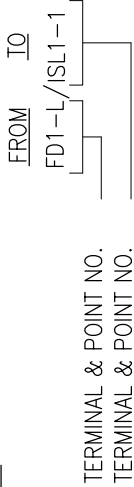

TERMINAL & POINT NO.
TERMINAL & POINT NO.



PERMIT STAMP AND PROFESSIONAL STAMP
AFFIXED ABOVE SHALL APPLY ONLY TO REV(s)

EMERSON PROJECT NO.: 3258585
PROJECT TITLE:
DCS SERANG PROJECT

SCALE: NTS
SIZE: A3
UNITS: mm (inch)
© 2018

TITLE:
TYPICAL SYSTEM CABINET
24VDC POWER DISTRIBUTION
DIAGRAM

EMERSON DRAWING NO.:
3258585-PSS-PASH-DWG-00003

SHEET NO.:
012

CUSTOMER DRAWING NO.:
-

REV.:
0